


**Note:**  
 ex. stone wall retaining 600mm to 12 demolished on boundary where new wall is to be erected.

sliding automatic gates

Piers 550 x 550.

**PLAN 1:100**

\* Finishes to both sides of wall to be plaster & paint.

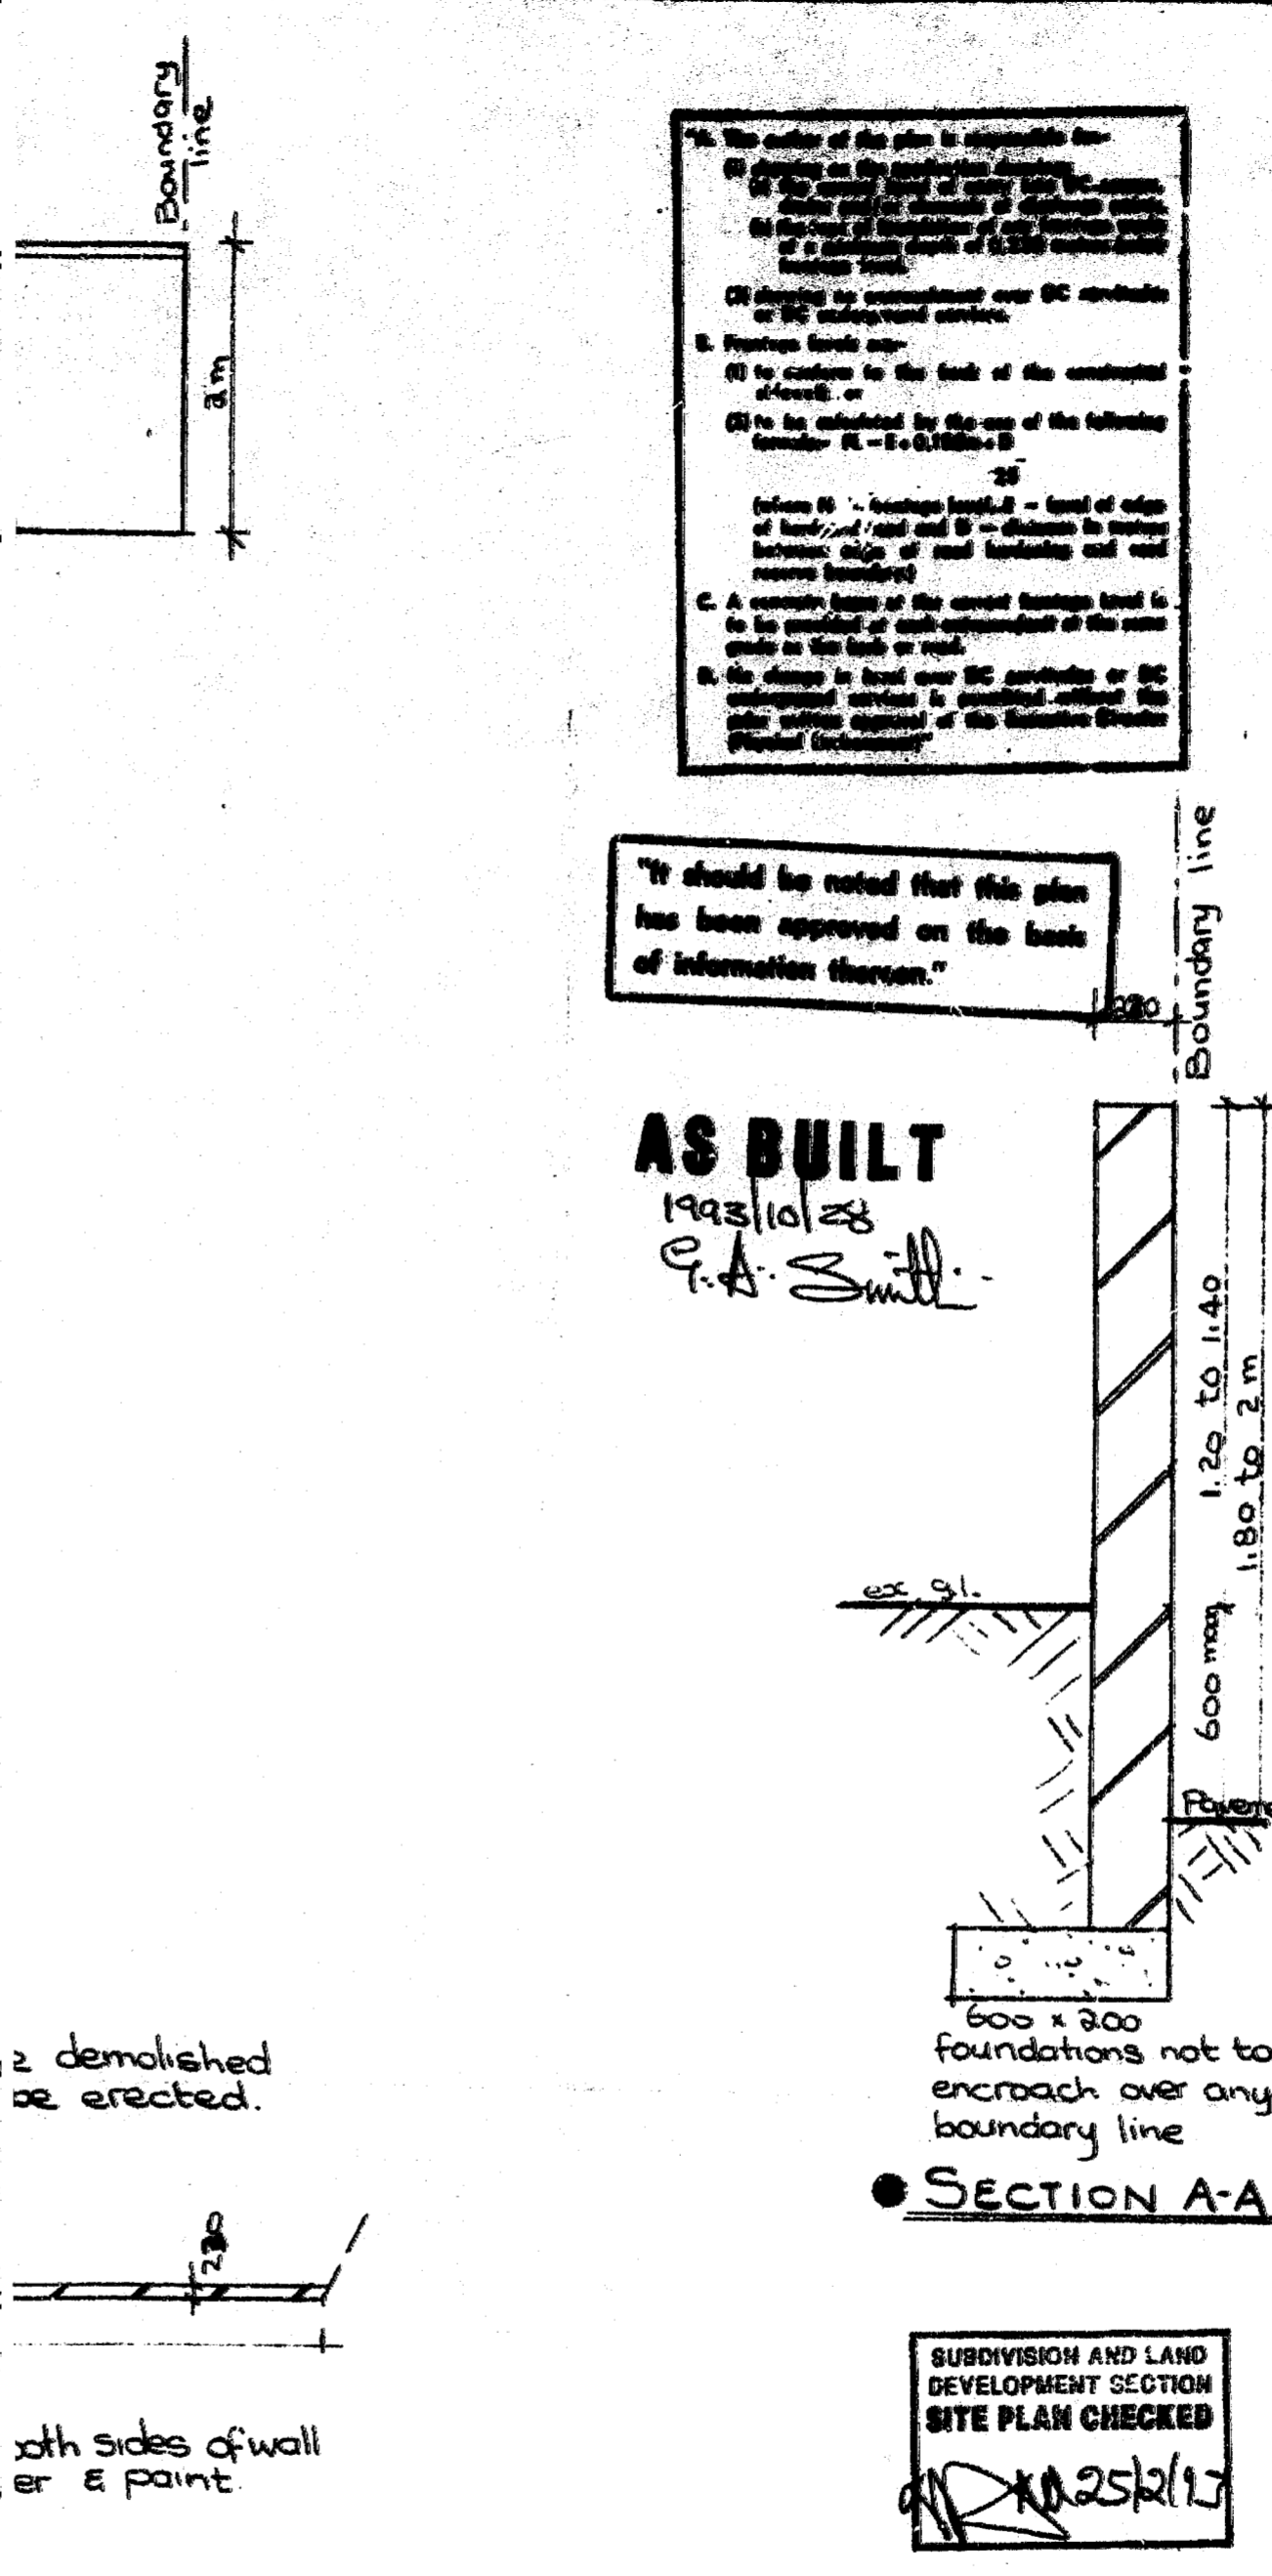

"The owner of the site is responsible for..."

1. The owner of the site is responsible for...  
 (a) to ensure that the wall is constructed in accordance with the specifications...  
 (b) to ensure that the wall is constructed in accordance with the specifications...  
 (c) to ensure that the wall is constructed in accordance with the specifications...

2. The owner of the site is responsible for...  
 (a) to ensure that the wall is constructed in accordance with the specifications...  
 (b) to ensure that the wall is constructed in accordance with the specifications...  
 (c) to ensure that the wall is constructed in accordance with the specifications...

3. The owner of the site is responsible for...  
 (a) to ensure that the wall is constructed in accordance with the specifications...  
 (b) to ensure that the wall is constructed in accordance with the specifications...  
 (c) to ensure that the wall is constructed in accordance with the specifications...

"It should be noted that this plan has been approved on the basis of information thereon."

**AS BUILT**  
 1993/10/28  
 P.A. Smith

SUBDIVISION AND LAND DEVELOPMENT SECTION  
**SITE PLAN CHECKED**

SHEET 11 COPY 3

**CITY OF DURBAN**  
 PLAN NUMBER  
 0812-02-93-7

APPROVED: R. A. MOORE  
 EXECUTIVE DIRECTOR PHYSICAL DEVELOPMENT SERVICES UNIT

1993/02/08

**ELECTRICITY SERVICES**

Any person carrying out building operations in accordance with this plan is required to ascertain from the Executive Director, Electrical Department,

- The location of any electrical services and services in the vicinity of the proposed work.
- Departmental requirements regarding Substation, Meter room and Cable ducts.

**ENGINEER'S DETAILS OF RETAINING WALL REQUIRED**

DEVELOPMENT CONTROL DEPT.  
 TOWN PLANNING AUTHORITY

**GRANTED**  
 1993-03-02

Signature: [Signature]  
 Checked: [Signature]

**BOUNDARY BEACONS**

FAILURE TO EXPOSE THE BOUNDARY BEACONS BEFORE STARTING THIS WORK IS AN OFFENCE

PROPOSAL: Front Boundary Wall

CLIENT: MR LAPIN

ADDRESS: 16 HIGHGATE PLACE

SITE DETAILS: Sub 6 of 409 of Durban North no 13379

OWNER: R. Lappin

DRAWN BY: E. Bradshaw

DATE: Feb 93

E. BRADSHAW  
 4 Gorse Road  
 Glen Hills  
 Ph. 838559