



WEST ELEVATION - DWELLING, OUTBUILDING & SECTION "A-A"
SCALE 1:100

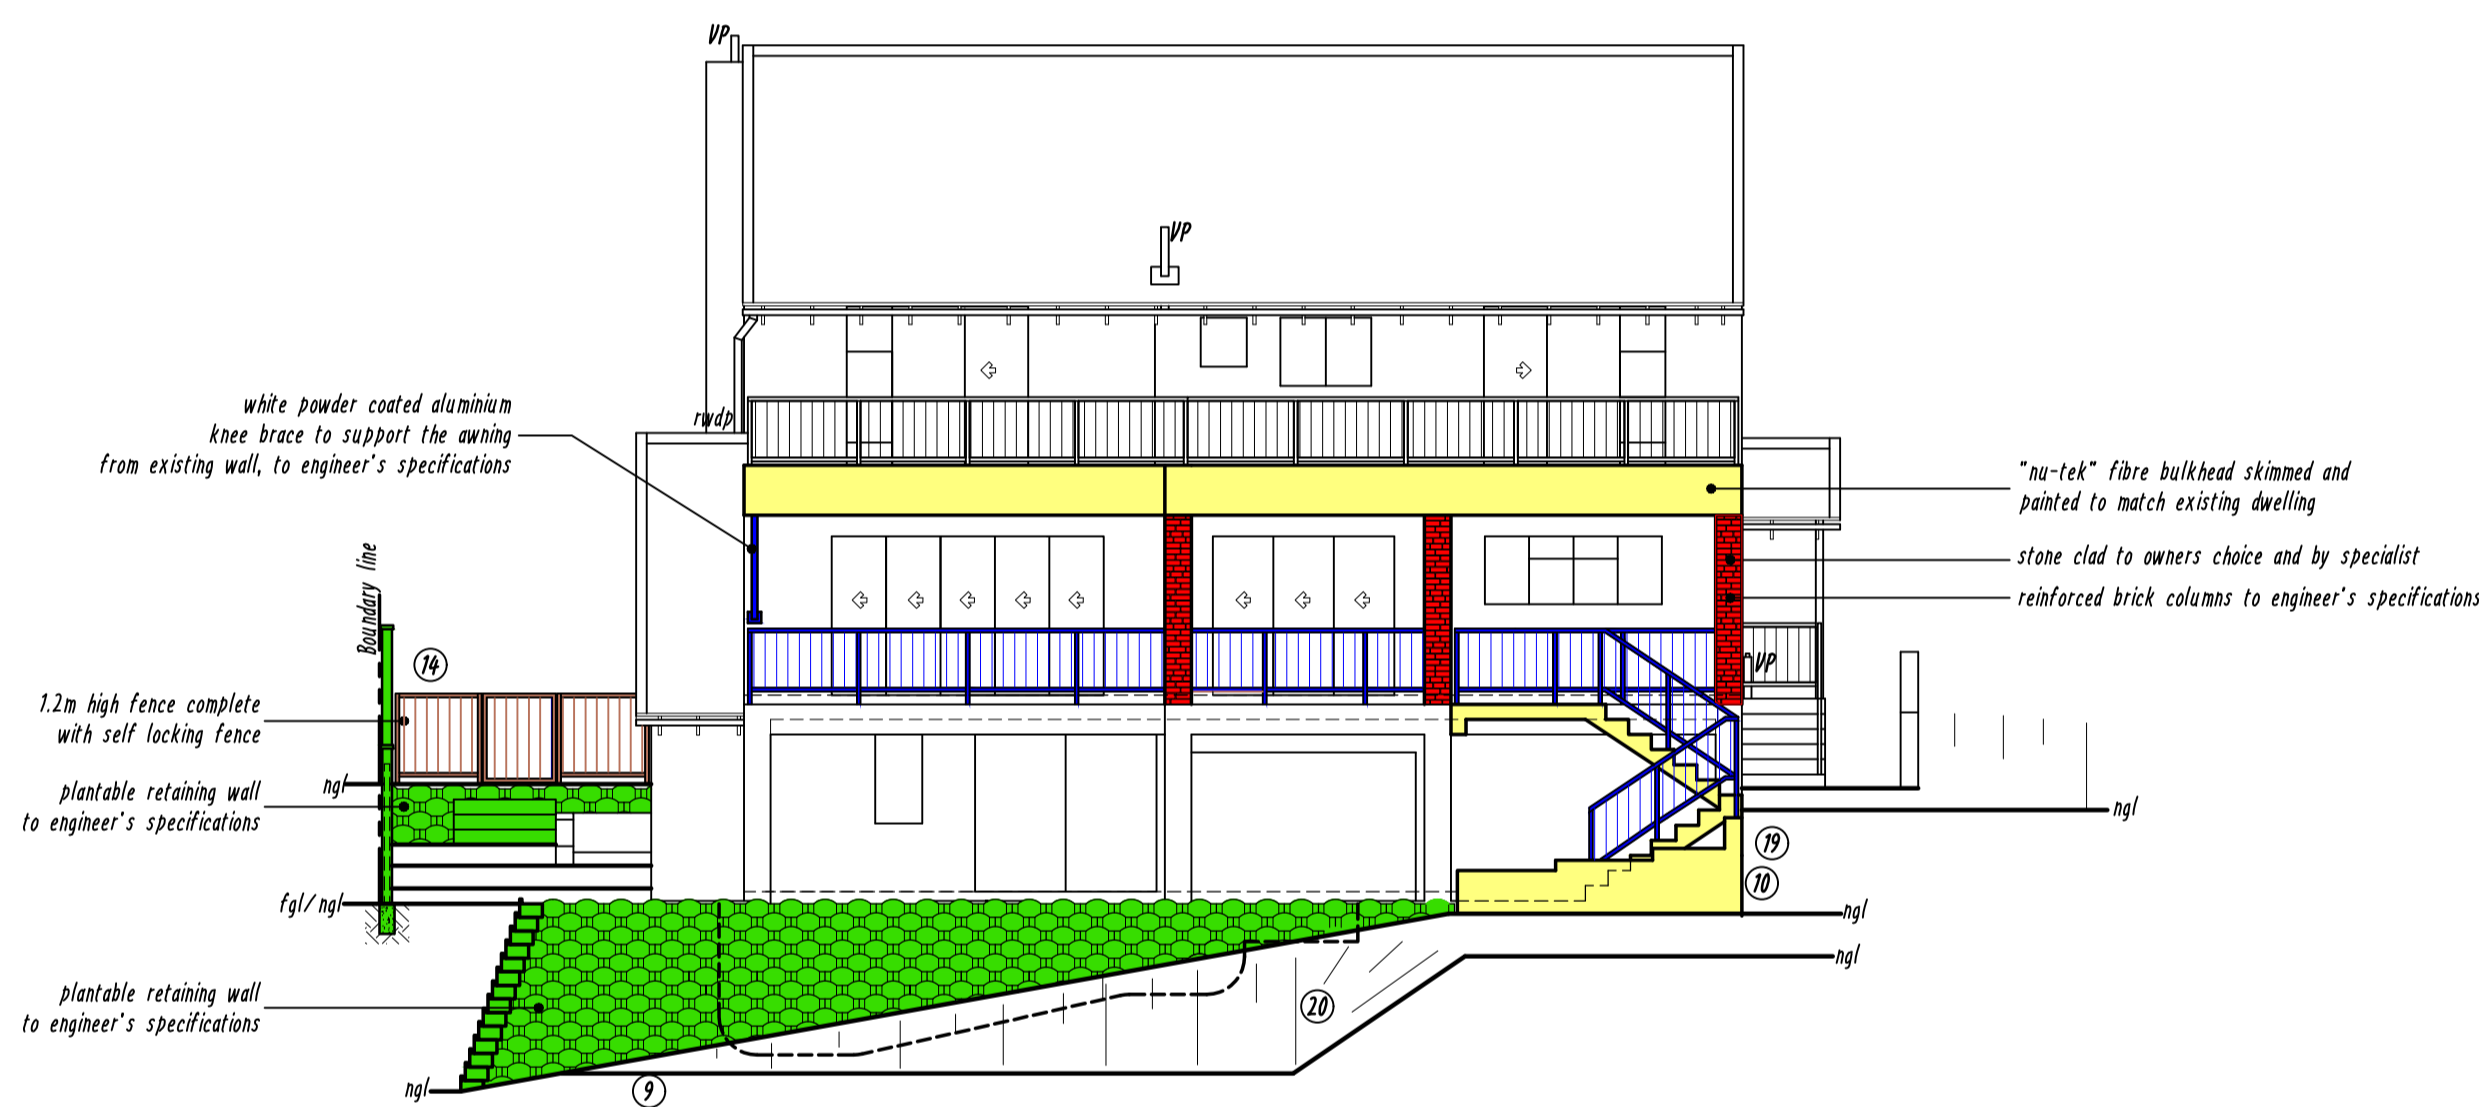

SOUTH ELEVATION - DWELLING
SCALE 1:100

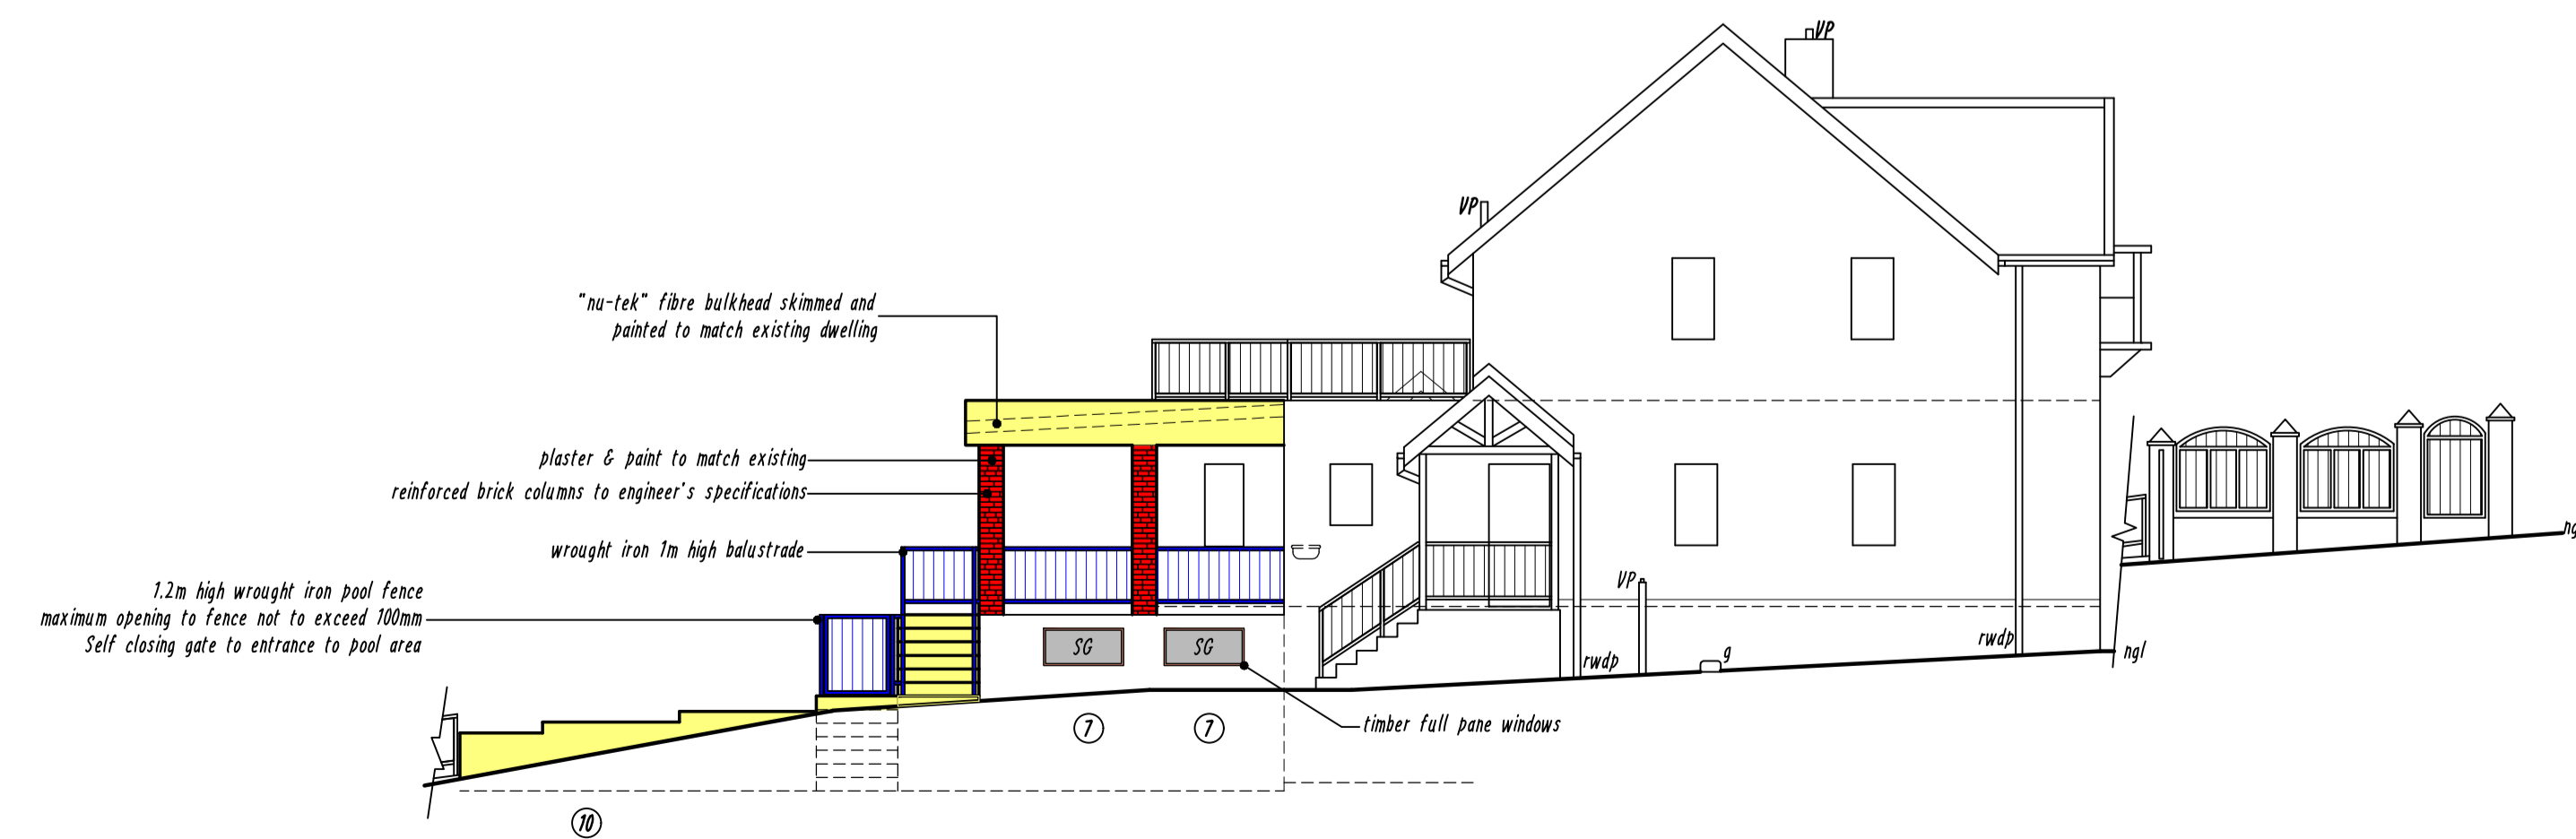

EAST ELEVATION
SCALE 1:100

NEIGHBOURS CONSENT			
ADDRESS	NAME	TEL. No	SIGNATURE
9 Anthony Road	LCS JANSEN	083 2724869	
12 Anthony Road	E. Landshery E. Landshery	079 7855470	
14 Anthony Road	C. ROBERT	082 5213407	
16 Anthony Road	R.C. ROBERT	082 5213561	
17 Anthony Road	A. NAICKER	083 6214438	
17 Anthony Road	M. DUPONT	082 7462593	
16A Underwood Road	A. MATTION	082 5794902	
18 Underwood Road	A. MATTION	082 5794902	
20 Underwood Road	N. MERTZON	071646600	
251 High Ridge Road	V. COCKLE	0722617899	

HYPHERE SYSTEMS cc OK 94/13816/23 1/A

Ian Whitaker
 Draughting Designs
 COMPUTER AIDED DRAWINGS
 REG. No. D0783

PROFESSIONAL ARCHITECTURAL DRAUGHTS PERSON CELL No. 083 303 8863
 8 UP THE HILL, SUNNINGDALE, 4051 TEL: 031 5620210

Owner:
J.K.B. BOSSERT & G. BOSSERT

Property Details:
11 ANTHONY ROAD ①
ATHLONE
REM OF ERF 78
DURBAN NORTH

Proposal:
DEVIATIONS TO APPROVED PLANS No. 159 06 13 & PROPOSED ALTERATIONS AND ADDITIONS TO EXISTING DWELLING

OCCUPANCY: H3 CLIMATE ZONE: 5

DRAWING TITLE
 SUBMISSION - ELEVATIONS

PROJECT NO: WD19/29 DRAWING NO: WD19/29/ai/602 REV. NO: A

SCALE: 1:100 DATE: 28-10-2019

AUTHOR'S SIGNATURE:

OWNER'S SIGNATURE: