



HESKETH & DRIMAN  
ARCHITECTS  
401 TRISTE BUILDING DUNNAN  
DUNNAN, S.O.S.S.

SCALE 1/8" = 1'-0"  
DATE DRAWN 27.1.53  
DRAWN BY P.D.

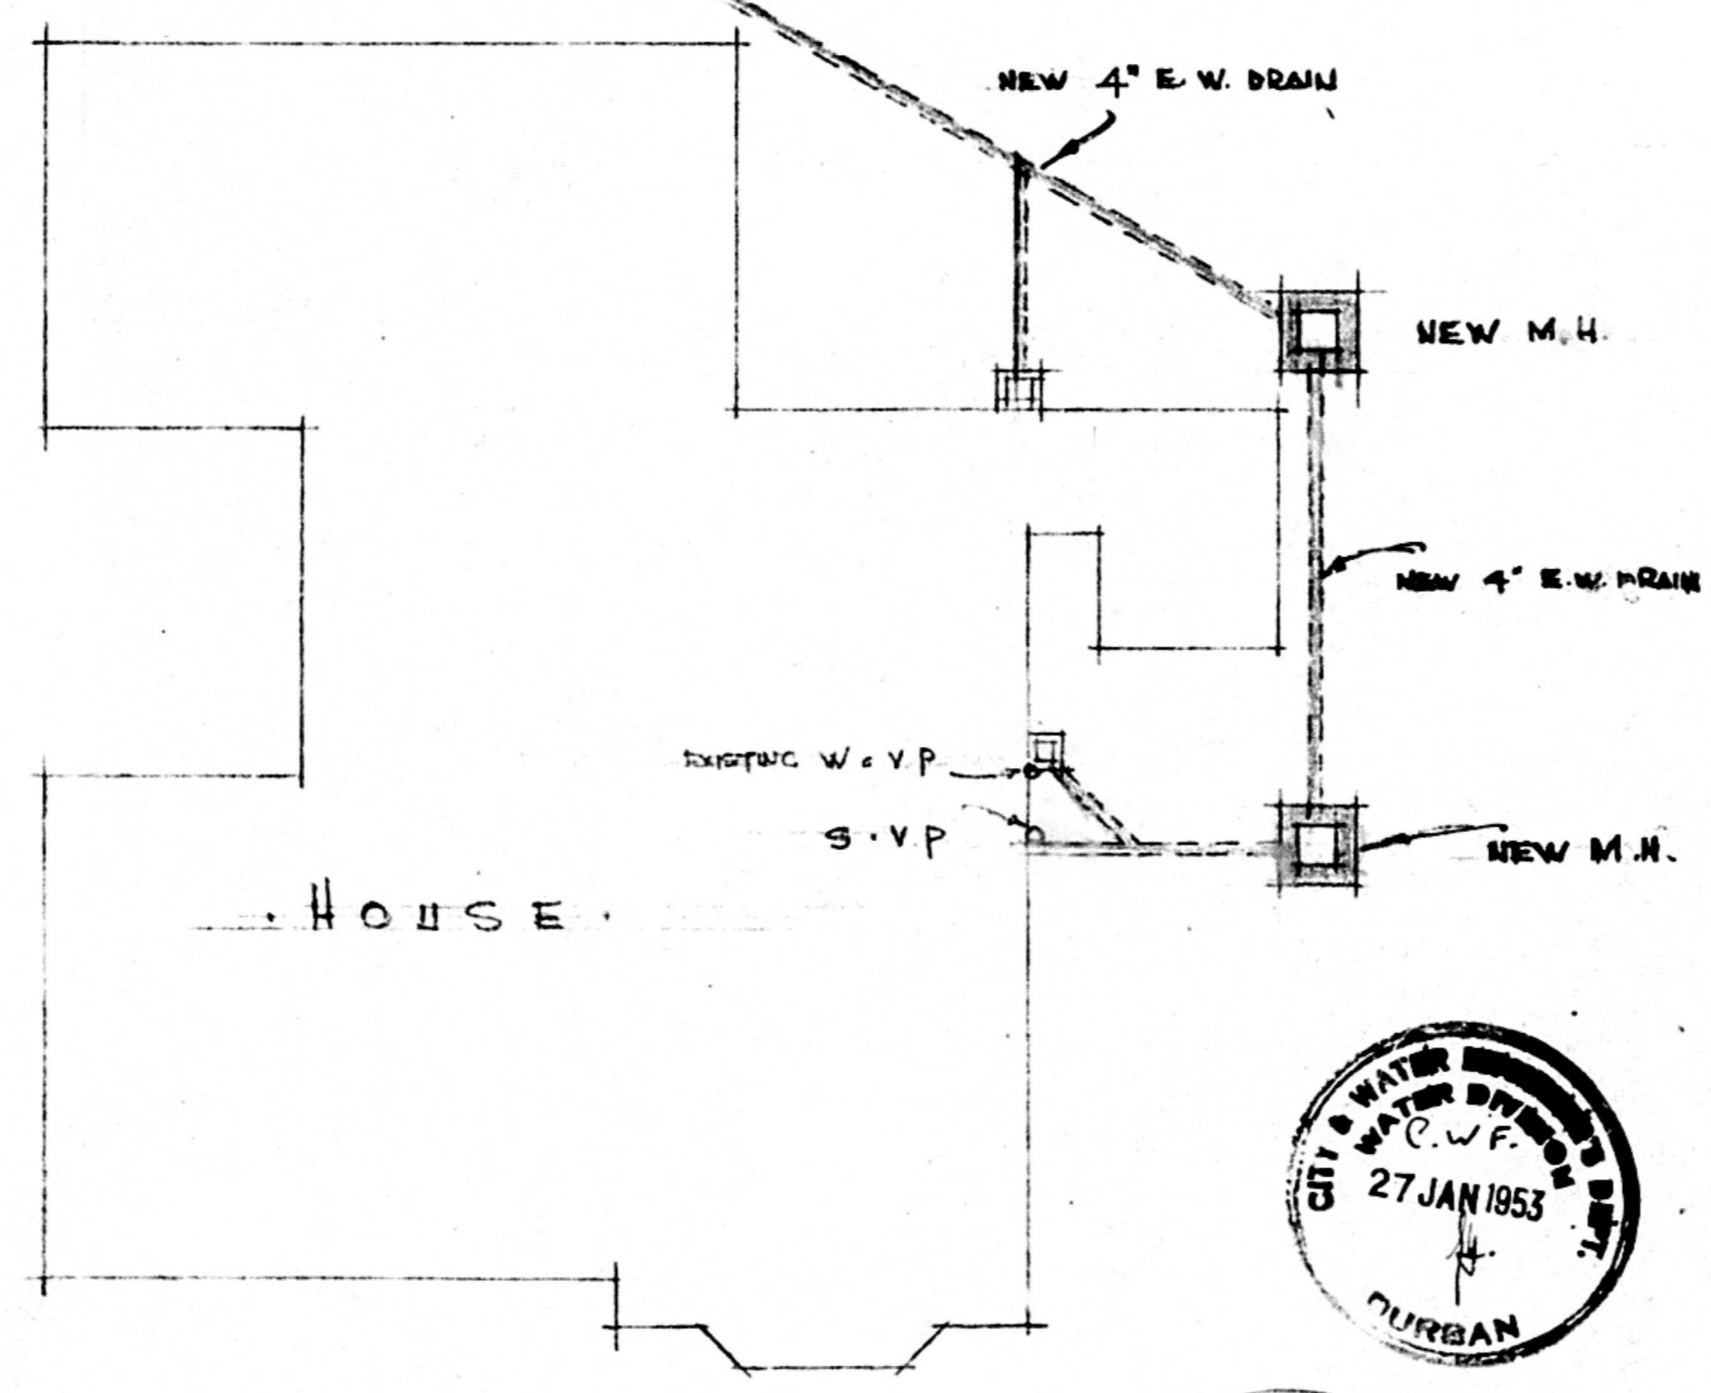


GROUND FLOOR PLAN

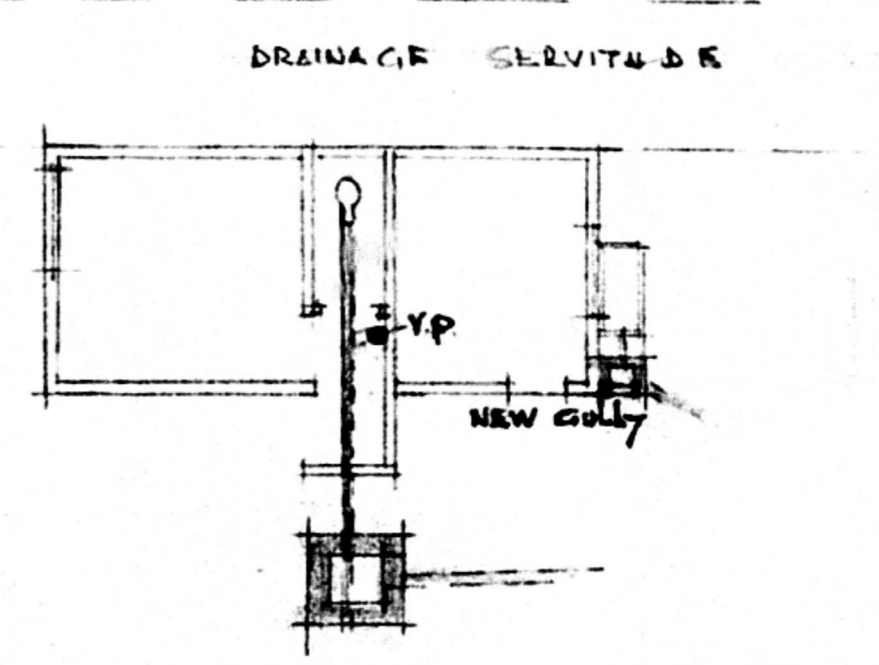

DRAINAGE SERVICE LINE

PLAN OF NATIVE QTRS

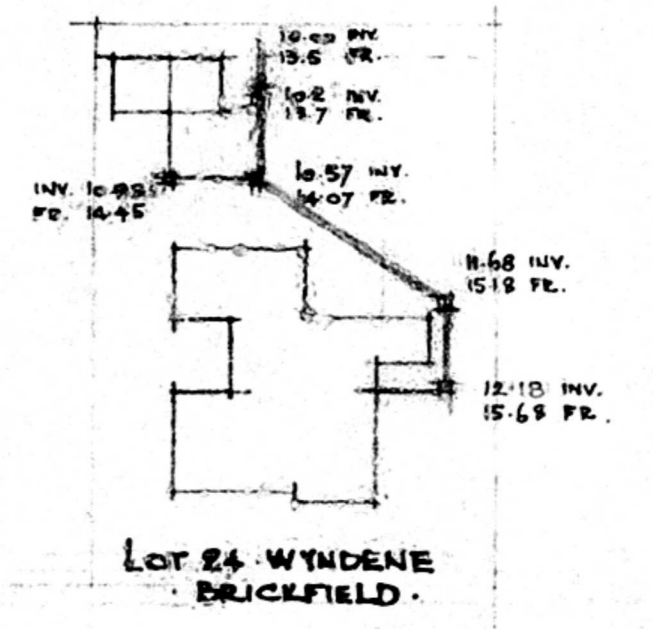


LOT 24 WYNDENE BRICKFIELD  
FRIESLAND ROAD  
BLOCK PLAN 1" = 40'




INSTALLATION OF NEW DRAINS AT 10 FRIESLAND ROAD  
BLACKHILL FOR MRS. E. DRIMAN

SHEET	1/1	COPY	3
<b>CITY OF DURBAN</b>			
PLAN NUMBER <u>630/6/82</u>			
APPROVED			
DATE <u>23 JUL 1982</u>			
D. C. MACLEOD			
CIVIL ENGINEER			

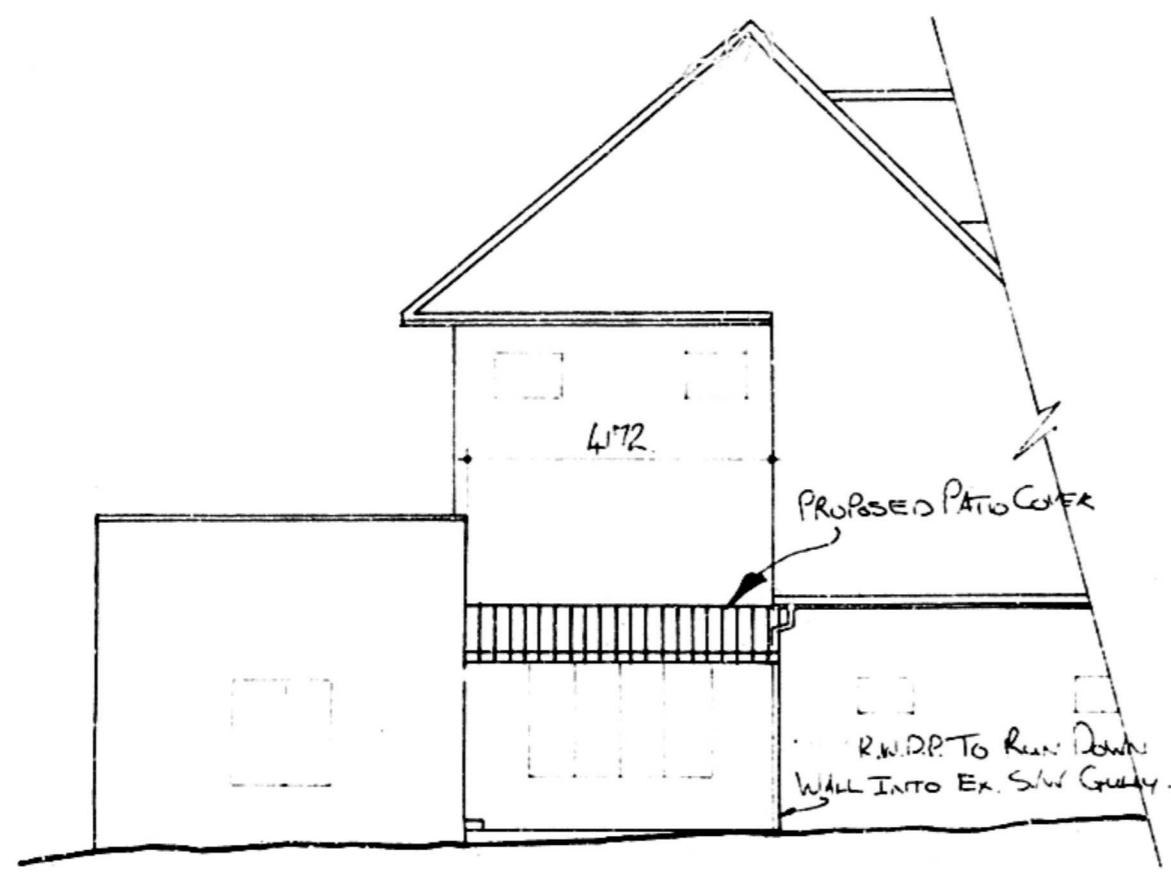

NW ELEVATION  
SCALE 1:100

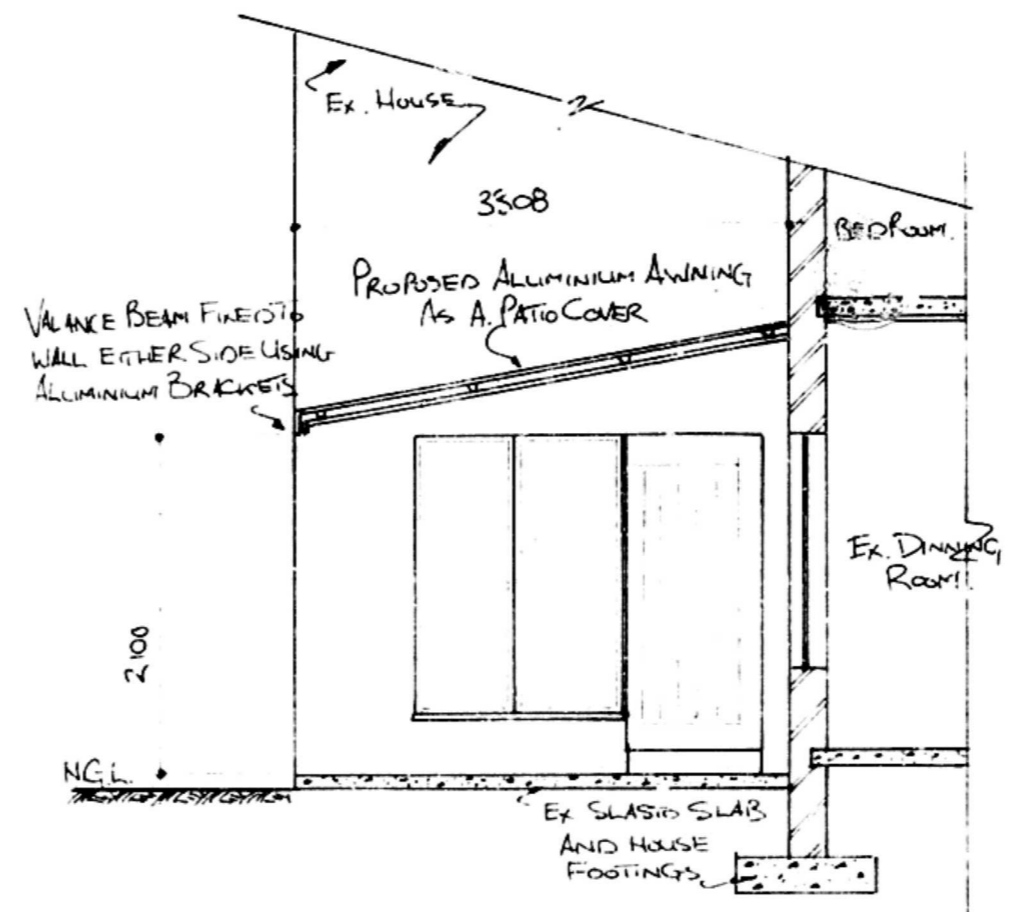

ENLARGED SECTION AA  
SCALE 1:50


**NOTES**

ALUMINIUM STRATA TYPE AWNING AS A PATIO COVER ON ALUMINIUM HOLLOWCORE VALANCE BEAM FIXED TO EXISTING WALL AT REAR END AND SUPPORTED AT FRONT END EITHER SIDE BY ALUMINIUM BRACKETS FIXED TO THE WALL SECURING VALANCE BEAM.


IF PATIO COVER IS TO CARRY ALIVE LOAD PLUCK BOARDS MUST BE USED

FOR DETAILS REFER TO STD. DRG'S 1/8 DRAWN BY P. DUFFY AND ASSOCIATES.

PROPOSED AREA OF AWNING = 13.65 m<sup>2</sup>

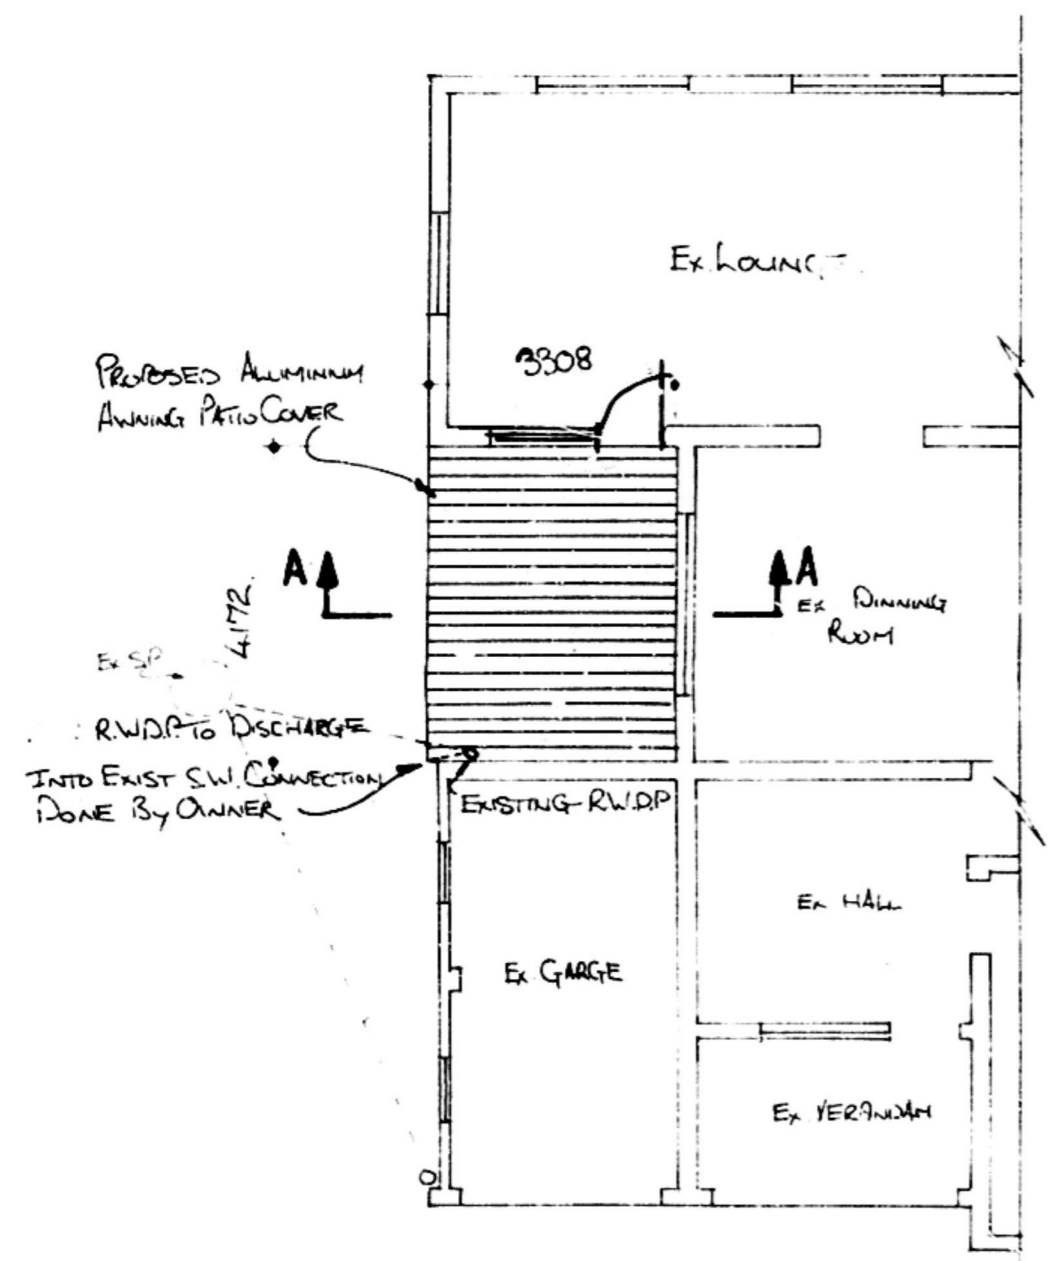

PART GROUND FLOOR PLAN  
SCALE 1:100

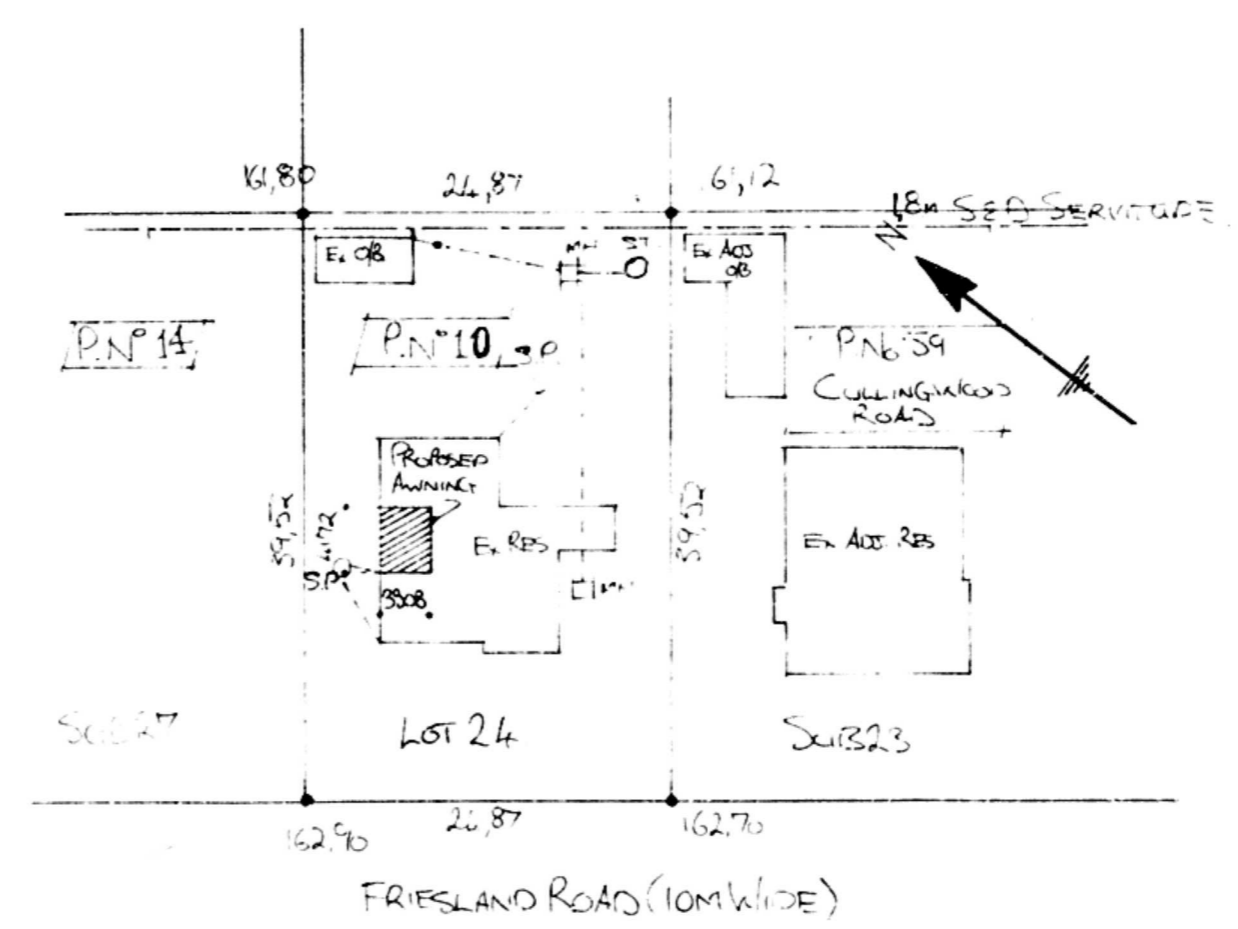


SITE PLAN  
SCALE: 1:500

TOWN PLANNING BRANCH	
APPROVED	
DATE 28 JUN 1982	
Signature <i>[Signature]</i>	


**ORIGINAL**  
**AS BUILT**

*[Signature]*  
16/8/82

ALFABCO (PTY) LTD.		
17 MCDONALD ROAD, DURBAN. TEL: 255381		
DRAWN BY: A. BOSTHA	DATE: 2-6-82	DRG. NO. 467
SIGNATURE: A. BOSTHA	SCALE: 1:50 1:100 1:500	
PROPOSED ALUMINIUM AWNING PATIO COVER FOR J.D. AIREY AT 10 FRIESLAND ROAD SHERWOOD ON LOT 24 OF WYNDENE OF BRICKFIELD. NO 806		

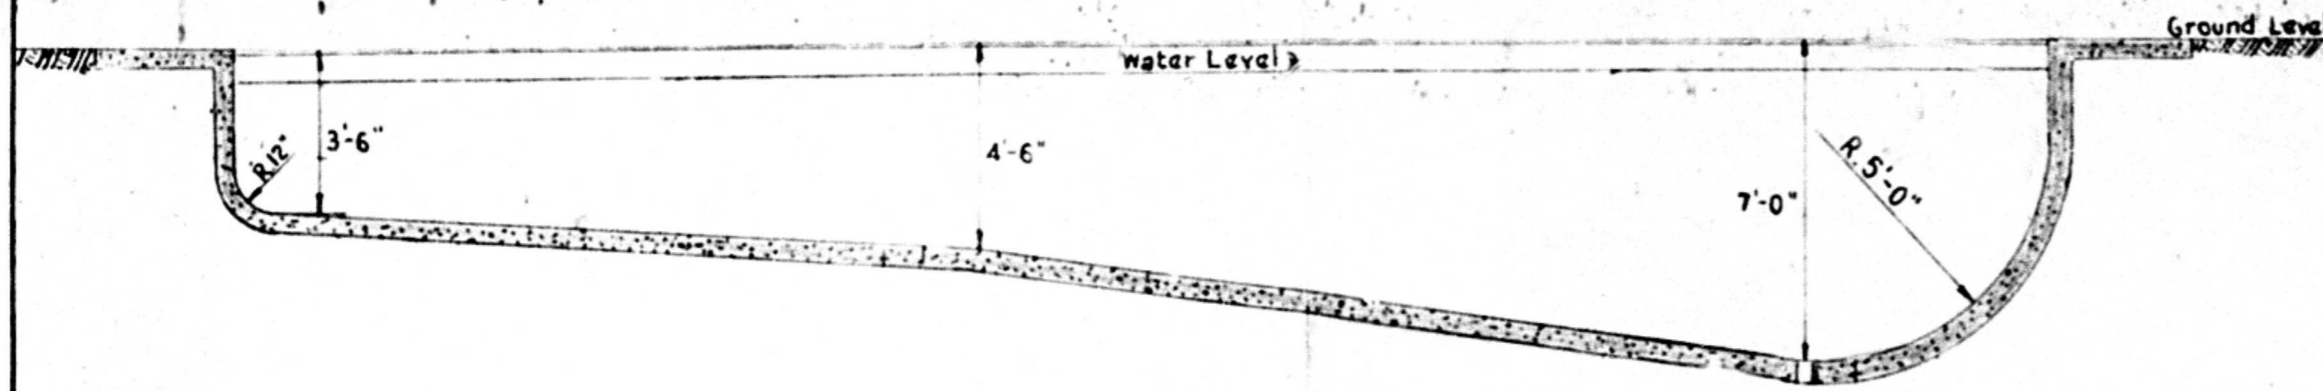

SECTION A-A

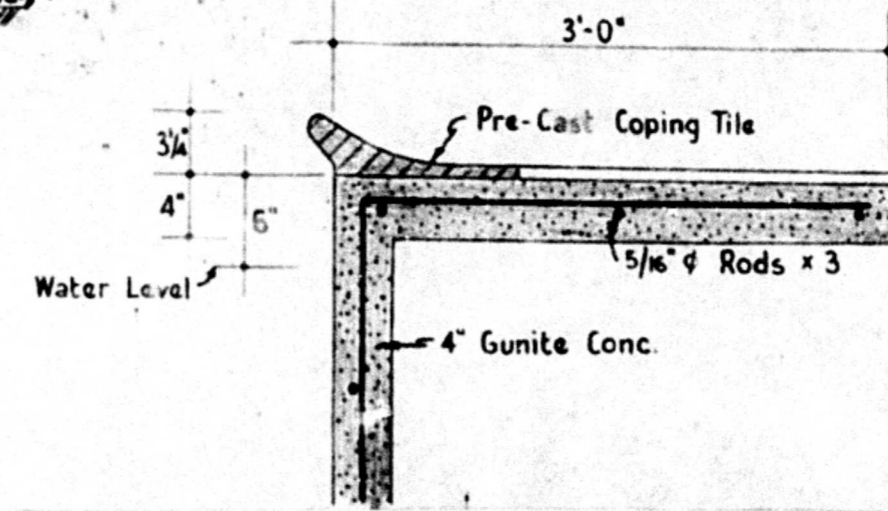

SURROUND BEAM DETAIL


**NOTES**

1. EARTH LEAKAGE PROTECTION TO BE FITTED TO ALL ELECTRICAL SUPPLY
2. PRECAUTIONS TO BE TAKEN IN REGARD TO CONDENSATE
3. PRECAUTIONS TO BE TAKEN AGAINST FLOODING SEEPAGE AND RAINWATER IN SUNKEN PUMP CHAMBER AND FILTER UNIT
4. PUMP CHAMBER TO BE ADEQUATELY DRAINED
5. PLANT ARRANGEMENT AND FIXING TO SUPPLIERS REQUIREMENTS
6. EXCAVATED SOIL TO BE REMOVED FROM SITE BY OWNER
7. NEW 1/2" Ø WATER CONNECTION TO BE METERED
8. WASTE WATER: OVER SITE / TO B.P.T. TO EXISTING SEWER


SCALE 1" TO 1'

CHAINAGE	530.00	704.00	721.50	731.50	601.00	602.350
GROUND LEV.	7.04	7.21	7.31	7.31	6.01	6.02
INVERT LEV.	7.04	7.21	7.31	7.31	6.01	6.02

SEWER SECTION  
SCALE: HOR. 1" TO 20'  
VER. 1" TO 5'

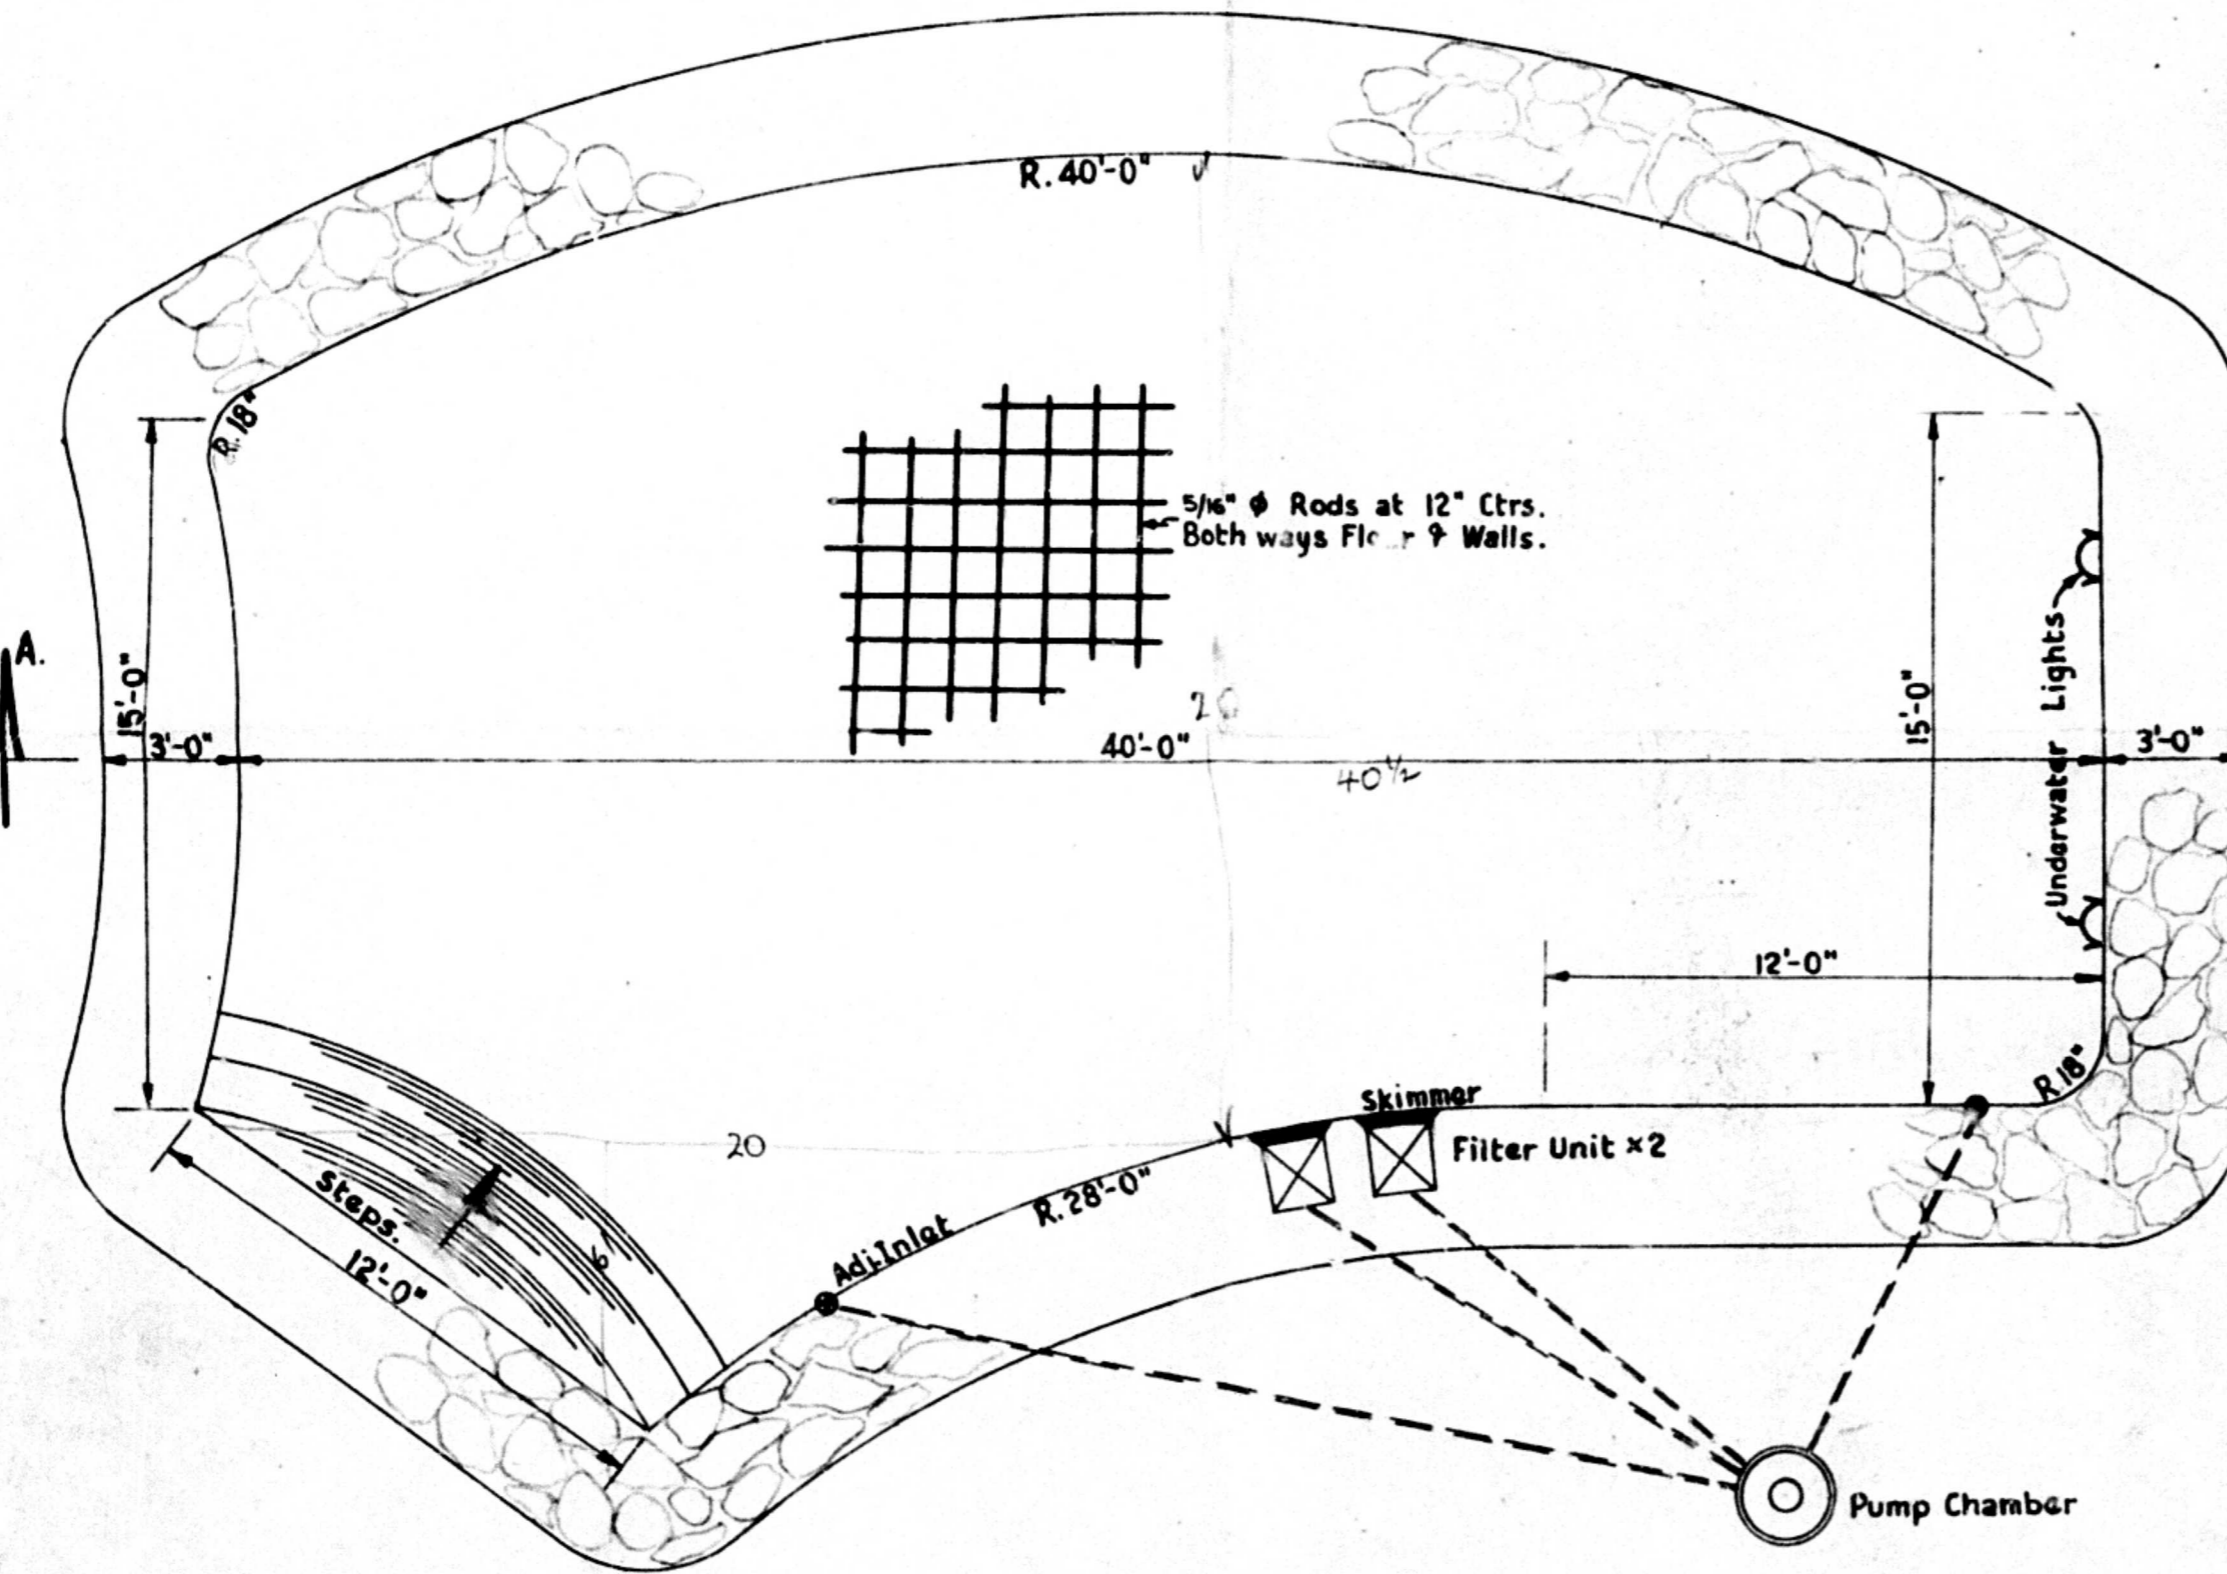

PLAN  
SCALE 1/4" TO 1'

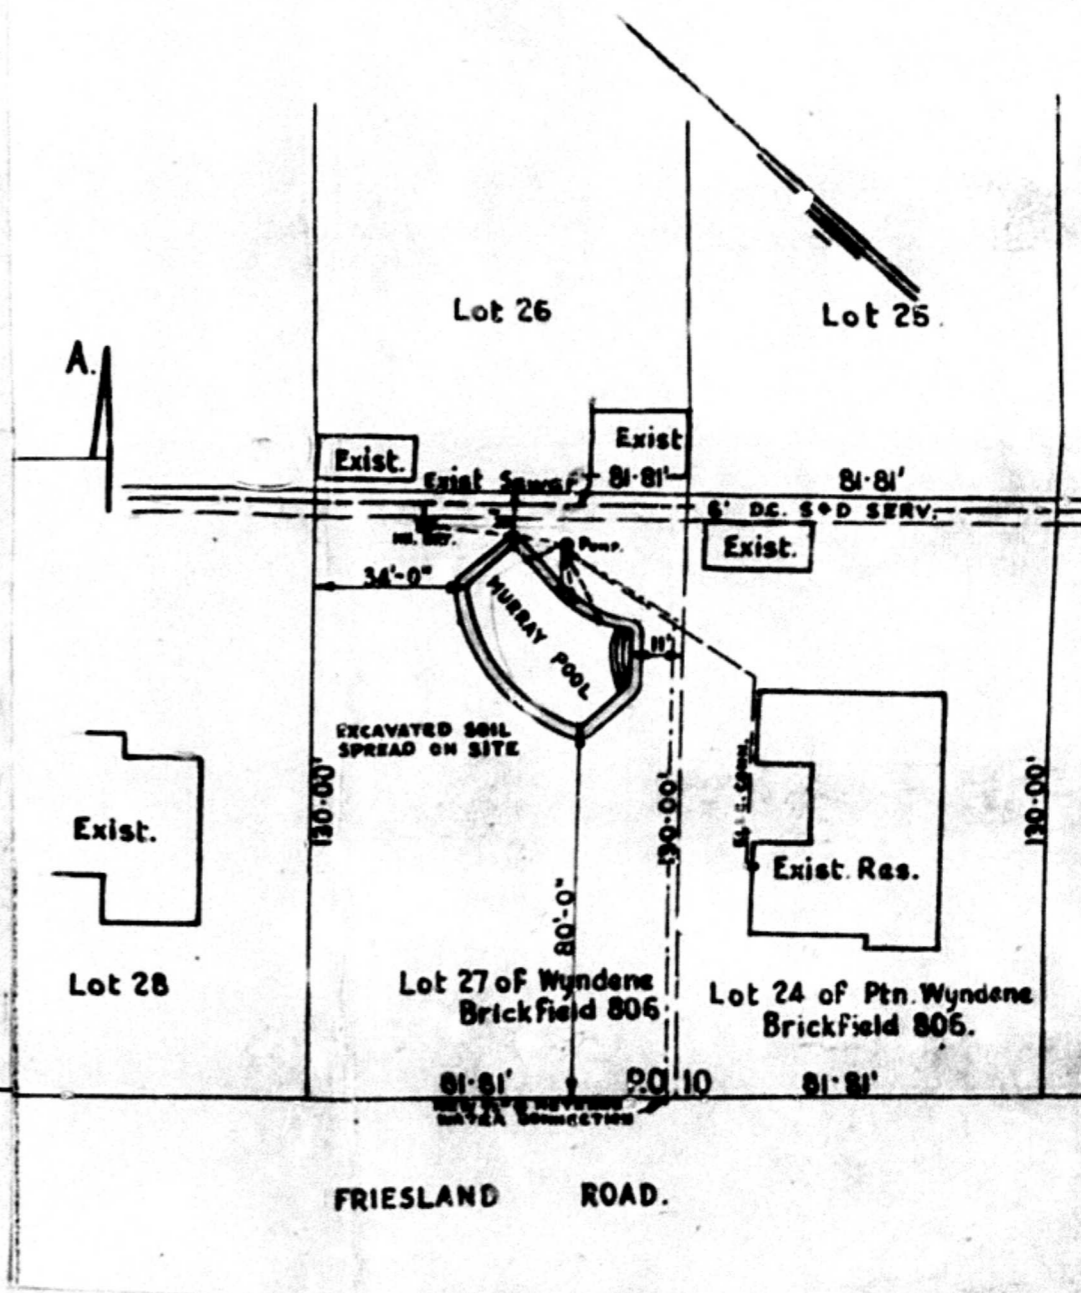

SITE PLAN  
SCALE 40' TO 1"


PROPOSED MURRAY SWIMMING POOL FOR  
J.D. AIREY ESQ.  
AT 10 FRIESLAND ROAD DURBAN

COASTAL POOLS (PTY) LTD. 379 UMDILO ROAD TEL. 35-6104	
DRAWN BY <i>[Signature]</i>	DATE 18.11.69
TYPE BOLERO	DRAWING NO. MUR 7.9


SET	COPY
1	3
CITY OF DURBAN	
N. No. 393	
APPROVED	
C. G. HANDS	
CITY ENGINEER	

TOWN PLANNING	
APPROVED	
1-DEC 1969	
DATE	<i>[Signature]</i>
SIGNATURE	<i>[Signature]</i>


B.  
10 Friesland  
Swim Pool

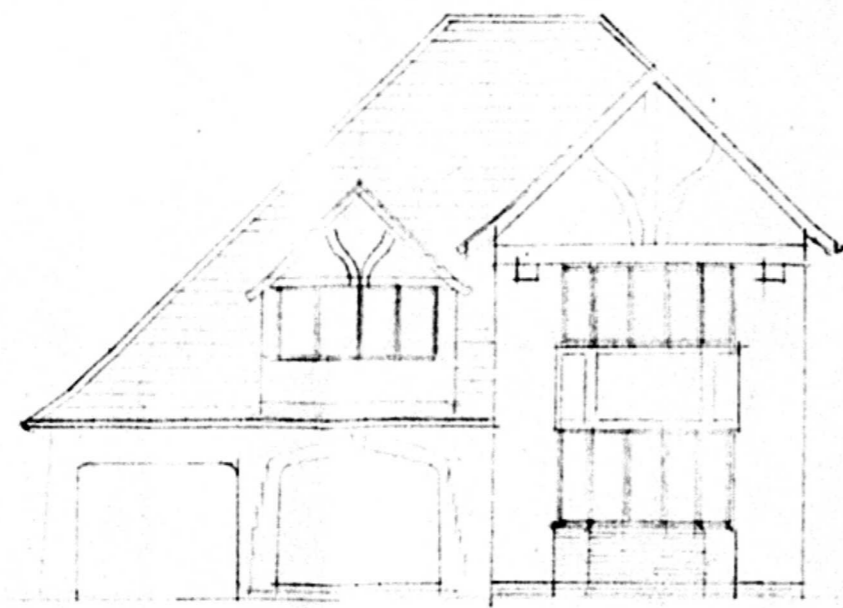


FRONT ELEVATION

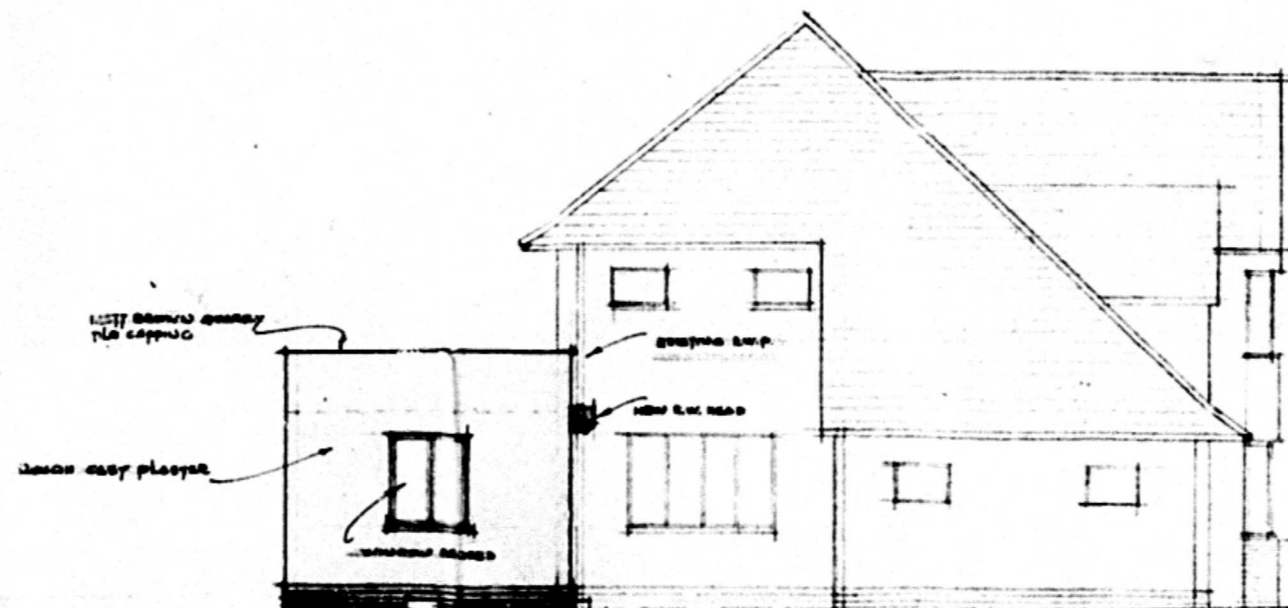


SIDE ELEVATION

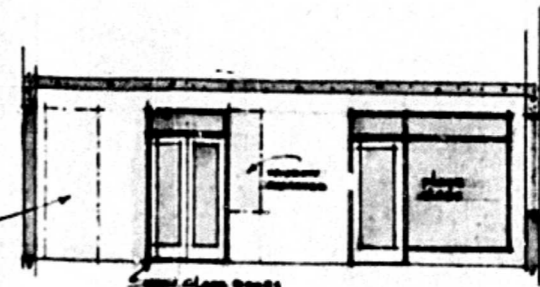


SECTION

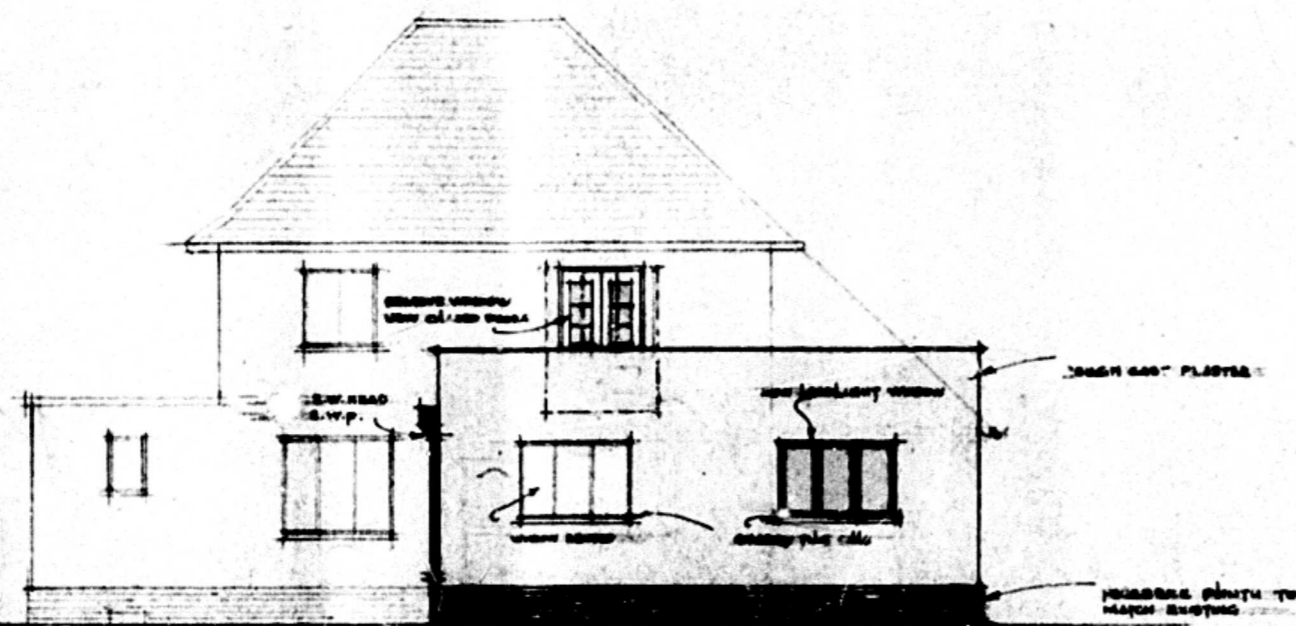


REAR ELEVATION

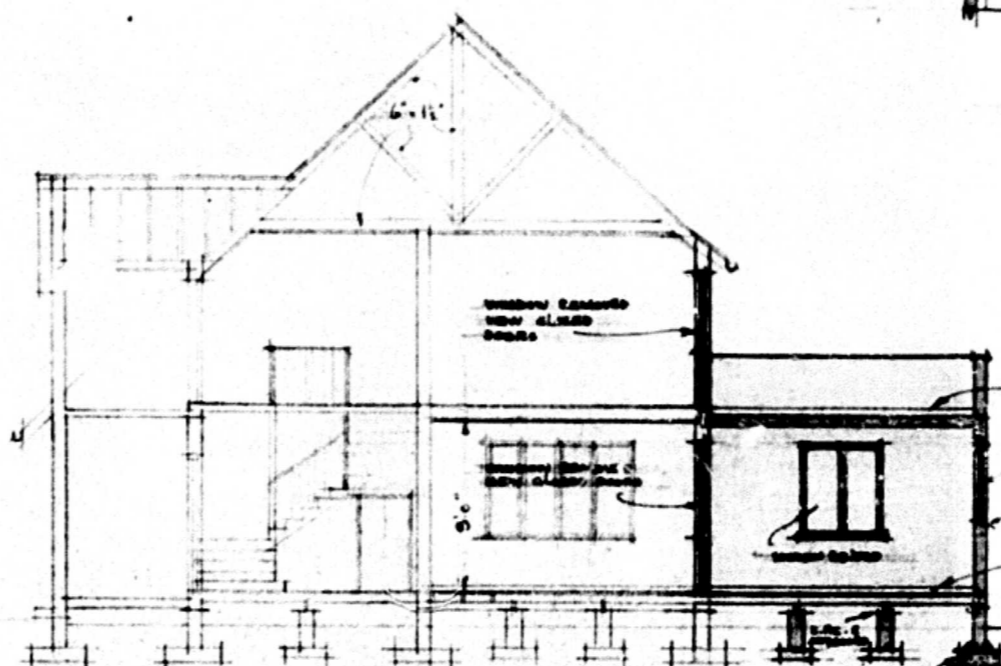



SECTION

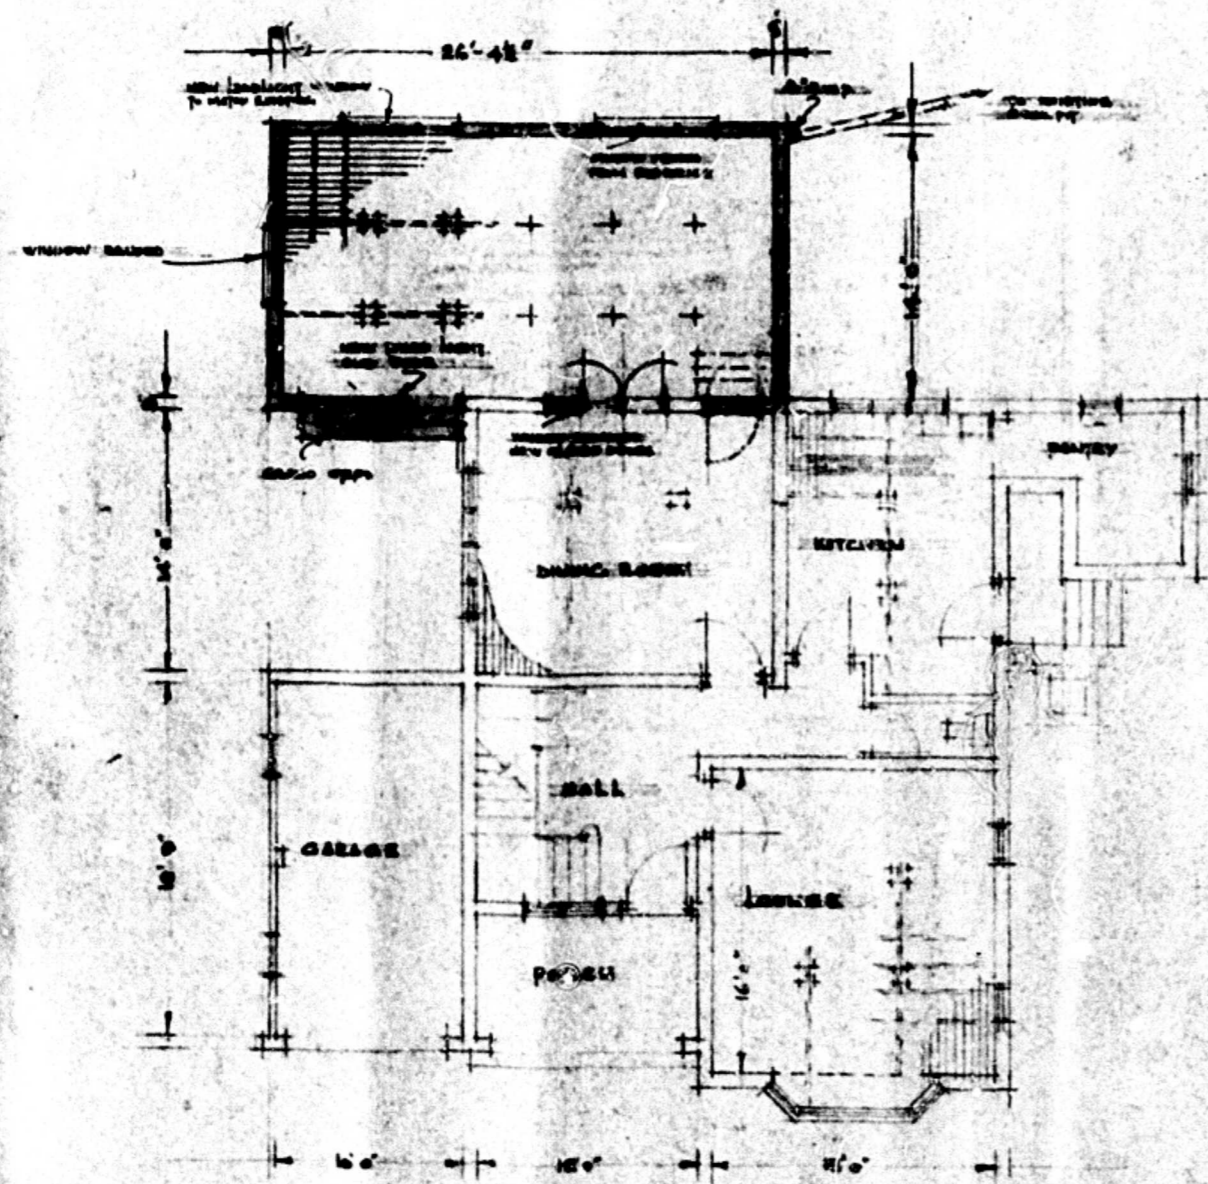

GROUND FLOOR PLAN

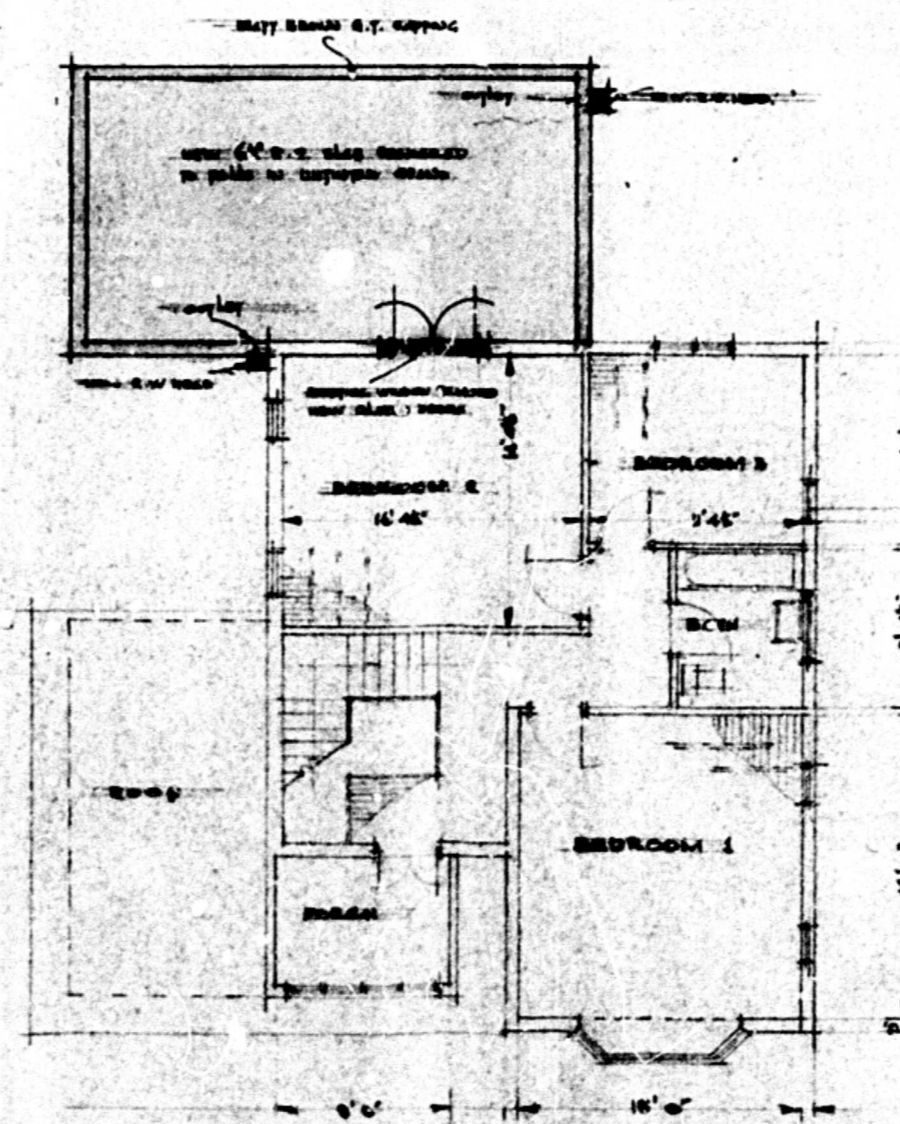


FIRST FLOOR PLAN

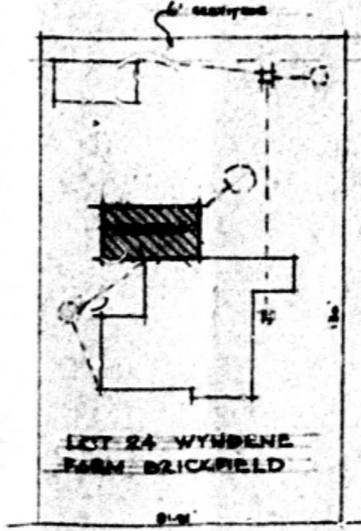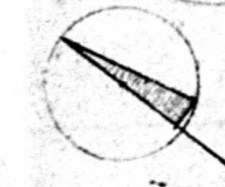


BLOCK PLAN 40' x 110'


Handwritten notes and numbers: 1-10-5, 1-12-5, 20, 3

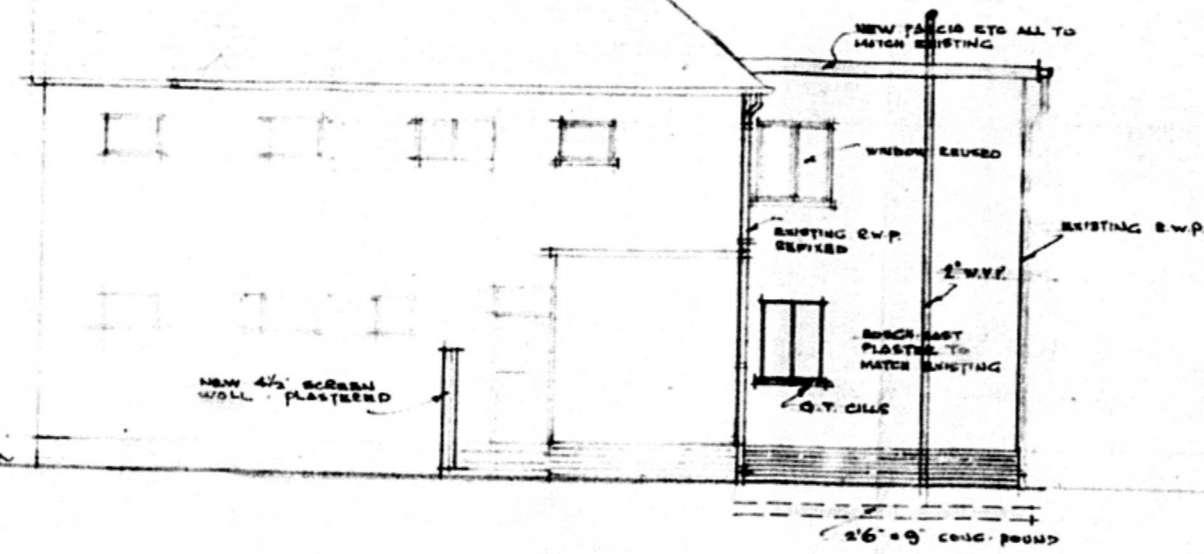


- EAST ELEVATION -

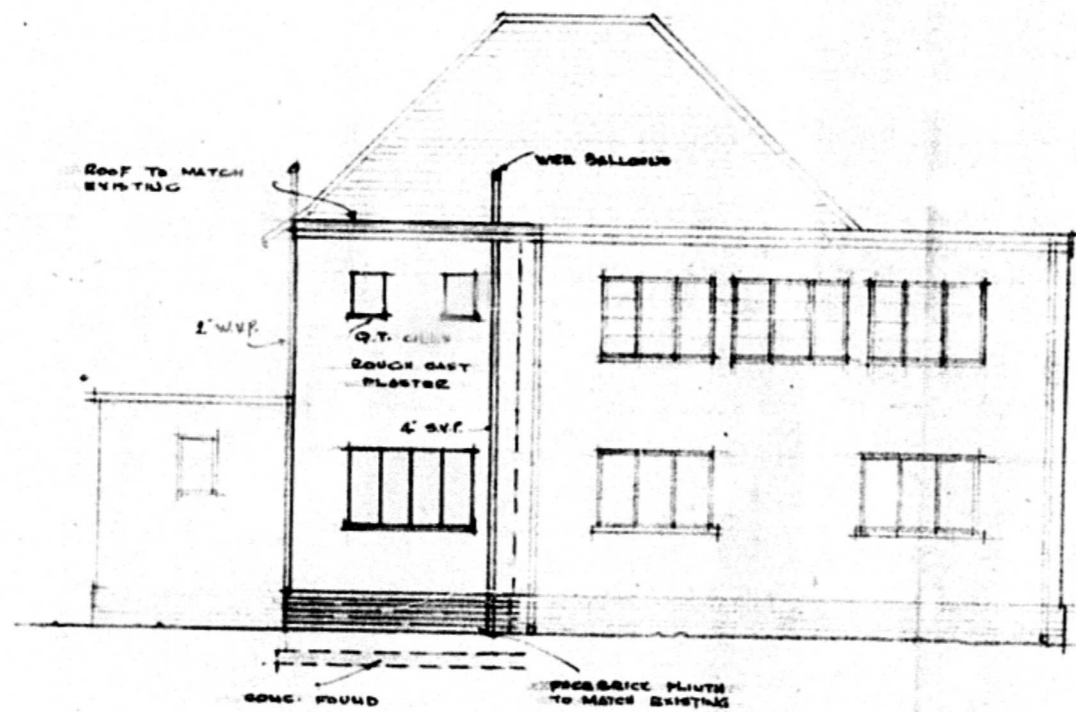


- REAR ELEVATION -

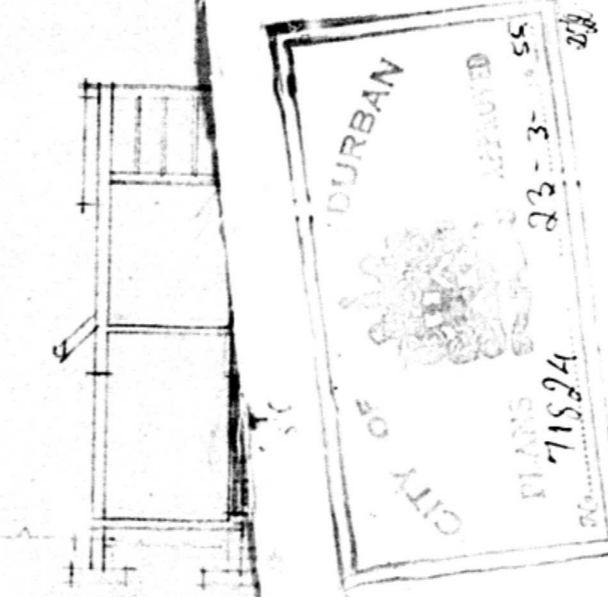

*Slab of reinforced concrete  
slab required*  
H. S. ...  
10 Christland Rd.

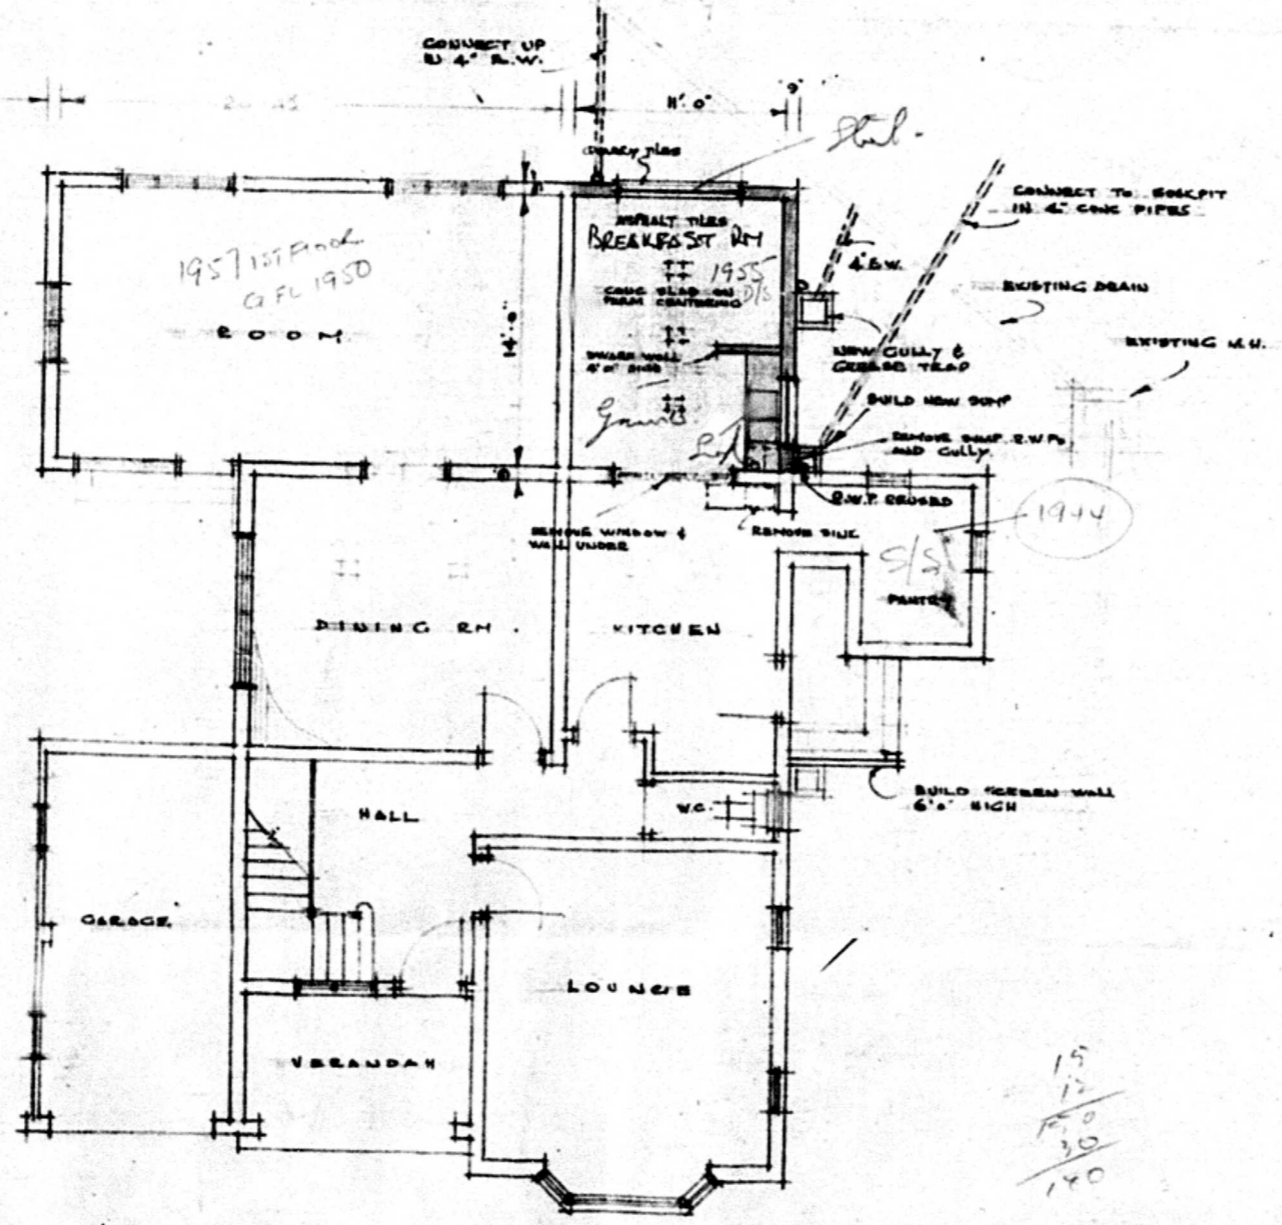


- GROUND FLOOR PLAN -

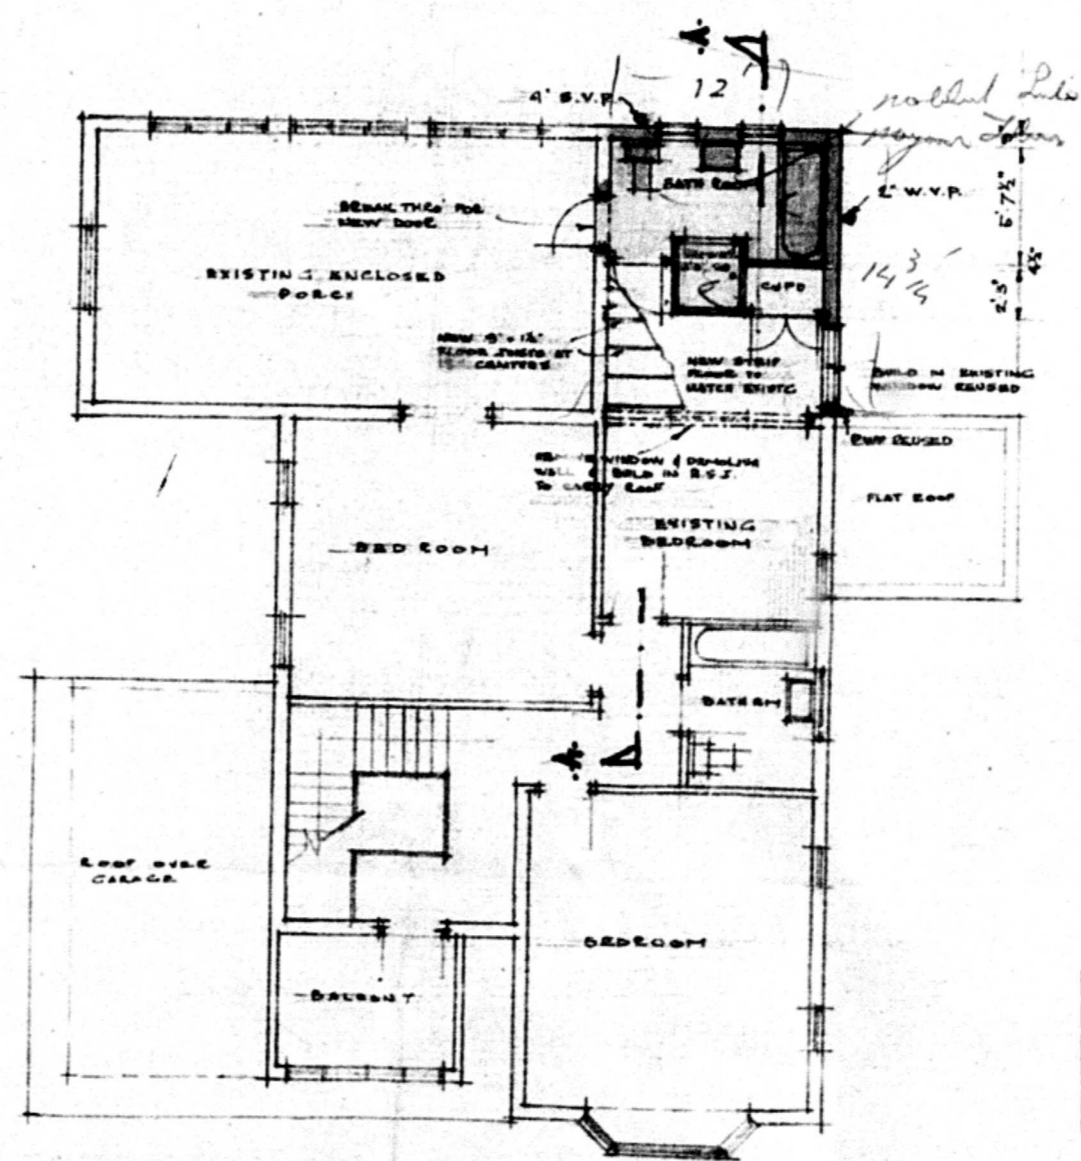

- FIRST FLOOR PLAN -

PLUMBING INSPECTORIAL  
PLAN APPROVED 26. 2. 58  
L. of Mrs. S. ...  
SUBJECT TO:


SEWERAGE FEES  
CONNECTION FEE: 7/11/-  
INSPECTION FEE: 7/11/-

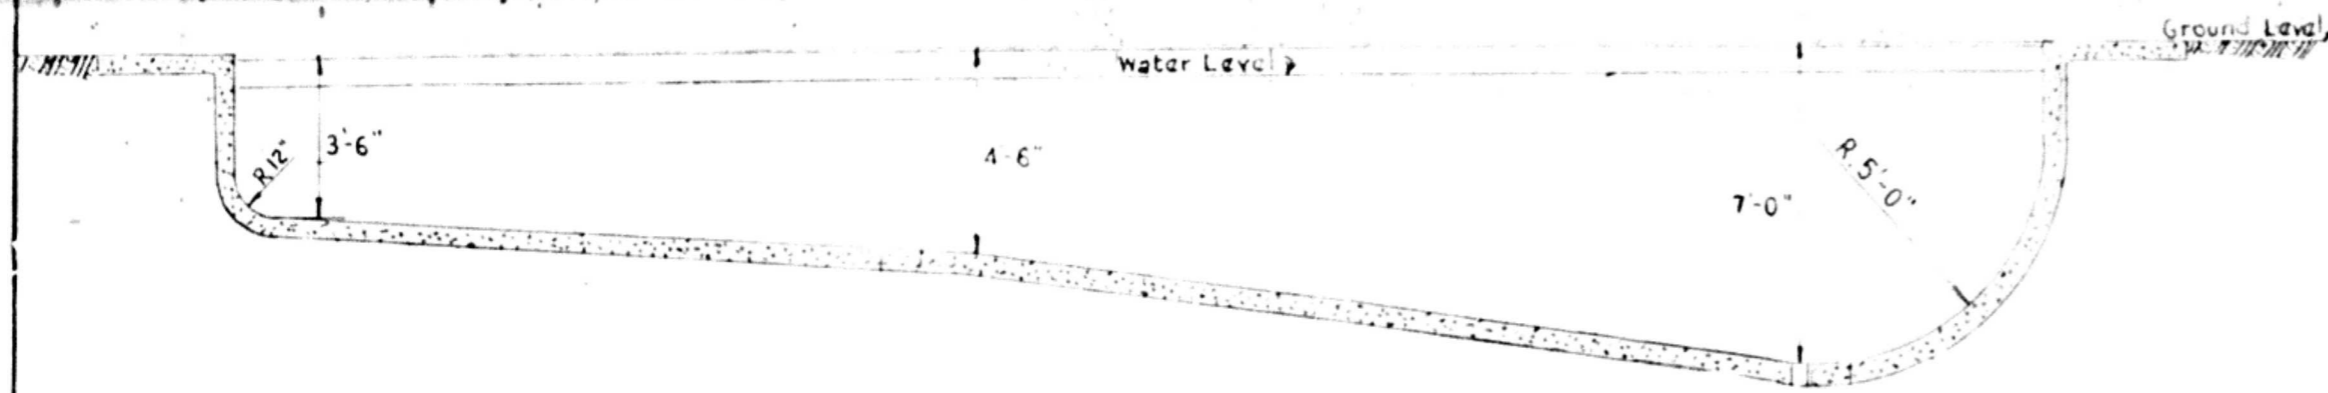

SECTION A-A

**NOTES**

1. EARTH LEAKAGE PROTECTION TO BE FITTED TO ALL ELECTRICAL SUPPLY
2. PRECAUTIONS TO BE TAKEN IN REGARD TO CONDENSATE
3. PRECAUTIONS TO BE TAKEN AGAINST FLOODING SEEPAGE AND RAINWATER IN SUNKEN PUMP CHAMBER AND FILTER UNIT
4. PUMP CHAMBER TO BE ADEQUATELY DRAINED
5. PLANT ARRANGEMENT AND FIXING TO SUPPLIERS REQUIREMENTS
6. EXCAVATED SOIL TO BE REMOVED FROM SITE BY OWNER
7. NEW 1/2" Ø WATER CONNECTION TO BE METERED
8. WASTE WATER: ~~OVER SITE~~ / TO B.P.T. TO EXISTING SEWER

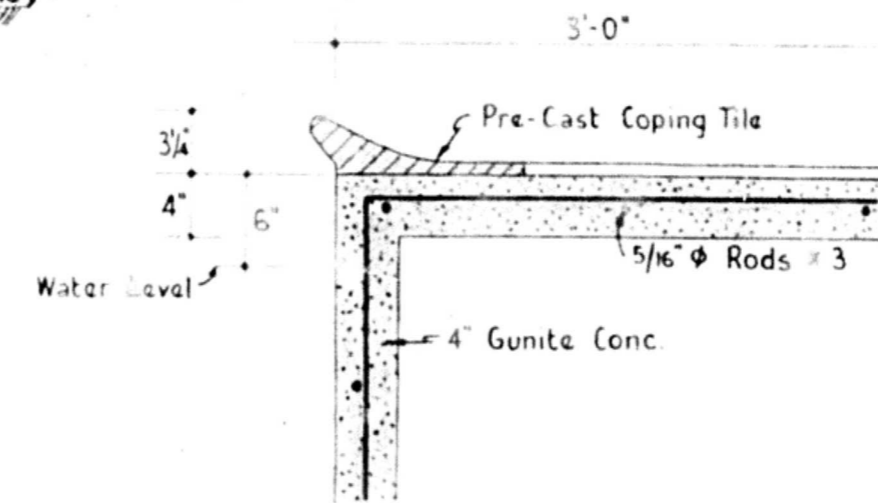


SURROUND BEAM DETAIL

SCALE 1" TO 1'

CHAINAGE	0.0	6.0	32.0
GROUND LEV.	7.04	7.31	6.07
INVERT LEV.	6.01	6.58	6.02


SEWER SECTION

SCALES: HOR. 1" TO 20'  
VER. 1" TO 5'

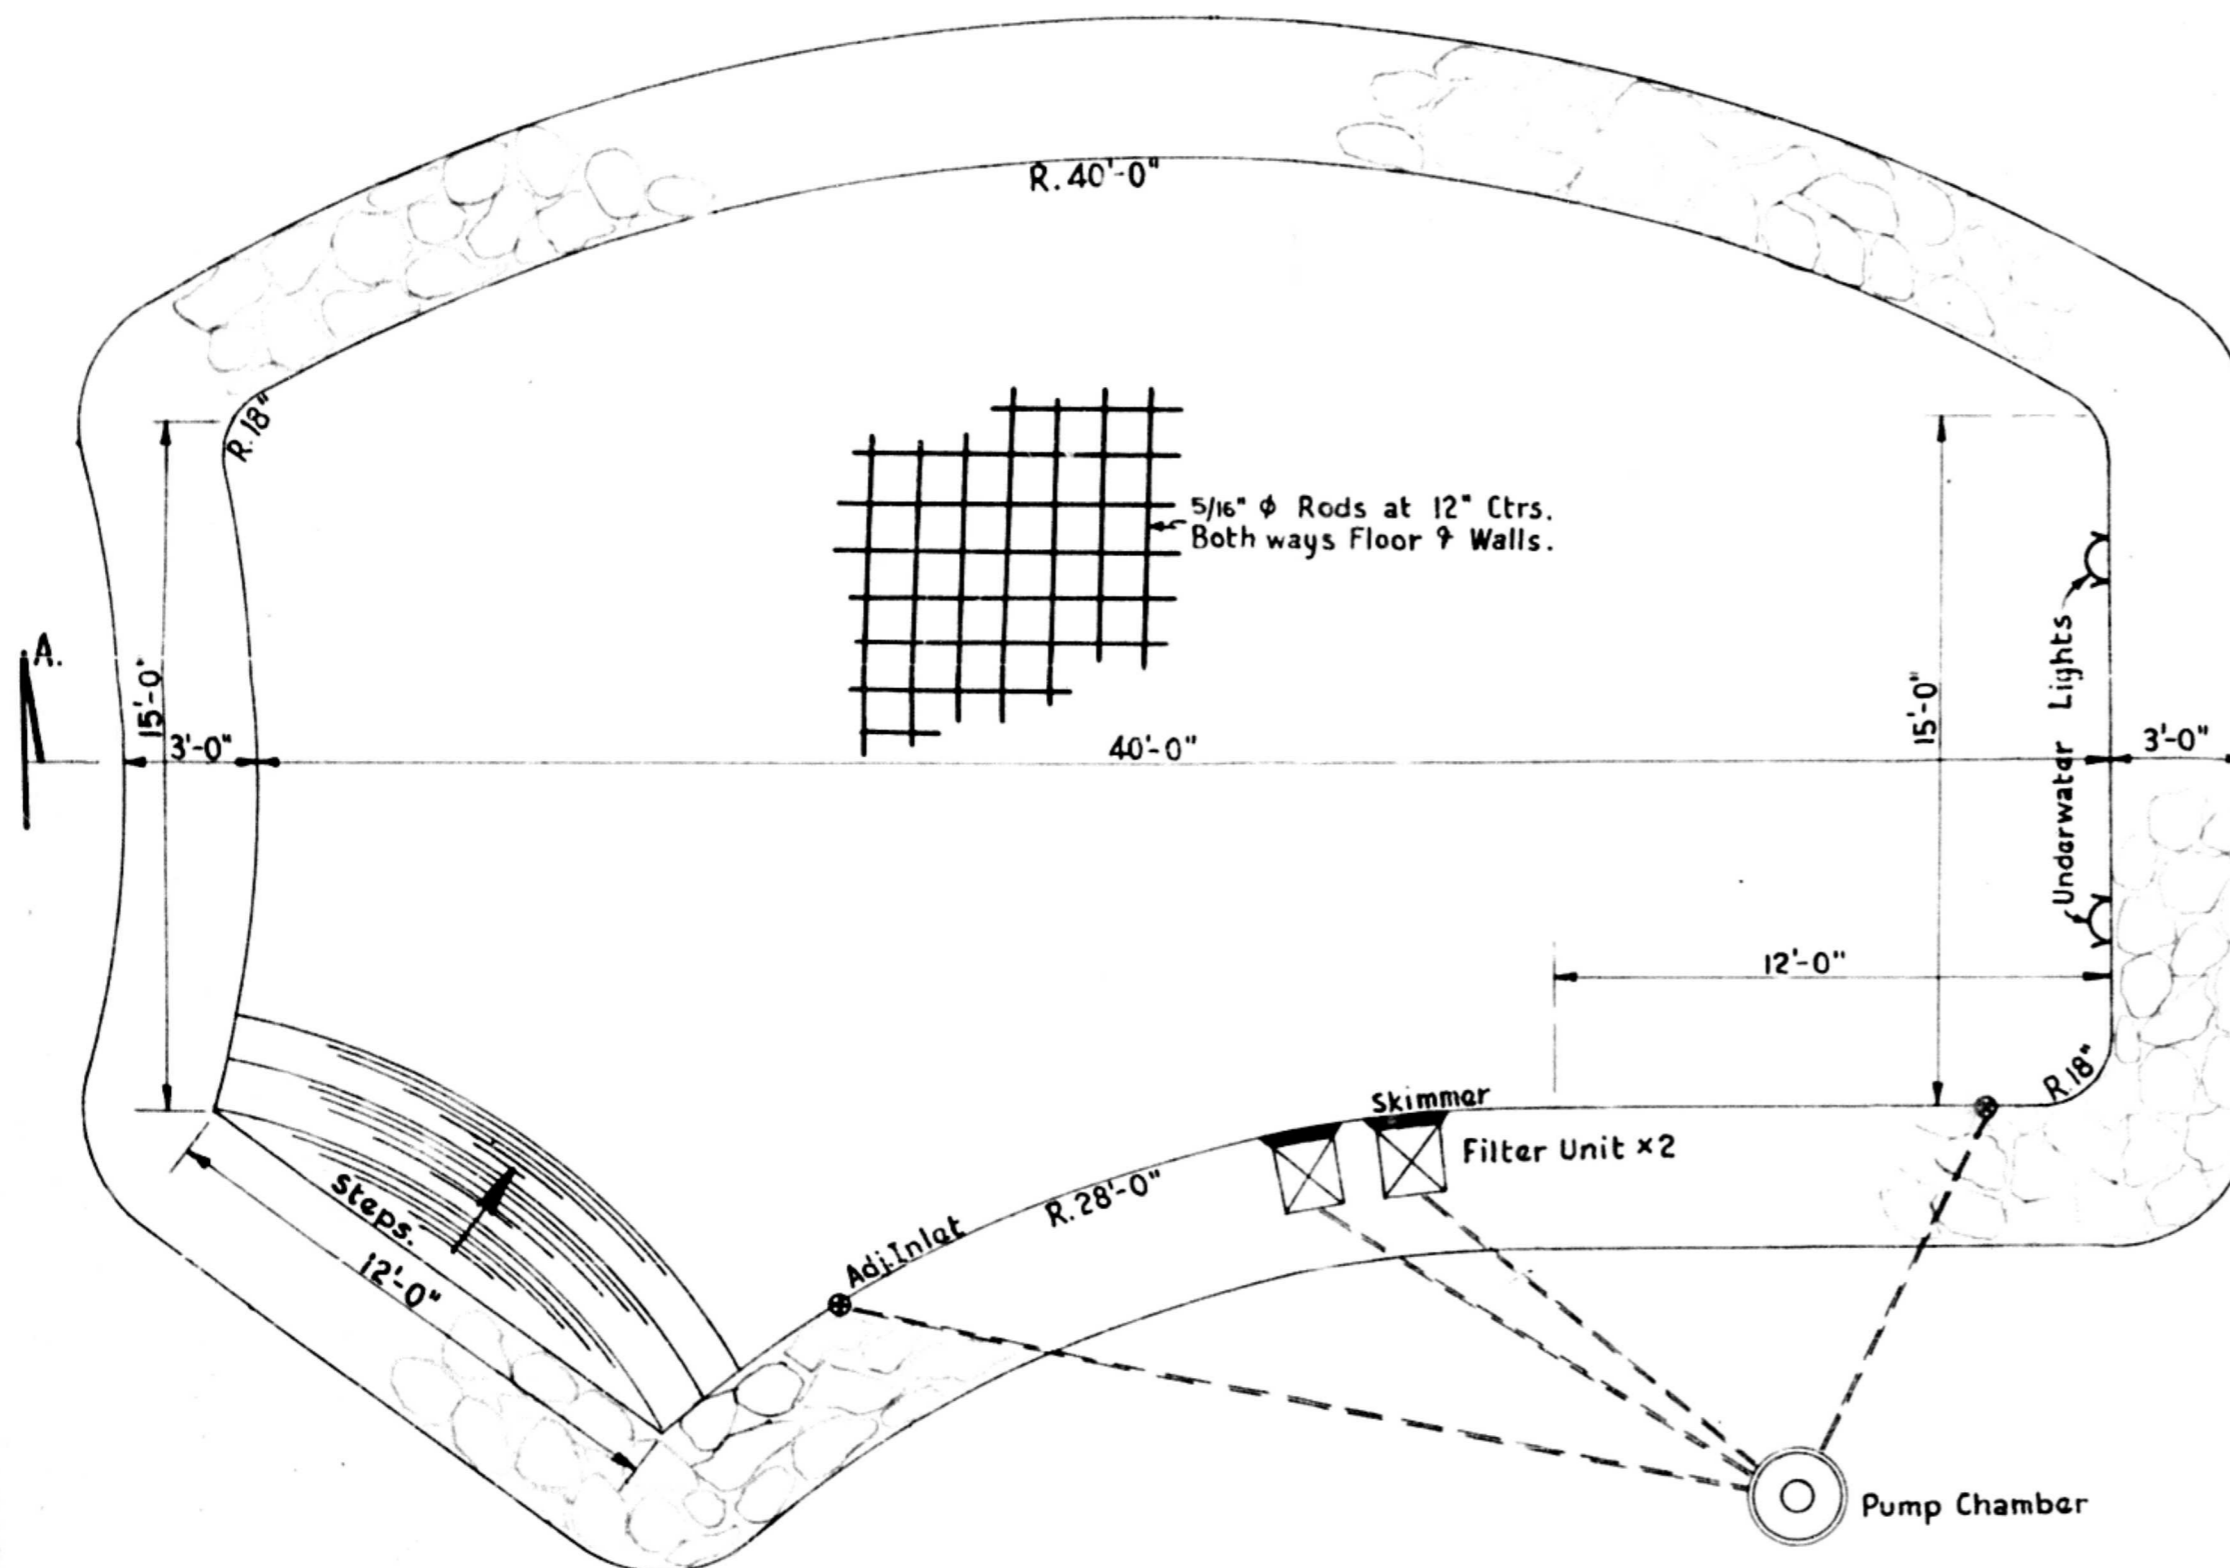

PLAN

SCALE 1/4" TO 1'

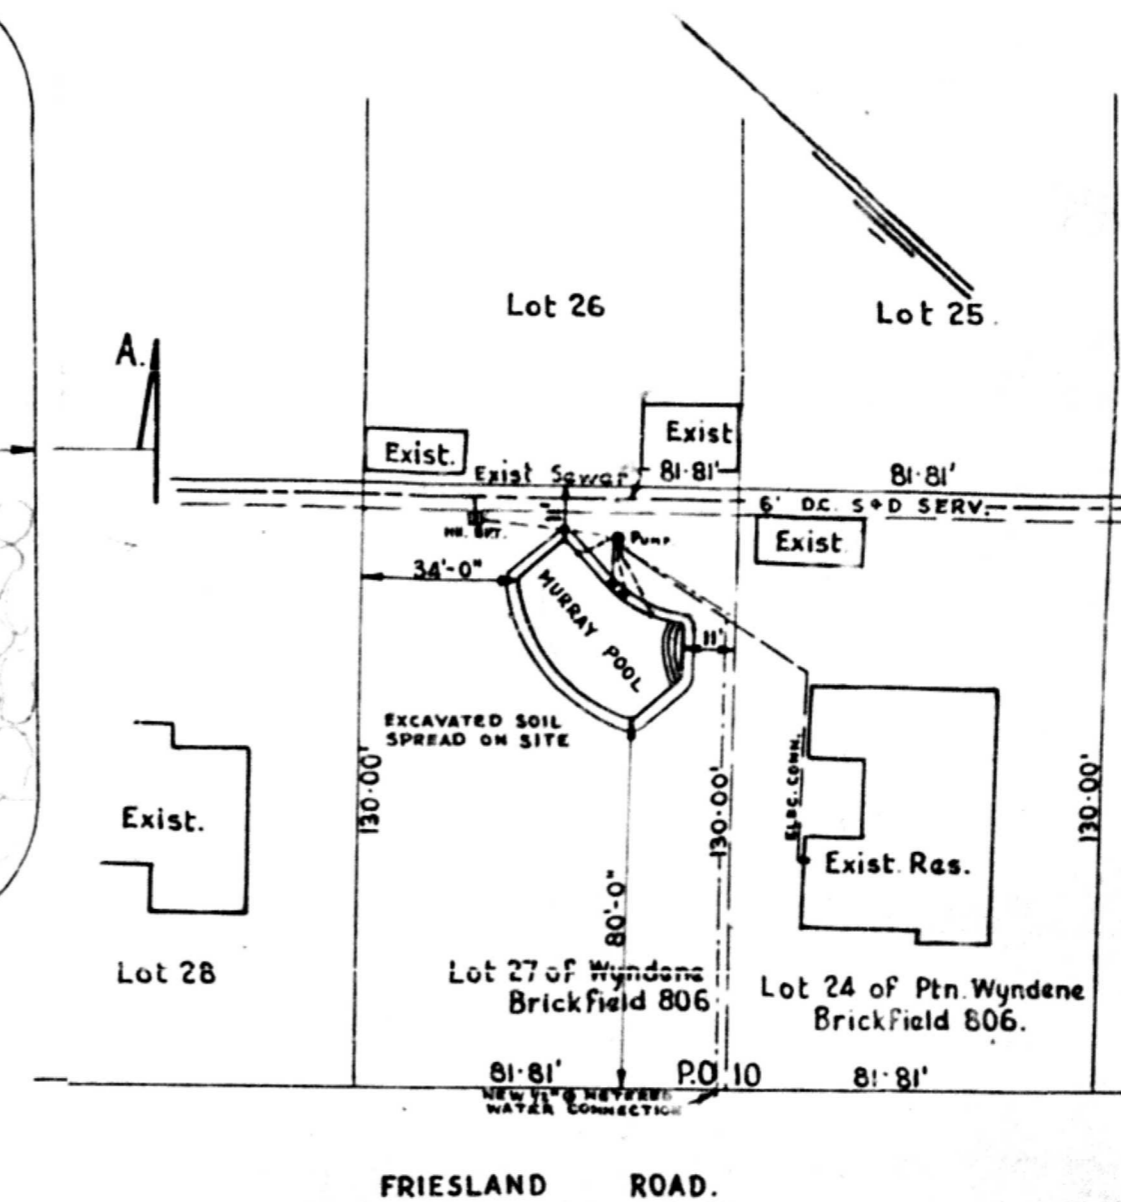

SITE PLAN

SCALE 40' TO 1"


1	COPY	2
CITY OF DURBAN		
PLAN NO.	393/11/69	
APPROVED	18.1.1970	
C. G. HANDS	DATE	
CITY ENGINEER	PER	

F.  
10 Friesland Rd.  
Swim Pool

PROPOSED MURRAY SWIMMING POOL FOR  
J.D. AIREY ESQ.  
AT 10 FRIESLAND ROAD DURBAN

CHECKED BY:	COASTAL POOLS (PTY) LTD.	
	379 UMBILO ROAD	TEL. 35-8104
	DRAWN BY	DATE
	18.11.69	
	TYPE	DRAWING NO.
	BOLERO	MUR 7H/9

REAR ELEVATION

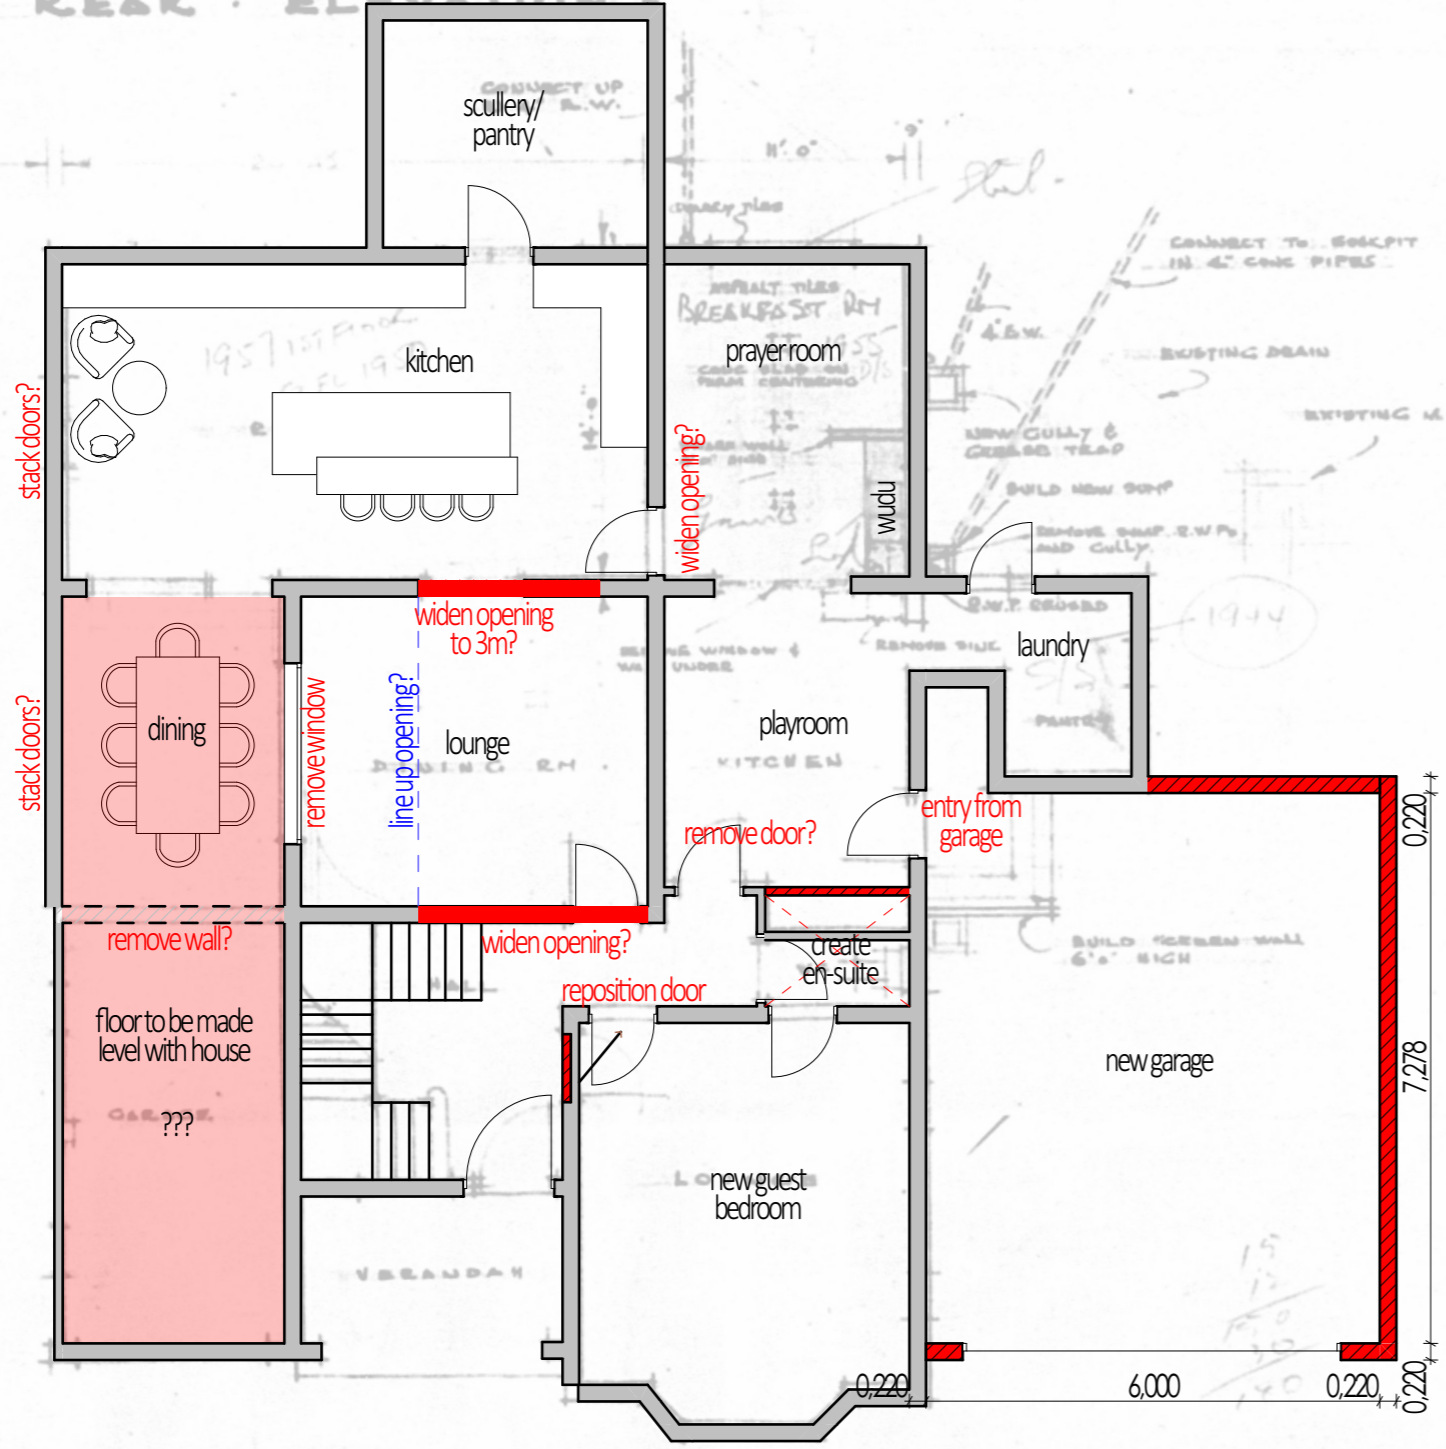

SECTION A-A

