

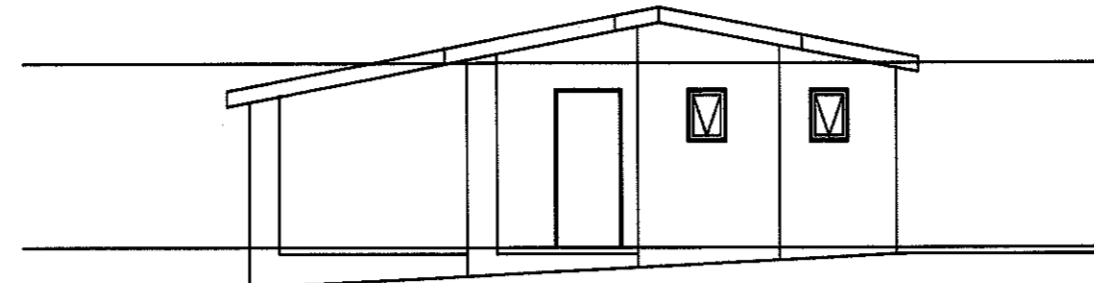




SIDE ELEVATION
Scale 1:100

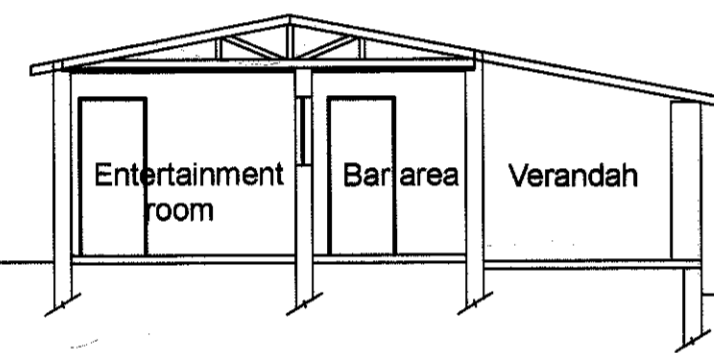


SIDE ELEVATION
Scale 1:100

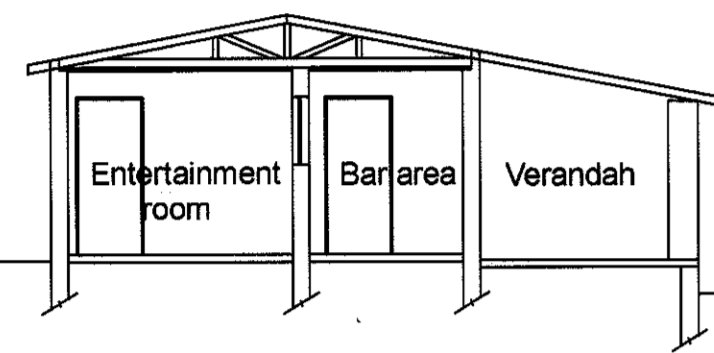


SITE SECTION
Scale 1:100

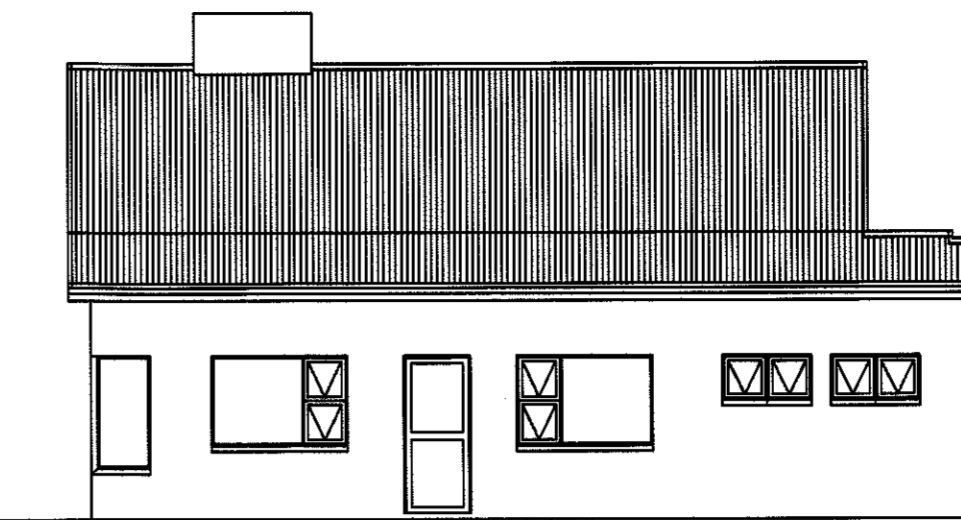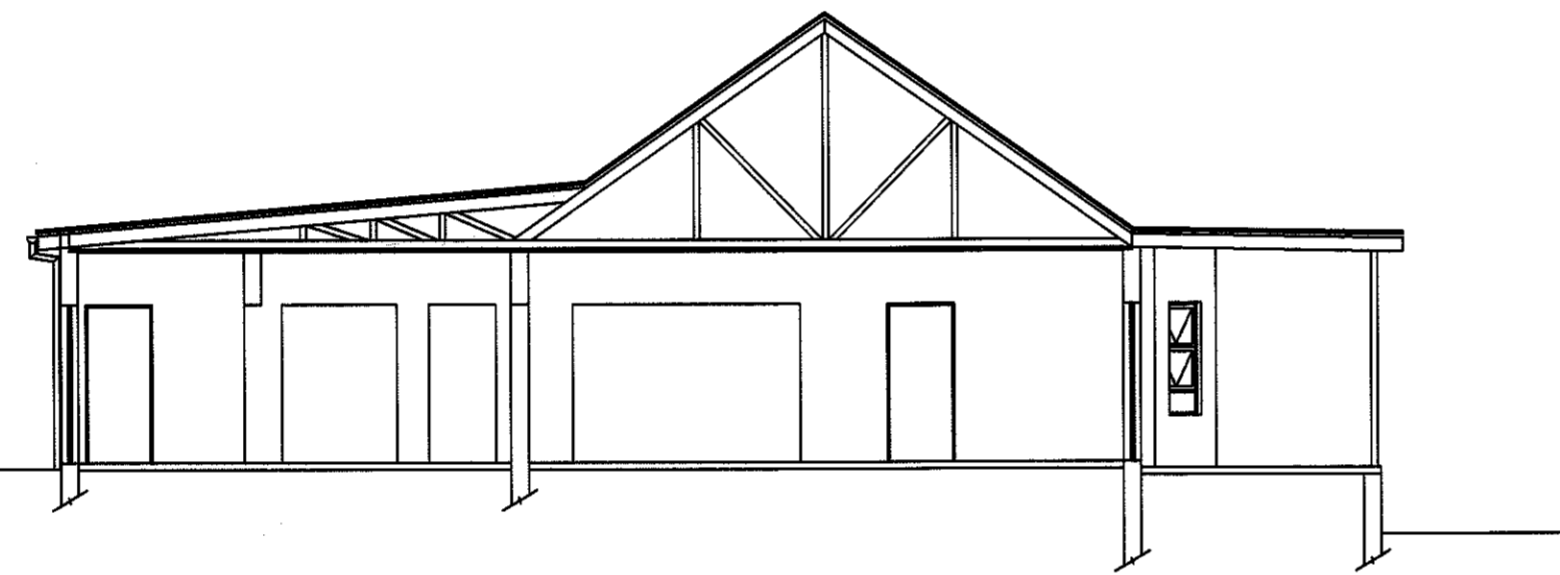

REAR ELEVATION
Scale 1:100

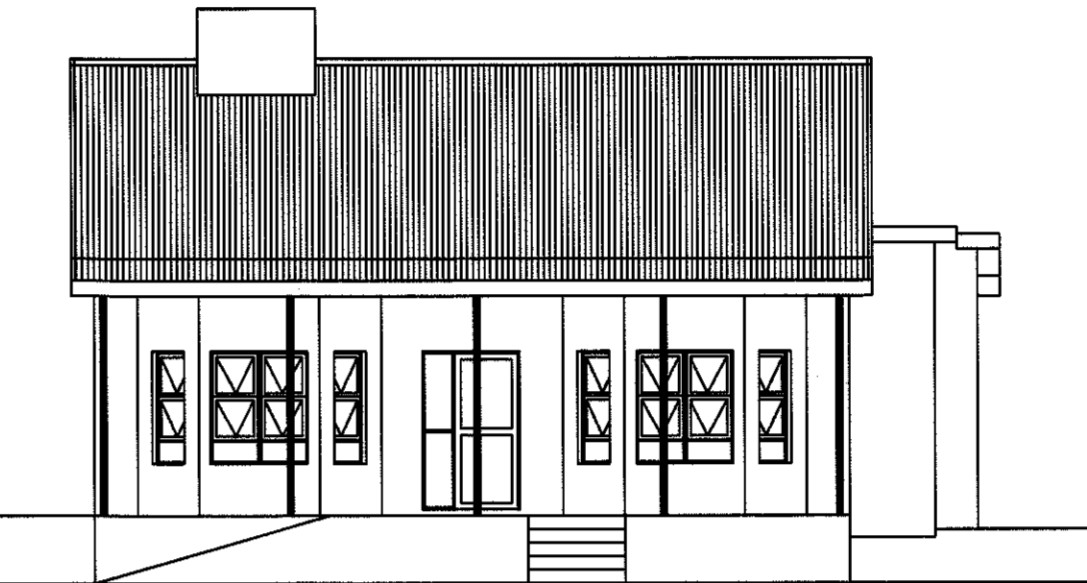

FRONT ELEVATION
Scale 1:100

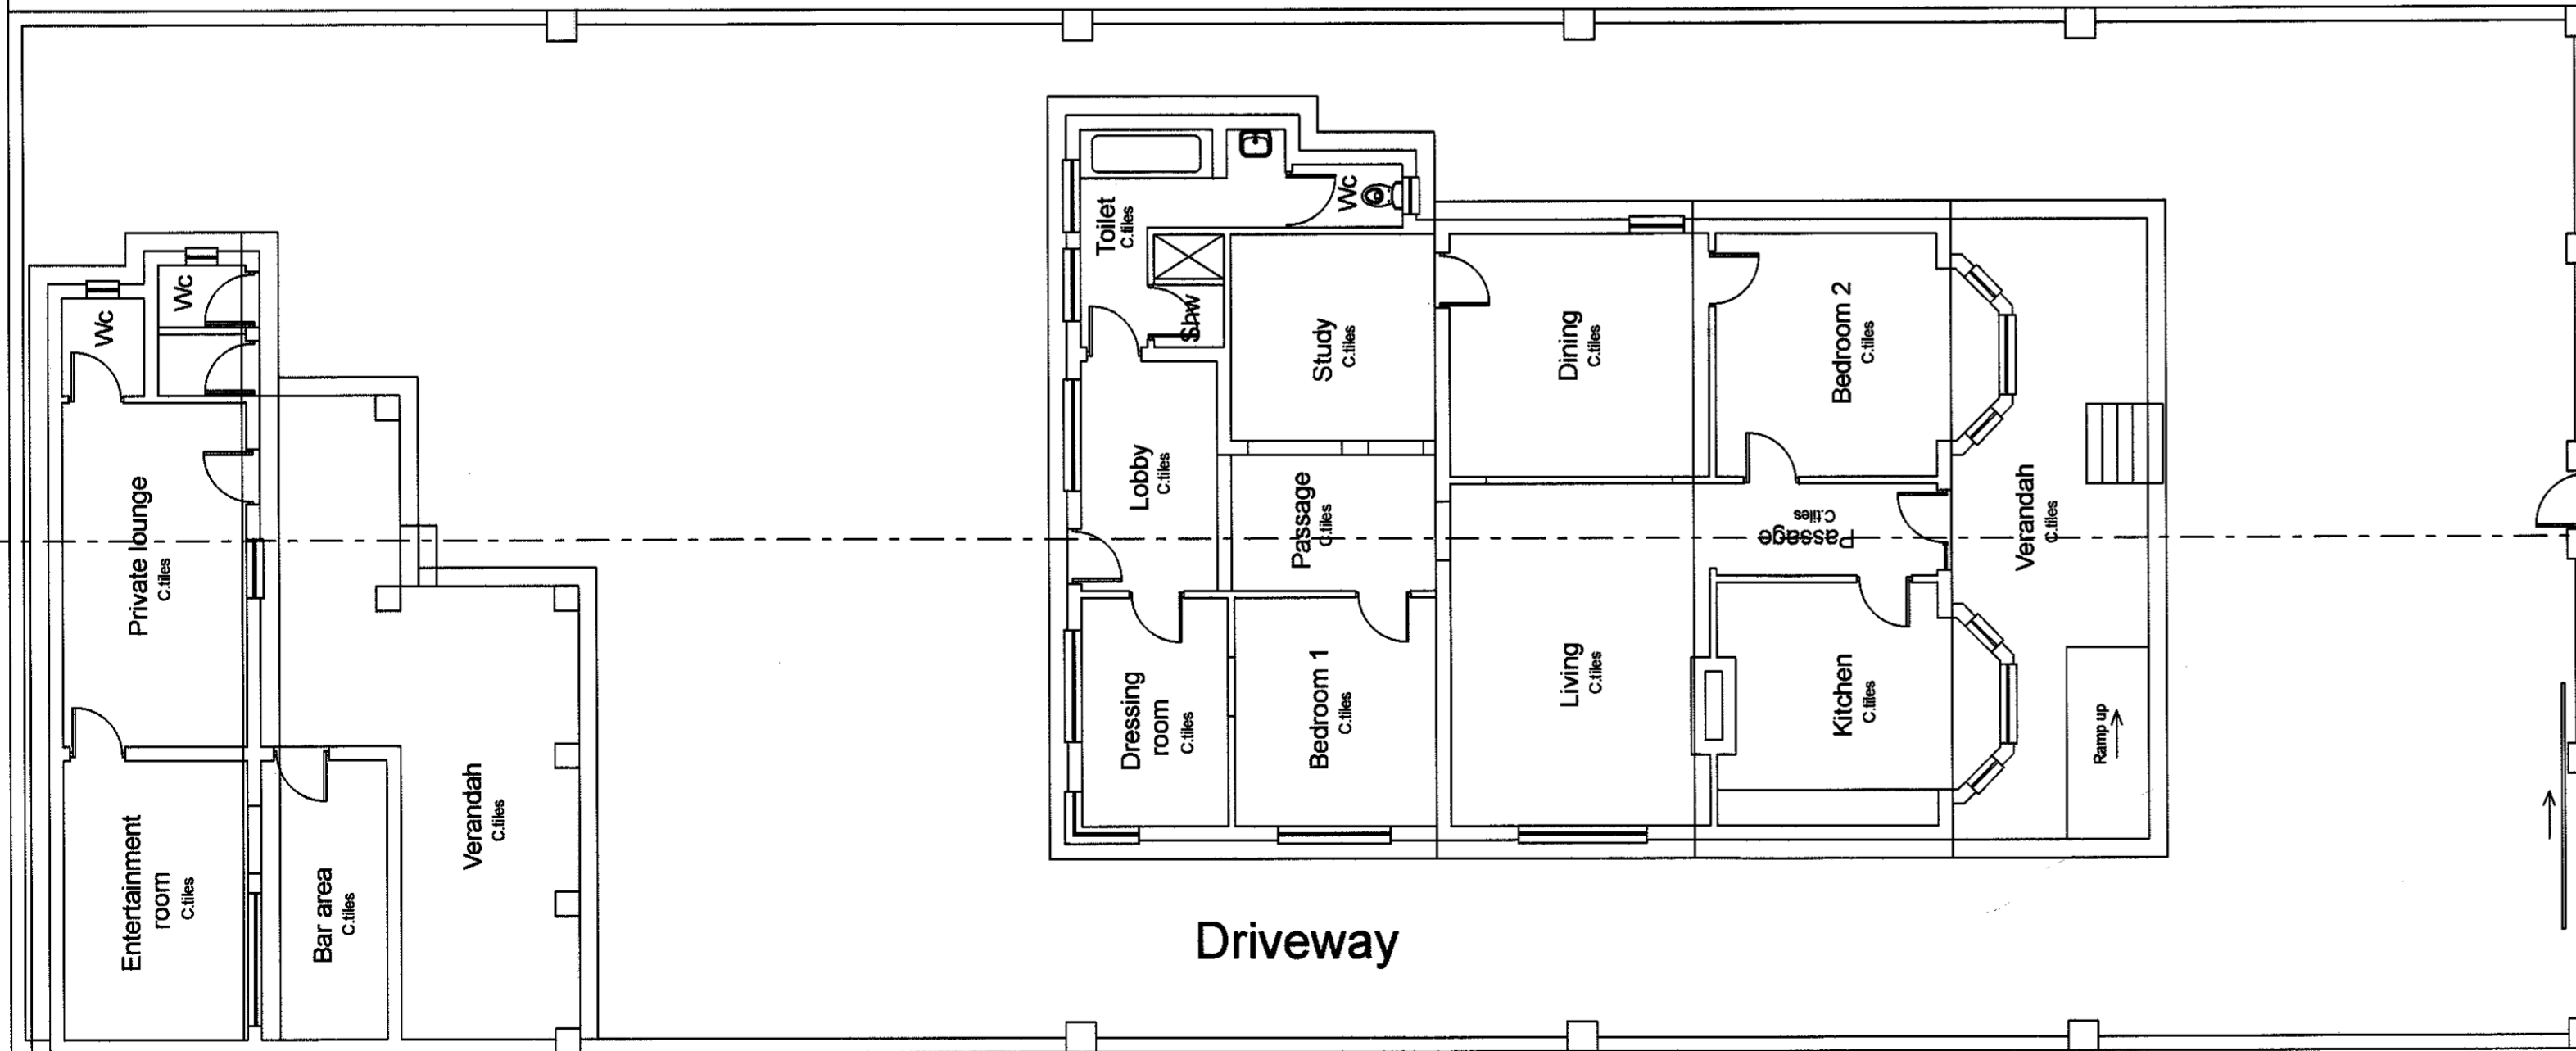

SITE LAYOUT PLAN
Scale 1:100

GENERAL NOTES:

ALL WORK TO COMPLY WITH THE NATIONAL BUILDING REGULATIONS AND LOCAL BY MUNICIPALITY BY-LAWS
 ALL LEVELS AND DIMENSIONS TO BE CHECKED ON SITE PRIOR TO COMMENCEMENT OF ANY WORK
 ALL DRAWINGS MUST BE CHECKED AND ALL DIMENSIONS MUST BE CONTROLLED ON SITE BEFORE ANY MATERIALS ARE ORDERED
 DISCREPANCIES MUST BE BROUGHT TO THE IMMEDIATE ATTENTION OF THE AUTHOR
 ALL PLUMBING BY REGISTERED CONTRACTOR
 ALL ELECTRICAL BY REGISTERED CONTRACTOR
 ALL GLAZING TO COMPLY WITH PART 'N' OF SANS 10400
 IF ON EXCAVATION IT IS FOUND TO CONTAIN POOR SOIL CONDITIONS, THEN ALL FOUNDATIONS ARE TO BE BUILT TO PROFESSIONAL ENGINEERS DETAILS AND UNDER HIS / HER SUPERVISION

Copyright is reserved on all drawings and designs.

*420 Pietmaritz PMB:
 Nkomo Tshikwasa
 [Signature]*

*10 Bourke Str.
 SADHASIVAN
 SOVENDER.
 [Signature]*

*14 Bourke Str.
 MAHMOUD EBRAHIM*

*413 Pietmaritz Str.
 Mrs. NKWANYANA
 [Signature]*

AUTHOR'S SIGNATURE:.....

CLIENTS SIGNATURE:.....

REVISION:

No.	Date	Description

Project **PROPOSED MEDICAL CENTRE FOR: DR X. NTOMBELA**

Cadastral description

Drawing description **AS BUILTS DRAWINGS**

Drawn	s.d.	Checked	s.d.
Date	00 / 00 / 00	Drawing No	
Scale	As shown	A00 - 00 / 00 / 00	