

**LOCALITY PLAN**

**R.T.I. Directorate**

Name : \_\_\_\_\_  
Signature : \_\_\_\_\_  
Date : \_\_\_\_\_

**Road Safety Directorate**

Name : \_\_\_\_\_  
Signature : \_\_\_\_\_  
Date : \_\_\_\_\_


**P.T.E.S. Directorate**

Name : \_\_\_\_\_  
Signature : \_\_\_\_\_  
Date : \_\_\_\_\_  
Name : \_\_\_\_\_  
Signature : \_\_\_\_\_  
Date : \_\_\_\_\_

- E 2017/09/22 Flat roof, water tanks and solar panels to New Building removed
- D 2017/05/09 Updated to Client comments and requirements of meeting of 08/05/2017
- C 2017/03/24 Updated to Client comments and requirements of meeting of 23/03/2017
- B 2016/11/14 Updated to Client comments and requirements
- A 2016/09/26 Updated to as constructed drawings

NO.	DATE	AMENDMENTS AND REVISIONS
⊙		AMENDMENTS BEFORE CONTRACT COMMENCES
⊠		REVISIONS AFTER CONTRACT HAS COMMENCED

**PROVINCE OF KWA-ZULU NATAL**  
**DEPARTMENT OF TRANSPORT**  
PRIVATE BAG X9043  
PIETERMARITZBURG  
3200

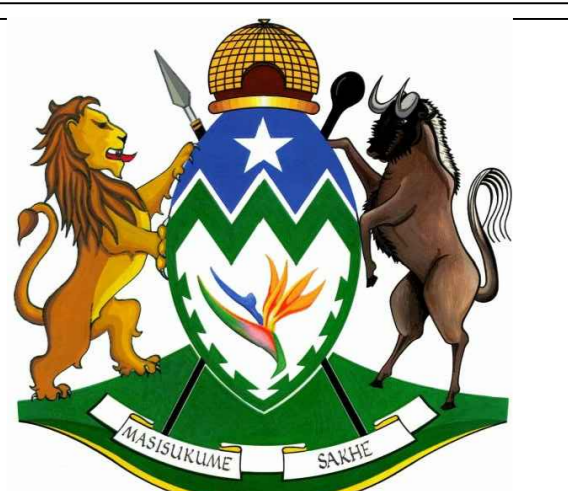

**L&R architects**

9 Wally Hayward Drive  
Ashburton  
Pietermaritzburg  
3213  
Tel : (+27) 33 326 1425  
Fax: (+27) 86 670 8694  
eMail: reesh@mweb.co.za  
eMail: admin@lrarch.co.za

PROJECT

PROJECT  
**DEPARTMENT OF PUBLIC WORKS**  
**REFURBISHMENT TO THEMBELETHU BUILDING**  
206 Burger Street  
Erven 2776 and 2777 Pietermaritzburg  
for  
**DEPARTMENT OF TRANSPORT**  
WIMS 060988

DRAWING DESCRIPTION  
NEEDS ASSESSMENT PLAN  
PLANS - FIRST FLOOR  
TABLE ROOM ALLOCATION

DRAWING NO. **060988 / A1 / 003** REV **E**

SCALE 1:100	CHECKED
FILE NO. <b>WIMS 060988</b>	CLIENT
DATE JUL 2016	DRAWN JKW

**A0**

0 10 20 30 40 50 60 70 80 90 100

Z:\Projects\L&R\_Architects\1611\_001\_206\_Burger\_Str.\_R&R\Drawings\1611-A1-003 - Needs Assessment\_Plan.dwg

