



REC'D IN THE OFFICE OF THE ENGINEER
1 FEB 1995
3:40

PROJECT COMPLETED
THE FOLLOWING
DEVIATIONS ARE NOTED


- 1 WASTE WATER DRAINS RE-DESIGNED.
- 2 SUSPENDED FLOORS FOR EN-SUITES, INSTALLED IN LIEU OF SUB FLOOR COMPACTION.

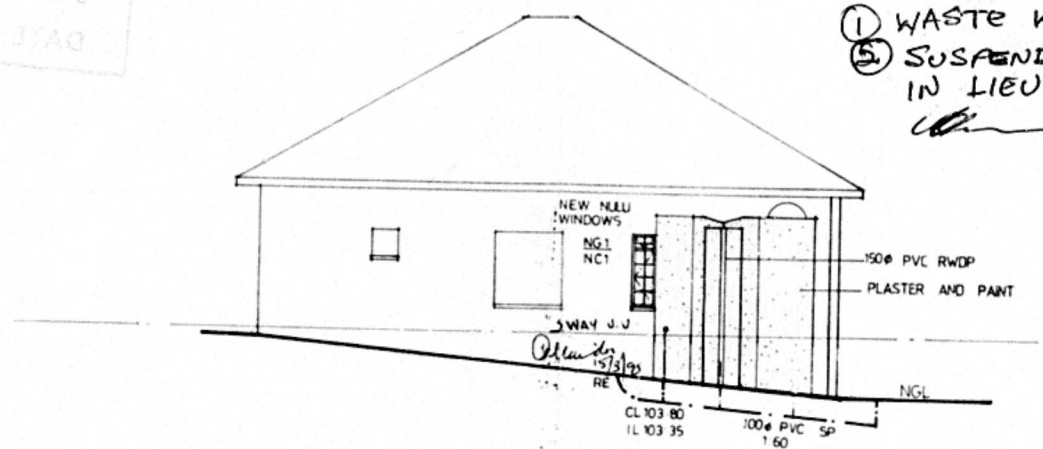


SOUTH WEST ELEVATION

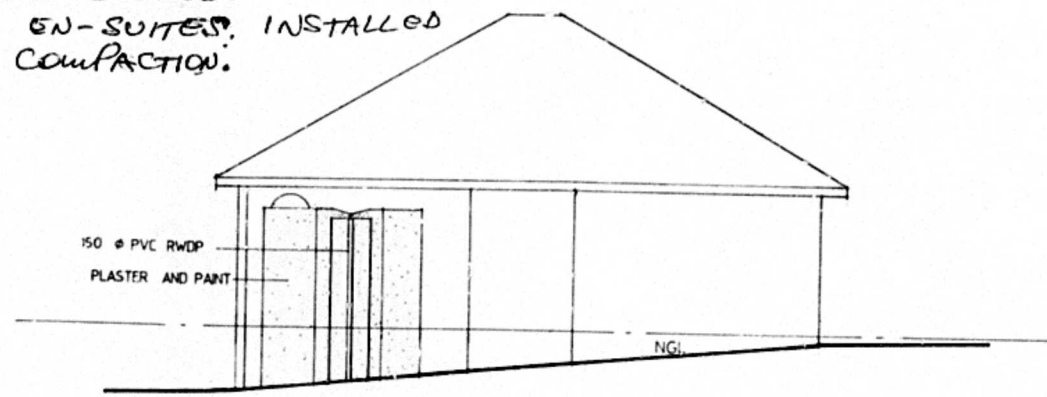

NORTH EAST ELEVATION

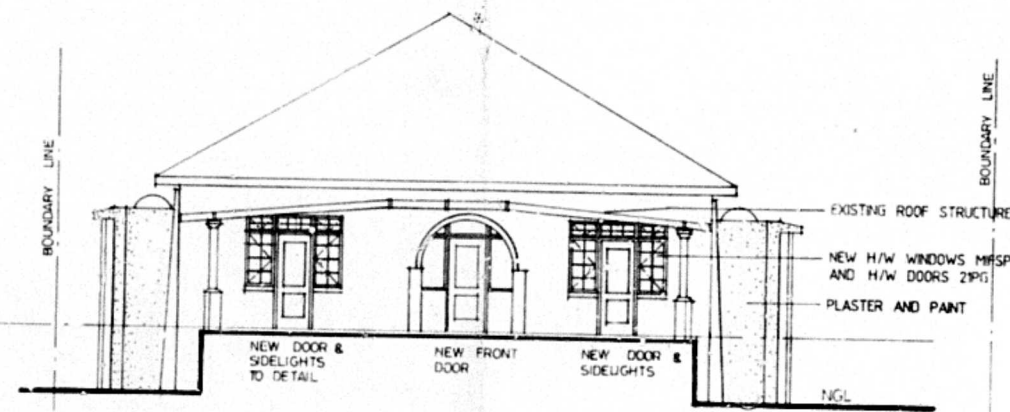

SECTION A-A

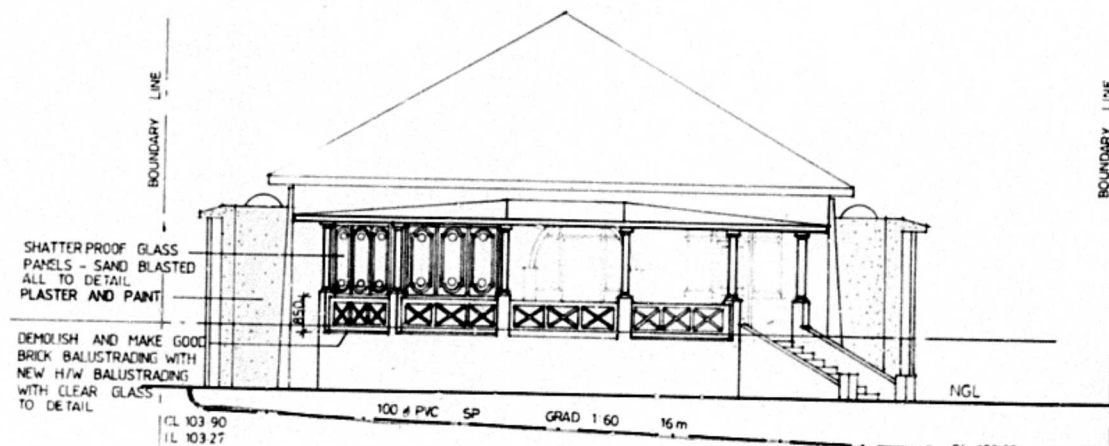

SOUTH EAST ELEVATION

BALUSTRADES, HANDRAILS,
HEIGHTS AND OPENINGS
TO COMPLY WITH
SABS 0400.

It should be noted that this plan has been approved on the basis of information thereon.

The author of the plan is responsible for:
(a) showing the application details;
(b) the correct level of entry into DC sewers, storm drains and discharge points;
(c) the form of foundation of any drainage works at a minimum depth of 0.250 metres below finished level;
(d) showing the measurement over DC manholes or any manholes services;
(e) showing the location of the constructed sidewalk or
(f) the location of the bank of the following foundation: PL = 0.150m + D
25
The author is responsible for:
(a) showing the level of the floor, ceiling, and roof structure in meters above the datum;
(b) showing the location of the proposed boundary;
(c) showing the location of the proposed boundary level is to be shown in meters above the datum;
(d) showing the location of the proposed boundary level is to be shown in meters above the datum.

DEVELOPMENT CONTROL DEPT.
TOWN PLANNING AUTHORITY
GRANTED
1995-03-12


ALL GLAZING TO COMPLY WITH PART N12 AND N13 OF SABS 0400.

Rev	Revision Description	Date


95/5/18
COPY 3
CITY OF DURBAN
PLAN NUMBER
0007-03-95-4 ✓
APPROVED: R. A. MOORE
EXECUTIVE DIRECTOR, PHYSICAL ENVIRONMENT SERVICE UNIT
1995-03-12
Approved 9/6/2000
AS BUILT

ELECTRICITY SERVICES
Any person undertaking electrical installations in accordance with the regulations must obtain the services of a registered electrician.
1) The location of any electrical conductors and services to the vicinity of the proposed works.
2) Requirements regarding protection, meter rooms and cable ducts.


ENGINEERS DETAILS REQUIRED

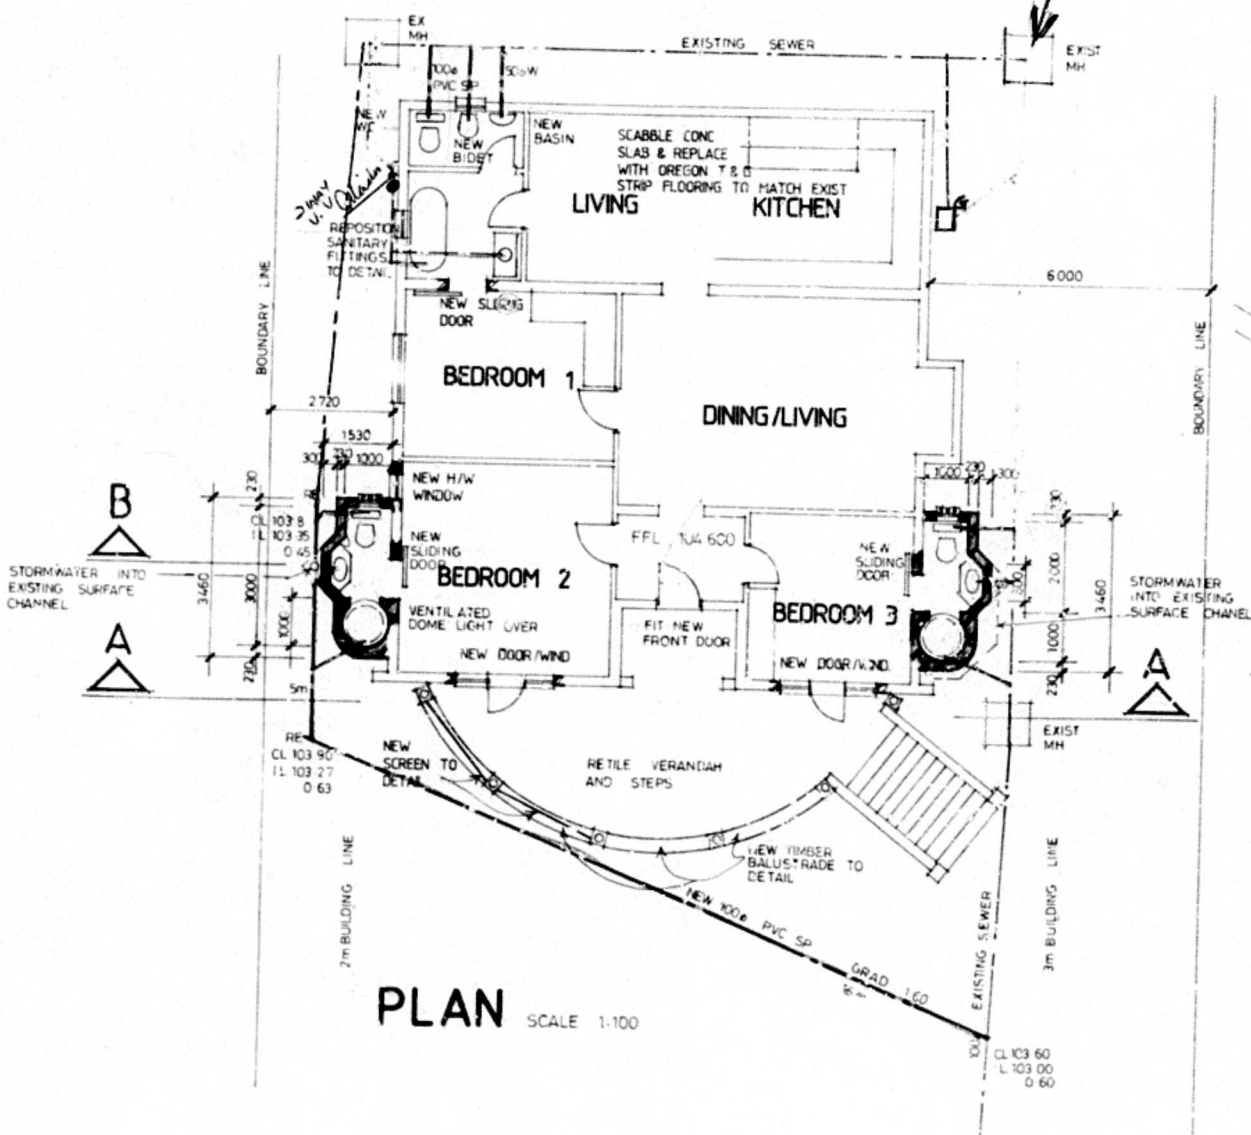

PLAN SCALE 1:100

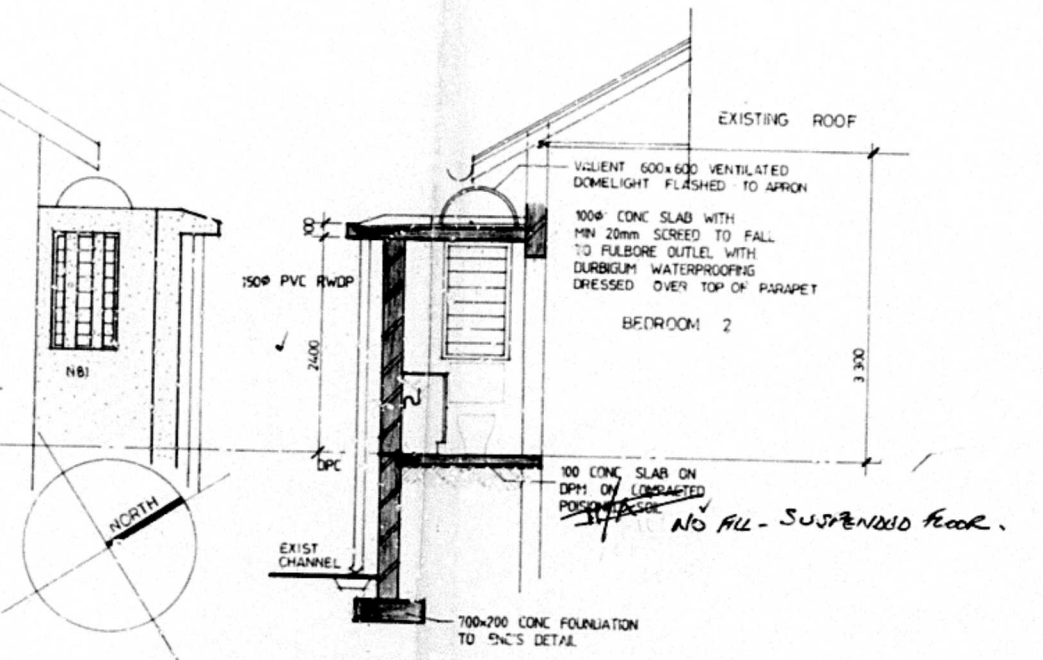

SECTION B B SCALE 1:50

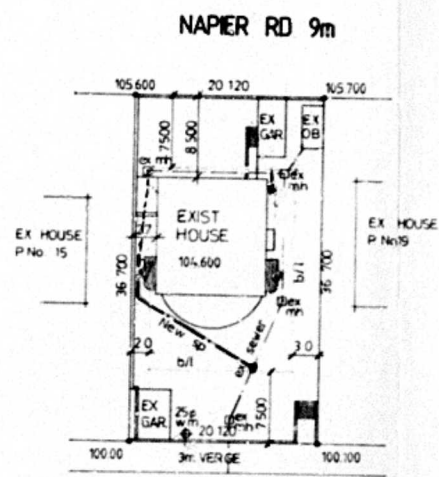

SITE PLAN SCALE 1:500

AREAS

SITE AREA	738.404
EXISTING FLOOR AREA	171.98
EXISTING O/BUILD	9.00
EXISTING GARAGE	35.50
NEW FLOOR AREA	9.00
TOTAL AREA	225.48
COVERAGE 40%	295.36

All existing wastes, drains, soil & vent pipes to conform to current National Building Regulations

SUBDIVISION AND LAND DEVELOPMENT SECTION
SITE PLAN CHECKED
1/3/95

Owners Signature: *[Signature]*

Client
ALTERATIONS & ADDITIONS TO HOUSE Mc GAW
17 COWEY ROAD
DURBAN

Cadastral & Site Description
33 OF LOT 30884
DURBAN

Scale	Date	Design	Drawn
1/100	FEB. 95	KA	CAH

MR KETH ALCOCK
OF THE
E.P.C.
MAB ARCHITECTS
MILAREN ALCOCK BEDFORD - PARTNERS
75 VALLEY VIEW RD DURBAN 4001
P.O. BOX 37069 OVERPORT 4067
TEL: (031) 303283 FAX: (031) 330496

Drawing Description
WORKING DRAWINGS

Project No.	Drawing No.	Revision
94045	WD01	