
LOCAL AUTHORITY STAMP ZONE: SPECIAL RESIDENTIAL 180 OCCUPANCY CLASSIFICATION: H3 REV REVISION Craig Moodley
197 Umhlanga Rocks Drive Durban North Tel: +27 (0)64 782 4179
craig@giarcdesigns.co.za
www.giarcdesigns.co.za ADDITIONS & ALTERATIONS
AS BUILT
ON: ERF 1969 &1970
AT: 186/190 UMGENI ROAD, DURBAN CLIENT S3A TRUST DRAWING TITLE SECTION A-A DATE 07/03/22
DRAWN JF CHECKED CM DRAWING SCALE 1:100 DRAWING NUMBER 2021_038_186/190 ASBUILTUMGENIRD_sheet 04

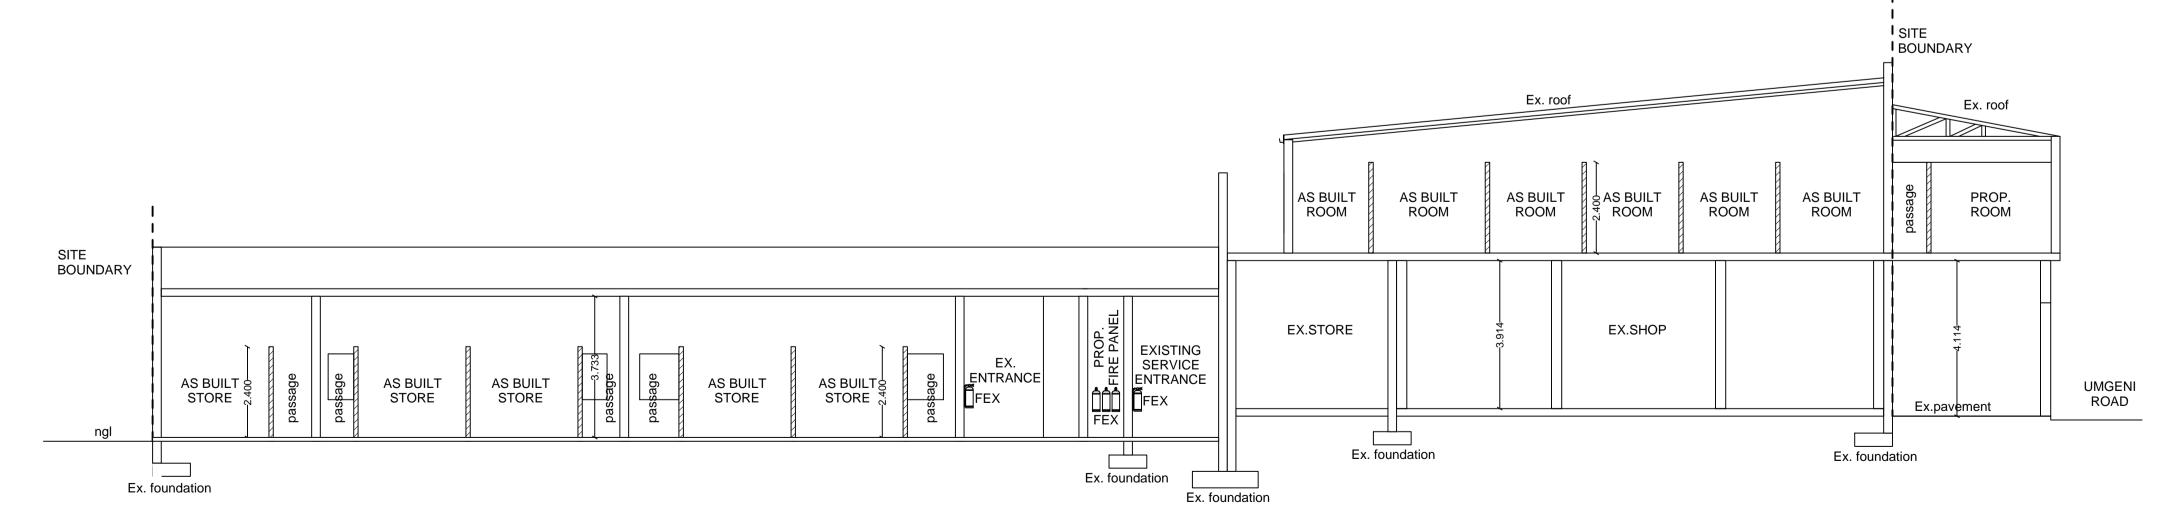

SECTION A-A SCALE - 1:100