




north west elevation

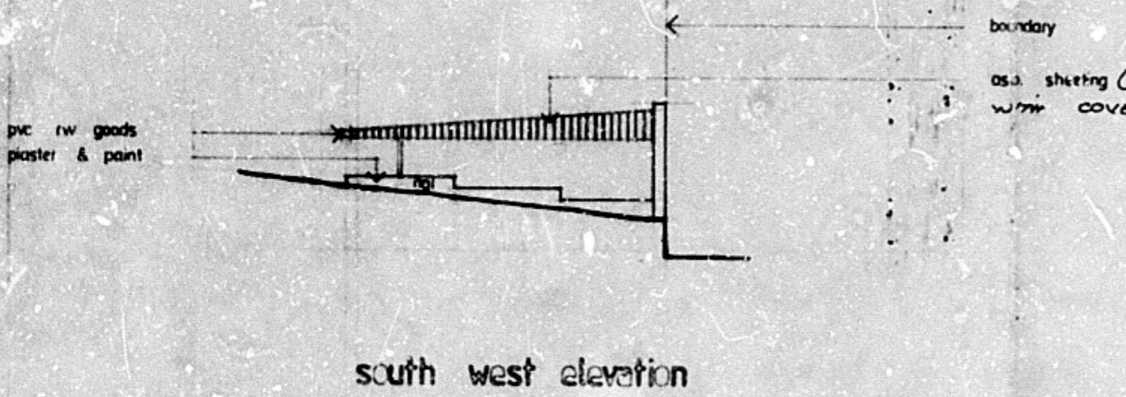


south west elevation

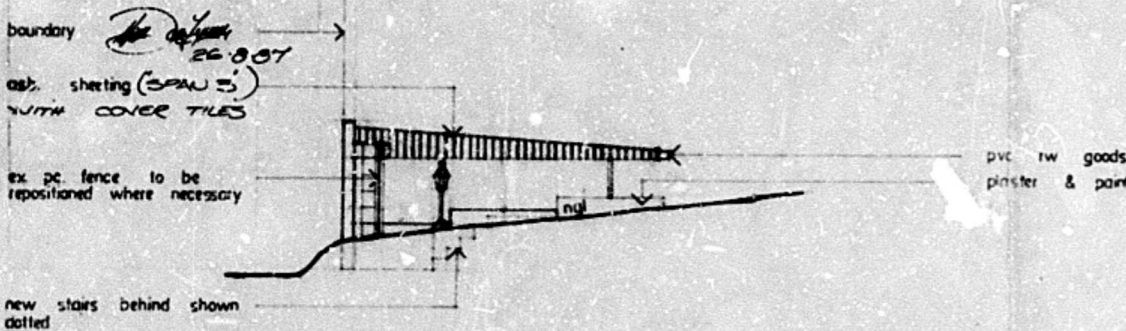


north east elevation

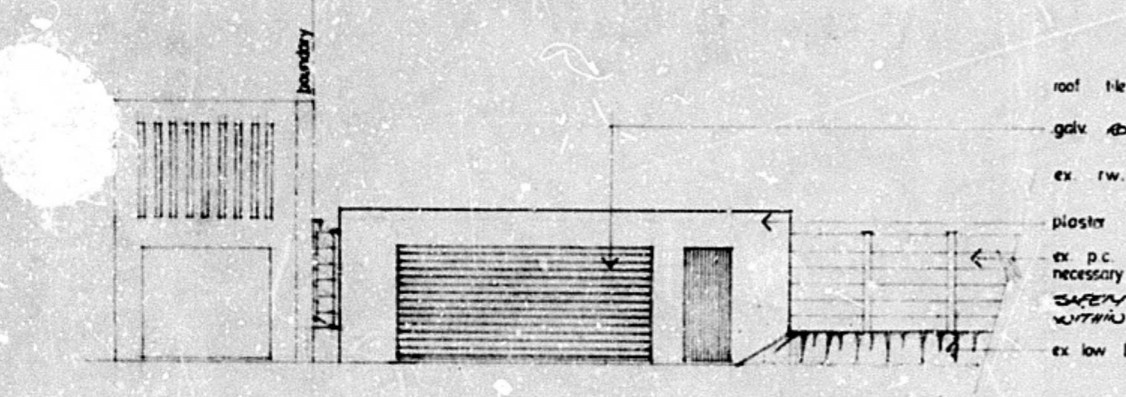


south east elevation

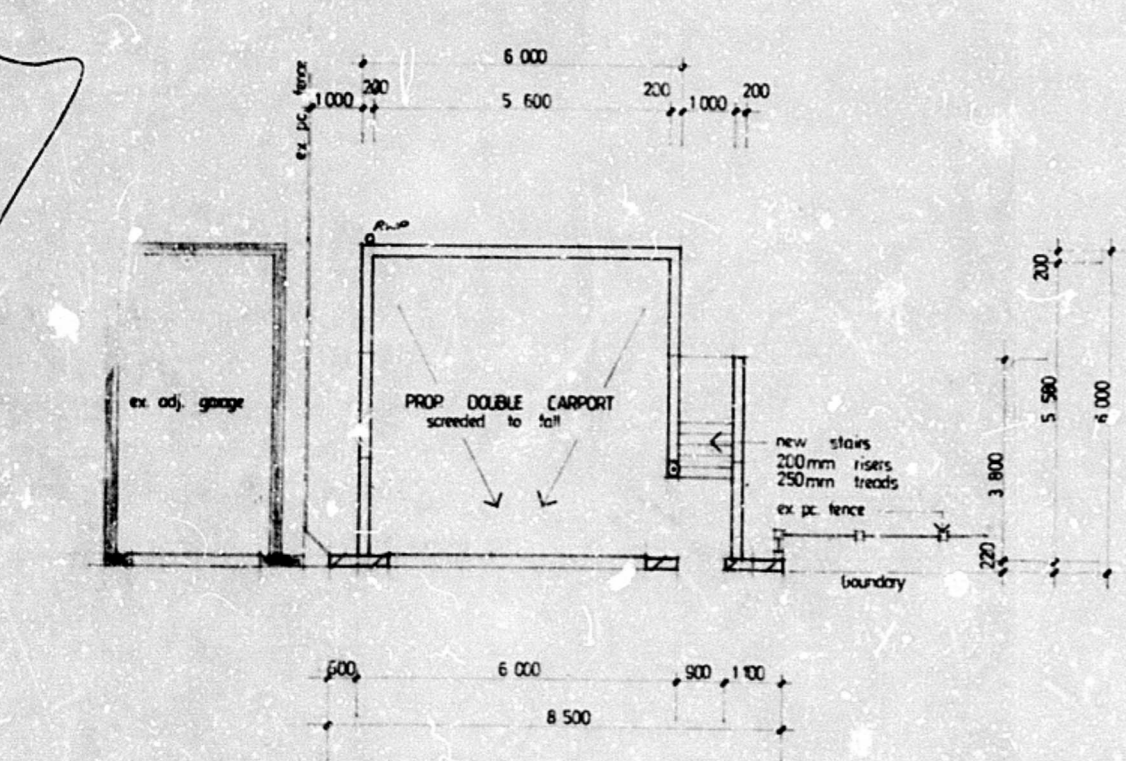


plan 1:100

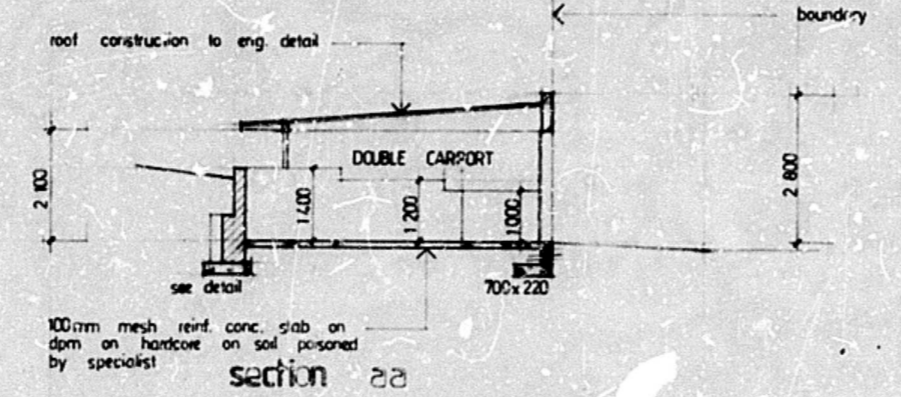


section aa

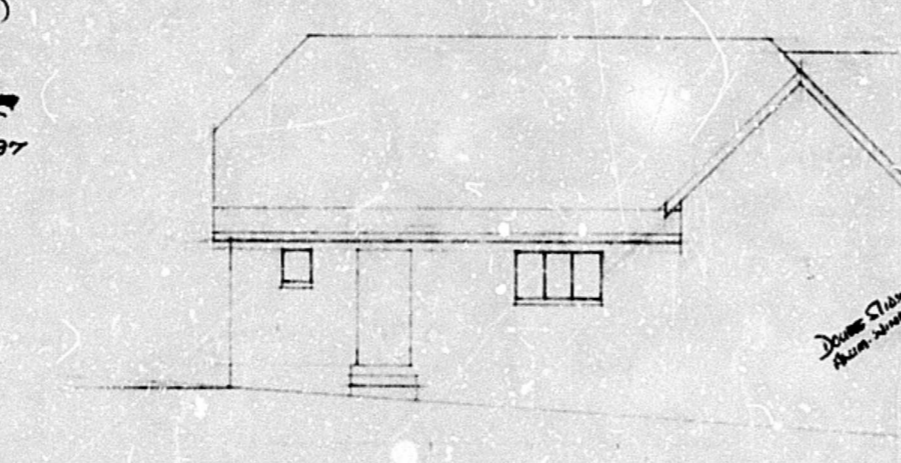


south west elevation

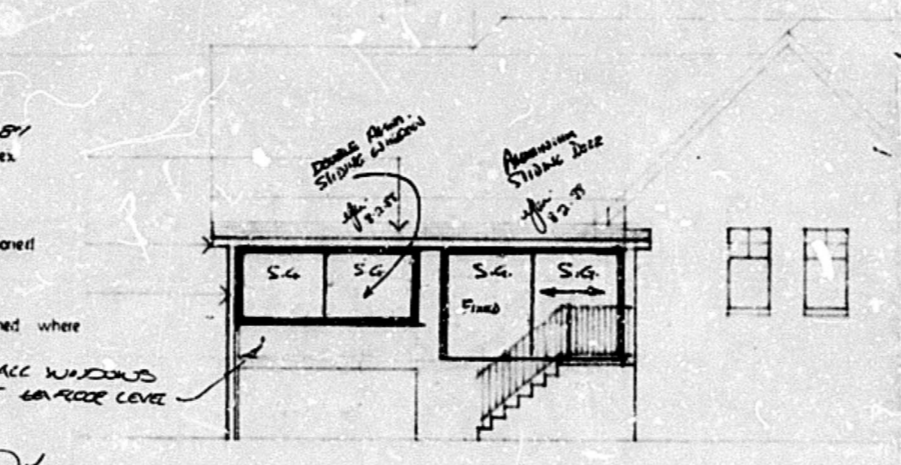


south east elevation

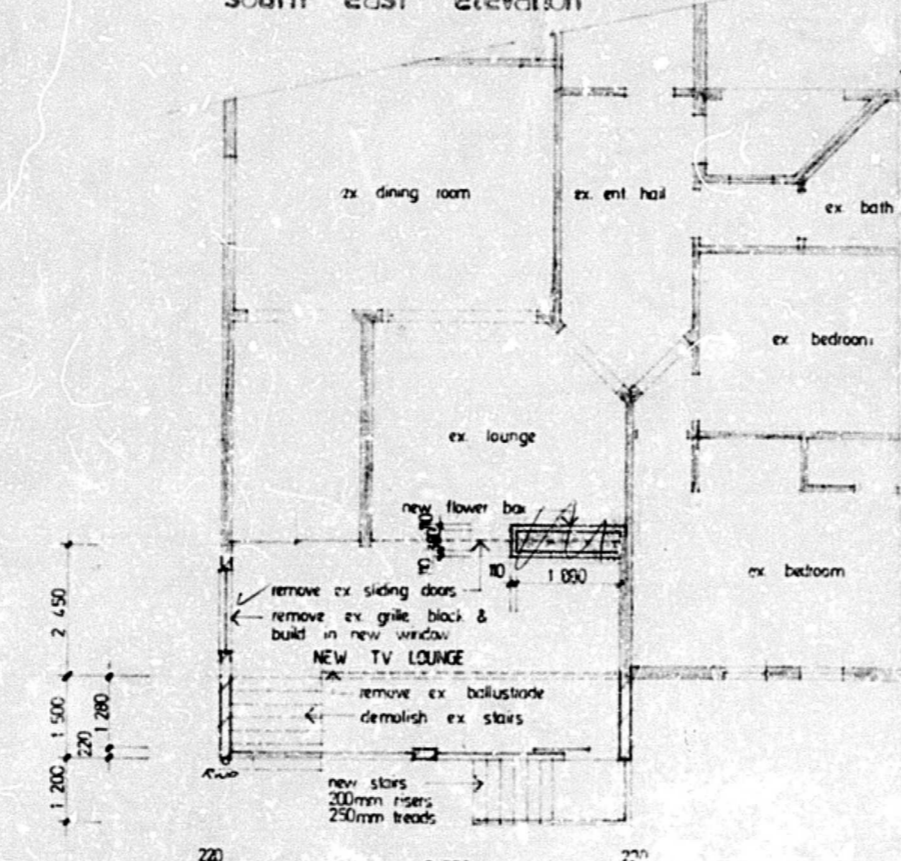


plan 1:100

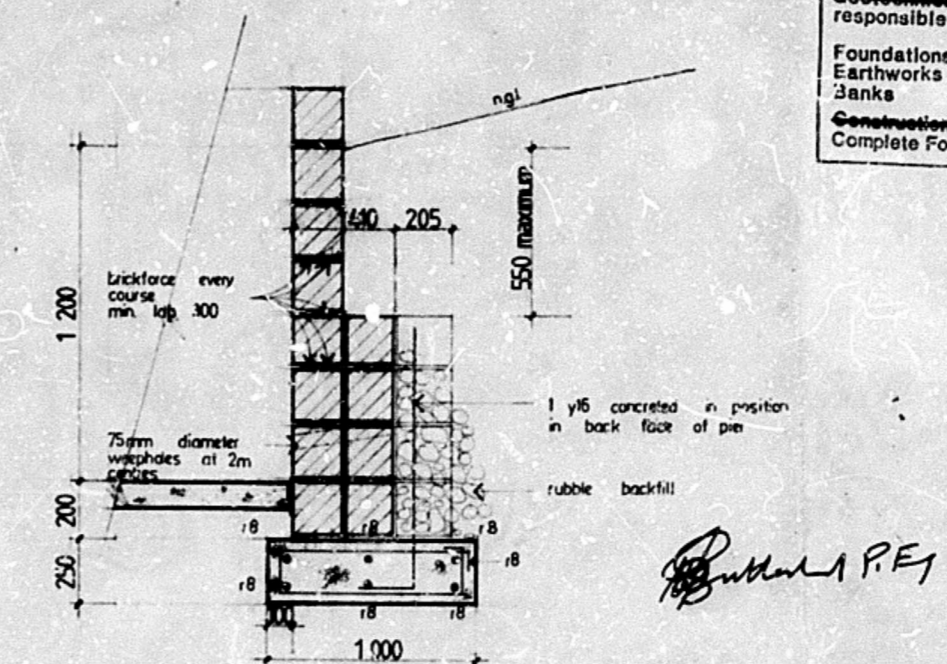


detailed section thru retaining wall 1:40

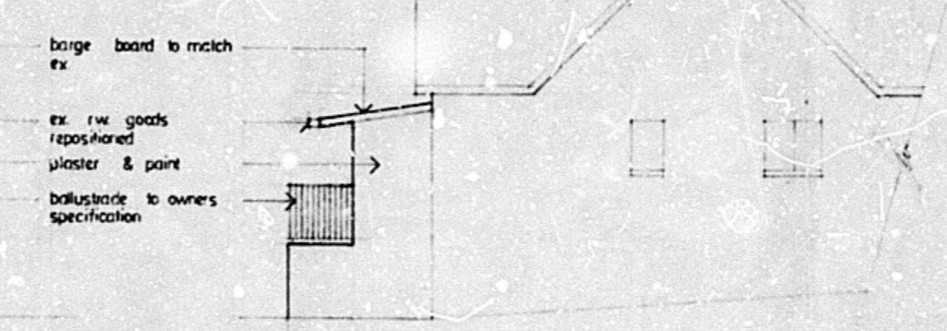

north east elevation

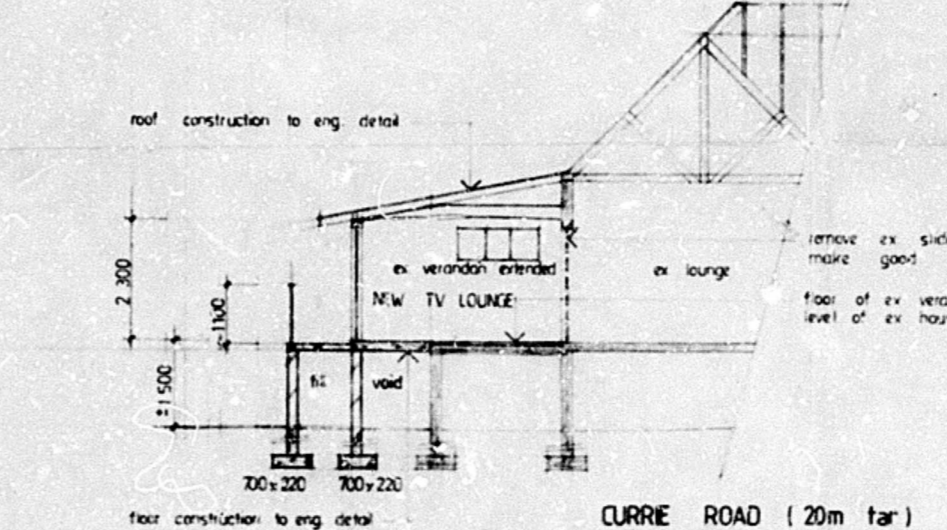

CURRIE ROAD (20m far)

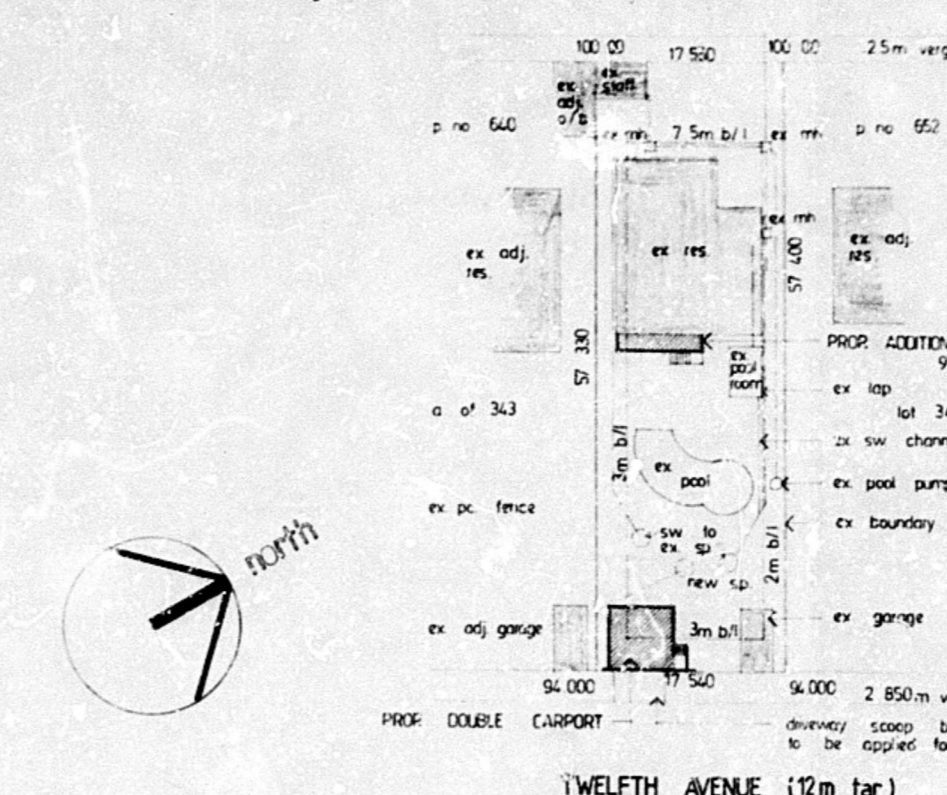

site plan 1:500

schedule of area

site area	1006	m <sup>2</sup>
ex. house	184.25	m <sup>2</sup>
ex. outbuilding	44.40	m <sup>2</sup>
PROP ADDITIONAL AREA	48.075	m <sup>2</sup>
PROP CARPORT	36.000	m <sup>2</sup>
PROP ADD. TO EX. HOUSE	12.075	m <sup>2</sup>

Geotechnical Professional Engineer to be responsible for and approve all proposed:  
 Foundations } Retaining Walls }  
 Earthworks }  
 Banks }  
 Construction of Piers }  
 Complete Form 1 and 2 and sign all plans

SHEET 1/1 COPY 3  
**CITY OF DURBA**  
 PLAN NUMBER 037/07/87/B  
 APPROVED: D.C. MACLEOD  
 CITY ENGINEER  
 17 SEP 1987  
 DATE

**AS BUILT**

**FRONTAGE LEVEL REQUIREMENTS**  
 Tops of foundations of any frontage works to be at least 0.230m below the levels given below  
 Where no level is recorded, foundations shall not be higher than the nearest edge of the adjacent hard-surfaced road.  
 Vehicular and pedestrian entrances on the road reserve boundary shall be constructed on the same grade as the kerb or road and shall be at a level 0.230m above the nearest edge of the hard-surfaced road.  
 Applicant to ensure that entrances/exits are not obstructed by Municipal services or trees.  
 Concrete datum at correct frontage level required at entrances/exits.  
 Date \_\_\_\_\_ Signature \_\_\_\_\_  
 Date of Second Circuit \_\_\_\_\_ Signature \_\_\_\_\_

**TOWN PLANNING BRANCH**  
 APPROVED  
 DATE - 9 SEP 1987  
 Subject to the conditions being used only for the purposes shown on the plan.  
 Signature \_\_\_\_\_

**AMENDMENT APPROVED**  
 DATE 12.1.88  
 D. C. MACLEOD  
 CITY ENGINEER PER \_\_\_\_\_

prop. double carport and atts & adds to ex. house on rem of 343 block a.t. for Mrs. J. G. Macfarlane at 642 Currie Road site no. 470054

**G. P. DRAWING SERVICES**  
 97 SMITH AVENUE MORNINGSIDES DURBAN 4001  
 P.O. BOX 597 WESTVILLE 3530  
 TEL: 3022658  
 DRAWN and TYPED BY: \_\_\_\_\_  
 SCALE: 1:10 1:100 1:500  
 DATE: 2 JUN 1987  
 DRAWING NUMBER: 797-1