
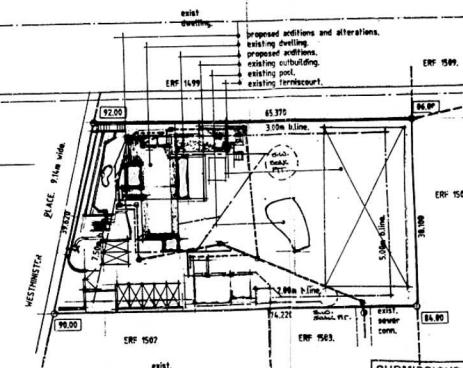
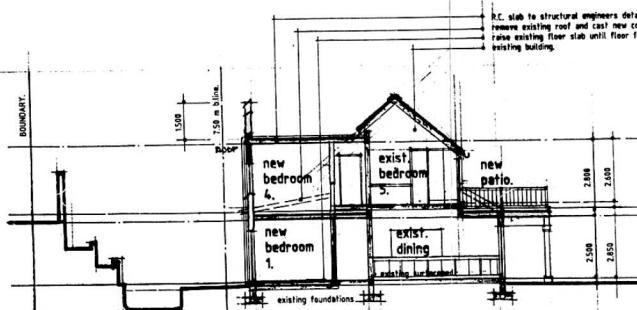
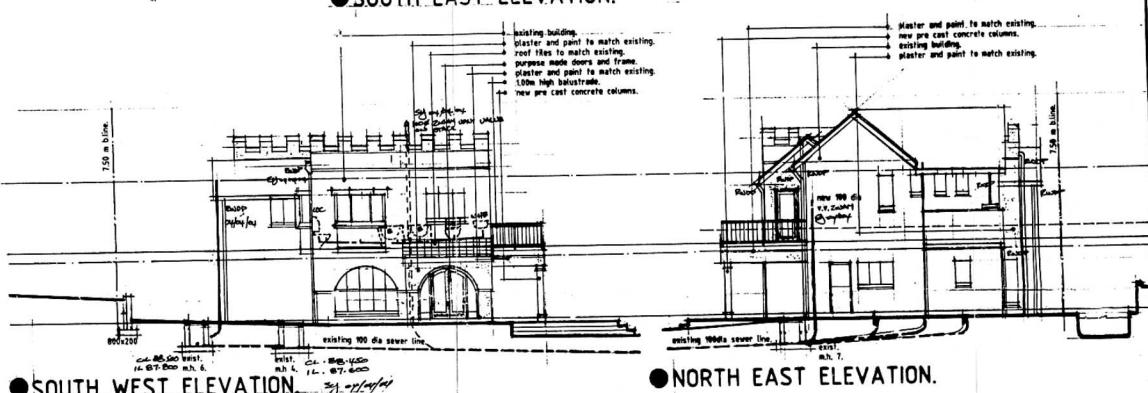
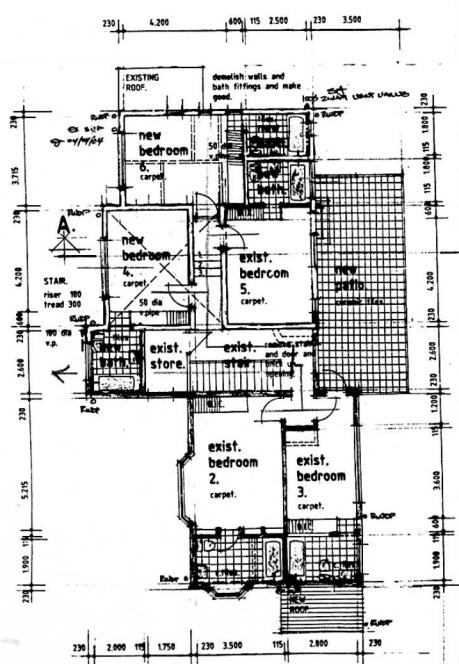


FIRE PLAN

1/2

16-04-04

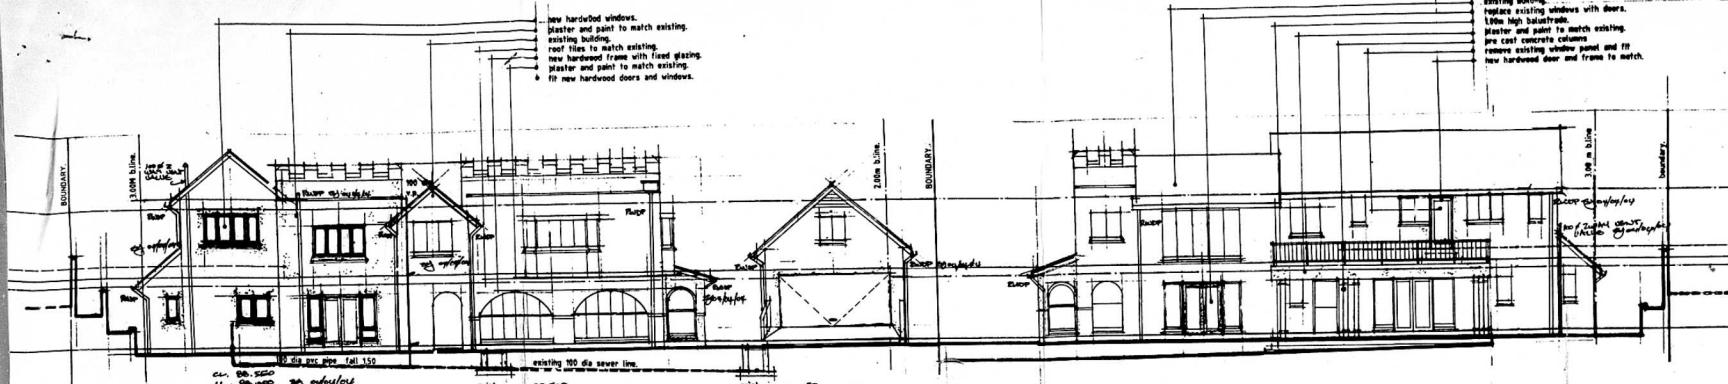

SCALE 1:500
ERF 1598 OF DURBAN NORTH.

SUBMISSIONS SITEPLAN CHECKED
2004-02-25
Signature

RATE NO. 88169082
REG. NO.

**PROPOSED ADDITIONS ALTERATIONS
AND CONVERSION OF EXISTING
DWELLING TO GUEST HOUSE
FOR MRS. M.M. BARRETT
AT 2 WESTMINSTER PLACE
ON ERF 1598 OF DURBAN NORTH
DURBAN.**

MAP DESCRIPTION
This map is for the use of the Architect. Detailed dimensions only can be used.
Drawings must not be copied or reproduced without the written permission of the architect.
Architect: *M. Barrett*
Signature: *M. Barrett*

**MORPHOSIS
DIGITAL ARTCC
ARCHITECTS**
25 MARLOWE AVE. WESTVILLE 3630
SCALE 1:100 DATE 17.02.04 PH 2623469

• ALL LENGTH VALUES TO THE 1000MM MARK.