

Notes:

1. ALL MATERIALS & FINISHES TO COMPLY TO N.B.R.
2. I.D. LINTOLS ABOVE ALL OPENINGS.
3. ALL CORRUGATED IRON ROOF SHEETS TO BE PAINTED (NOT SILVER OR ALUMINIUM)
4. ALL SEWER INTO SEPTIC TANKS
5. ALL STORMWATER INTO SOAK PIT.

BL	724.0	724.0	724.0
LL	727.7	727.1	724.8
SL	1.3	0.9	0.8
SP	1.4	1.4	1.4
ST	2.0	2.0	2.0



SEWER SECT. E-G

BL	728.4	724.3
LL	726.8	723.8
SL	2.0	0.5
SP	1.4	1.4
ST	2.0	2.0

SEWER SECTION B3-B4

BL	721.0	721.9	721.0	724.9	726.9
LL	724.7	727.3	724.9	726.6	725.9
SL	1.3	0.5	0.1	0.3	1.0
SP	1.4	1.4	1.4	1.4	1.4
ST	2.0	2.0	2.0	2.0	2.0

SEWER SECT. A-D

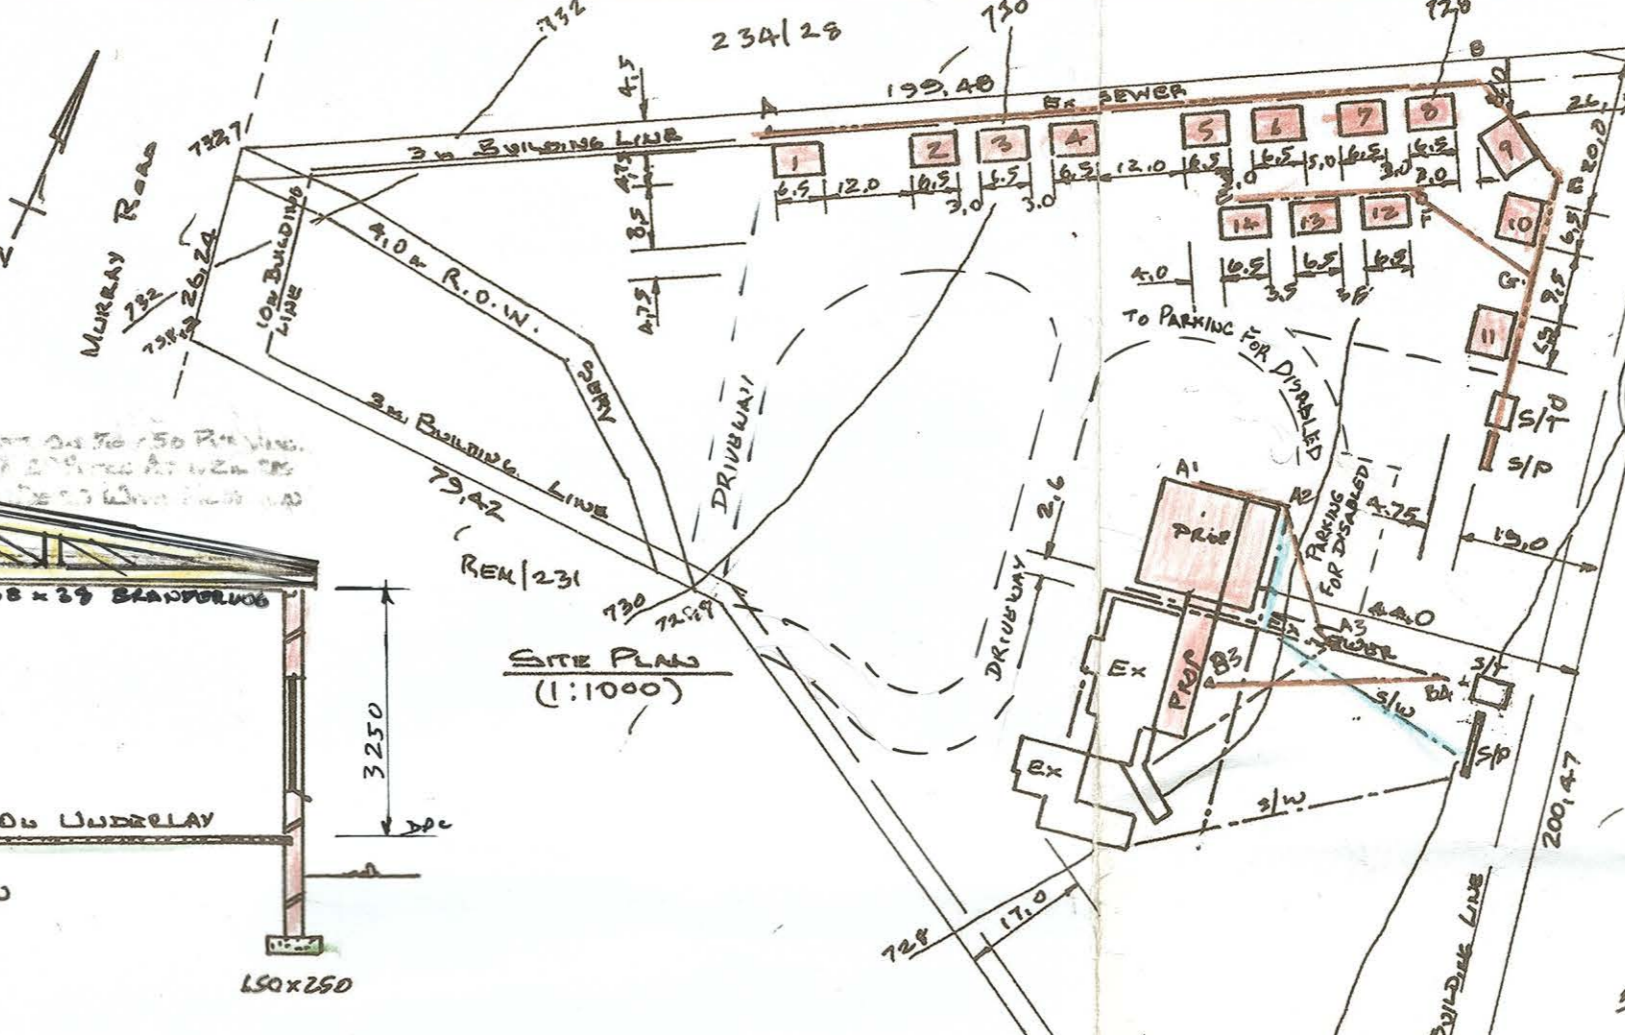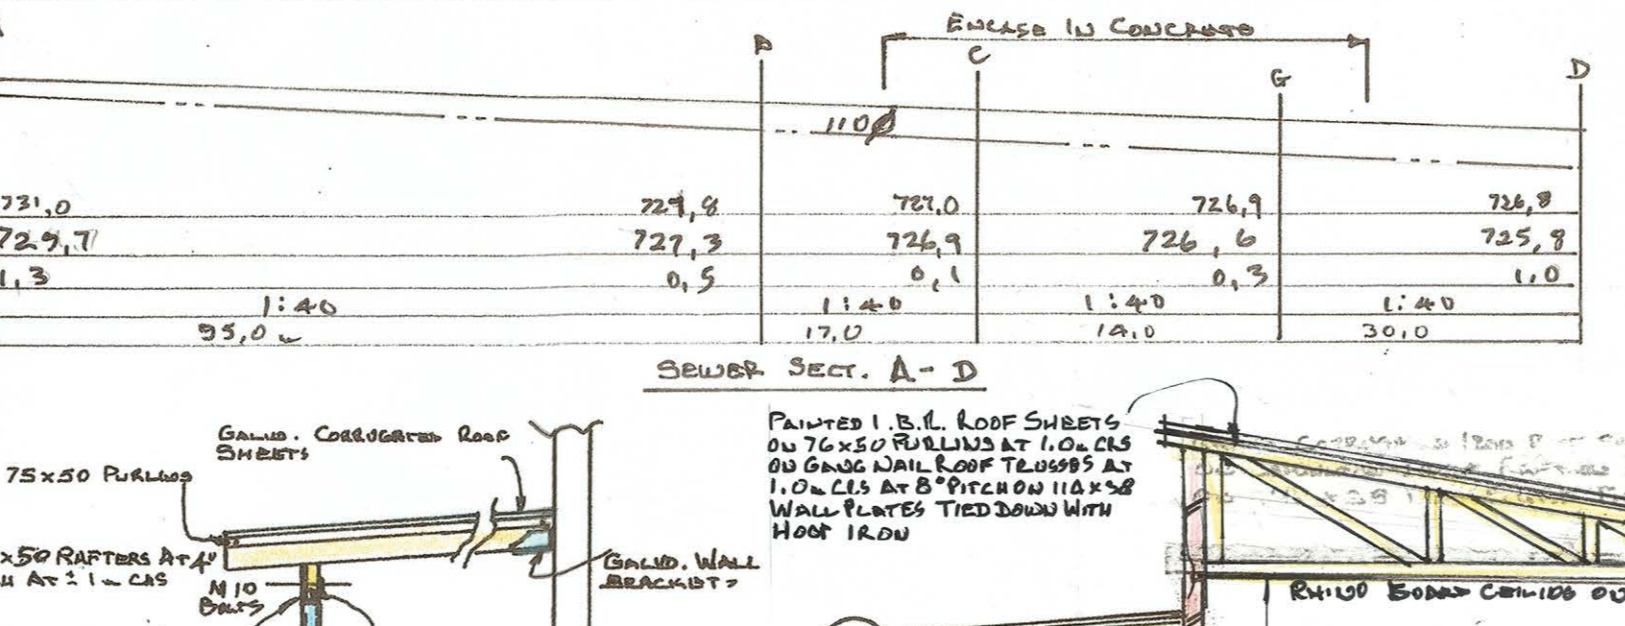



BUILDING CONTROL & SIGNAGE
RECEIVED
2013-03-06
Plan No. 12/13

RECEIVED
2012-10-16
Plan No. 12/13












BUILDING CONTROL & SIGNAGE
RECEIVED
2013-01-31
Plan No. 12/13

BUILDING CONTROL & SIGNAGE
RECEIVED
2013-04-19
Plan No. 12/13

BUILDING CONTROL & SIGNAGE
RECEIVED
2013-06-14
Plan No. 12/13

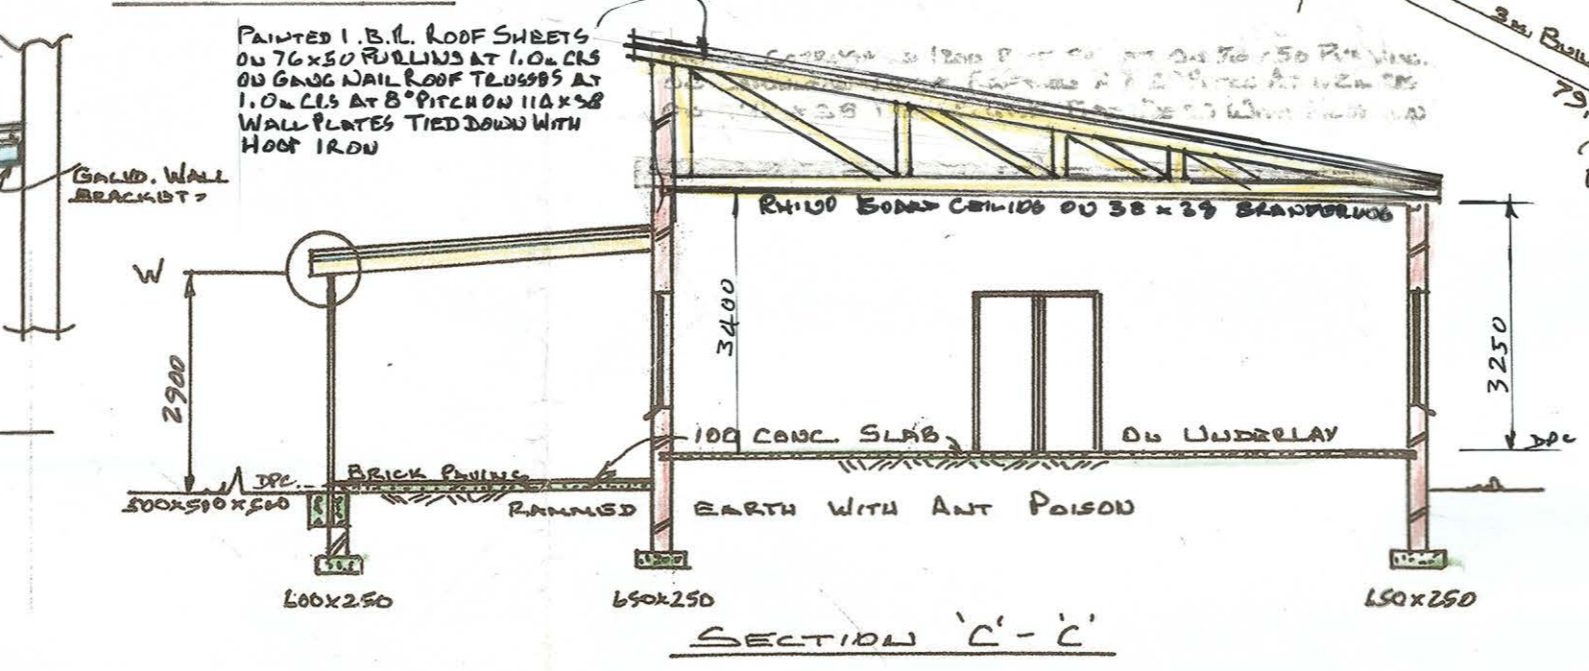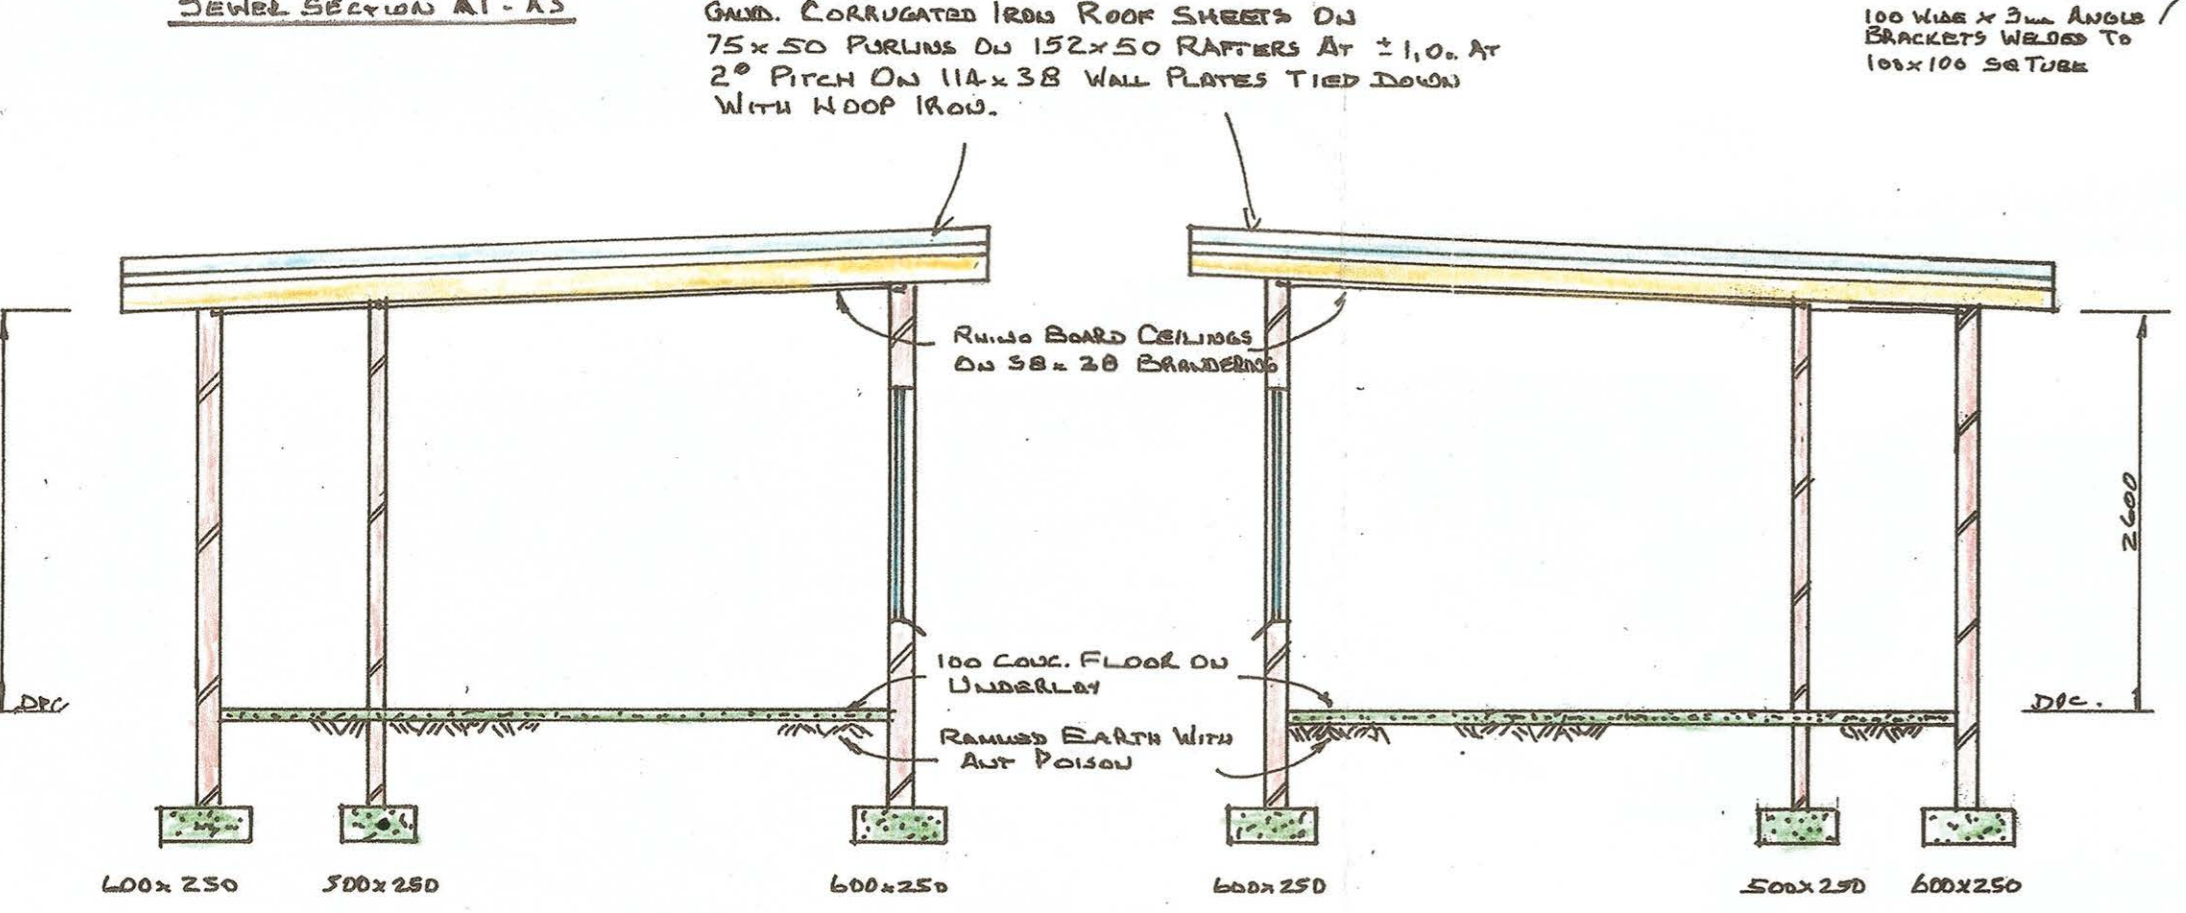





SECTION B-B (1:50) SECTION A-A (1:50)

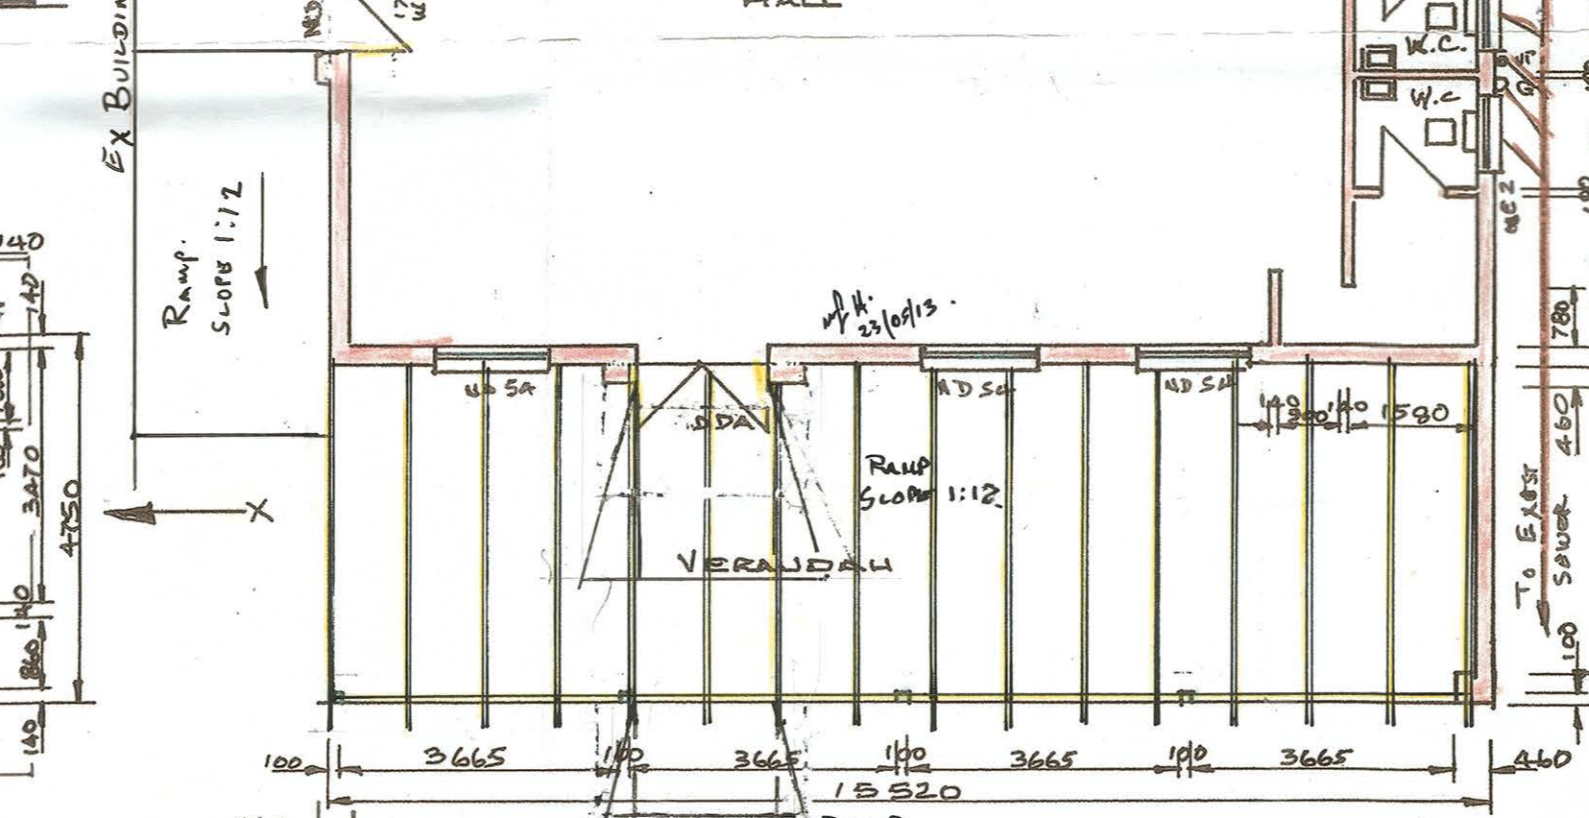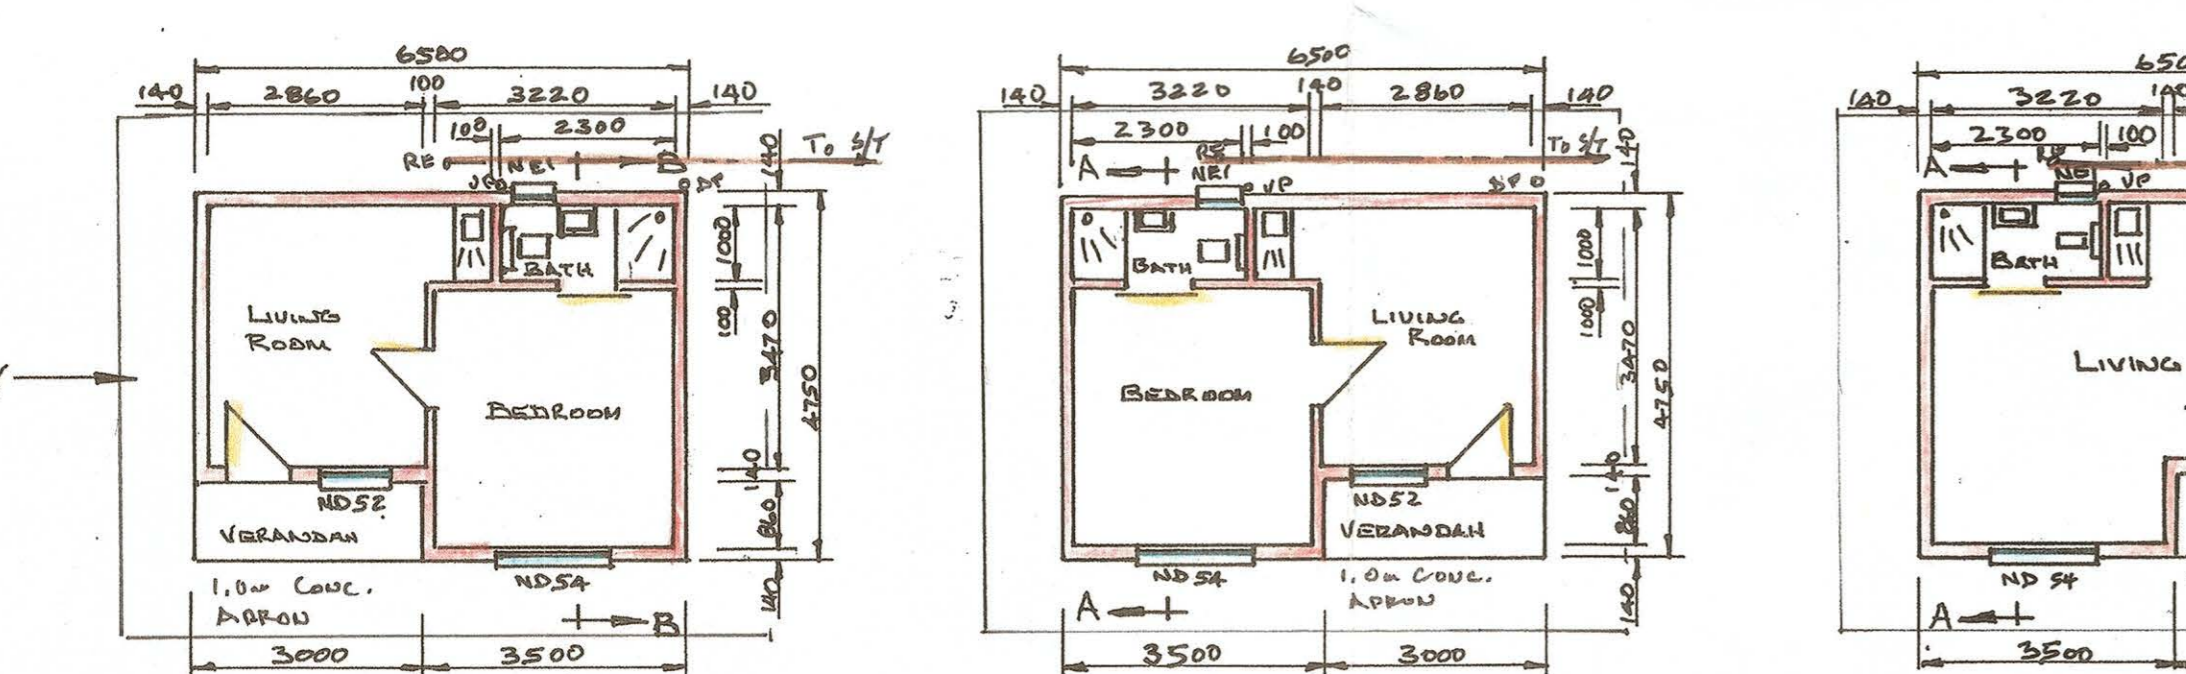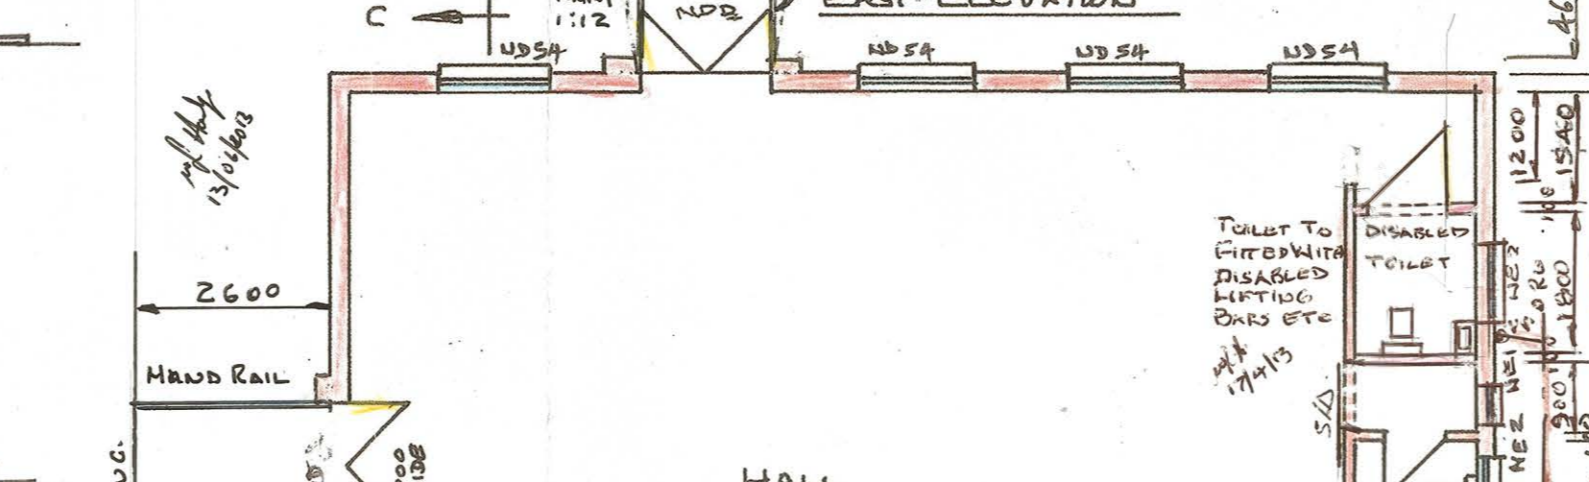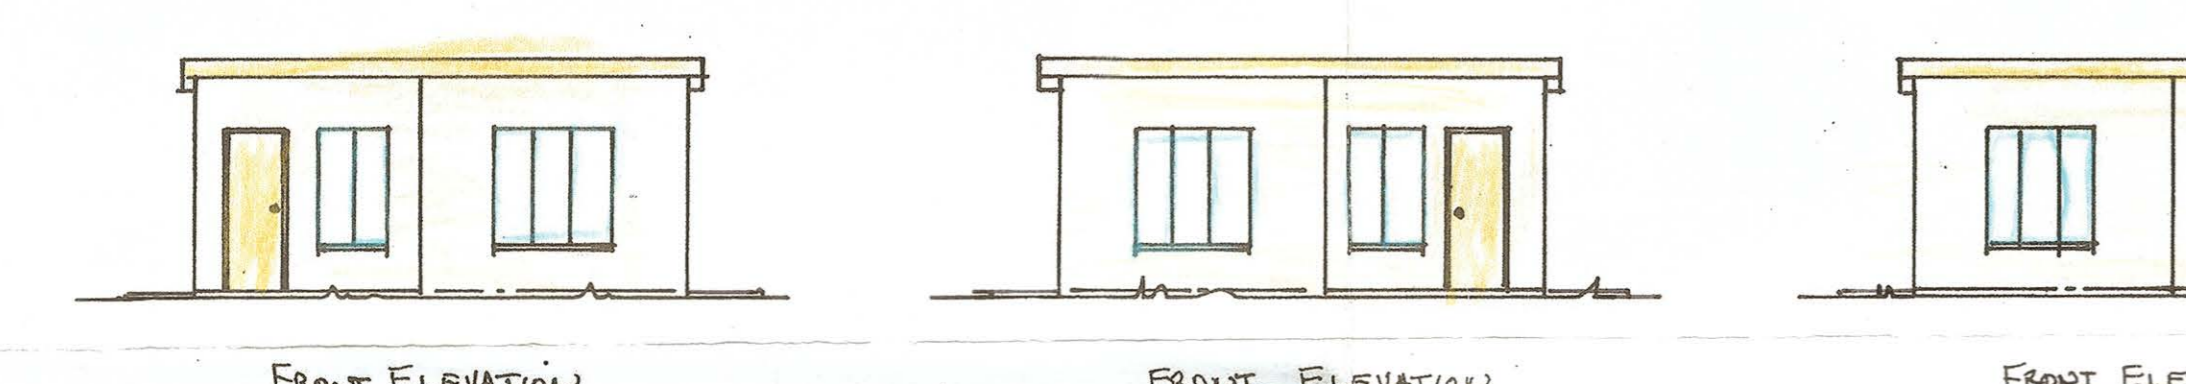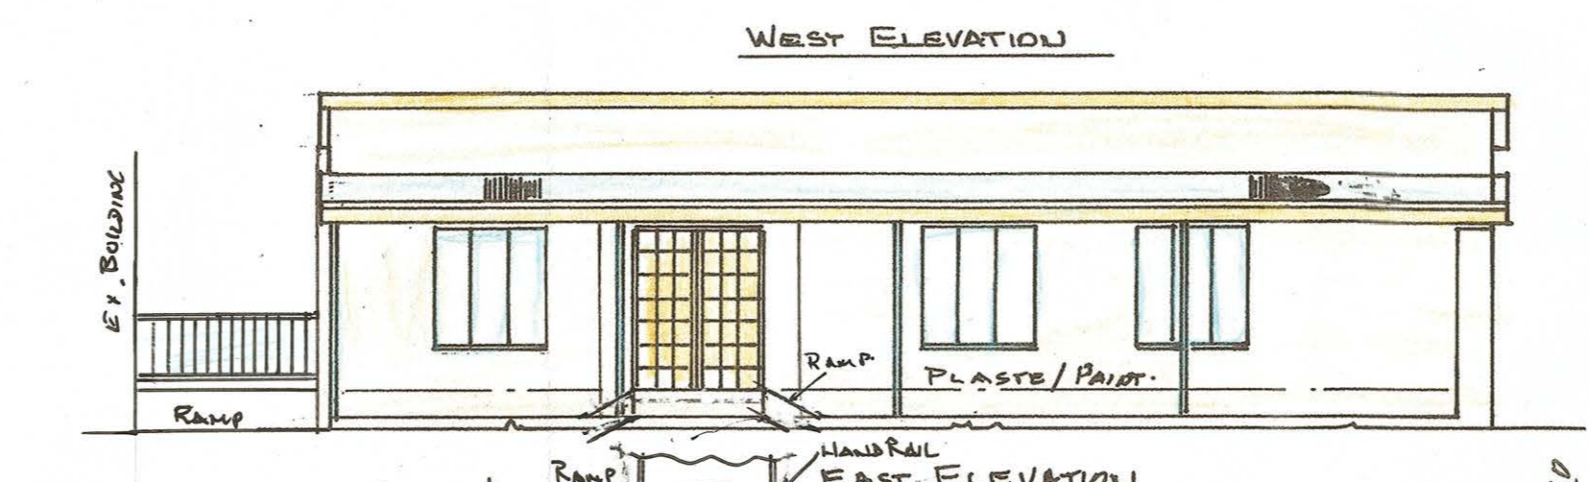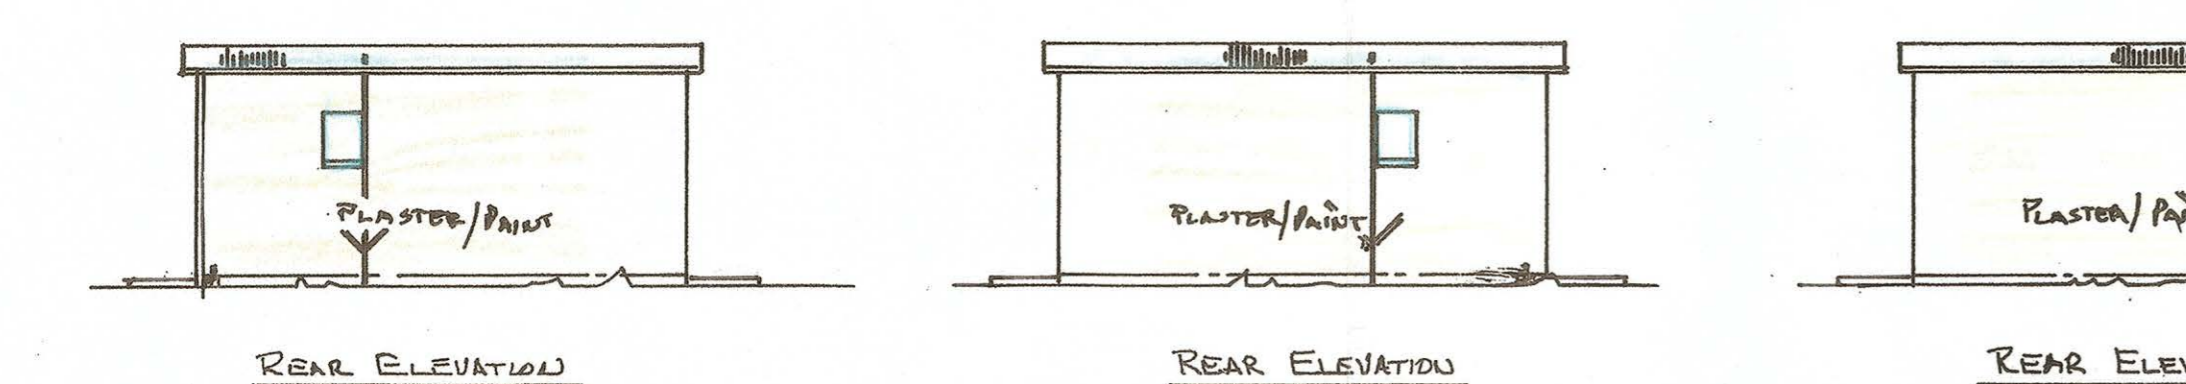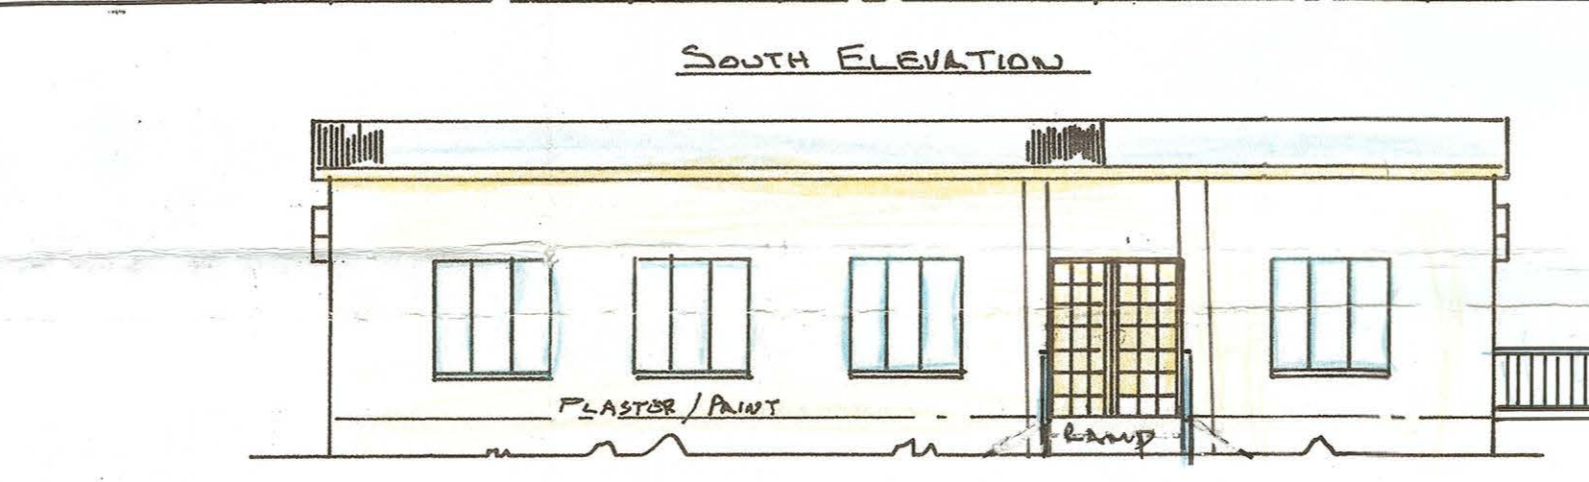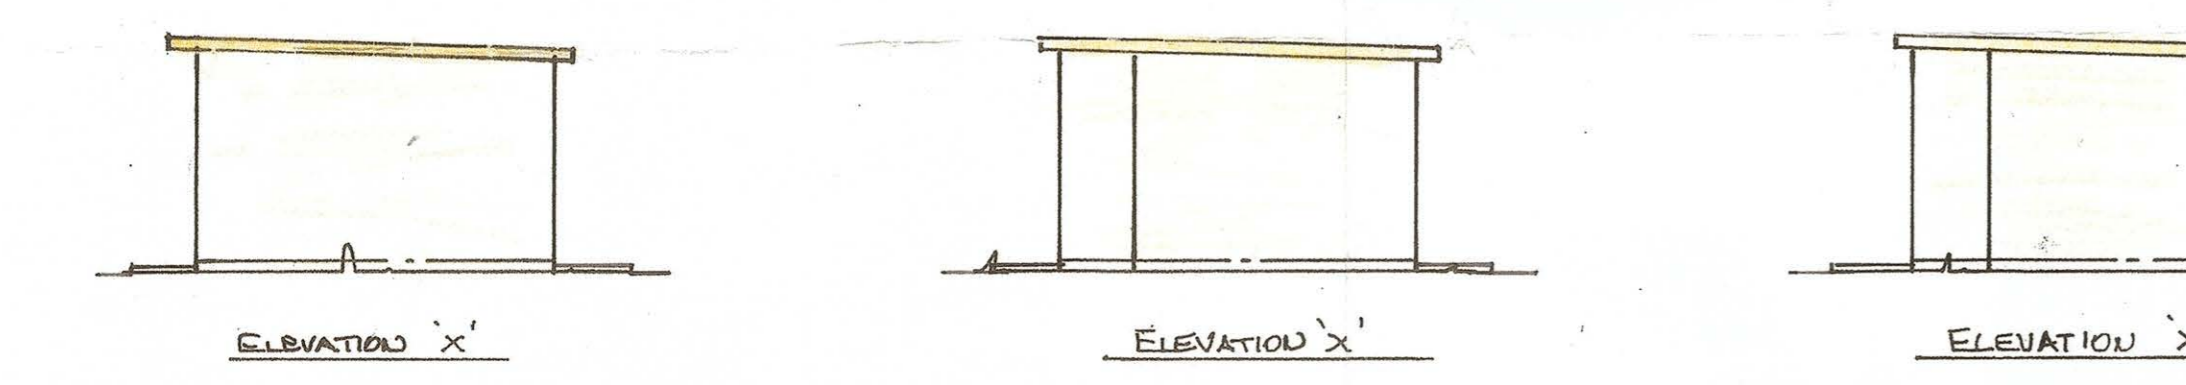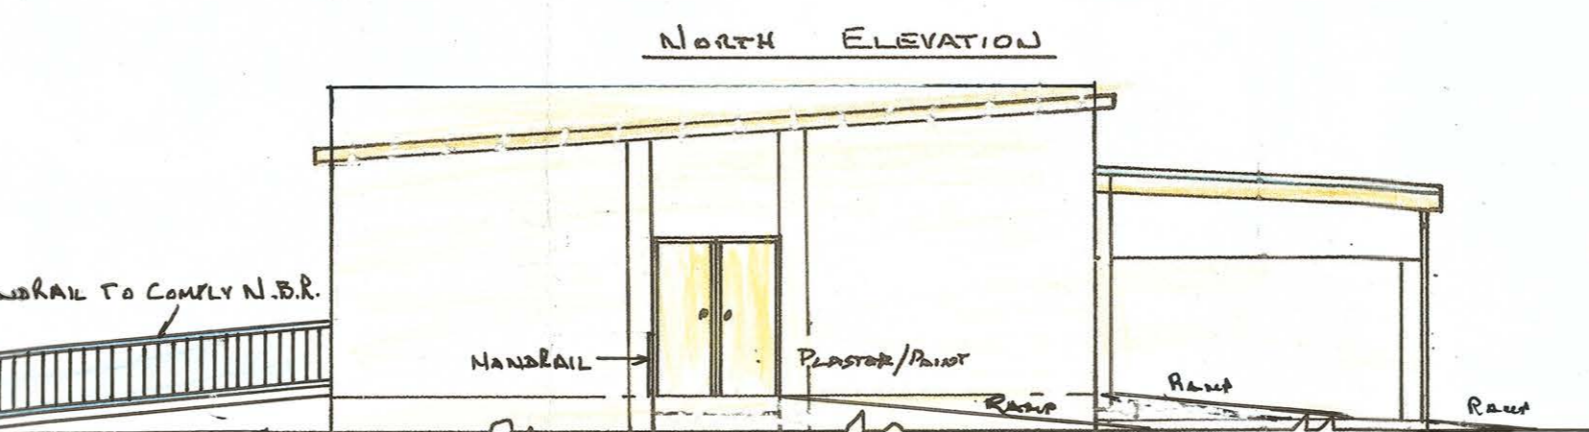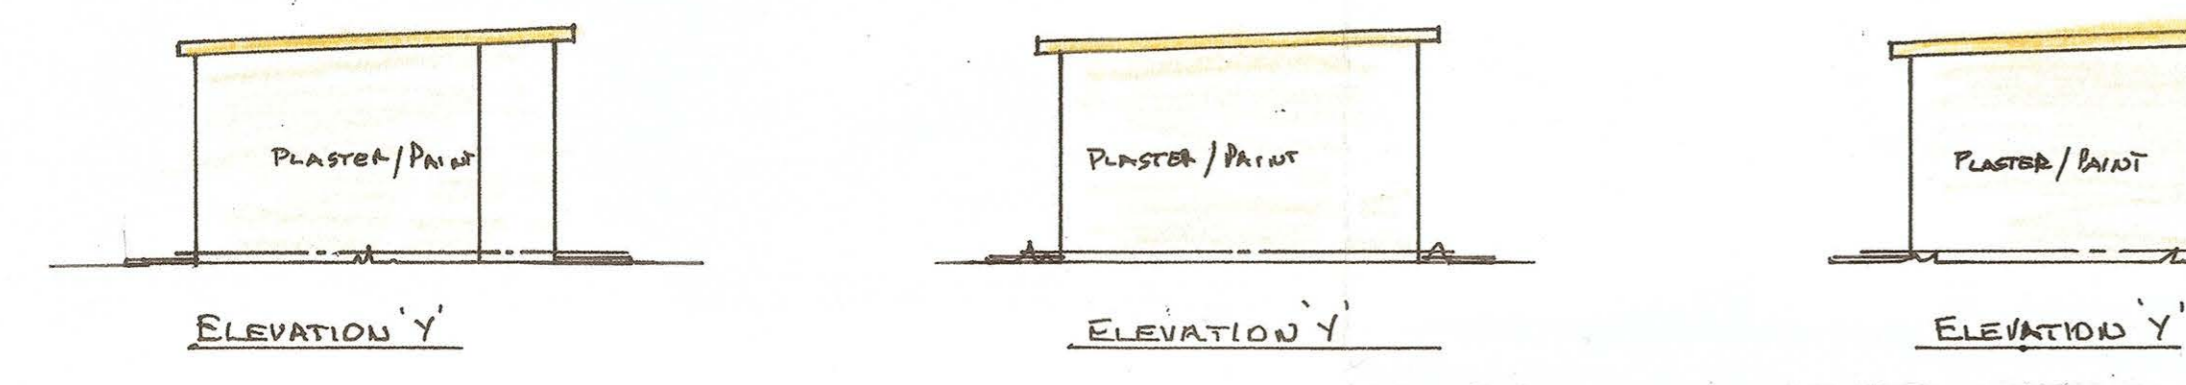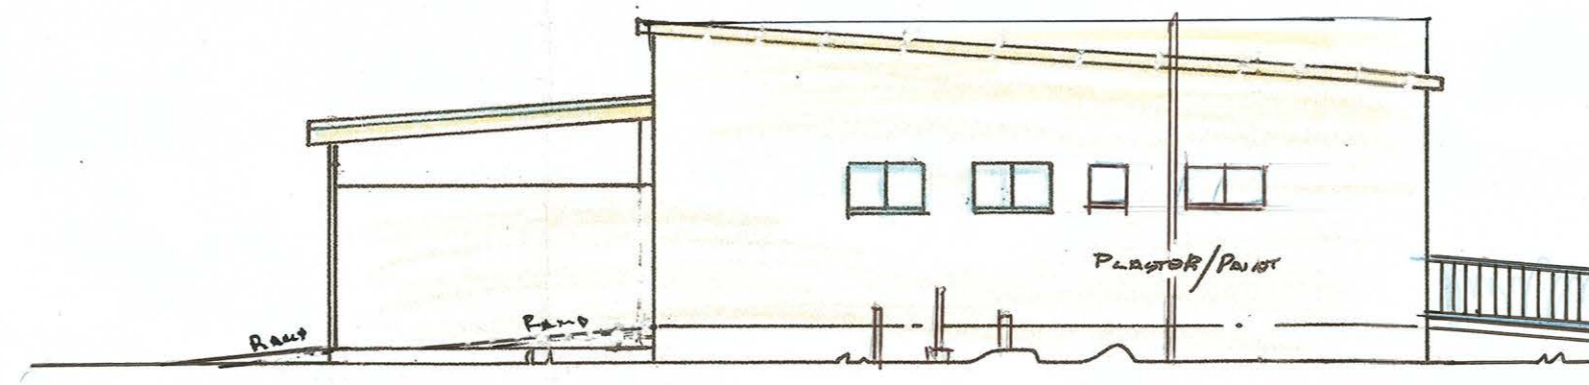

PLAN: UNITS 12-14 (AREA = 30.9m²)
PLAN: UNITS 1-4 & 9-11 (AREA = 30.9m²)
PLAN: UNITS 5-8 (AREA = 30.9m²)

PLAN OF HALL (AREA = 22.7m²)
TOTAL AREA = 740m²
OCCUPANCY H3

CONDUIT PIPES FOR TELECOMMUNICATION SERVICES IN BUILDINGS ARE TO COMPLY WITH REQUIREMENTS OF POST OFFICE GENERAL ENQUIRIES PLEASE CONTACT TEL 423836 OR 84412 FOR ATTENTION BRANCH MANAGER

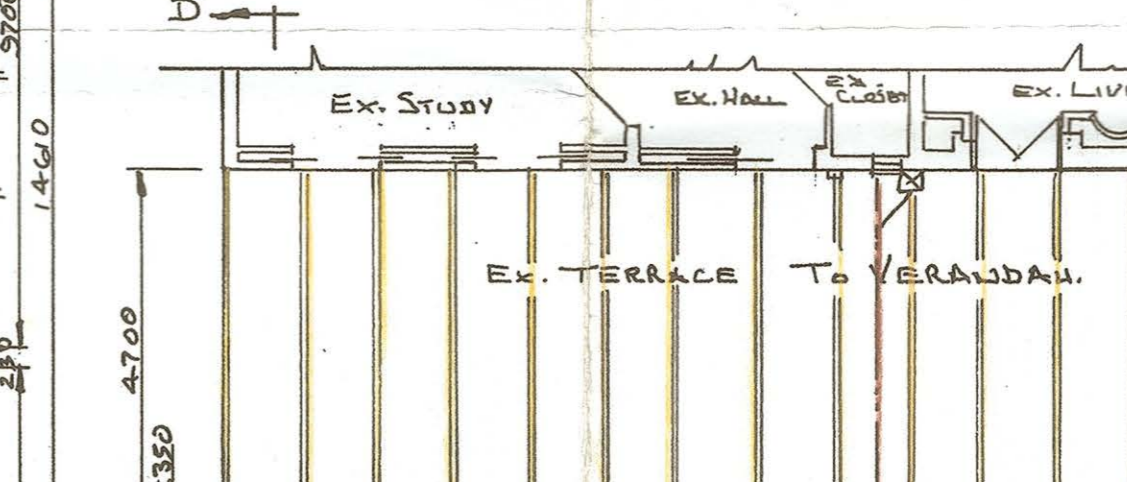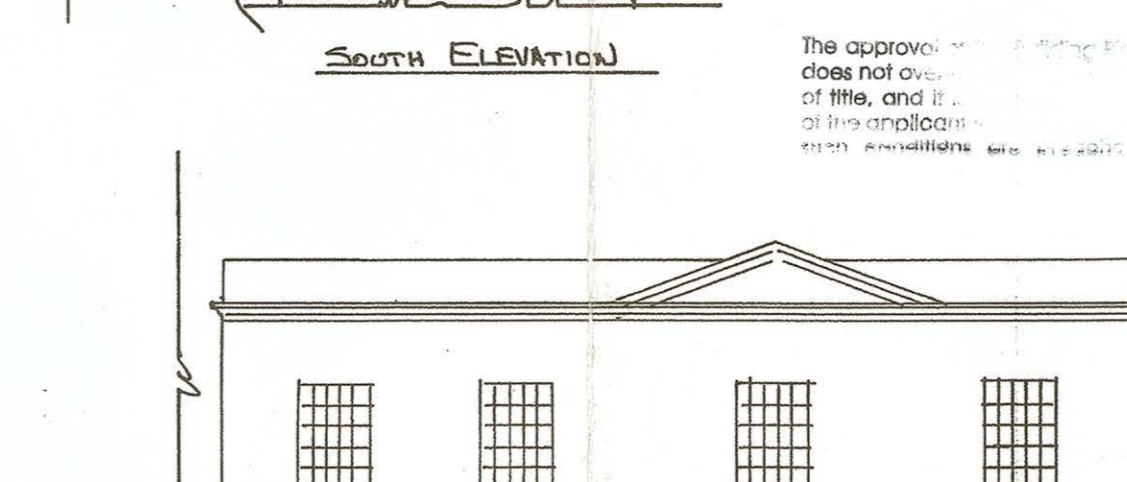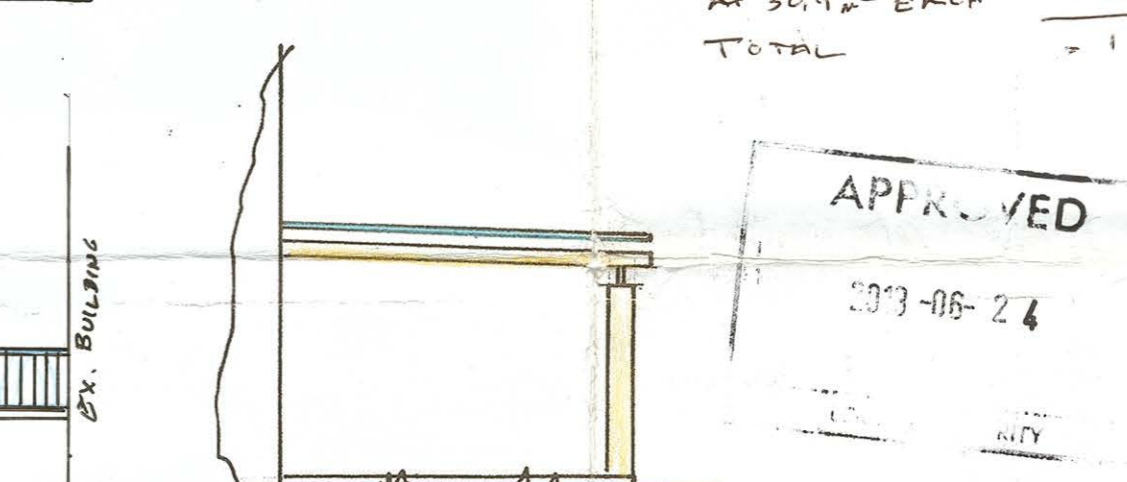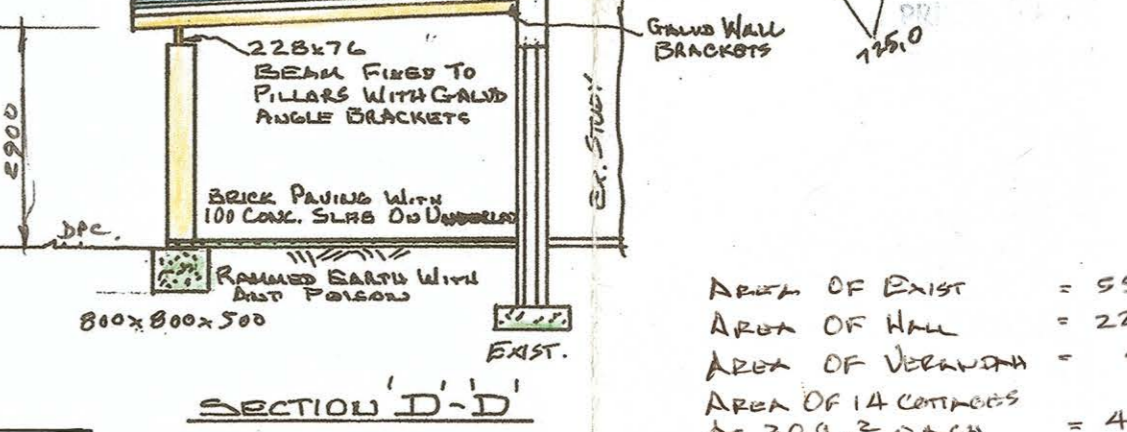

PART PLAN OF VERANDAH (AREA = 81m²)

APPROVED
2013-06-26
Subject to roof trusses being certified by an approved I.T.C. engineer.

APPROVED
2013-06-26
AREA OF ELEV. = 555.0m²
AREA OF EXIST. = 226.7m²
AREA OF VERANDAH = 81m²
AREA OF 14 COITHEES AT 30.9m² EACH = 432.6m²
TOTAL = 1295.3m²

W. J. HODGE REG. NO. D1239
4 KIMBELL ROAD, BISLEY CREST, P.M.B. 206
033-3867267 084 444 6239

AS BUILT PLANS OF BUILDINGS ON ERF 546 NEW ENGLAND 1462 FOR MR & MRS JENSEN (P.T.B. Nos. 31694 & 13433)
DATE 16-02-2012
SCALE 1:100 / 1:1000
DRAWN W. J. HODGE