




**EX SOUTH ELEVATION**  
SCALE 1:100

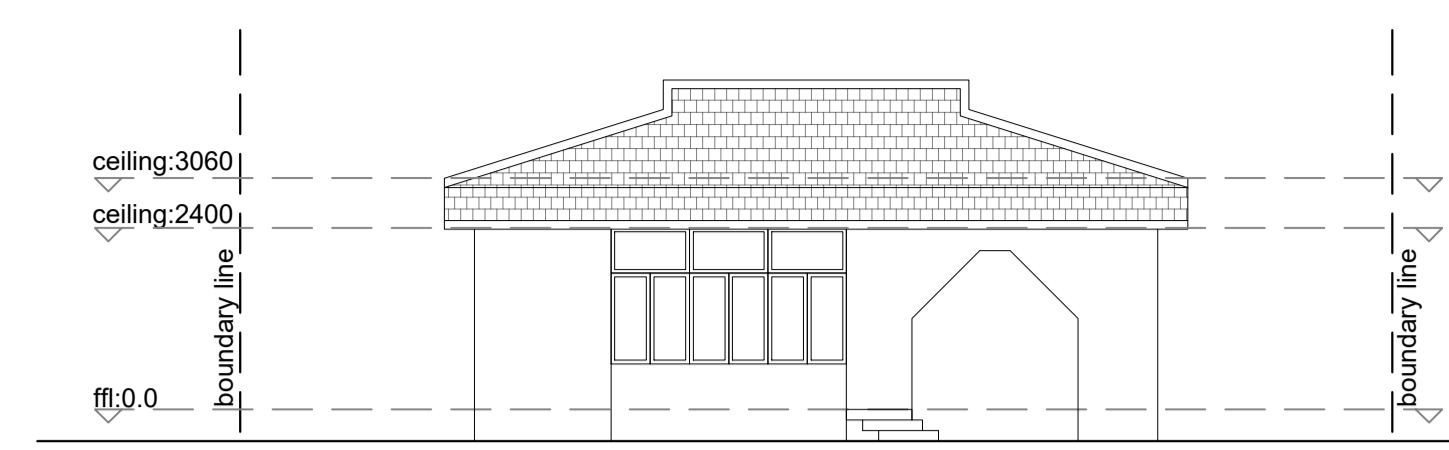


**EX EAST ELEVATION**  
SCALE 1:100

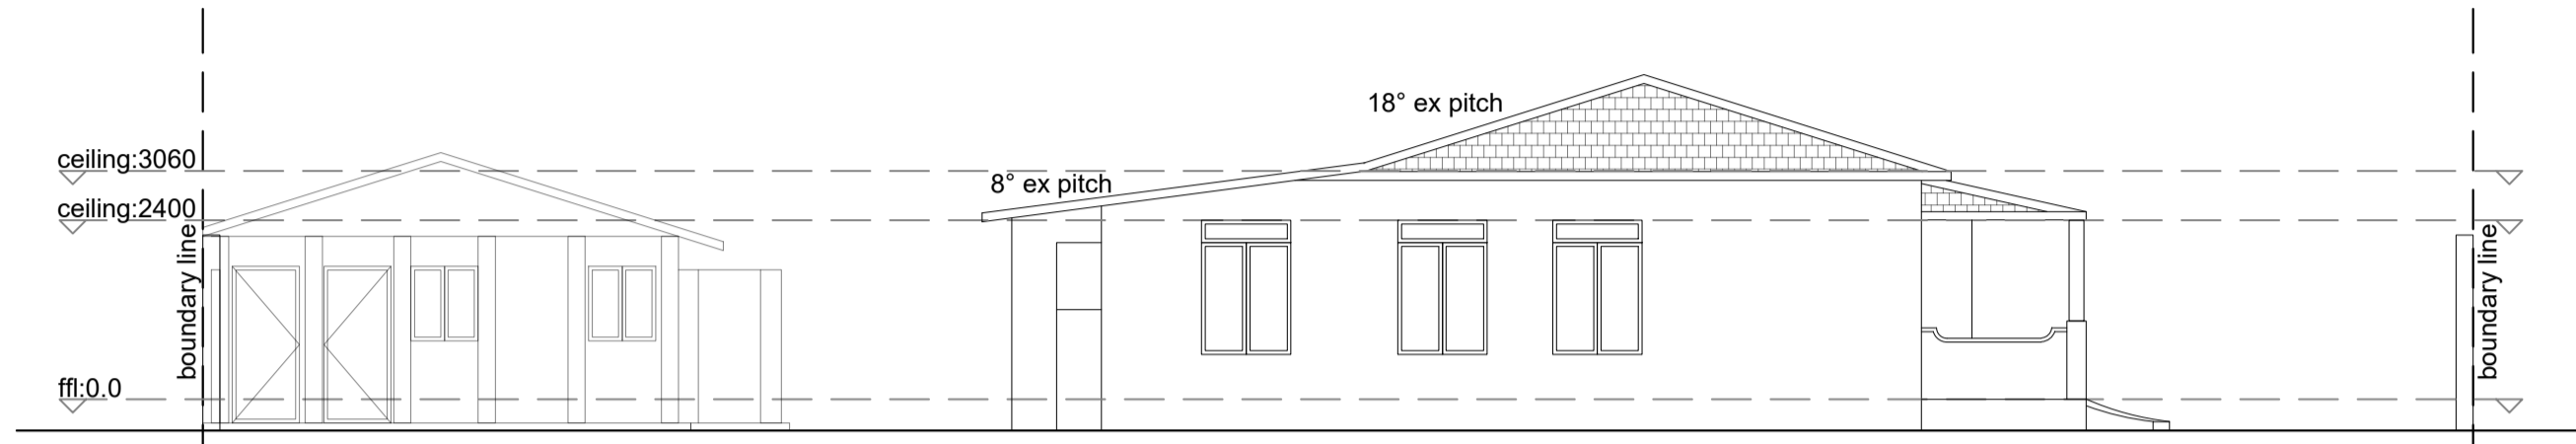



**EX NORTH ELEVATION**  
SCALE 1:100

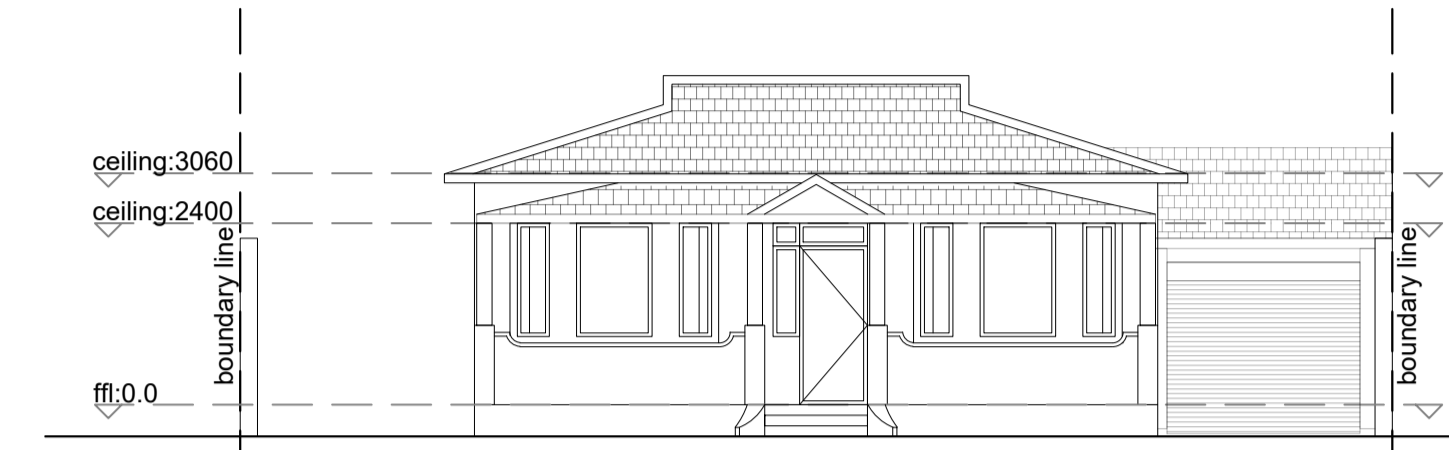


**EX WEST ELEVATION**  
SCALE 1:100

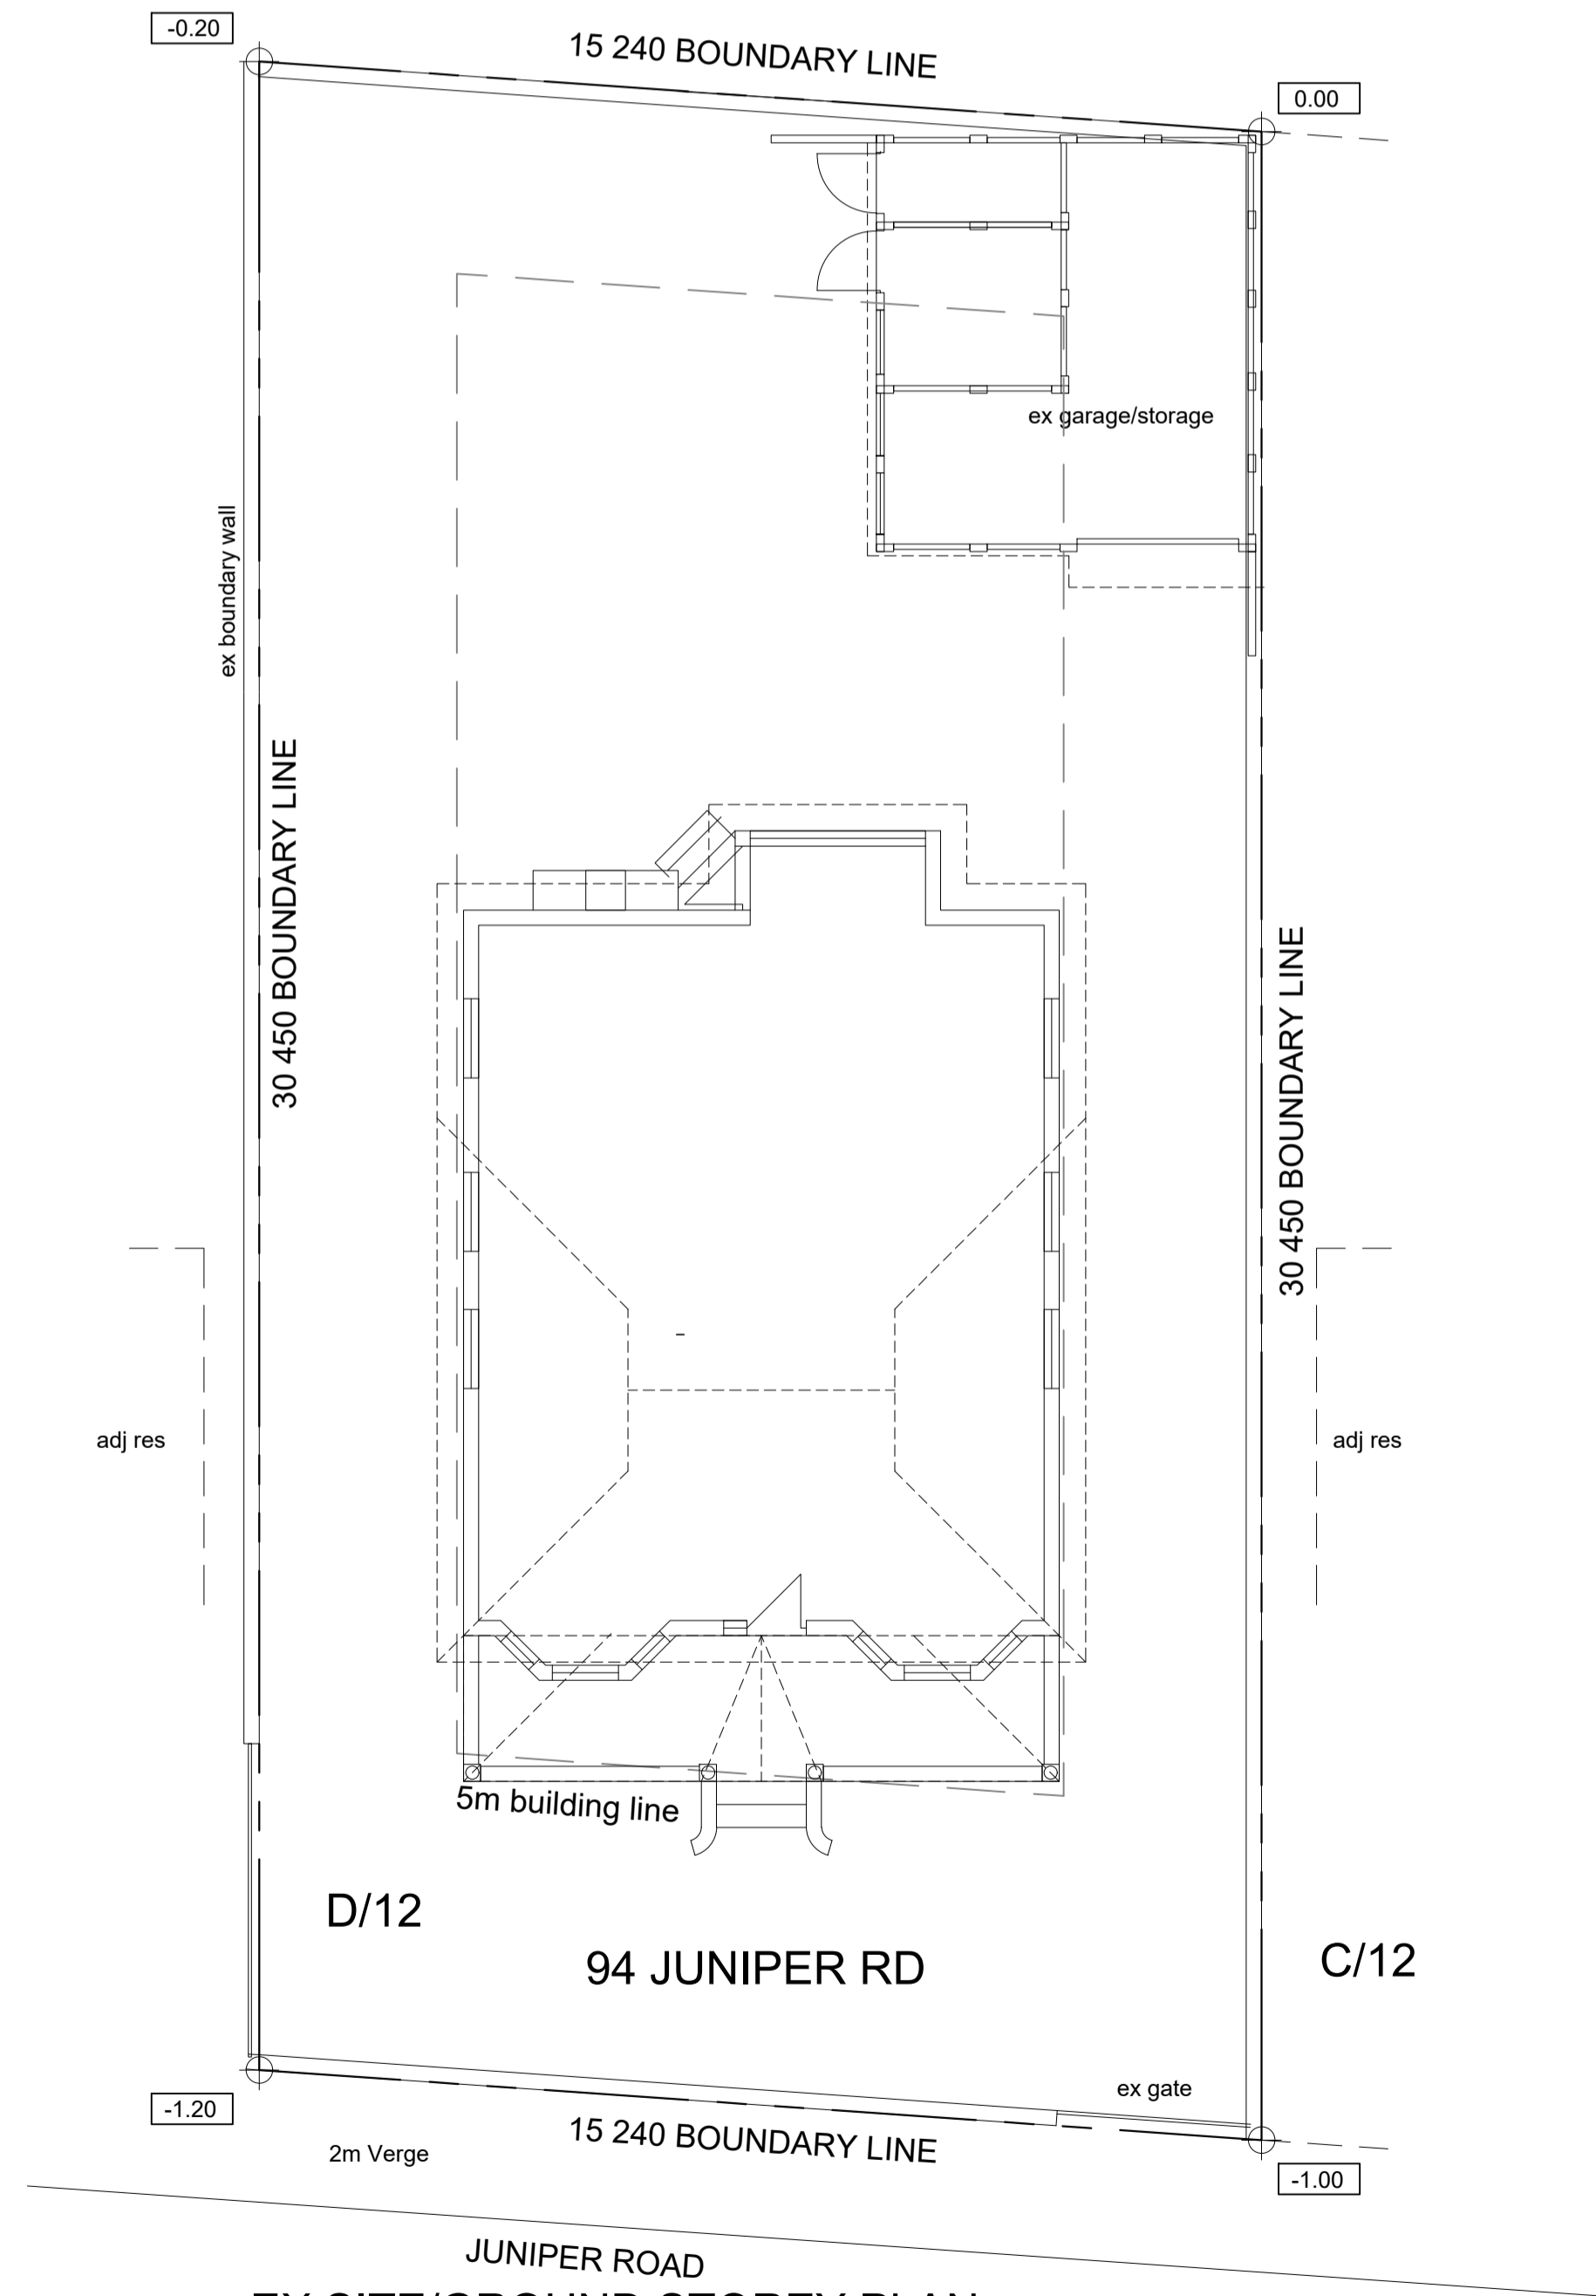


**EX SITE/GROUND STOREY PLAN**  
SCALE 1:100

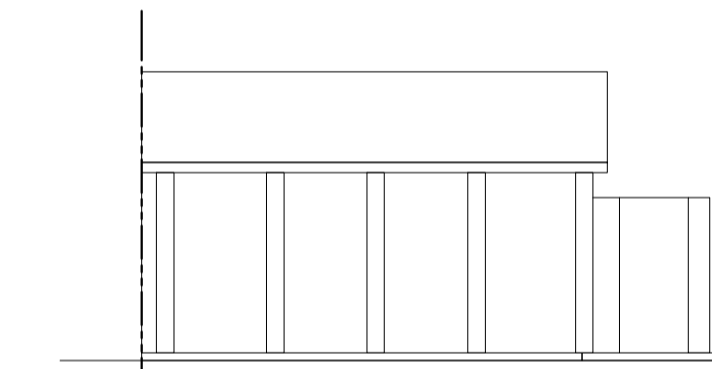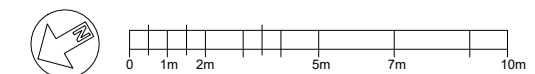


**EX EAST ELEVATION - GARAGE**  
SCALE 1:100

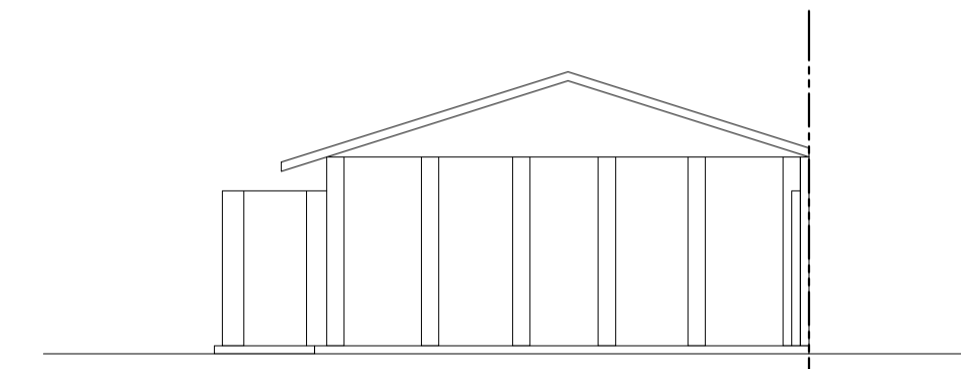


**EX SOUTH ELEVATION - GARAGE**  
SCALE 1:100

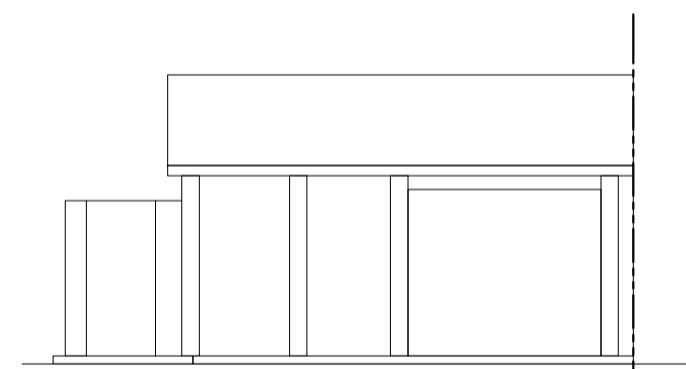



**EX WEST ELEVATION**  
SCALE 1:100

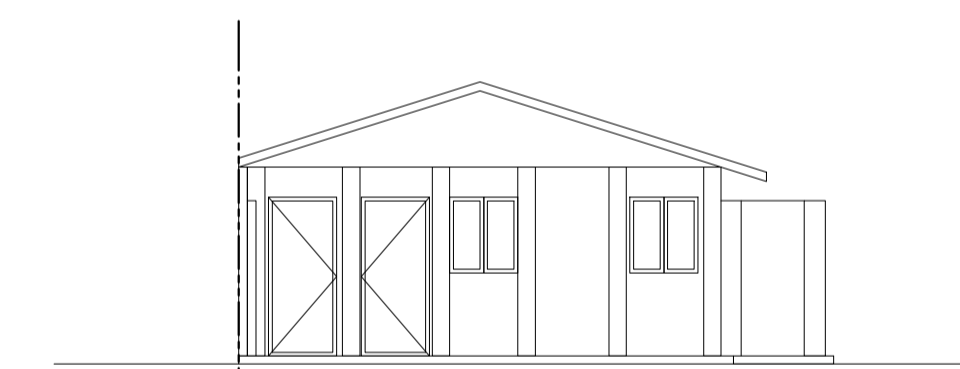

**EX NORTH ELEVATION**  
SCALE 1:100

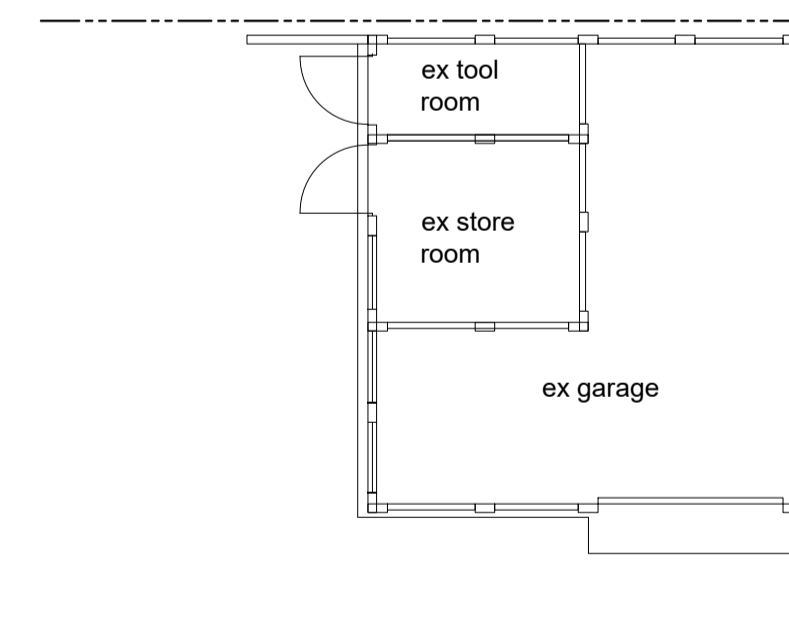

**EX GROUND PLAN - GARAGE**  
SCALE 1:100

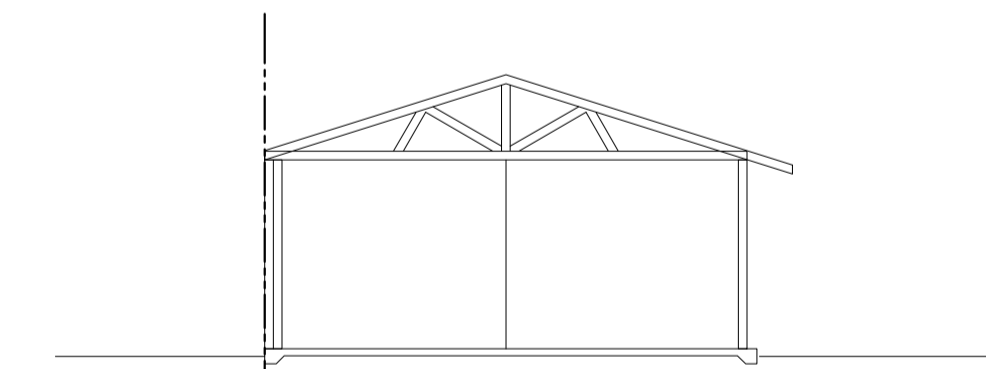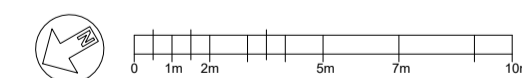

**EX SECTION A-A**  
SCALE 1:100

Architects Collaborative cc.  
41 Cedar Road PO Box 17181  
Glenwood Congella  
Durban 4013  
4001 South Africa  
Tel. +27 31 - 206 1591, Fax. +27 31 - 206 1590

Design : Y.P Drawn : N.M

Owner's Signature :

Name Sign

Architect's Signature :  
YUSUF .PATEL  
SACAP no: 5218 Sign

Project Name :  
AS-BUILT DRAWINGS FOR SUHAIL  
AGJEE ON PORTION 60 OF ERF 2128  
DURBAN  
PN: 94 JUNIPER ROAD,  
ESSENWOOD

Drawing Title :  
AS-BUILTS OF GROUND/SITE PLAN  
AND ELEVATIONS AND SECTIONS

Contract No. :

Scale : AS SHOWN Date :22 NOV 2021

Drawing no. : 22112021 - 00 Rev. ....