


ITEM:	NO:	SIZE (mm):	THICKNESS:	GLASS:	FRAME:
w1	1	1600 x 2100	6.3mm tsg	1/3clear-2/3frosted	aluminium
w2	1	3000 x 2100	6.3mm tsg	1/3clear-2/3frosted	aluminium
w3	1	1250 x 2100	6.3mm tsg	1/3clear-2/3frosted	aluminium
d1+	1	1600 x 2100	6.3mm tsg	1/3clear-2/3frosted	aluminium
sd/lite	2	1025 x 2100	6.3mm tsg	1/3clear-2/3frosted	aluminium


NORTH WEST ELEVATION (1 : 200)

ESTHER ROBERTS ROAD

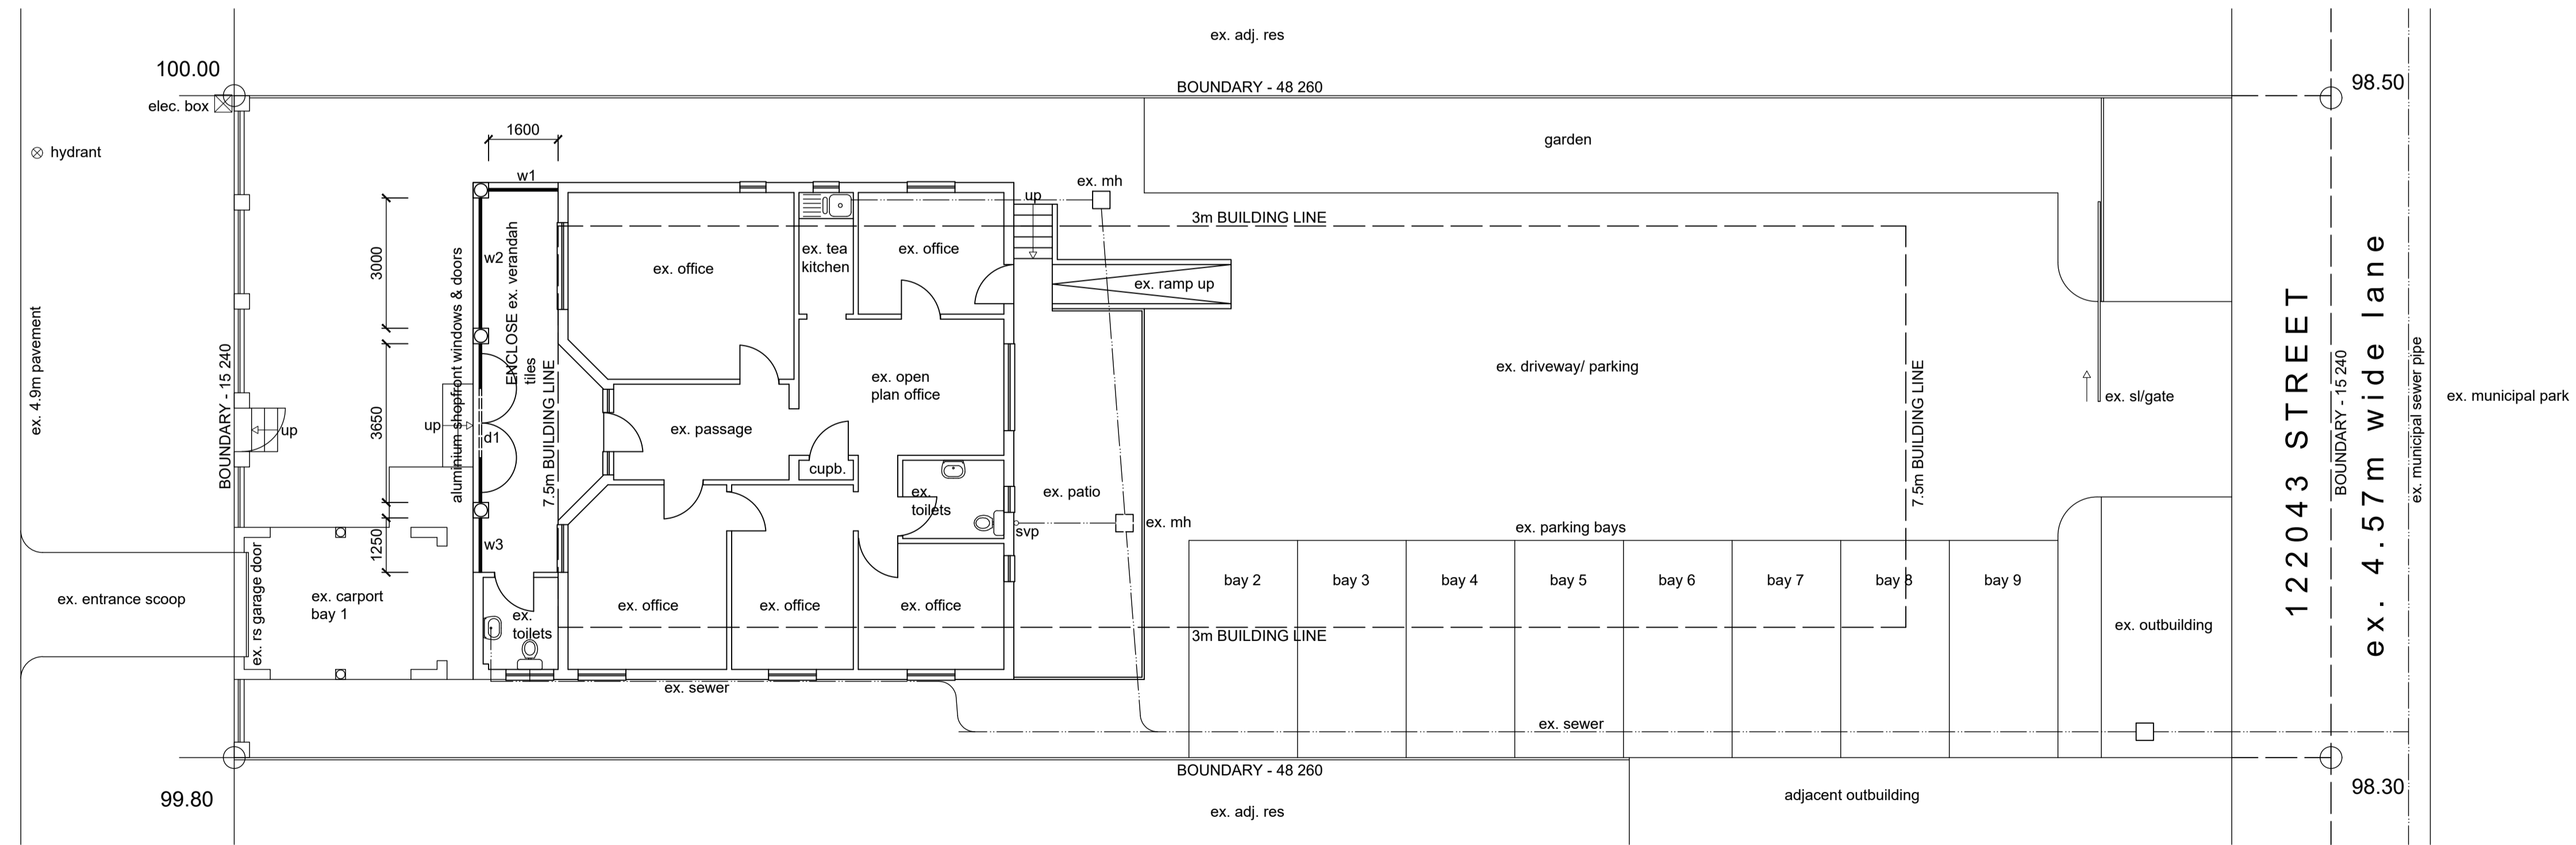

GROUND STOREY PLAN/ SITE PLAN (1 : 100)

Additional Area = 0.00 m²

Client's Signature  Contact Number 072 823 1220
Rate No. 1111 2040 / 000

ENCLOSE EXISTING VERANDAH AT 28 ESTHER ROBERTS ROAD ON PORTION 7 OF ERF 6670 DURBAN FOR OIC HOLDINGS (PTY) LTD

GRAHAM BRAUM

ARCHITECTURAL DESIGNER
Pr. S. Arch. T
Reg. No. ST0010

13 Helen Joseph Road Durban 4001
Tel. : 031-2054142
Cell : 082 454 0441

Email : gpbdesigners@gmail.com

SCALE : 1 : 100 / 1 : 200

CHECKED : G. P. BRAUM

DRAWN/DESIGNED : M. R. AZMUTH

DATE : JUNE 2022

Drawing No. : AS-BUILT

