
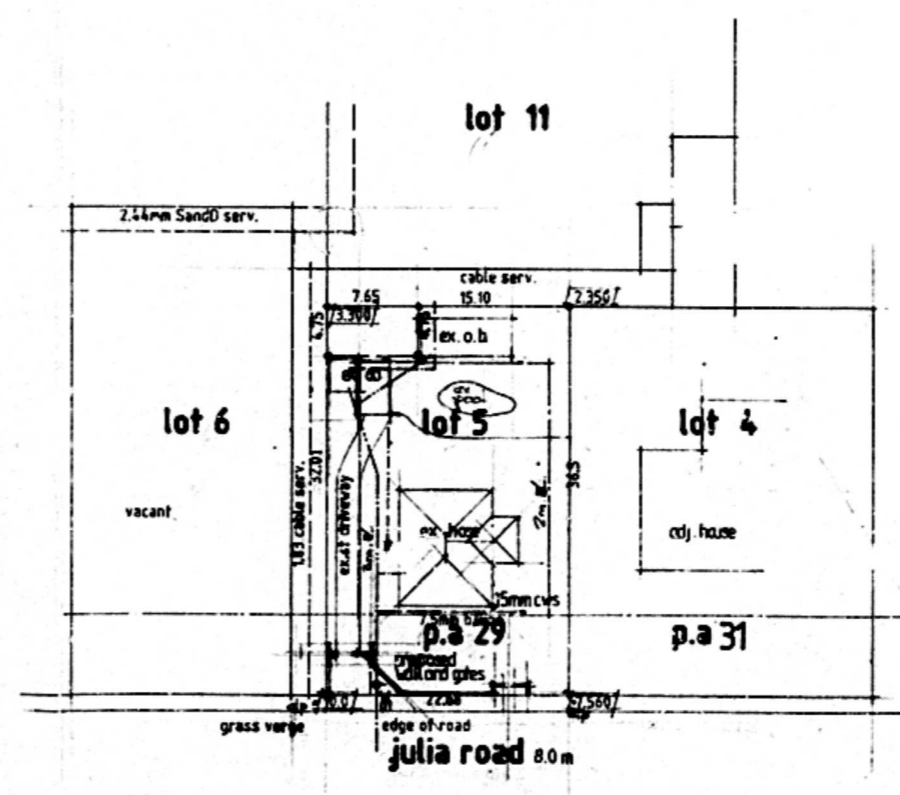
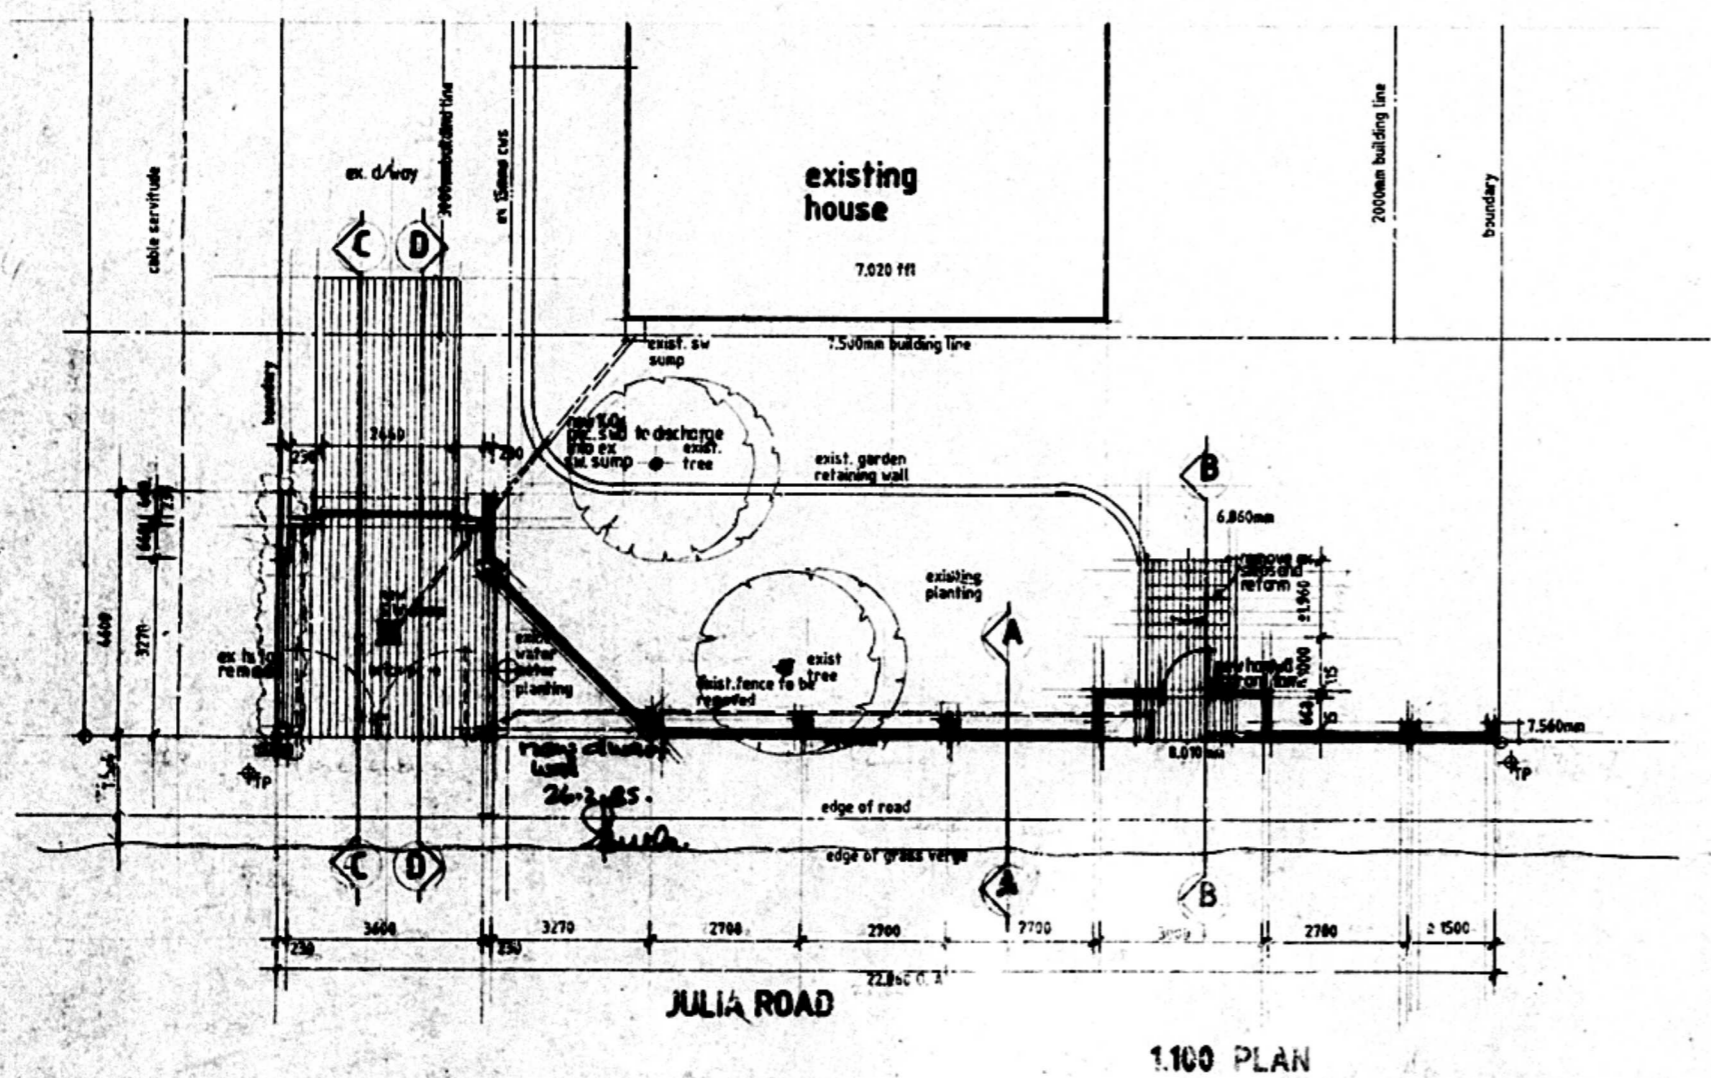
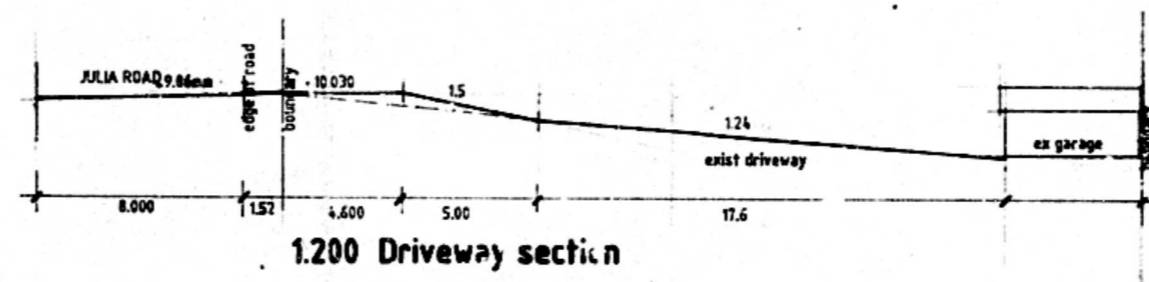


Wyskings		Revisions	
Number	Date	By	Details
ORIGINAL			
1/1		COPY	3
CITY OF DURBAN			
PLAN NO. 90/1/RS			
APPROVED 1985. 3. 13.			
D. C. MALLARD			
CITY ENGINEER			

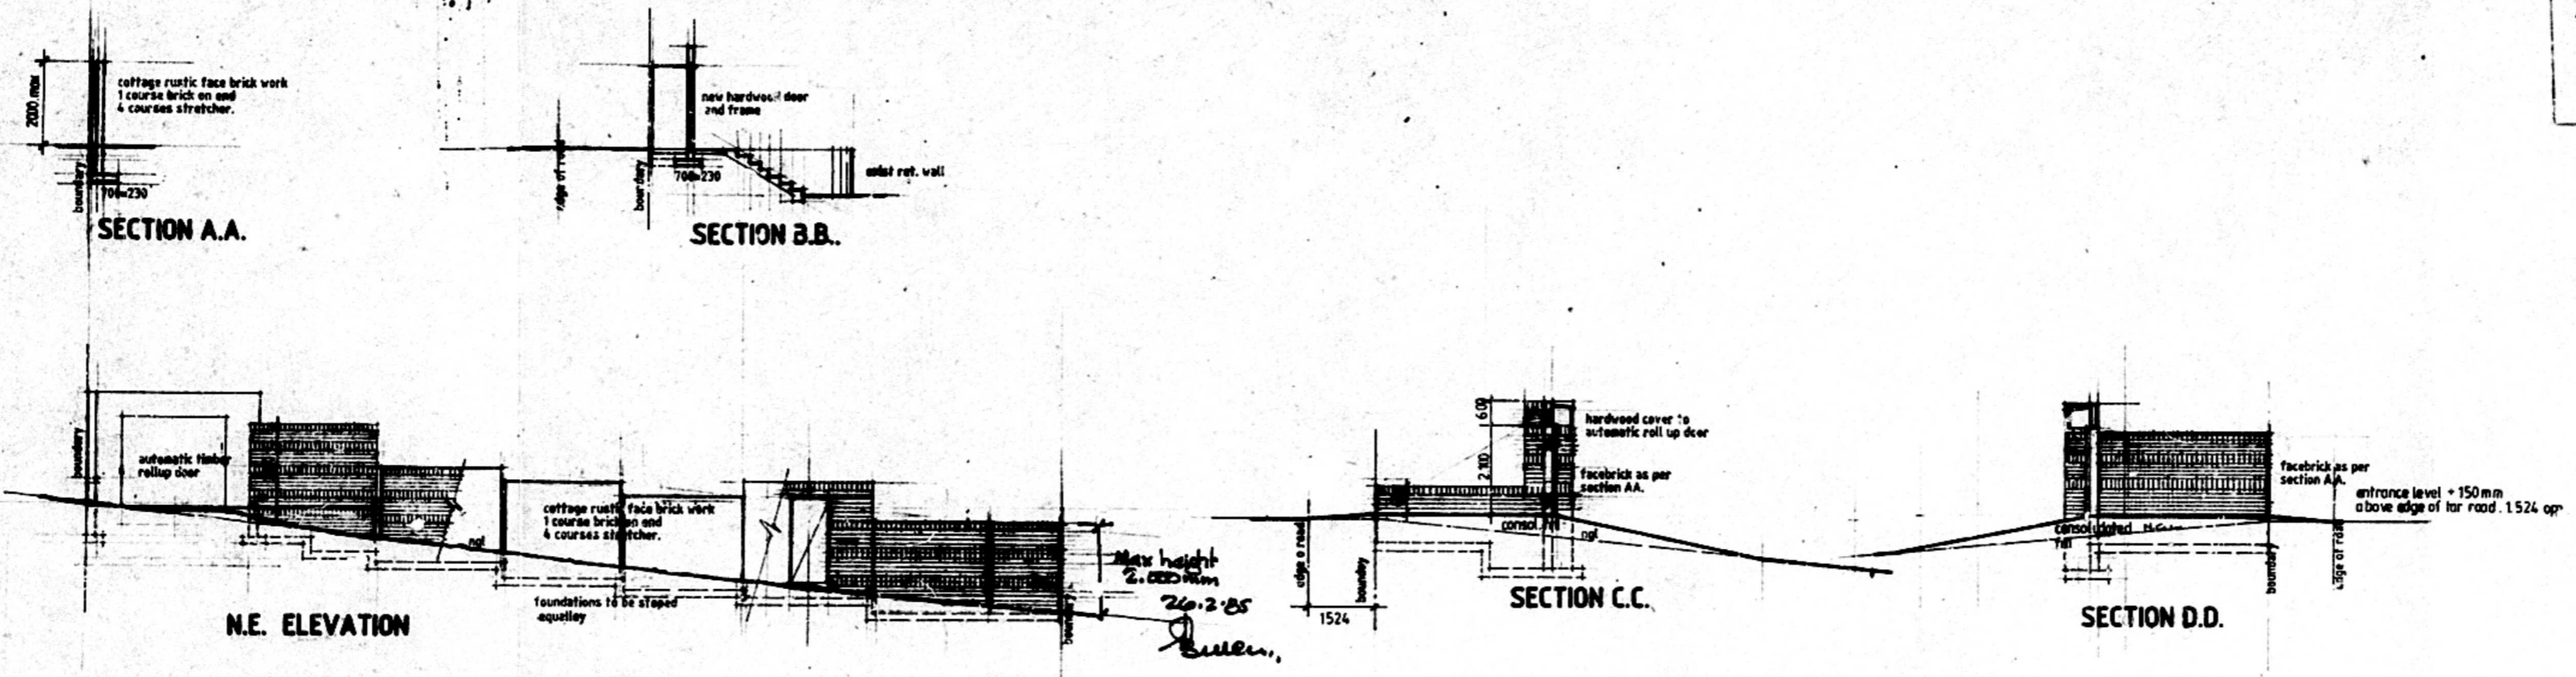

SITE PLAN
 5 OF D OF 3 AND 4 BLOCK E
 OF BRICKFIELD NO. 806
 RATE NO 623200. 50
 SCALE 1:500

AS BUILT
 2-2-87
 RONGAGE LEVEL REQUIREMENTS
 Tops of foundations of any frontage works to be at least 0.270m below the levels given below.
 Where no level is recorded, foundations shall not be higher than the nearest edge of the adjacent hardened road.
 Vehicular and pedestrian entrances on the road reserve boundary shall be constructed at the same grade as the curb or road and shall either (A) conform to both of existing footpaths, or (B) be at a level
 (i) above/below nearest existing curb OR
 (ii) above/below the nearest edge of the road/adjacent road.
 Date: _____ Signature: _____
 It is confirmed:-
 (A) Existing frontage level in order.
 (B) Existing frontage level NOT IN ORDER.
 (C) Un-ascertained from _____ submitted.
 Date of Second Circulation: _____ Signature: _____


TOWN PLANNING BRANCH
APPROVED
 DATE - 1 MAR 1985
 Signature: _____

All metes moet op die terrein nagegaan word voor die werk begin.
 All dimensions to be checked on site before any work is put in hand.
 Kopiereg voorbehou Copyright reserved


Architects: **Stauch Vorster**
 Planners: **Stauch Vorster**
 Pretoria Johannesburg Pieterburg Durban Worcester
 Cape Town Port Elizabeth Oudtshoorn East London
 King William's Town Mosselton Westport

Klient: **Mrs Morton**
29 Julia road
Durban
 Client:
 Projek: **proposed boundary wall and entrance gates at 29 Julia road Durban**
 Projek: **proposed boundary wall and entrance gates at 29 Julia road Durban**





working drawing			
Drawing			
Skaal 1:500/1:500	Datum 24-12-84	Geteken	Nagezien
Scale	Date	Drawn	Checked
Projek Nr	Tekening Nr	Wyskings	
Project No	100	100	
	Drawing No	Revision	

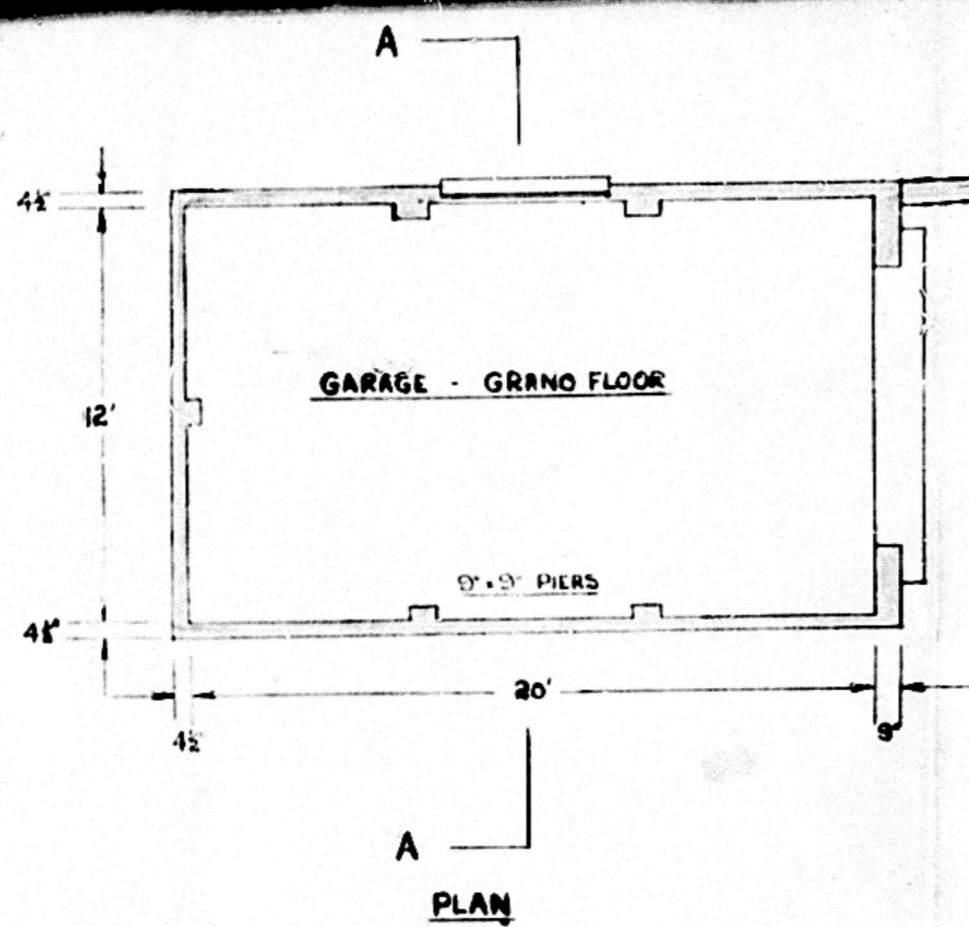

ALL WALLS PLASTERED EXTERNALLY
BAGGED INTERNALLY

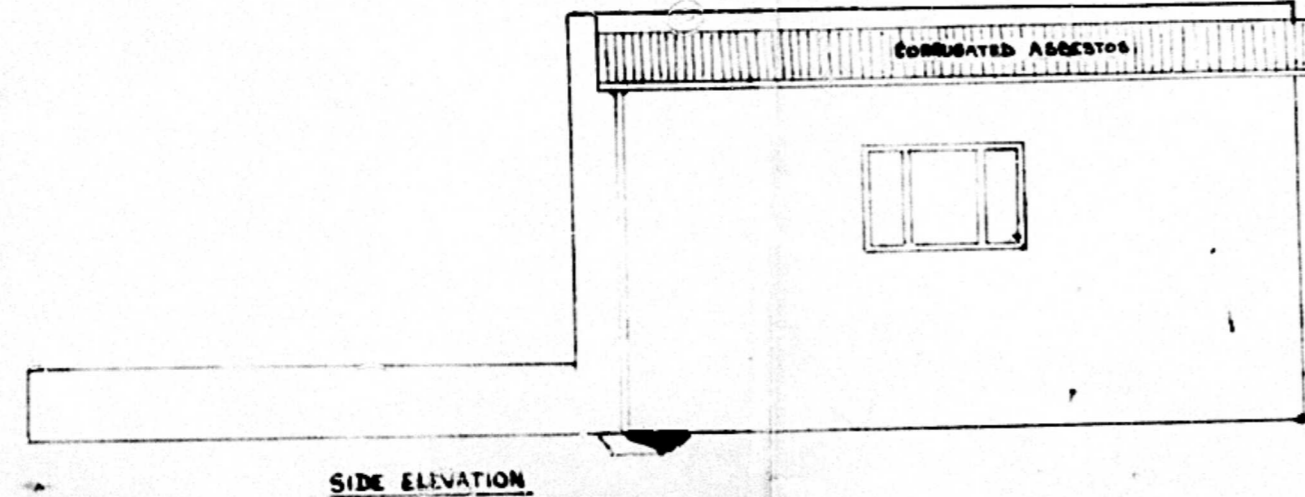

SCALE 1" = 4'

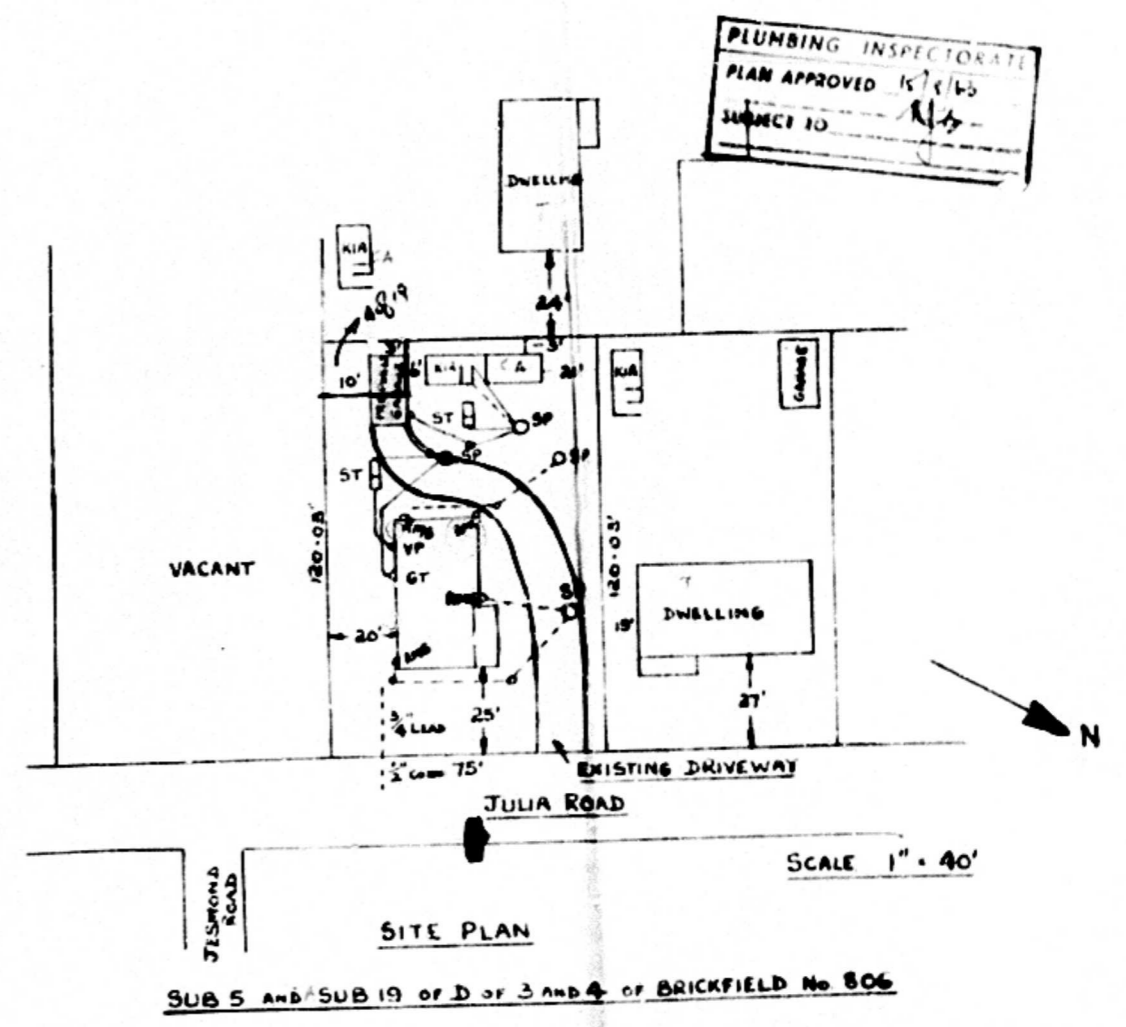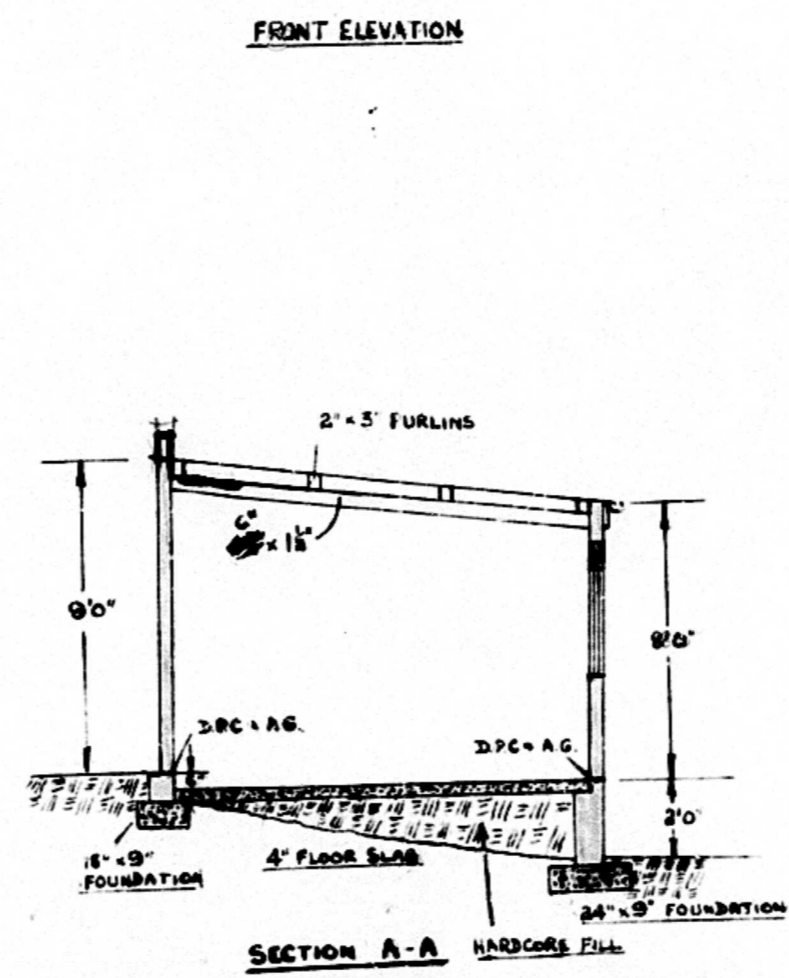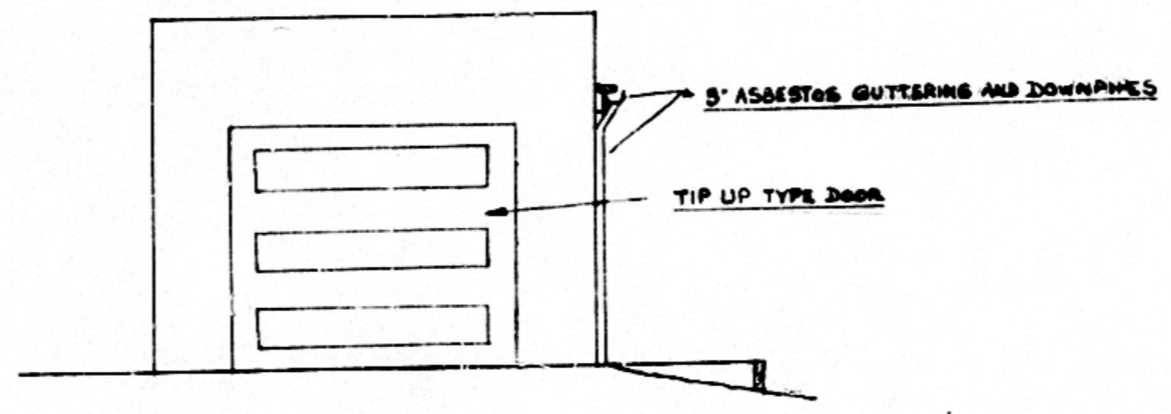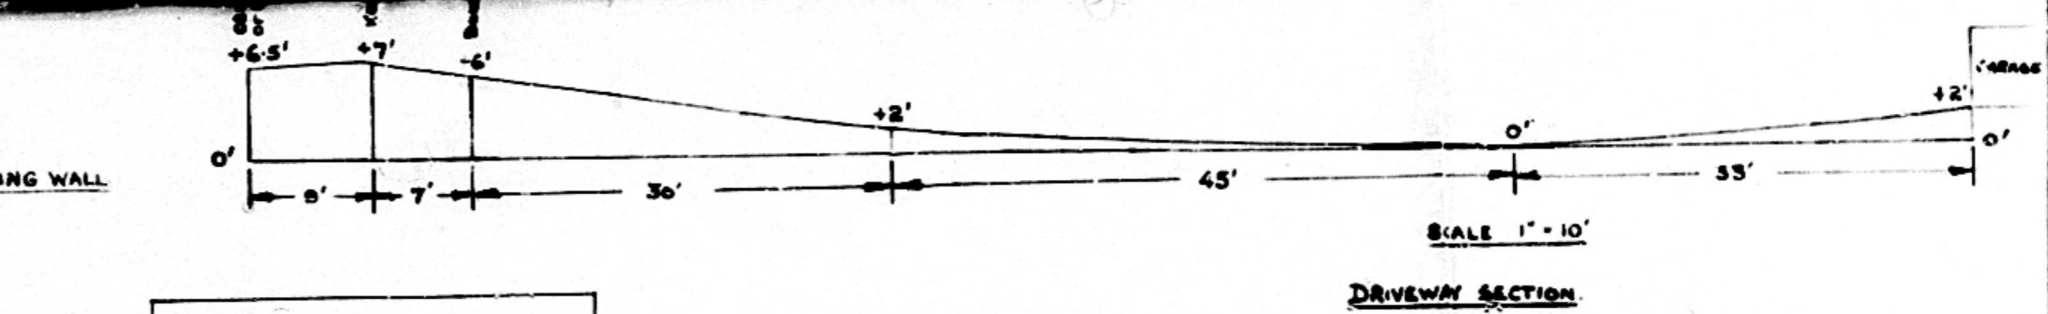

PROPOSED GARAGE FOR B.K.RICH
SUB 5 AND SUB 19 OF D OF 3 AND 4 OF BRICKFIELD No 806

ELEVATIONAL CONTROL
REFERENCE No. *10/24/62*
CHECKED BY *[Signature]*
PLANS APPROVED SUBJECT TO

PROPOSED AREA, 626'

SHEET 1/1

CITY OF DURHAM
 PLAN NO. 649/1
 APPROVED 22
 C. G. HANDS
 CITY ENGINEER PER. 1

29 Julia
 O/B

ALL SEPTIC TANKS TO BE 10FT. FROM BUILDINGS OR BOUNDARIES
 ALL SOAK PITS 12FT. FROM BUILDINGS OR BOUNDARIES





CITY HEALTH DEPT.
 PLANS SECTION
 RECEIVED
 29 OCT 1971
 REPORT No. 29/11/71
 APPROVED

FRONTAGE LEVEL REQUIRED
 TOPS OF FOUNDATIONS OF ANY FRONTAGE
 AT LEAST 6" BELOW THE LEVELS GIVEN HERE
 PEDESTRIAN ENTRANCES ON THE ROAD
 SHALL BE CONSTRUCTED ON THE SAME OF
 ROAD OPPOSITE AND AT A LEVEL

ABOVE THE NEW EXISTING LEVELS OPPOSITE
 TO ABOVE EDGE LEVEL OF TARRED ROAD

SITUATED APPROX. DIRECTLY OPPOSITE

TO BE CONSTRUCTED TO BACK OF EXISTING
 EXISTING ENTRANCE LEVELS IN ORDER

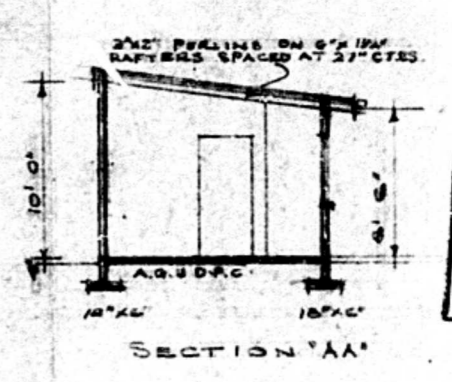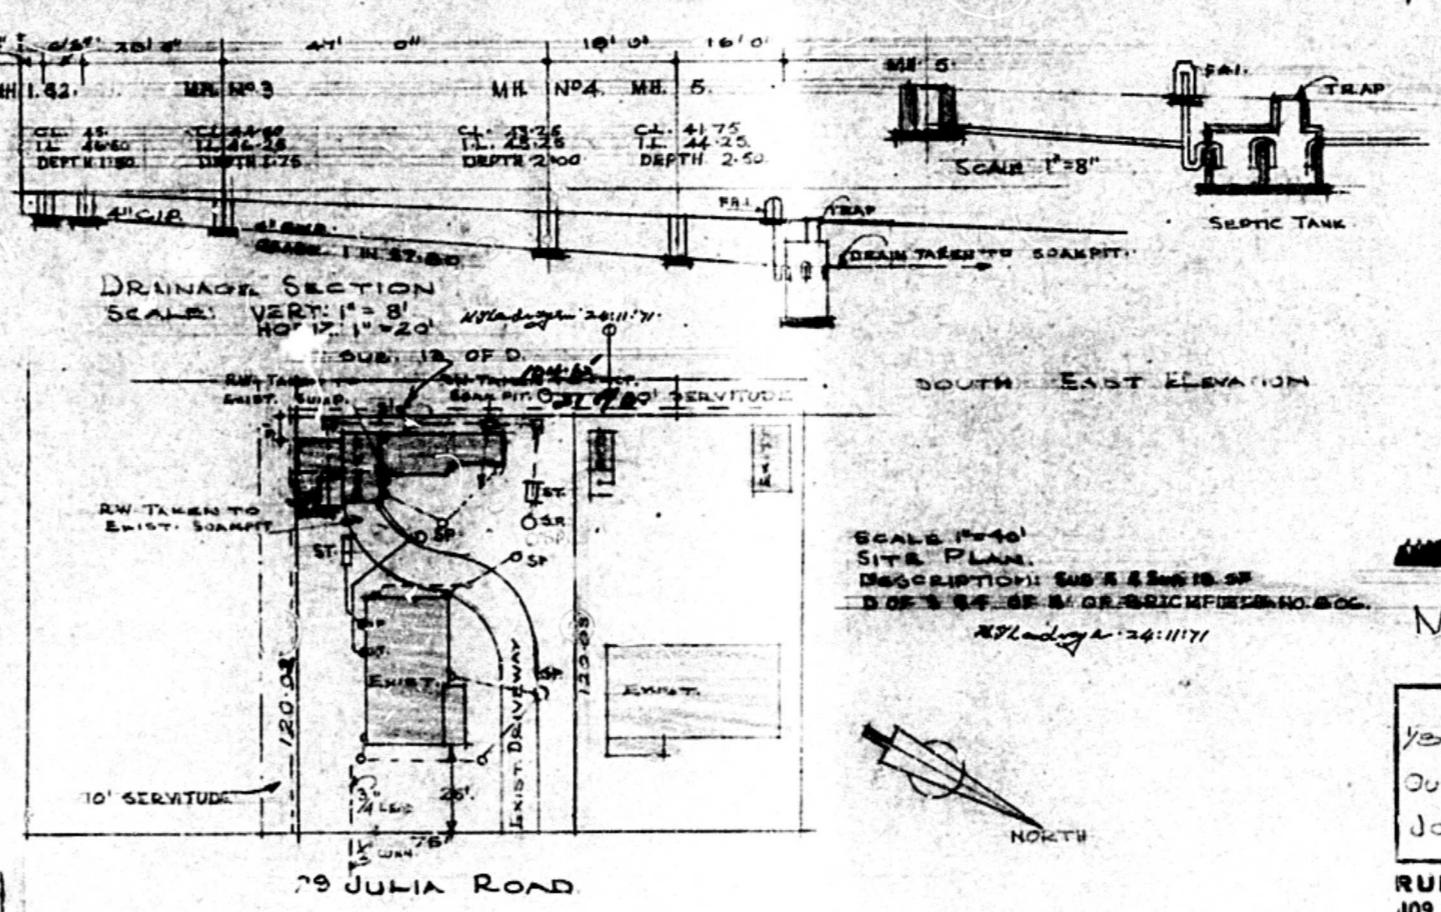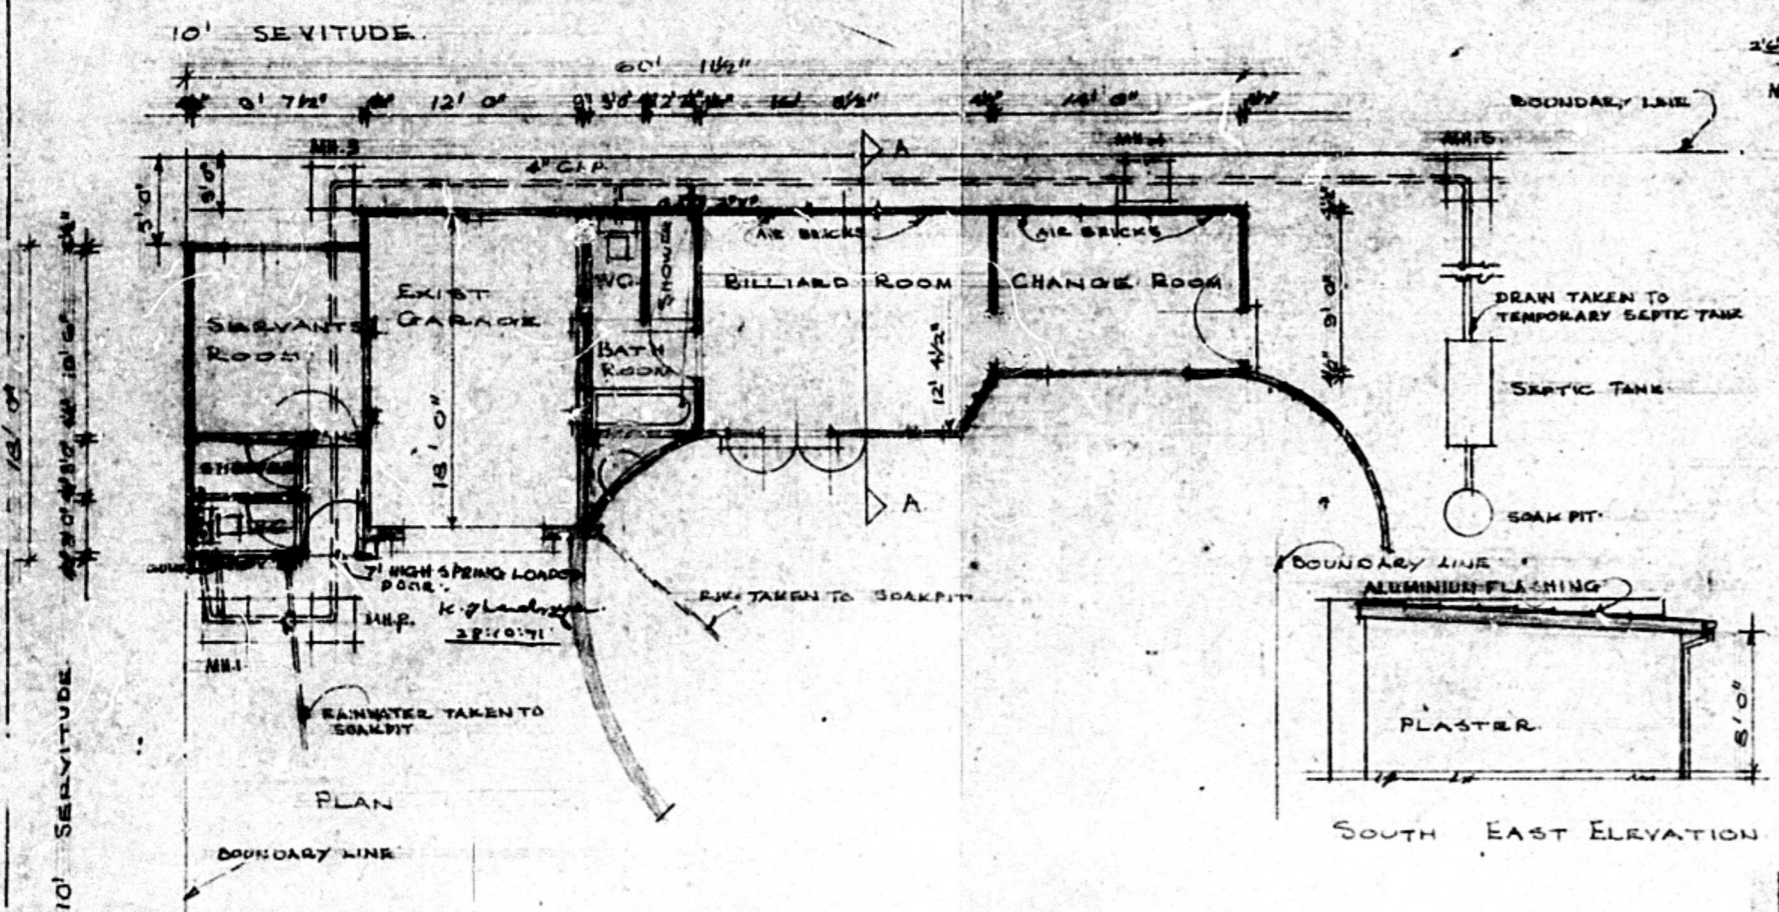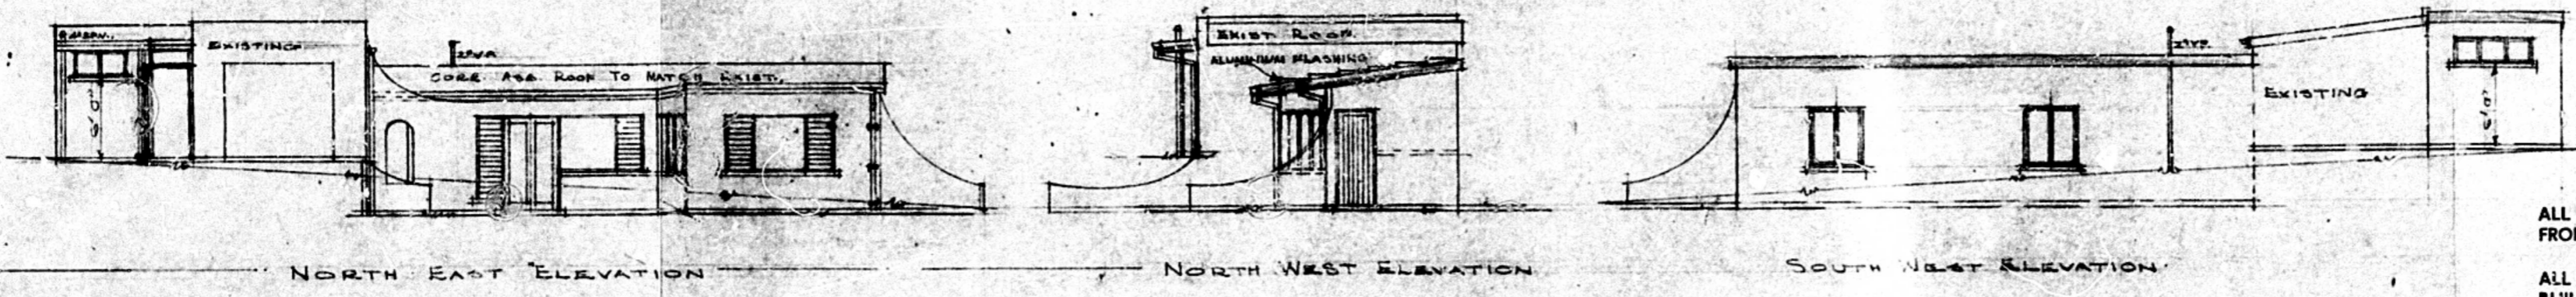


MR. M.D. JOHNSON.

1/8" SCALE PLAN OF
 OUTBUILDING FOR MR. M.E.
 JOHNSON AT 79 JULIA ROAD.

RUPERT G. STEAD, M.A.
 109 AFRICAN LIFE BLDG., DURHAM.

DATE 6/10/71
 SCALE 1/8"
 DRAWN R.T.
 JOB No. 312
 2
 ARCHITECT
 PHONE 313541

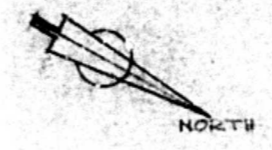

DUREAN CORPORATION
SCALE 1" = 8'-0"


PROPOSED HOUSE FOR B. K. RICH.

CITY & WATER ENGINEERS DEPARTMENT
LOANS TO INDIVIDUALS
HOUSING SECTION


TYPE 38 B

*SECTION AREA, ACE 1934
All alterations shown in red
to be made in accordance with
the provisions of the City Ordinance
of which a copy is required, unless
noted also to Section 41 of this Act.*


*9-20-35 P.R. Plan
Height 2.61 m/f
Exp. of 1/2" on floor
Steel windows*

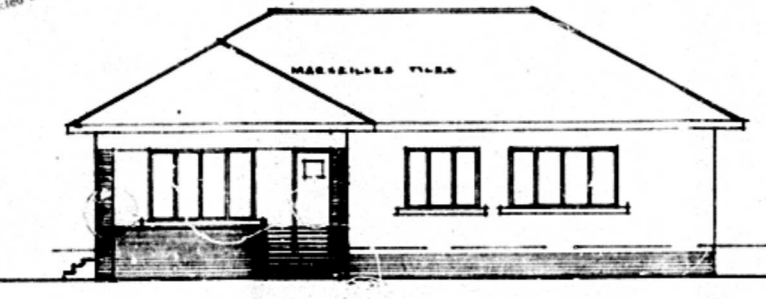

FRONT ELEVATION.

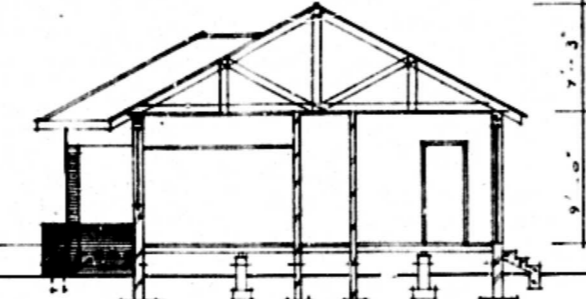

SECTION A-A.

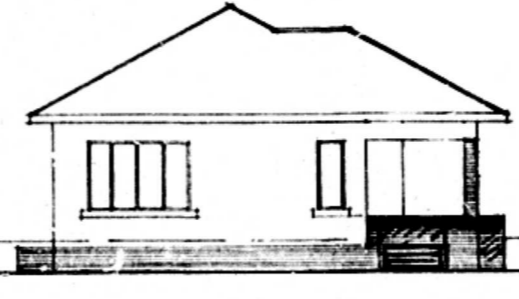


END ELEVATION.


ALL OVERLAYS FROM ENGINEERS
DRAWN BY [unclear]
A CONSULTING ENGINEER

SECTION
Section of floor & foundation
to be shown in conformity with
obtaining from [unclear] or as
stated hereon.

Date: _____
Reference is made to Section 41
of the City Ordinance which
requires that all plans for
construction of buildings shall
show the foundation and floor
plans to be shown in red
to be made in accordance with
the provisions of the City Ordinance
of which a copy is required, unless
noted also to Section 41 of this Act.

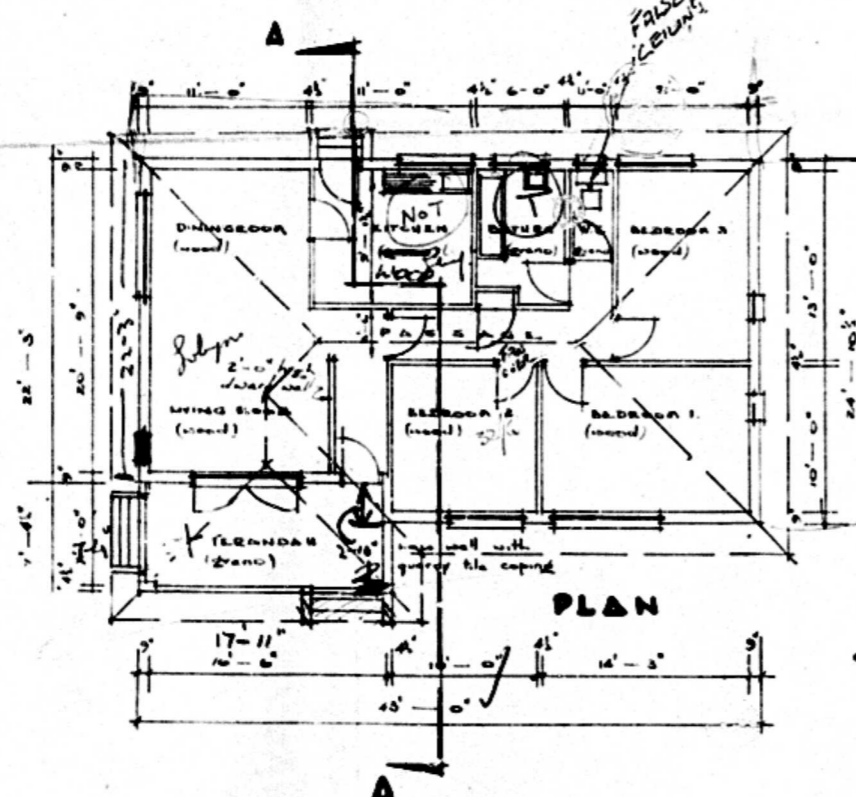


PLAN

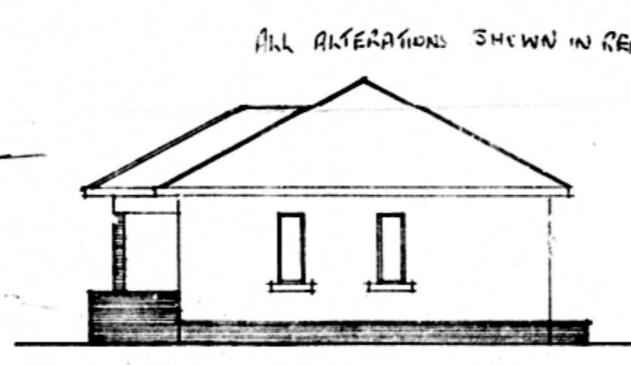


END ELEVATION.

ALL ALTERATIONS SHOWN IN RED

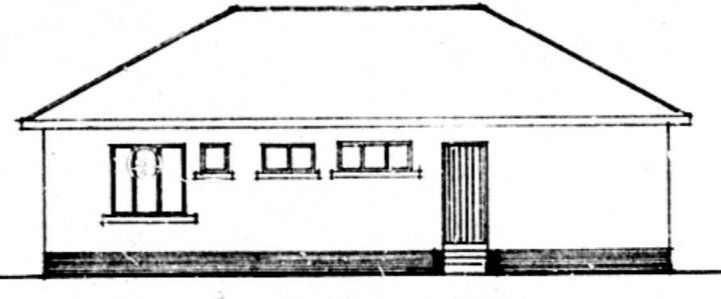



BACK ELEVATION.

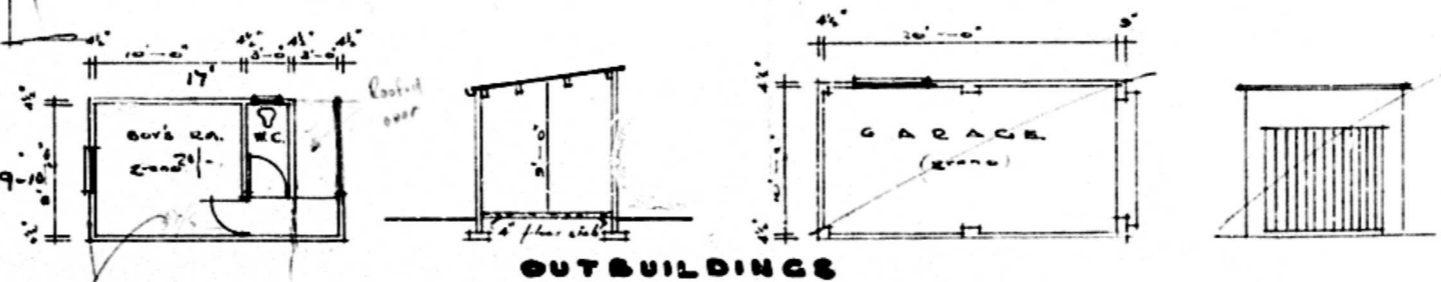


OUTBUILDINGS

*9-20-35 P.R. Plan
4/20/35
Steel w
6 in fl.*


A. W. [unclear]
CITY & WATER ENGINEERS
T.C.D. Plans for
T.C.D. 38 B
24. 5. 35
Loans to Individuals
A. W. [unclear]
CITY & WATER ENGINEERS

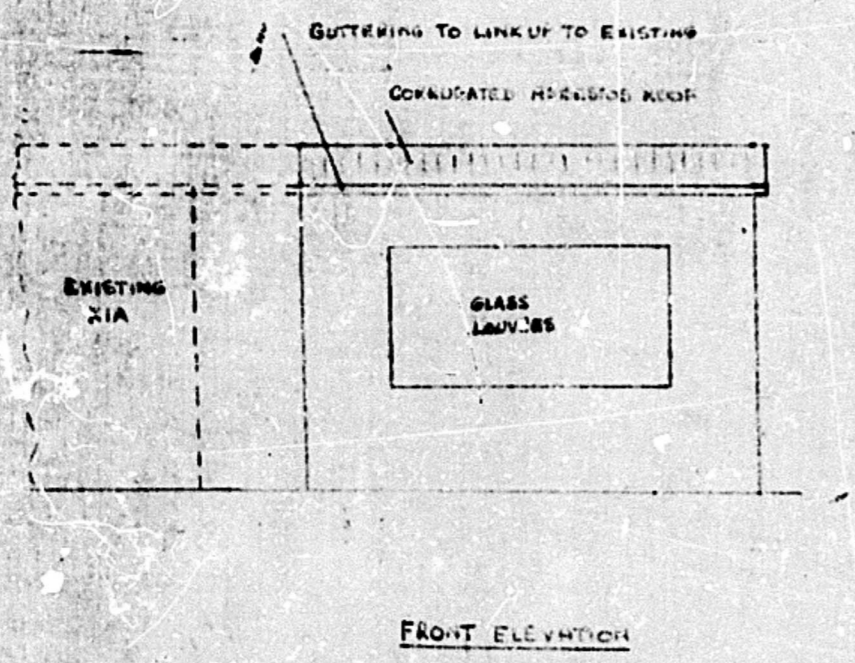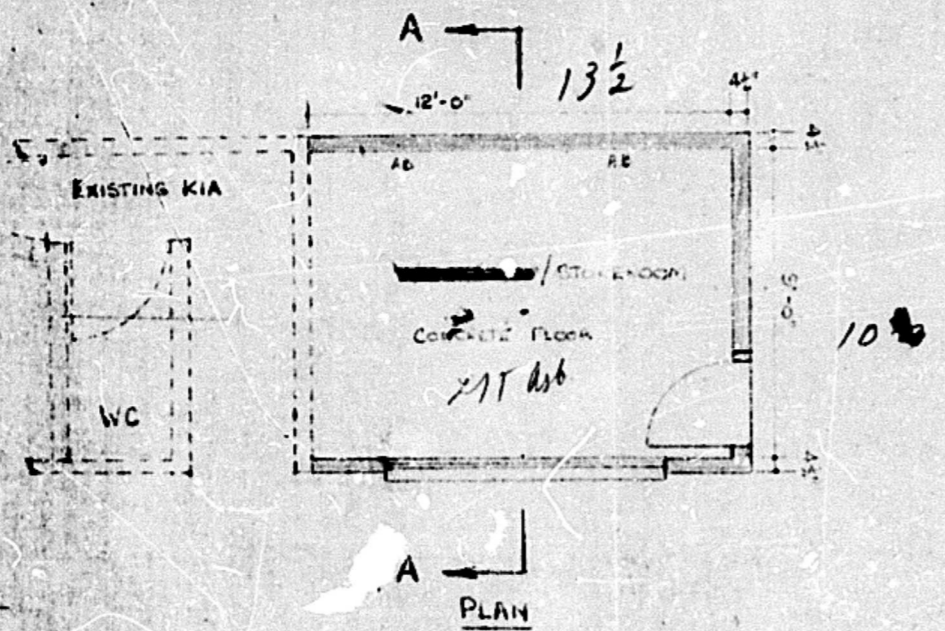

ALTERATIONS TO EXISTING OUTBUILDINGS
 FOR B.K. RICH ON SUB 5 OF D OF 3 AND 4 OF
 BRICKFIELD No. 806
 SCALE 1" = 4'

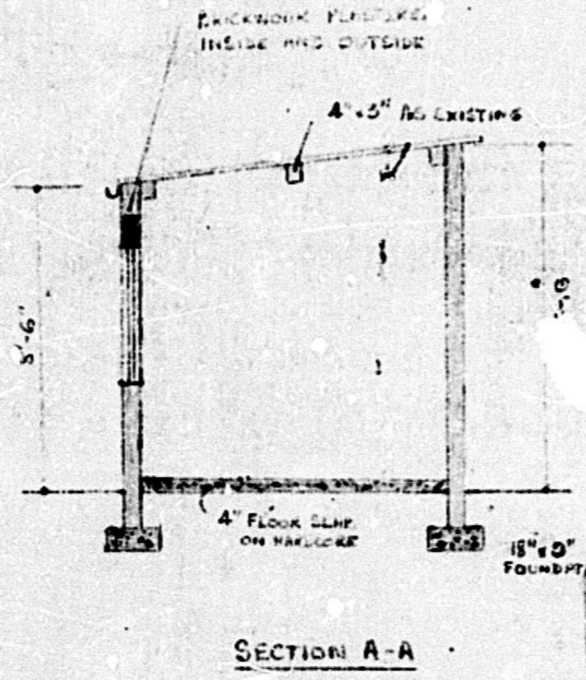

PLUMBING INSPECTORATE
 PLAN APPROVED 16.5.60
A. M. Walker

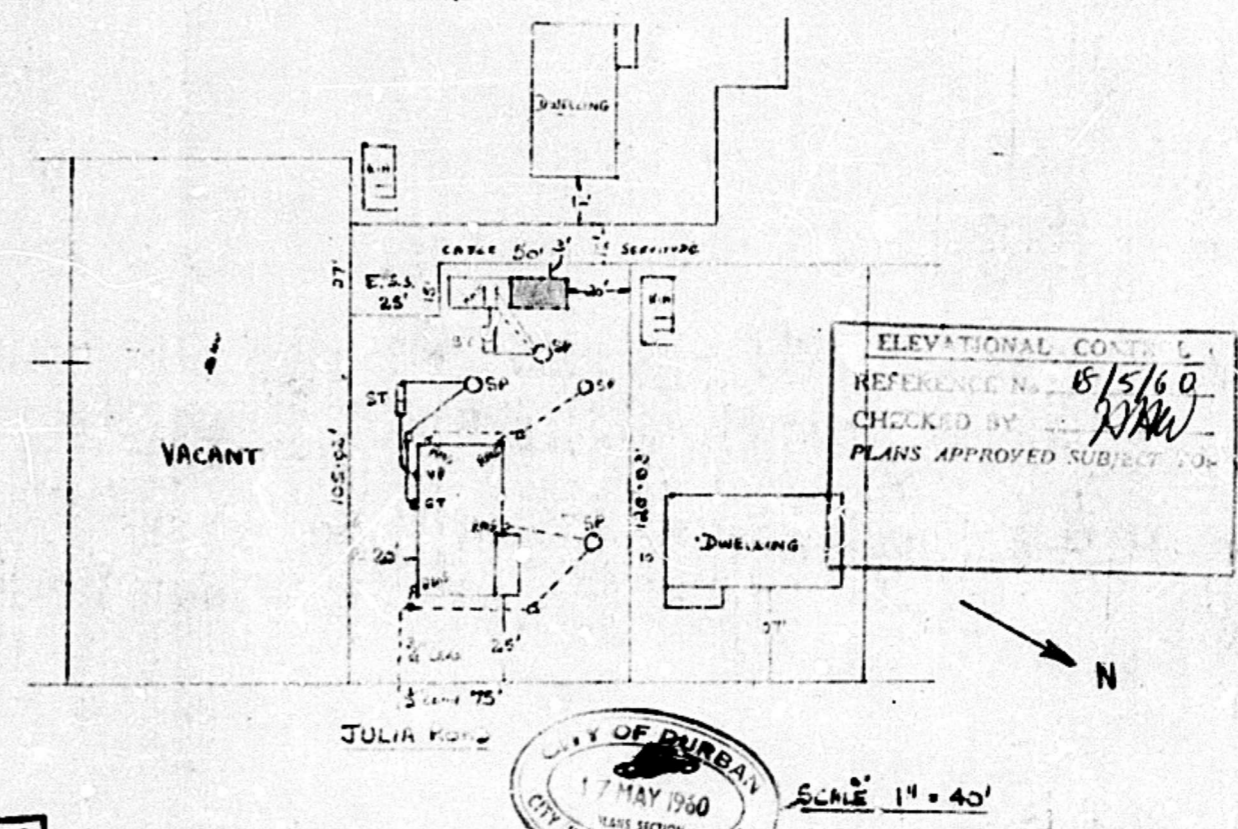

SITE PLAN FOR B.K. RICH
 SUB 5 OF D OF 3 & 4 OF E OF BRICKFIELD No. 806
 SCALE 1" = 40'