




SOUTH ELEVATION 1:100

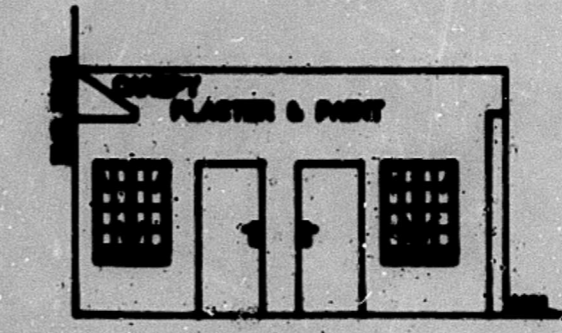

SOUTH ELEVATION 1:100

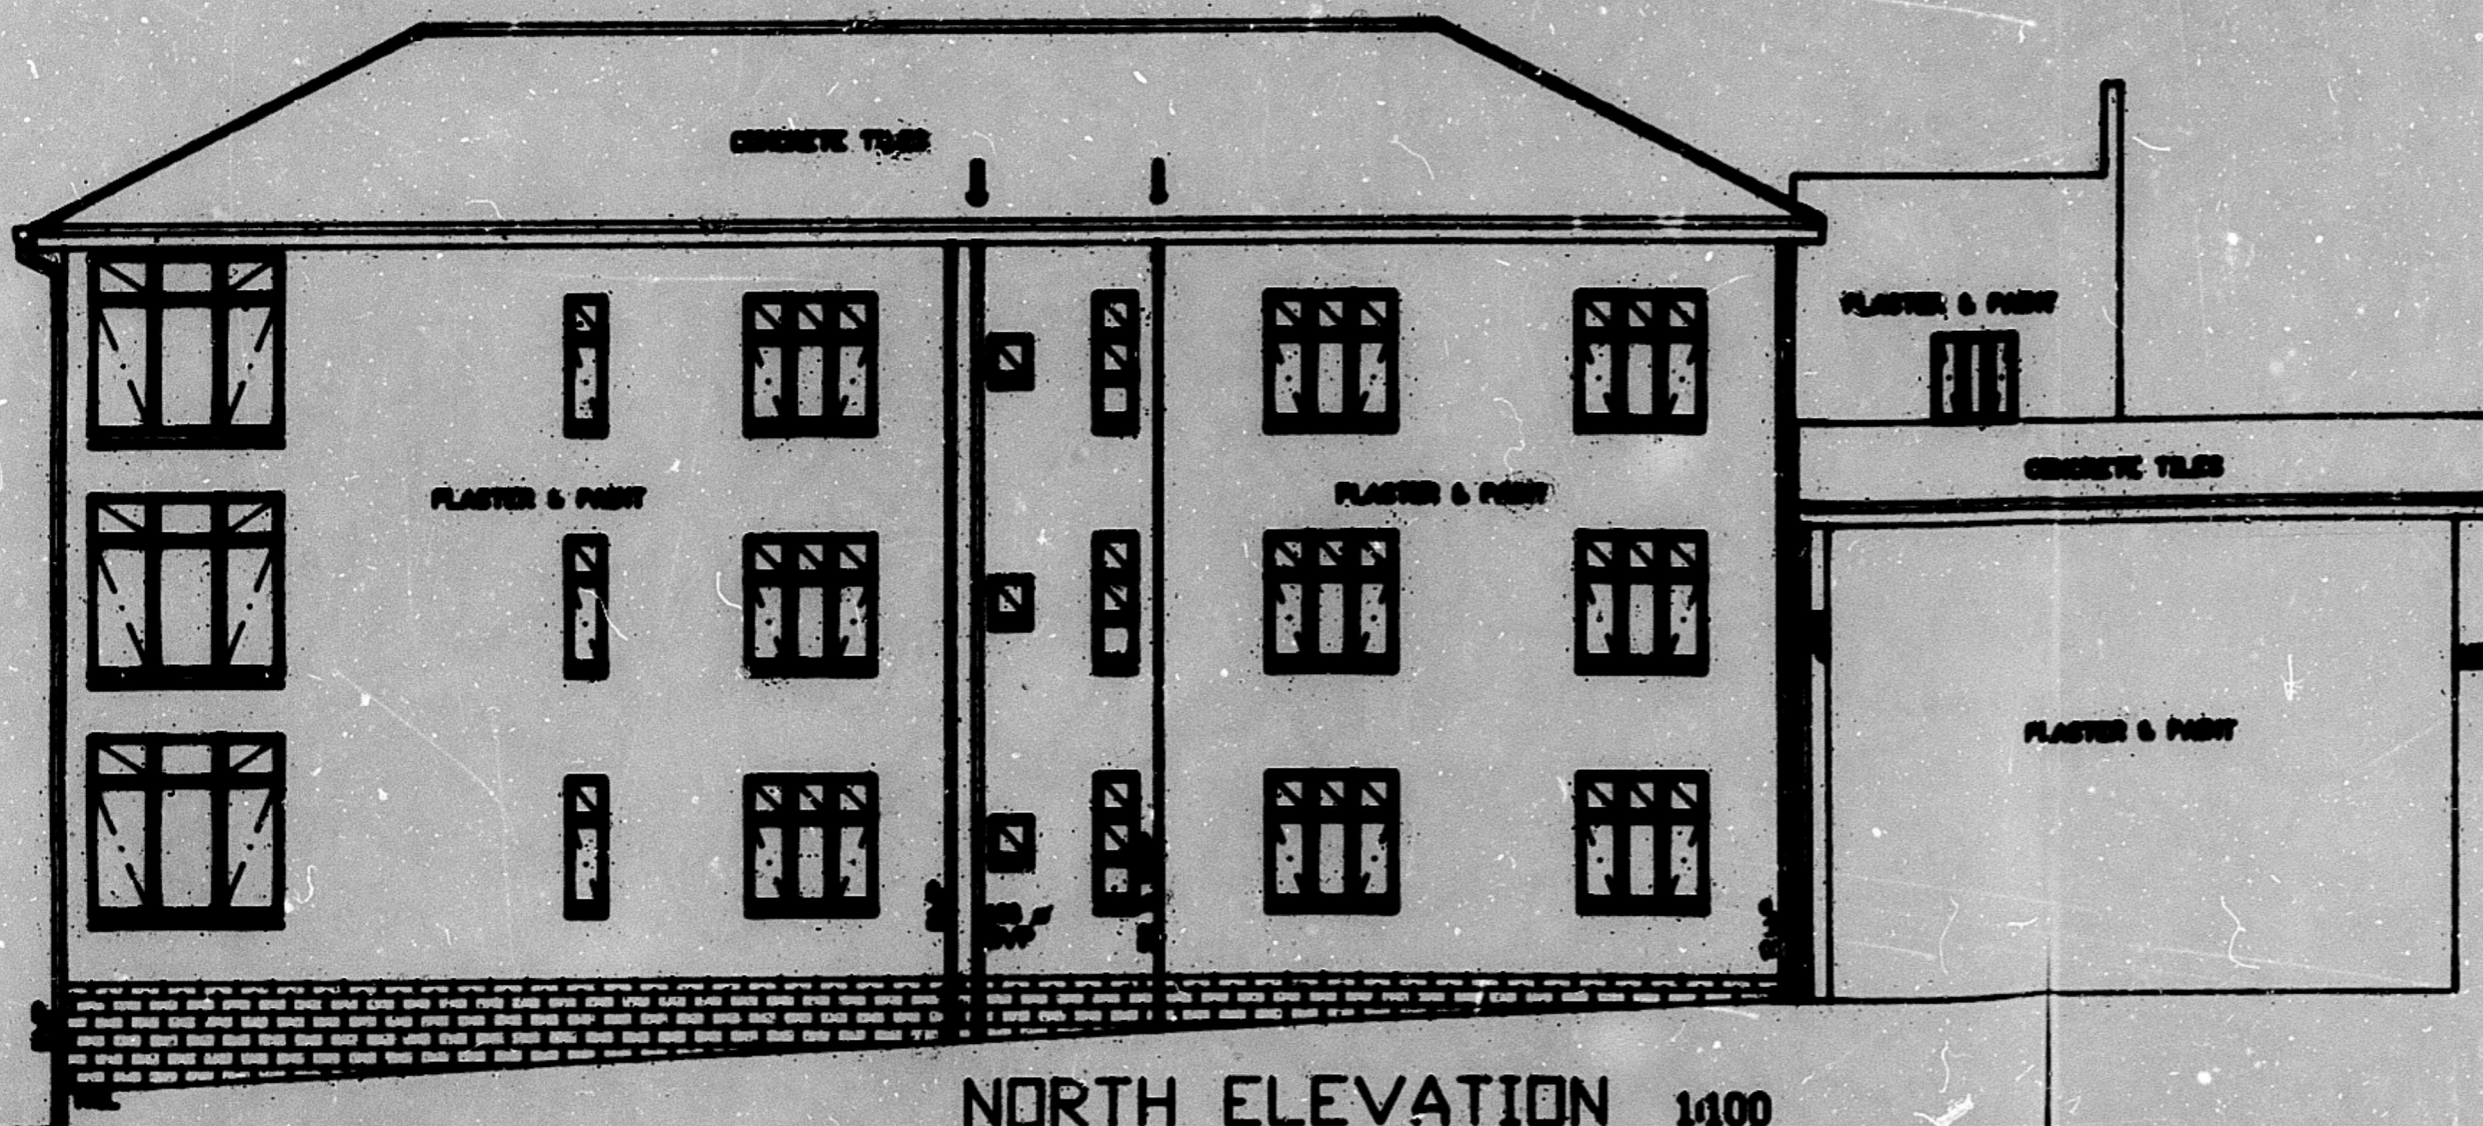

NORTH ELEVATION 1:100

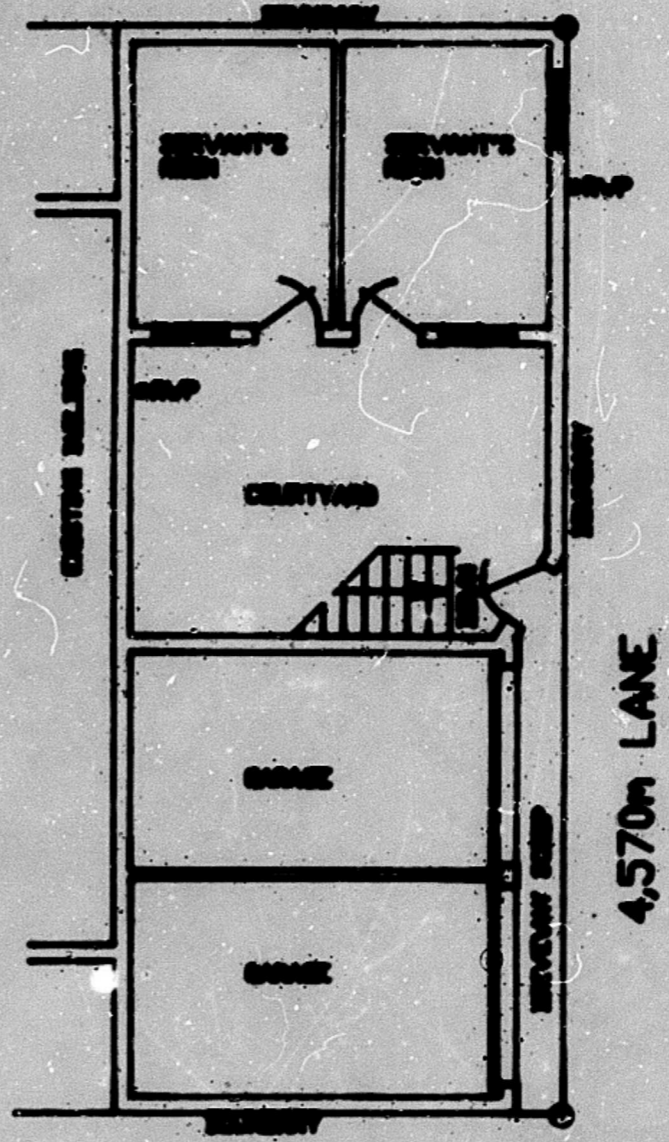

LOWER GROUND FLOOR PLAN 1:100

Approved for the purposes of regulation
2 (2) (b) (iii) under the Sectional Titles Act
No. 66 of 1971

D. C. MACLEOD Date 24/12

CITY ENGINEER per [Signature]

SHEET 3 OF 3.

AS BUILT PLAN FOR
"DOVEHILL".
LOT 10 of 19 of
20 of B.
AT 178 CURRIE ROAD

For: Mrs. M.P. TAYLOR
M. Taylor

COMPU-DRAUGHT
7 BOUGAINVILLEA
DRIVE. GLENHILLS,
4051. ph:847350 *[Signature]*