



EAST ELEVATION 1:100

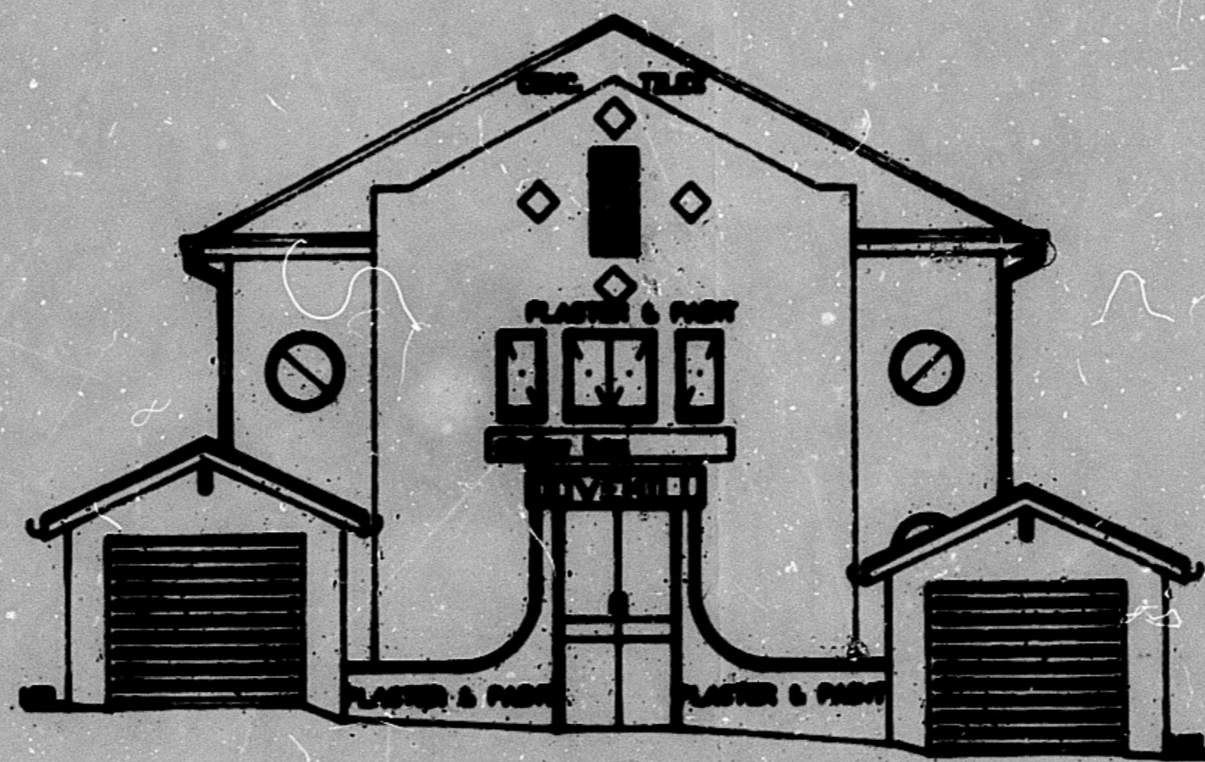

WEST ELEVATION 1:100

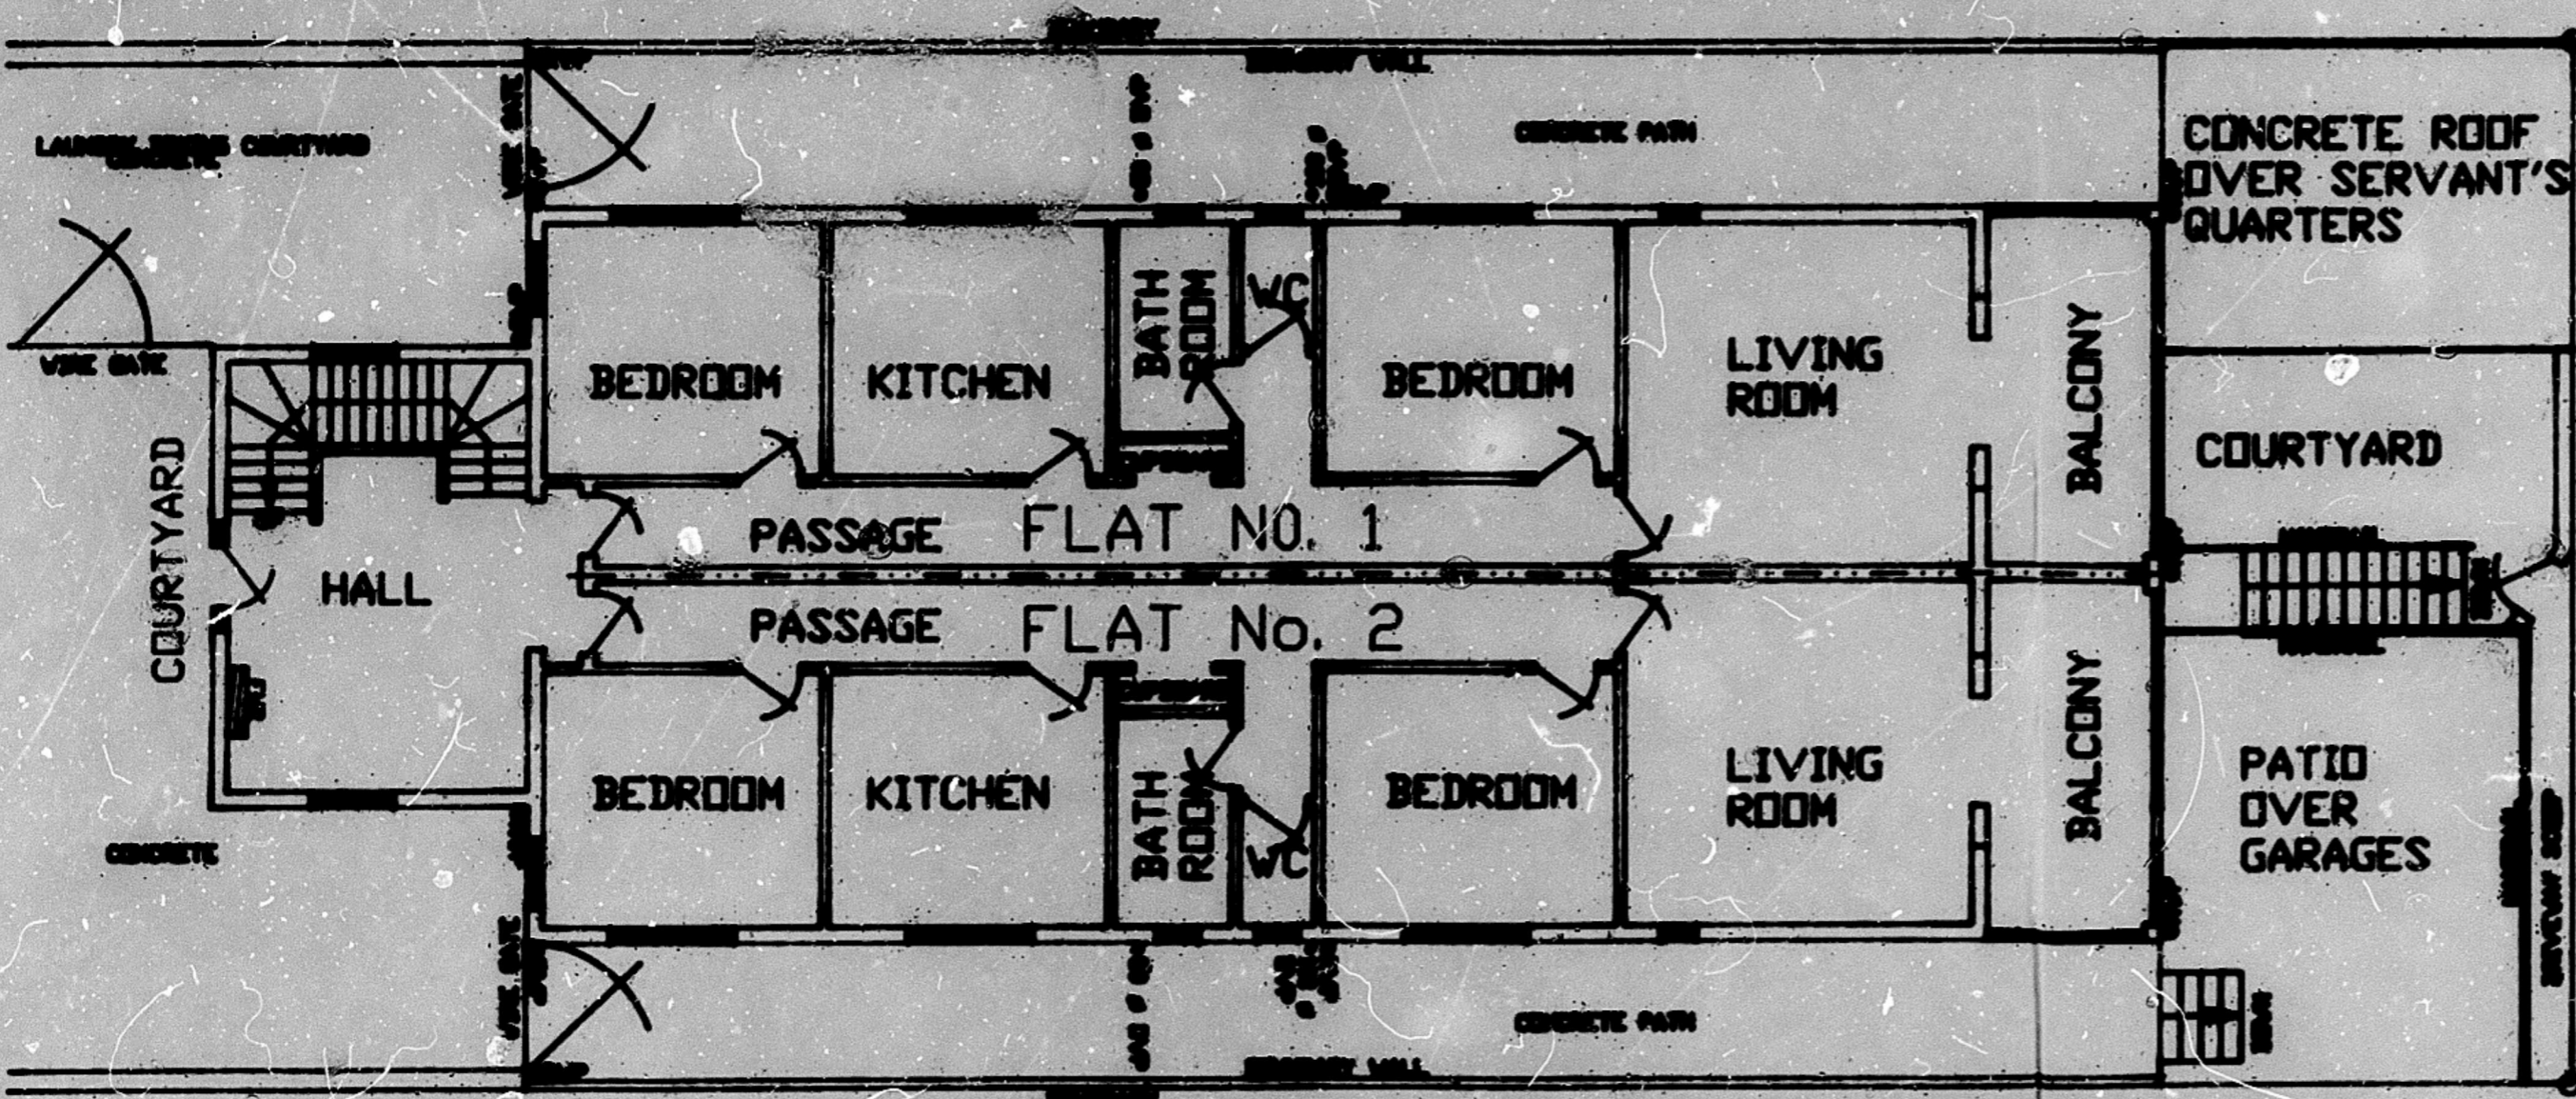

GROUND FLOOR PLAN 1:100

Approved for the purposes of regulation
 of the Sectional Titles Act
 1986 (Act No. 95 of 1986)
 D. O. REGISTERED DRAWING
 CITY ENGINEER: *[Signature]*

SHEET 2 OF 3.

AS BUILT PLAN FOR
 'DOVEHILL',
 LOT 10 of 19 of
 20 of B.
 AT 178 CURRIE ROAD

For: Mrs. M.P. TAYLOR
[Signature]

COMPU-DRAUGHT
 7 BOUGAINVILLEA
 DRIVE, GLENHILLS,
 4051. ph:847350 *[Signature]*