

CITY OF DURBAN

PLAN NUMBER

0072-10-95-3

APPROVED: R. A. MOORE
 EXECUTIVE DIRECTOR: PHYSICAL
 ENVIRONMENT SERVICE UNIT

R. A. Moore 4/11/96

**SHOULD WORK NOT HAVE
 COMMENCED THIS APPROVAL
 WILL EXPIRE ON ITS FIRST
 ANNIVERSARY DATE.**

ELECTRICITY SERVICES

ANY PERSON undertaking building operations in accordance with this plan is required to ascertain from the Executive Engineer, Electrical, Durban, the location of any electrical services and services in the vicinity of the proposed works.

- 1) The location of any electrical services and services in the vicinity of the proposed works.
- 2) Departmental requirements regarding Substations, Meter rooms and Cables sheaths.

THE AUTHOR OF THIS PLAN IS RESPONSIBLE FOR SPECIFYING ON THE APPLICATION DRAWINGS THE TYPES OF FOUNDATIONS OF ANY FOOTING WORKS AT A MINIMUM DEPTH OF 0.230 METERS BELOW FINISH GRADE.

**SUBDIVISION AND LAND
 DEVELOPMENT SECTION
 SITE PLAN CHECKED**

03 OCT 1995

[Signature]
 Signature

All existing wastes, drains, soil & vent pipes to conform to current National Building Regulations

**ALL GLAZING TO COMPLY
 WITH PART N12 AND N13
 OF SABS Q400.**

**CONVERSION OF
 EX. DWELLING
 TO OFFICES &**

**PROPOSED ALTERATIONS &
 ADDITIONS TO OFFICES FOR
 WHEEL SALES
 332 UMBILO ROAD
 CONGELLA
 DURBAN 4001
 LOT 7292 DURBAN**



**DRAWING
 AHEAD**

147 COWEY PD
 BEREA
 DURBAN
 4001

DRAWN



TELEPHONE 298819
 JOAN KOSTER

OWNERS
 SIGNATURE

DATE SEPT 95 SCALE 1:100 500

DRAWING NUMBER

AS BUILT

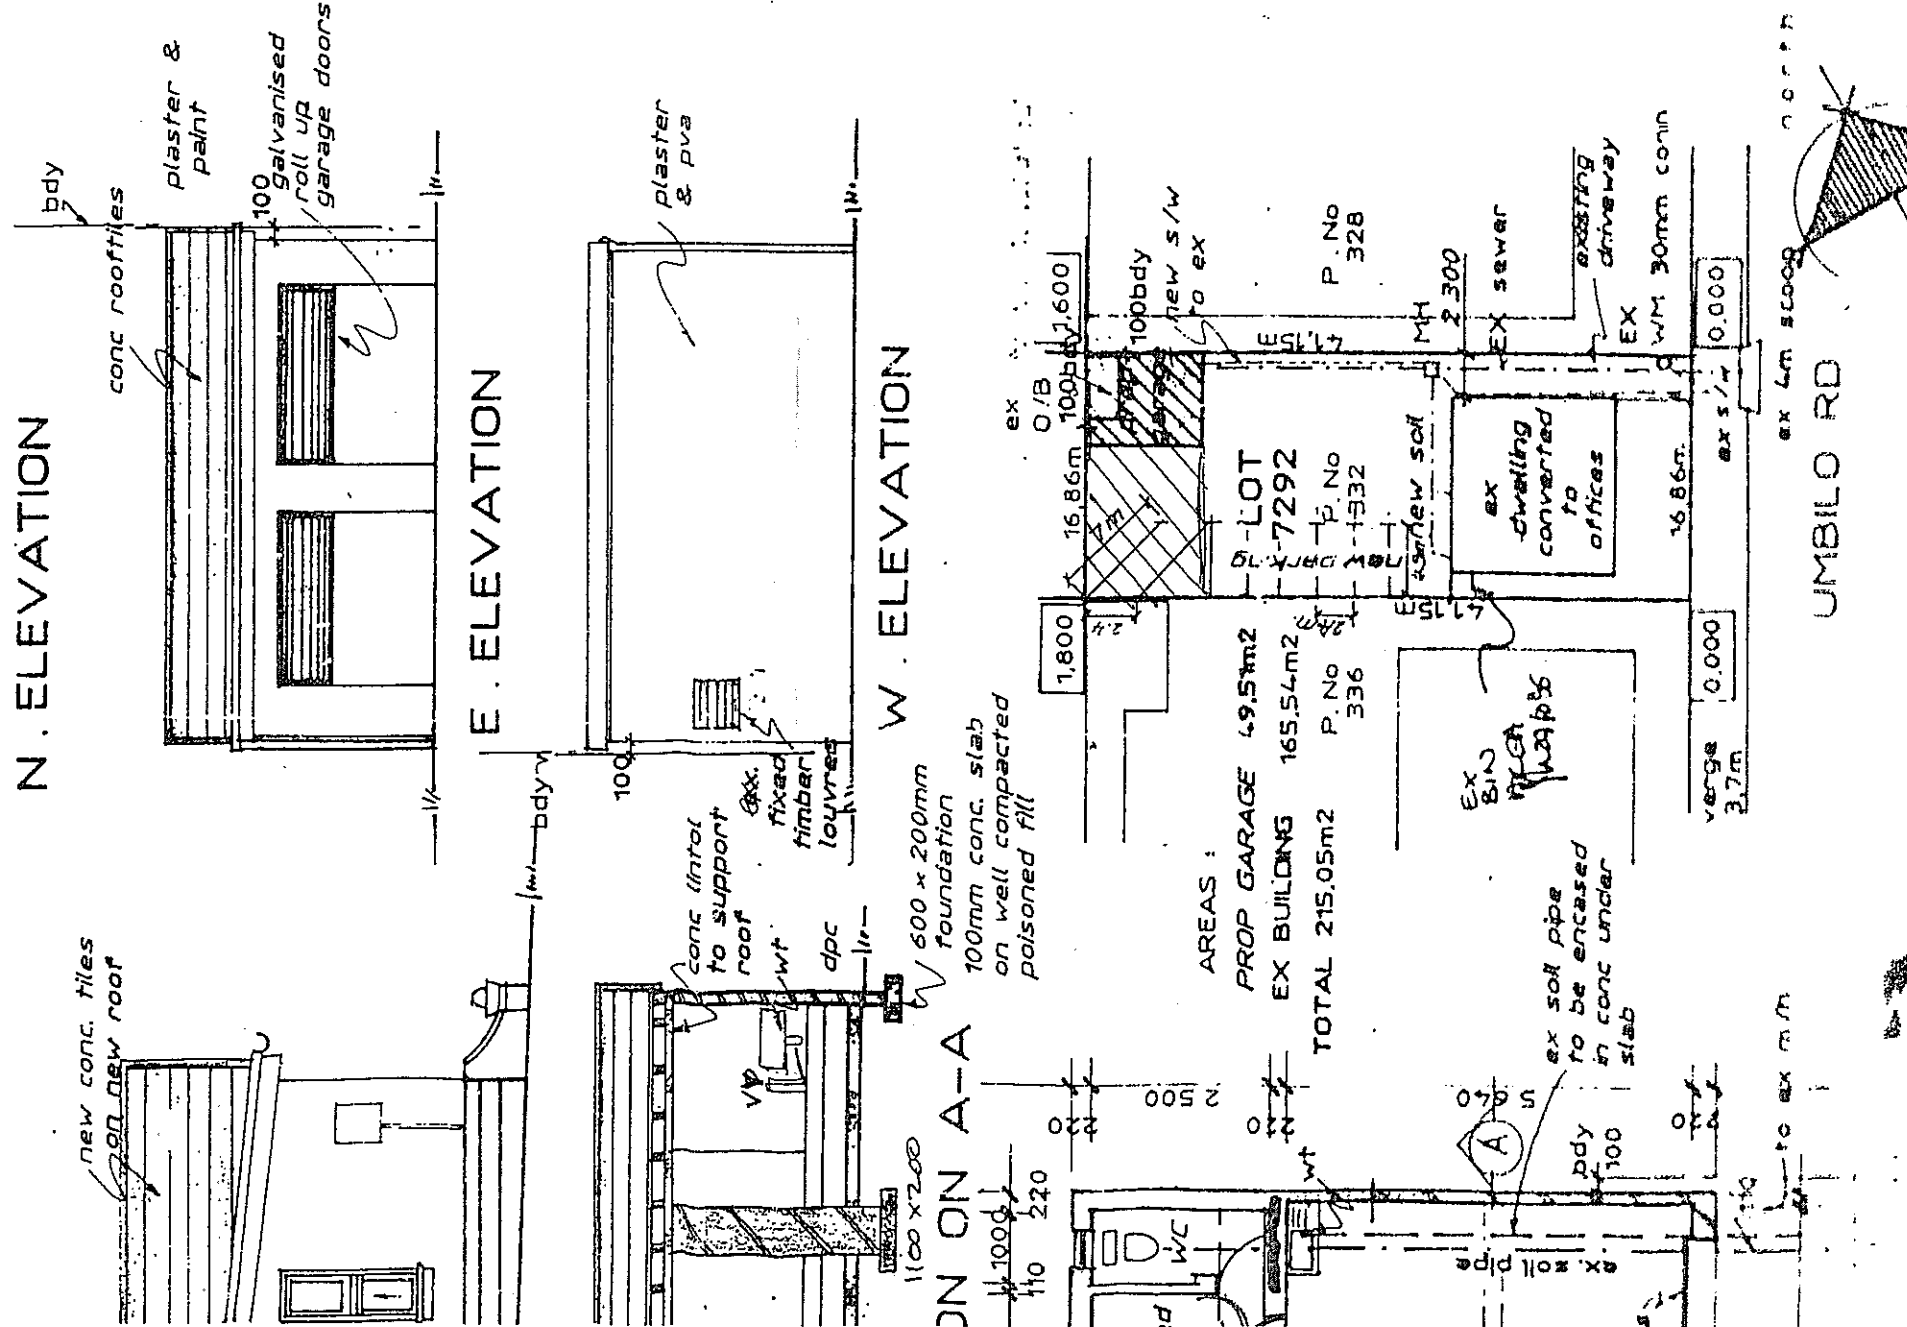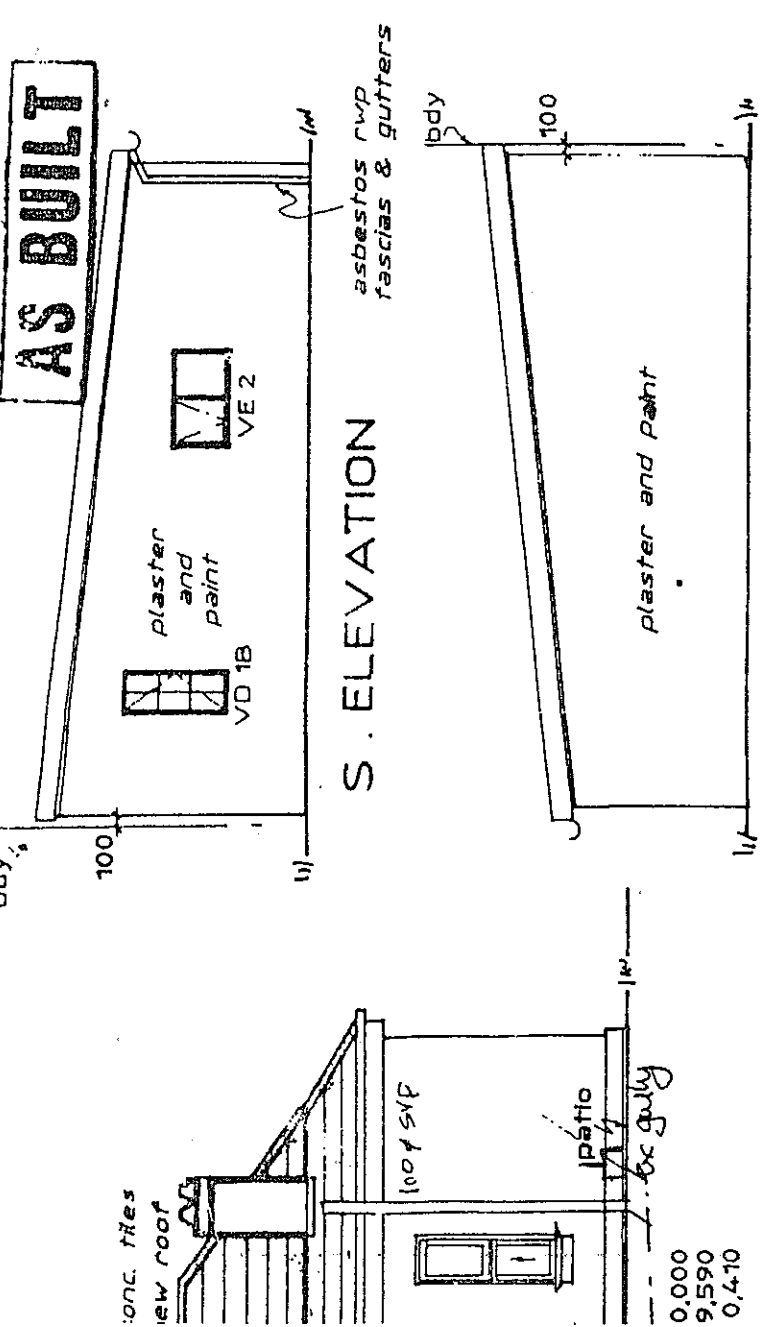

SITE PLAN

**ROOF STRUCTURE TO BE TO
 EMPERICAL SCALE OR DELICATED
 BY ENGINEER**