


SHEET 11/ 3
CITY OF DURBAN
 PLAN NUMBER 355/2/83
 APPROVED
 DATE 1983 2 23
 D.G. MACLEOD
 CIVIL ENGINEER

ALL SOAK PITS 4M FROM BUILDINGS, BOUNDARIES AND DRAINAGE SERVITUDES

TOWN PLANNING BRANCH
 APPROVED
 DATE 17 FEB 1983
 Signature

ORIGINAL
AS BUILT
AS BUILT

Marseilles tiles
 30 x 52 battens
 on Gangnail trusses to engineers design bolted to piers by m/s.
 brackets with 2 x 8 mm. galv. bolts.

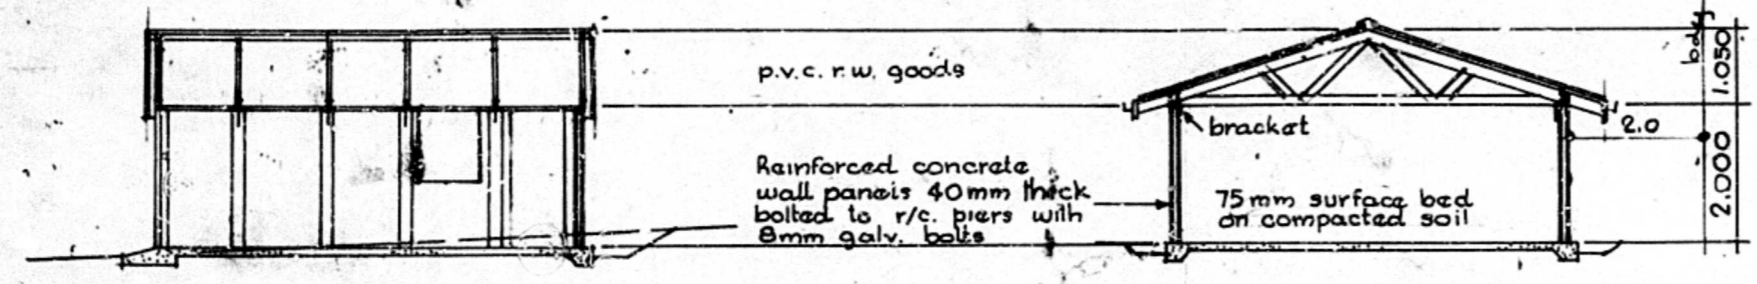

SECTION A · A


SECTION B · B




N.W. ELEVATION



S.W. ELEVATION

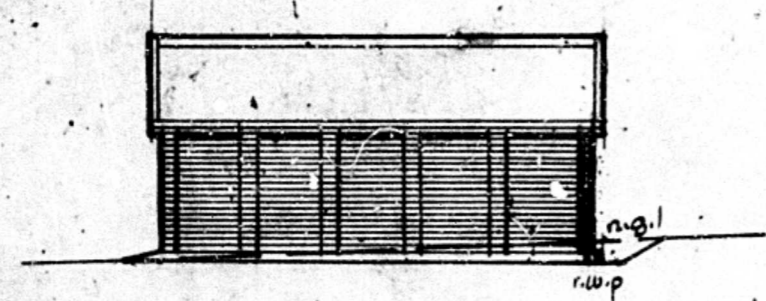


S.E. ELEVATION

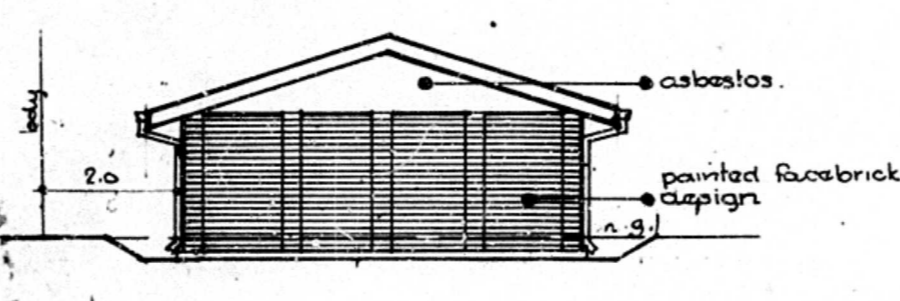


N.E. ELEVATION


All banks sloped at 26°

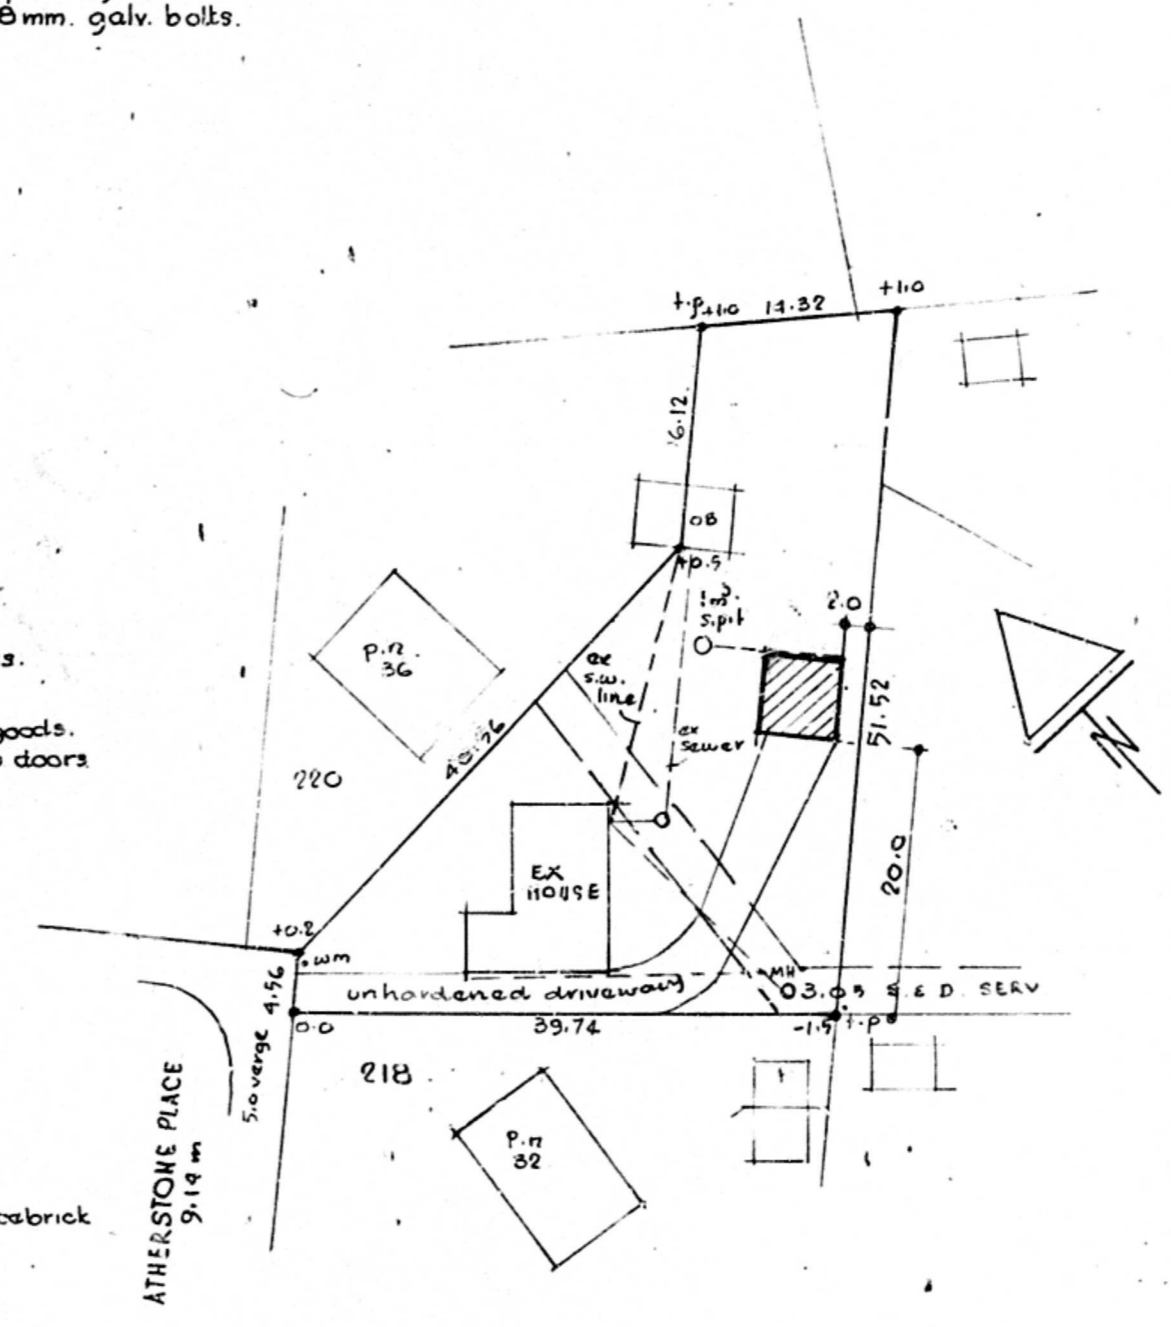

SITE PLAN
 1:500
 219 OF 9 OF MOBENI No 13538

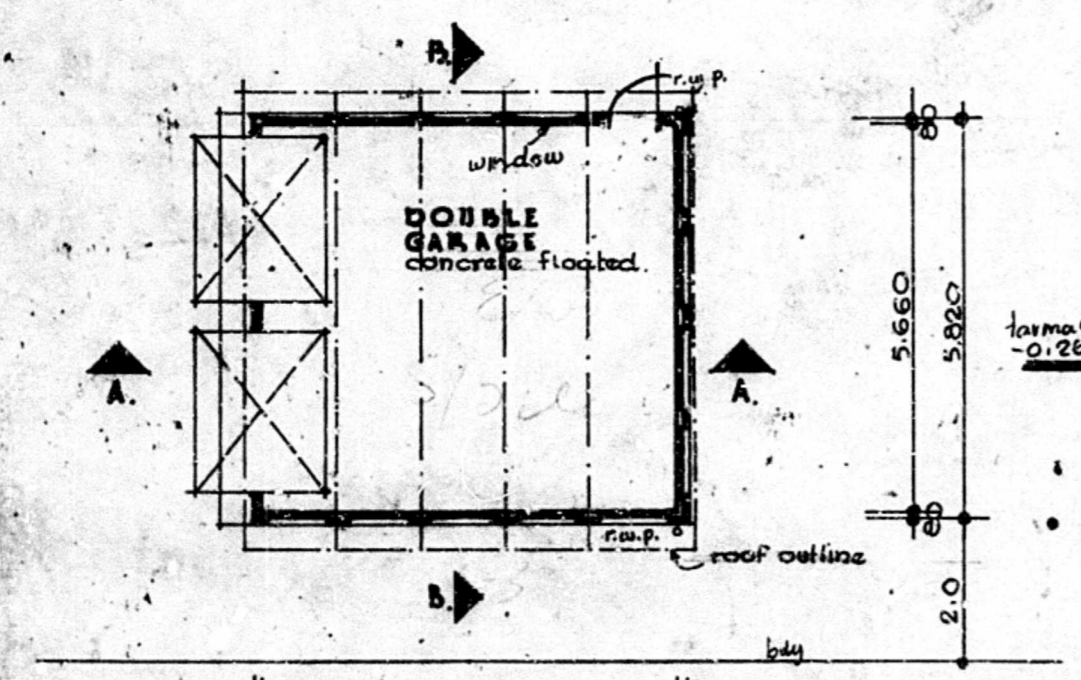

PLAN
 1:100

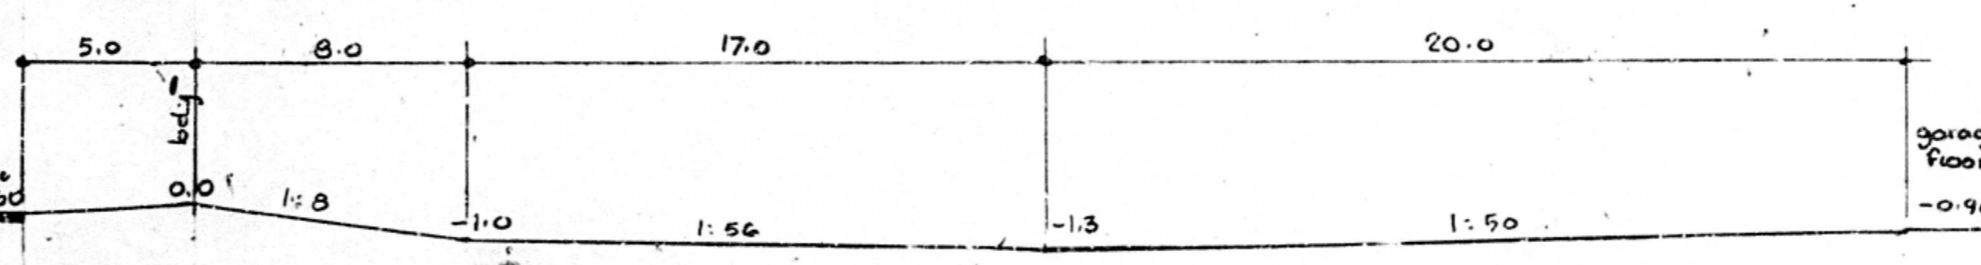

DRIVEWAY SECTION
 1:200

IFAFA. DOUBLE GARAGE 6,240 x 5,820
 JOB: NEW GARAGE
 ADDRESS: 34 ATHERSTONE PLACE
 CLIENT: MR. J. E. PASSMORE
 DATE: 8.2.83
 SIGNED: [Signature] ADDITION: 36.31 m²
 DRAWN BY: [Signature] ENG. No. 644
 SCALES: 1:100, 500, 1000
 RECTIBUILD CONSTRUCTION (PTY) LTD.
 4 BADMANN RD. QUEENSBURG PH. 447955
House-it