


SOUTH EAST (REAR) ELEVATION

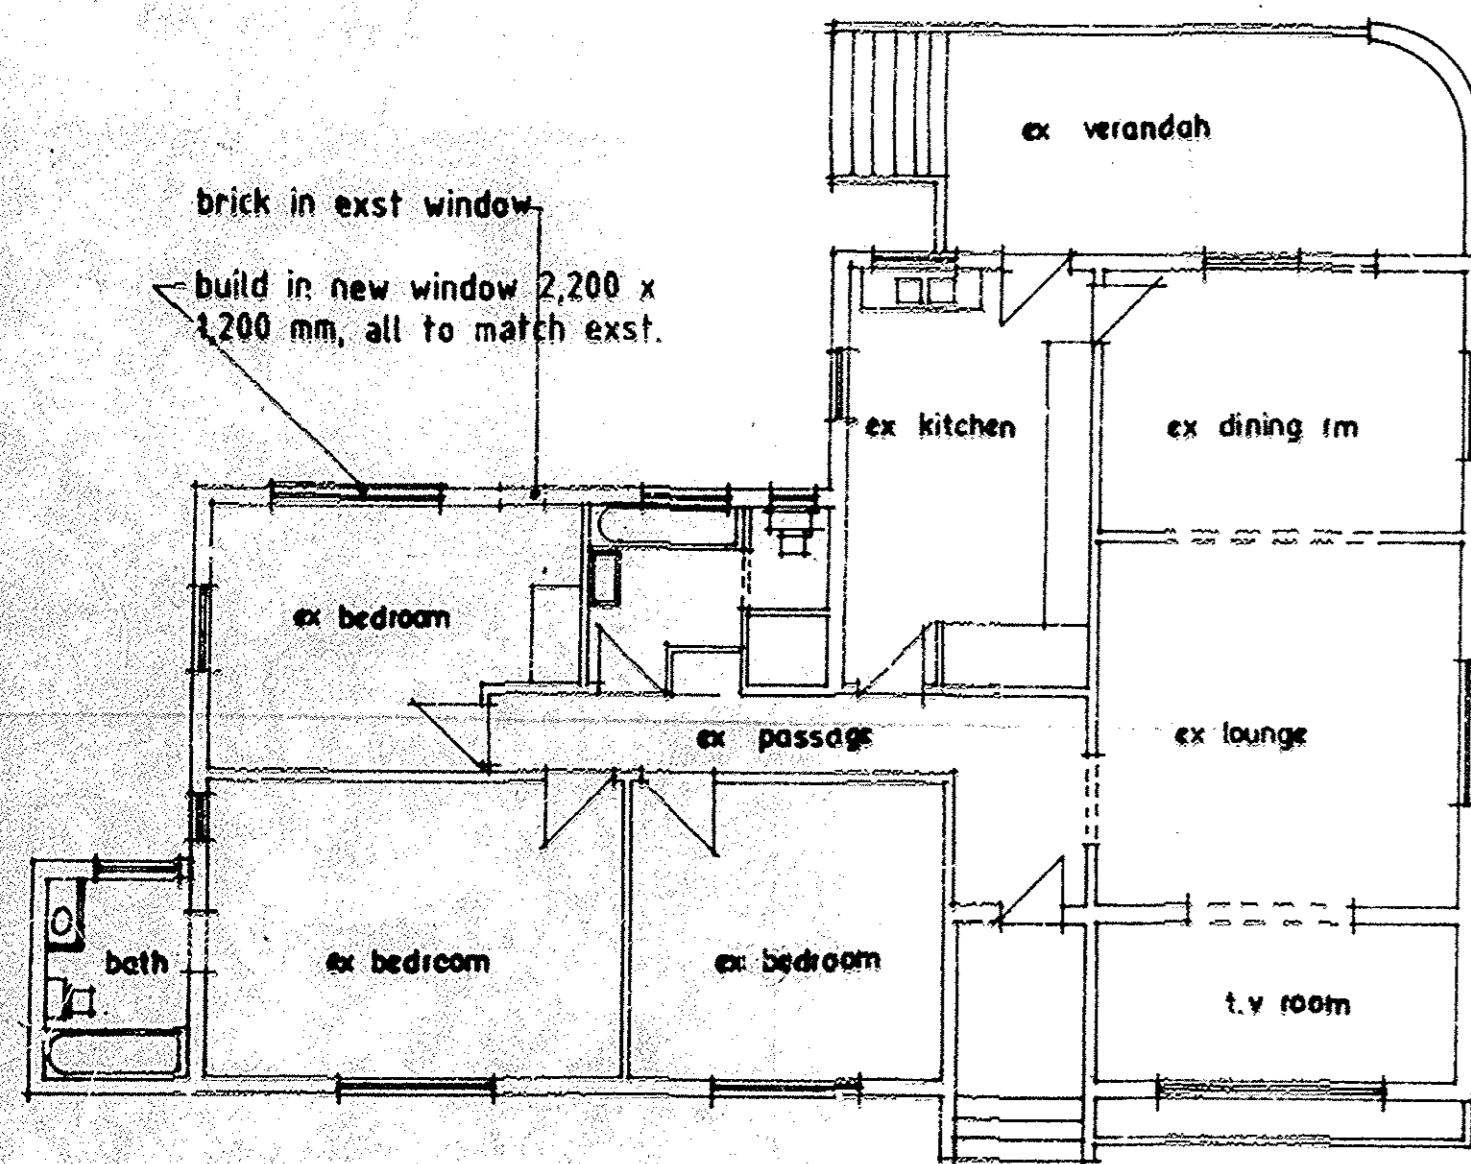

PLAN scale 1:100

SHEET 1/1 COPY 3

CITY OF DURBAI

PLAN NUMBER
0730/09/90/3

APPROVED: D. C. MACLEOD
16 OCT 1990 CITY ENGINEER

DATE PER [Signature]

AS BUILT [Signature]

1990 OCT '9 [Signature]

TOWN PLANNING BRANCH

APPROVED

1990 -10- 08

Signature: [Signature]

Checked: [Signature]

"It should be noted that this plan has been approved on the basis of information thereon."

PROPOSED NEW WINDOW FOR MR. A. P. BLACKWOOD
38 ST ANDREW'S DRIVE
LOT 2272 OF 14 OF VICTORIA COUNTY, 1547

scales 1:100
drawn A. Blackwood
owner
rate no. 889320
phone 031 842632

[Signature]