




Section A-A  
Scale 1 : 100

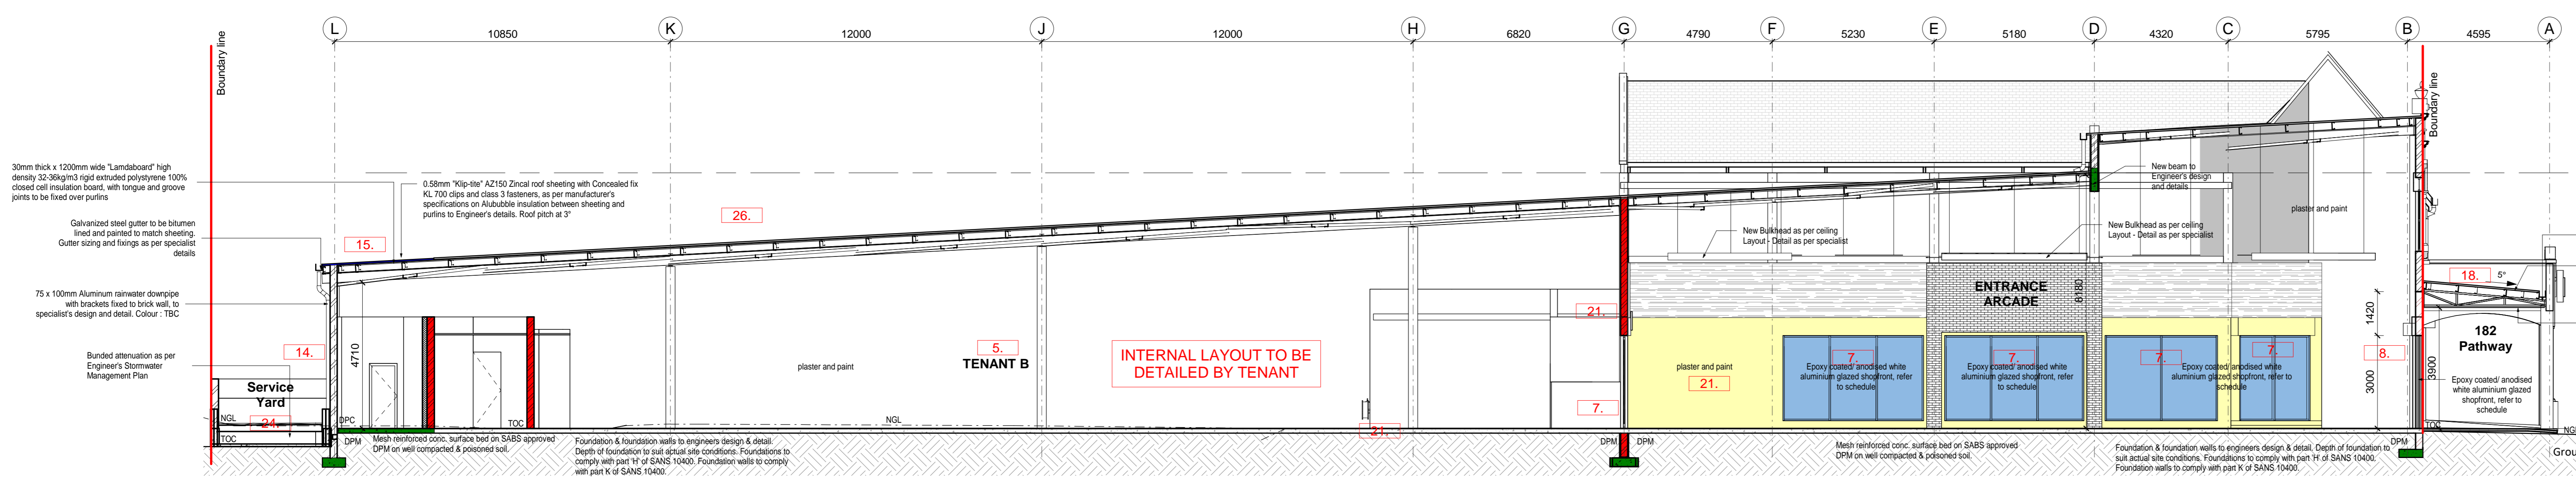


Section B-B  
Scale 1 : 100

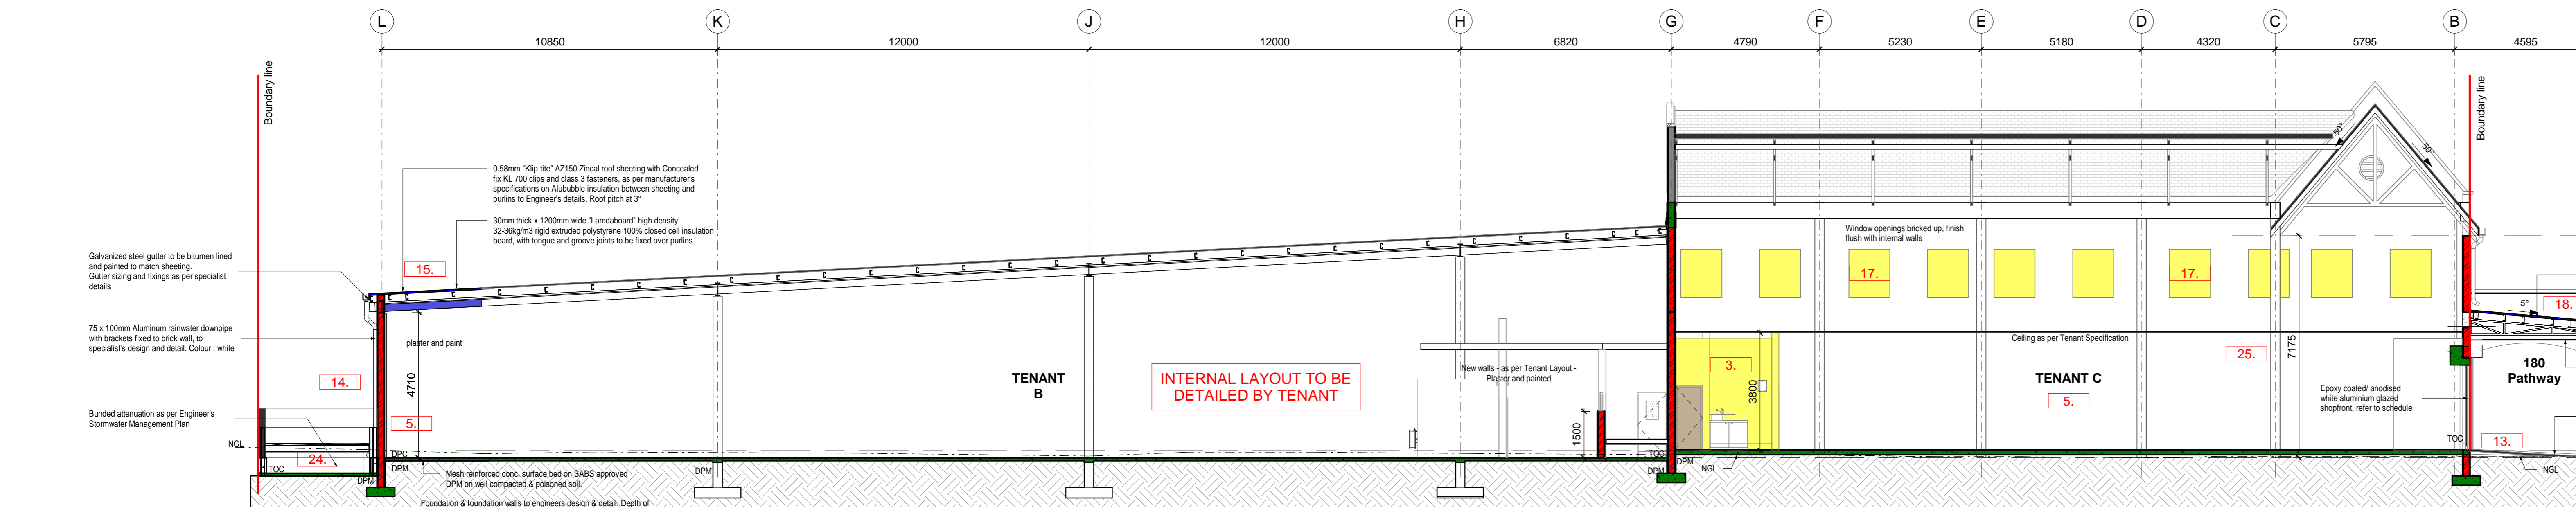

Section C-C  
Scale 1 : 100

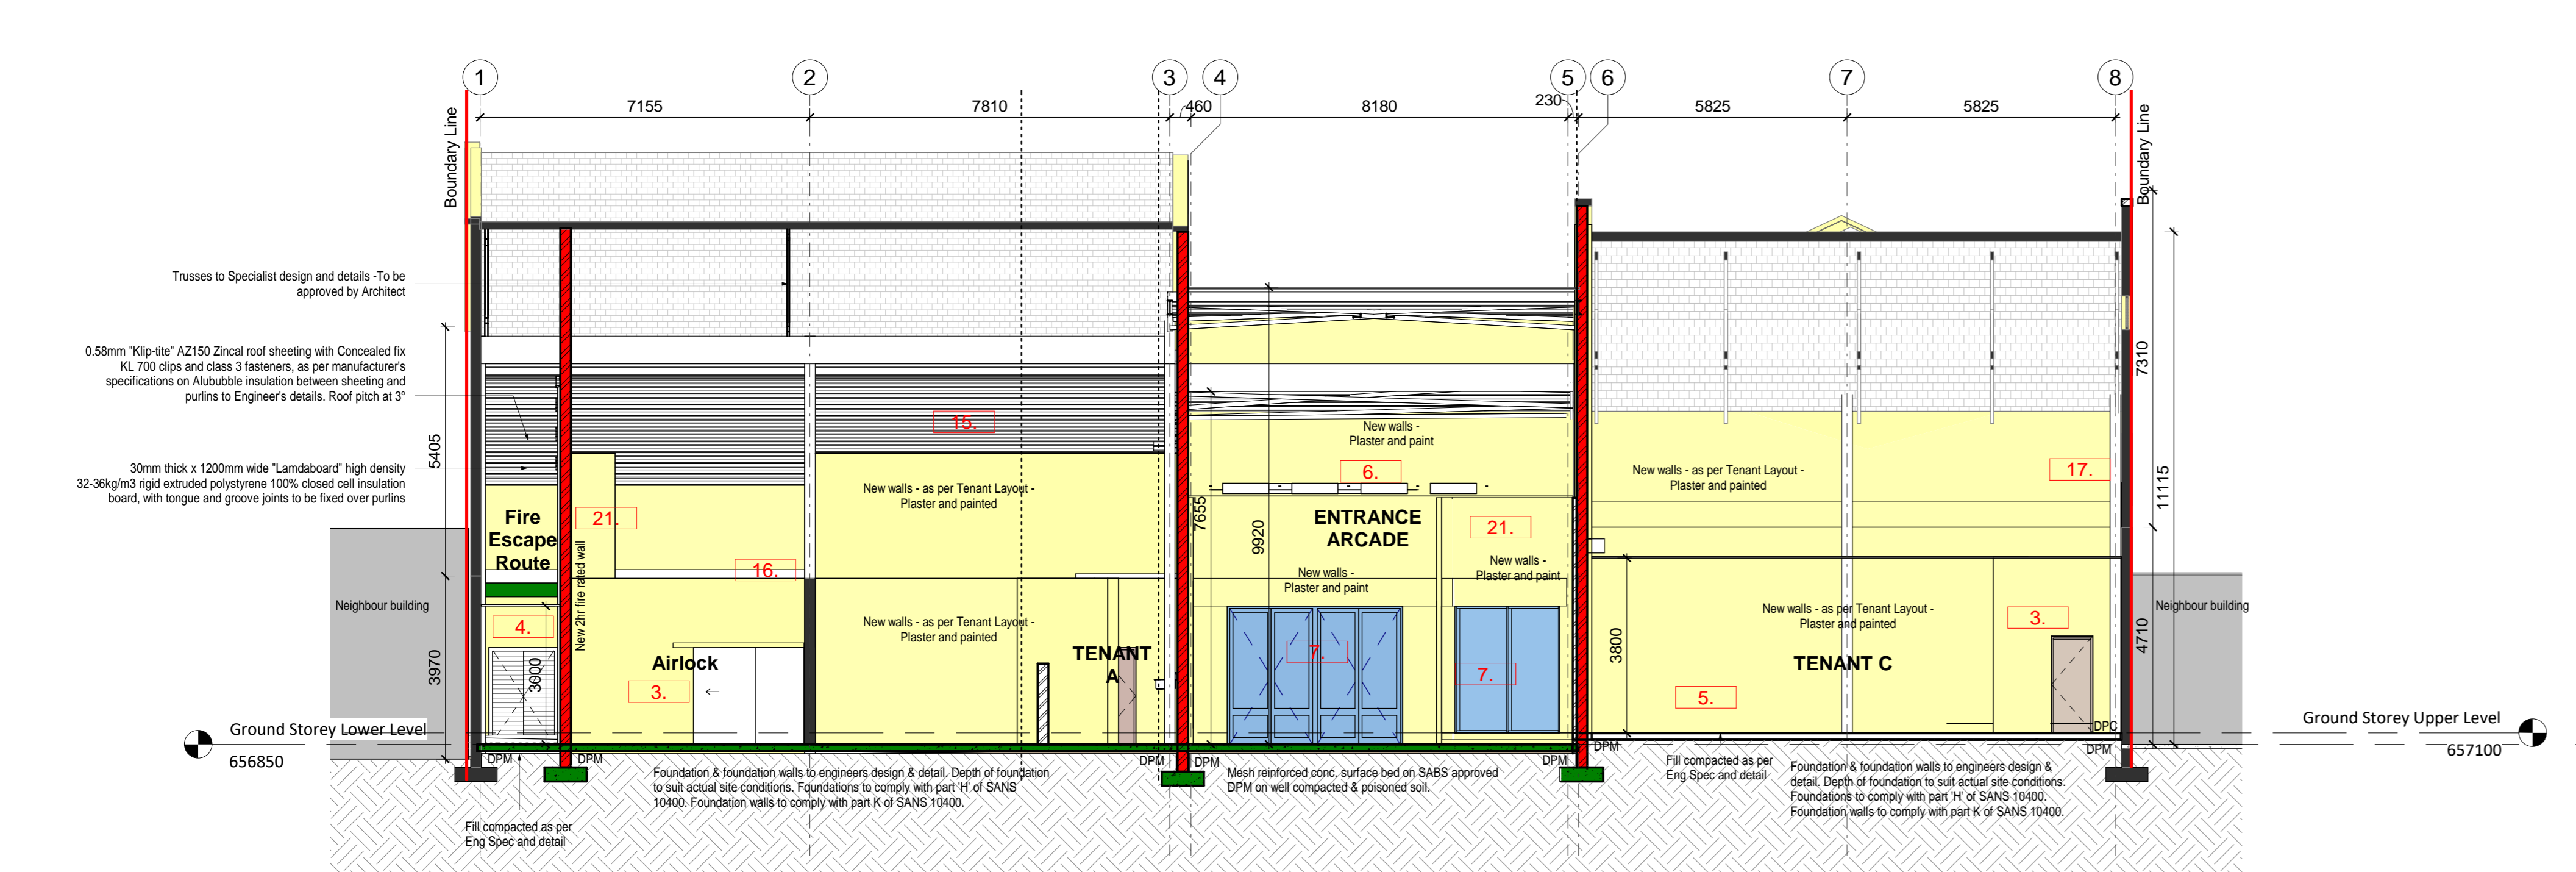

Section E-E  
Scale 1 : 100

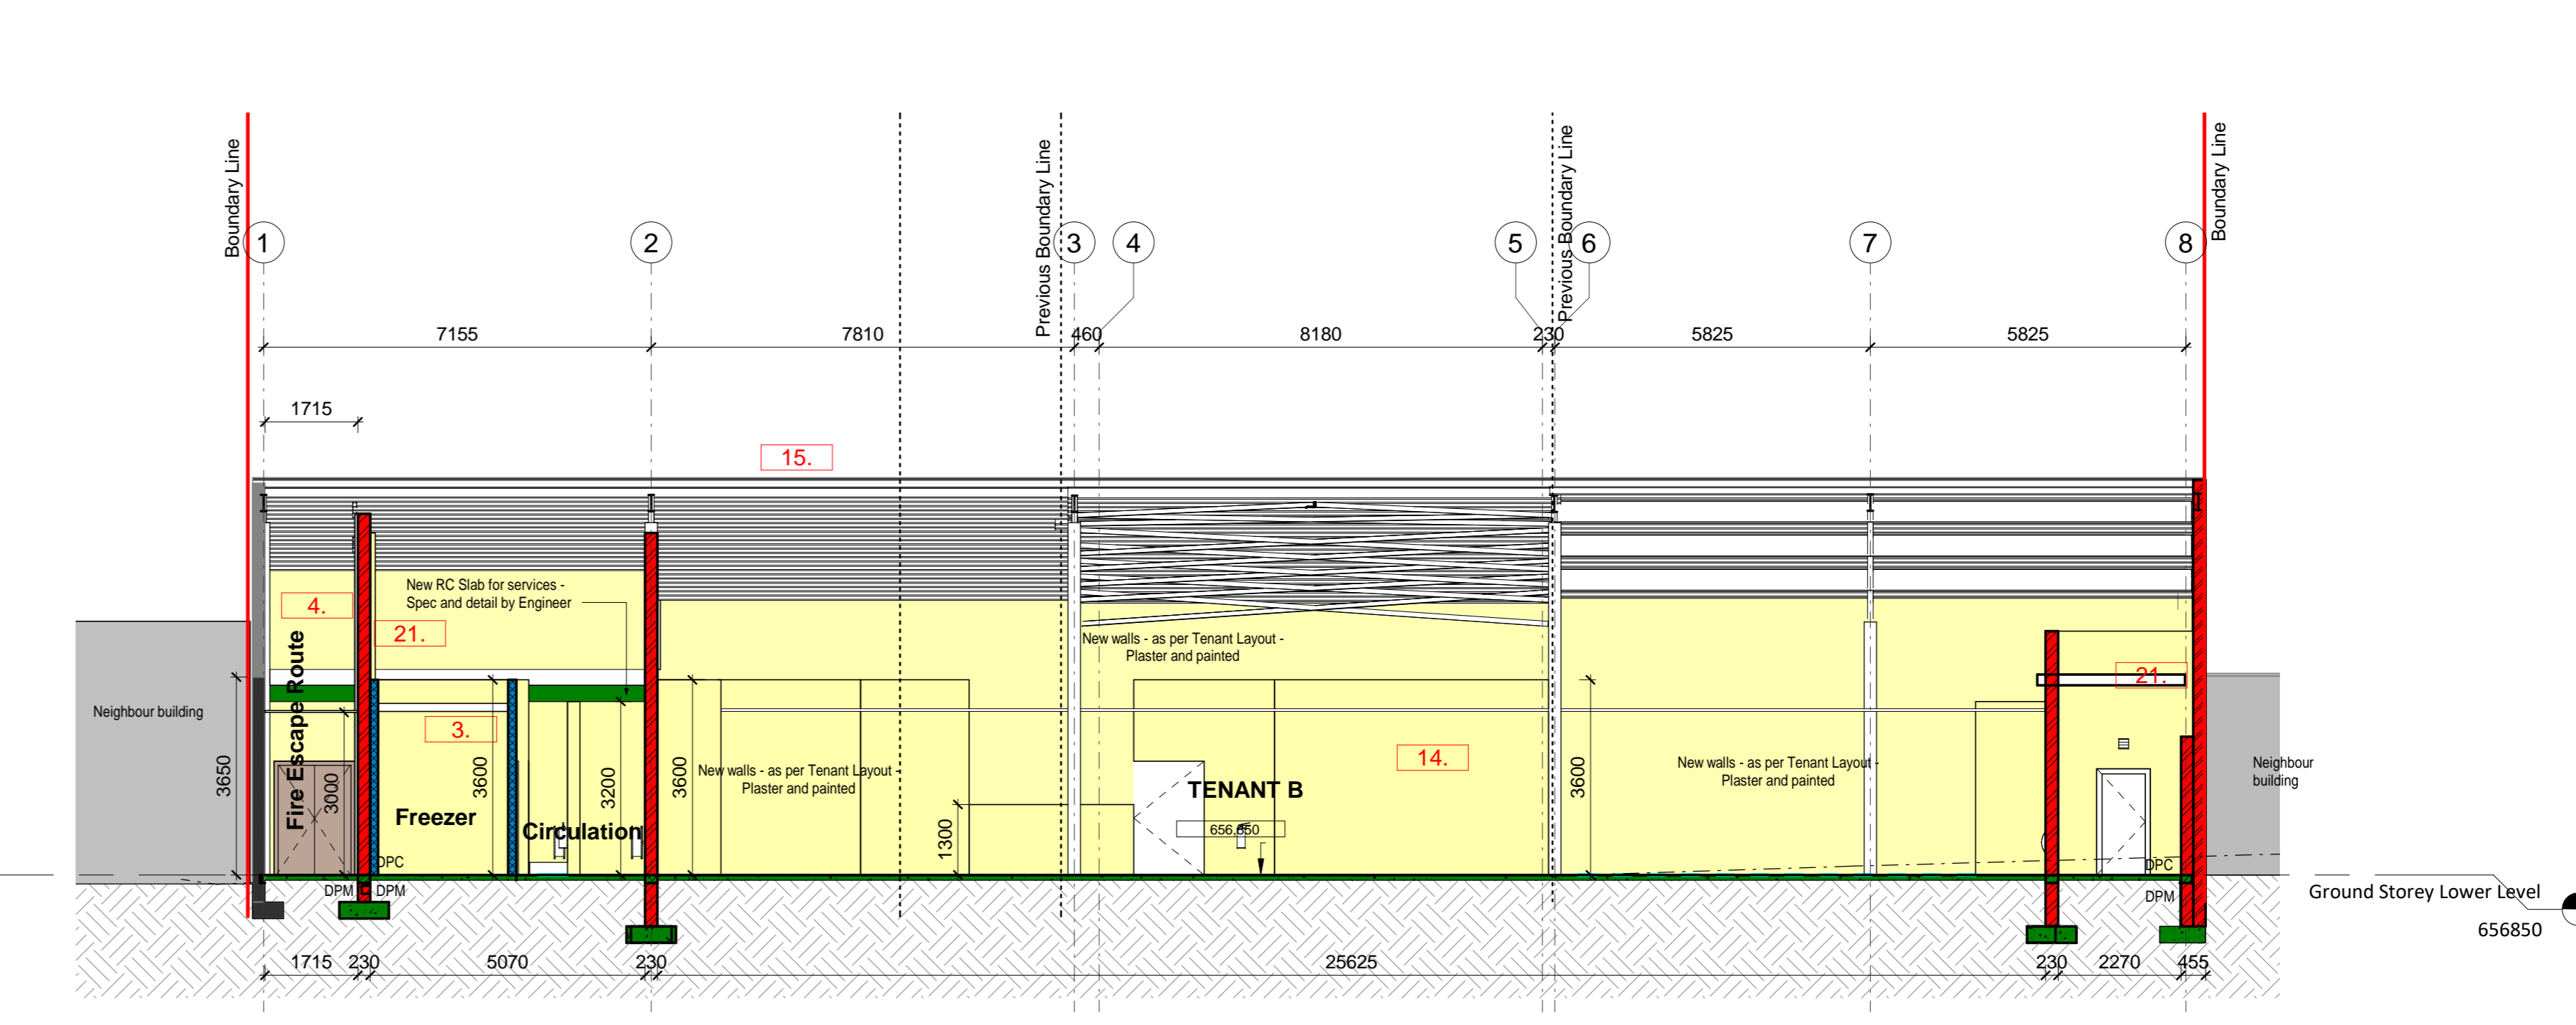

Section F-F  
Scale 1 : 100

Deviation List	
Number	Deviation List
1.	Grid layout revised
2.	Walls omitted
3.	Ablution position revised
4.	Fire escape door and fire escape route added
5.	Tenant envelope revised
6.	New Entrance Arcade
7.	Shopfront configuration revised
8.	Roller Shutter Door added
11.	Security wall added behind shopfront
12.	New square Columns to replace circular
13.	Paving levels to correspond to new FFL's
14.	Building footprint increased. New wall added
15.	Sheeted Roof extended
16.	New Roof Slab
17.	Windows Omitted - Bricked up with recess detail
18.	Canopy roof pitch revised-to be steel substructure
19.	New Canopy Roof revised.
21.	Addition of 2hr fire rated wall.
22.	New Concrete gutter added.
23.	Staircase Omitted
24.	Revised storm water attenuation tanks
25.	Column Layouts Revised
26.	Area Schedule Revised

**REVISIONS**

No.	Date	Description	ISSN	APPR.
17	2023-02-13	Revised to AMBA A - Removal of Steel bracing on facade.	PT	BD

**GENERAL NOTES:**

THIS DRAWING IS TO BE READ IN CONJUNCTION WITH DRAWINGS ISSUED BY CONSULTANTS IN CONNECTION WITH THIS PROJECT. THE DRAWING IS TO BE USED FOR THE PURPOSES OF THE PROJECT AND IS NOT TO BE USED FOR ANY OTHER PURPOSE. THE ARCHITECTS SHALL NOT BE RESPONSIBLE FOR THE ACCURACY OF THE INFORMATION PROVIDED BY OTHER CONSULTANTS. THE ARCHITECTS SHALL NOT BE RESPONSIBLE FOR THE ACCURACY OF THE INFORMATION PROVIDED BY OTHER CONSULTANTS. THE ARCHITECTS SHALL NOT BE RESPONSIBLE FOR THE ACCURACY OF THE INFORMATION PROVIDED BY OTHER CONSULTANTS.

**KEYPLAN**

FOR INFORMATION	DESIGN DEVELOPMENT
SKETCH PLAN	TENDER
SDP	CONSTRUCTION
MUNICIPAL SUBMISSION	AS BUILT

**MUNICIPAL SUBMISSION**

**tc rpv ARCHITECTS**  
1 Richmond Circle  
Rogiesdale Office Park  
Lindhurst 4320

**TCRPV ARCHITECTS**  
Tel: +27 31 502 3625  
Rogiesdale Office Park  
Lindhurst 4320  
E-mail: philip@trpv.co.za  
www.trpv.co.za

**Deviations to Approved Plan**  
Nos. 198/22 (Ptn 3 of 2of ERF 2518, 180 Church Street), 199/22 (Ptn 2 of ERF 2518, 182 Church Street) and 200/22 (Ptn 4 of 2518, 184 Church Street)

**OWNER**  
IMBALI PROPS 21 PTY (Ltd)

**PROJECT ADDRESS**  
Church Street, Pietermaritzburg

SIZE	SCALE	CURRENT REVISION DATE	DRAWN	TCRPV Project Number	Sheet
AD	1 : 100	2023-02-13	LB	4265	M

**Sections**

Project Code	Originator	Zone	Level	Type	Rate	Dwg Number	REV
4265	Crigners					-200	1