

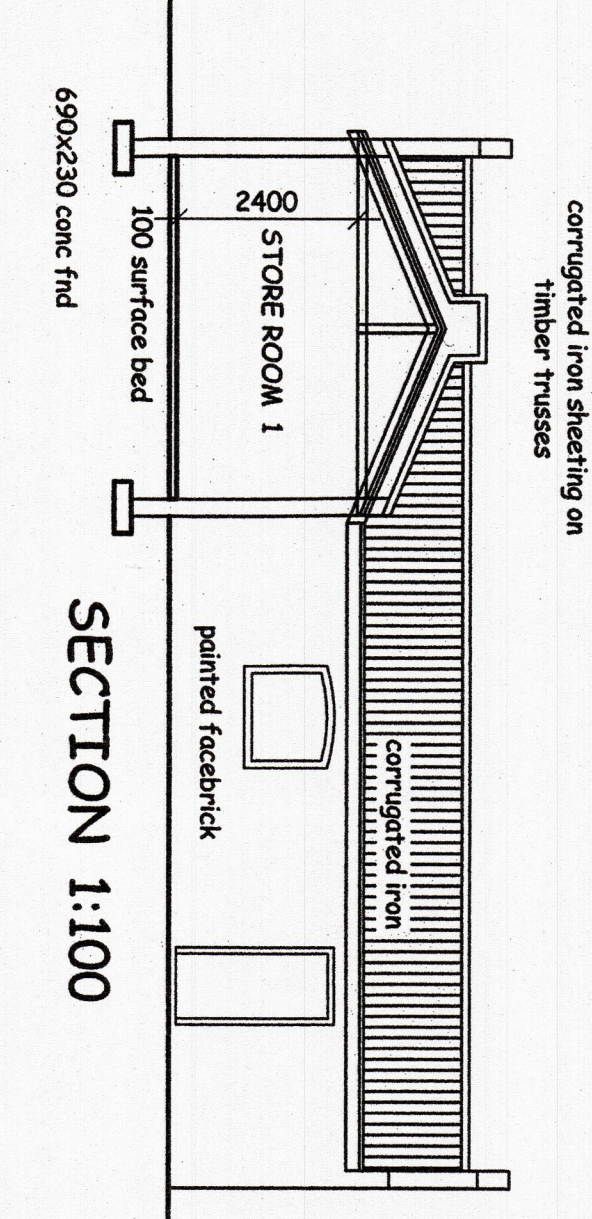


AREA 38 sq.m





AREA 34 sq.m

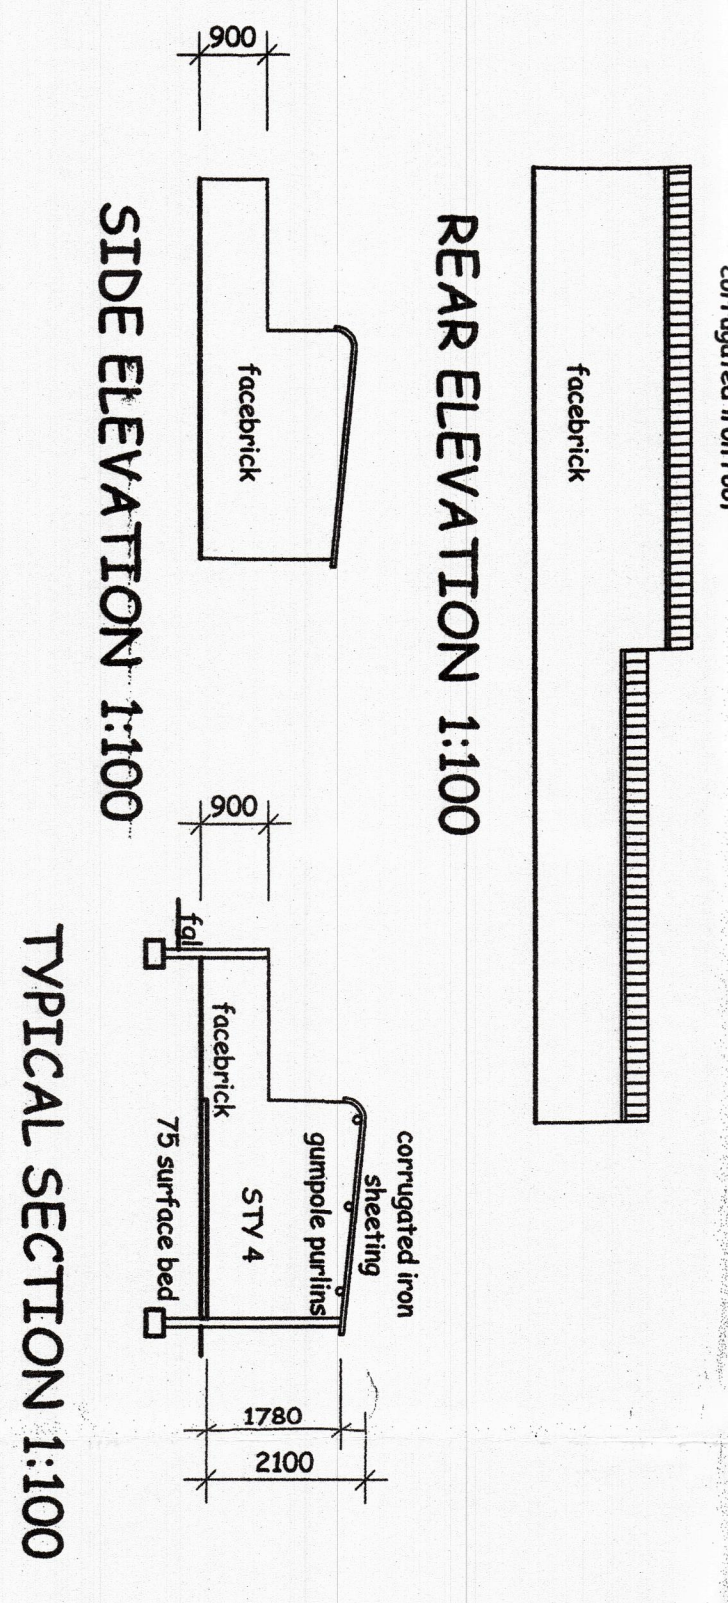



AREA 20 sq.m

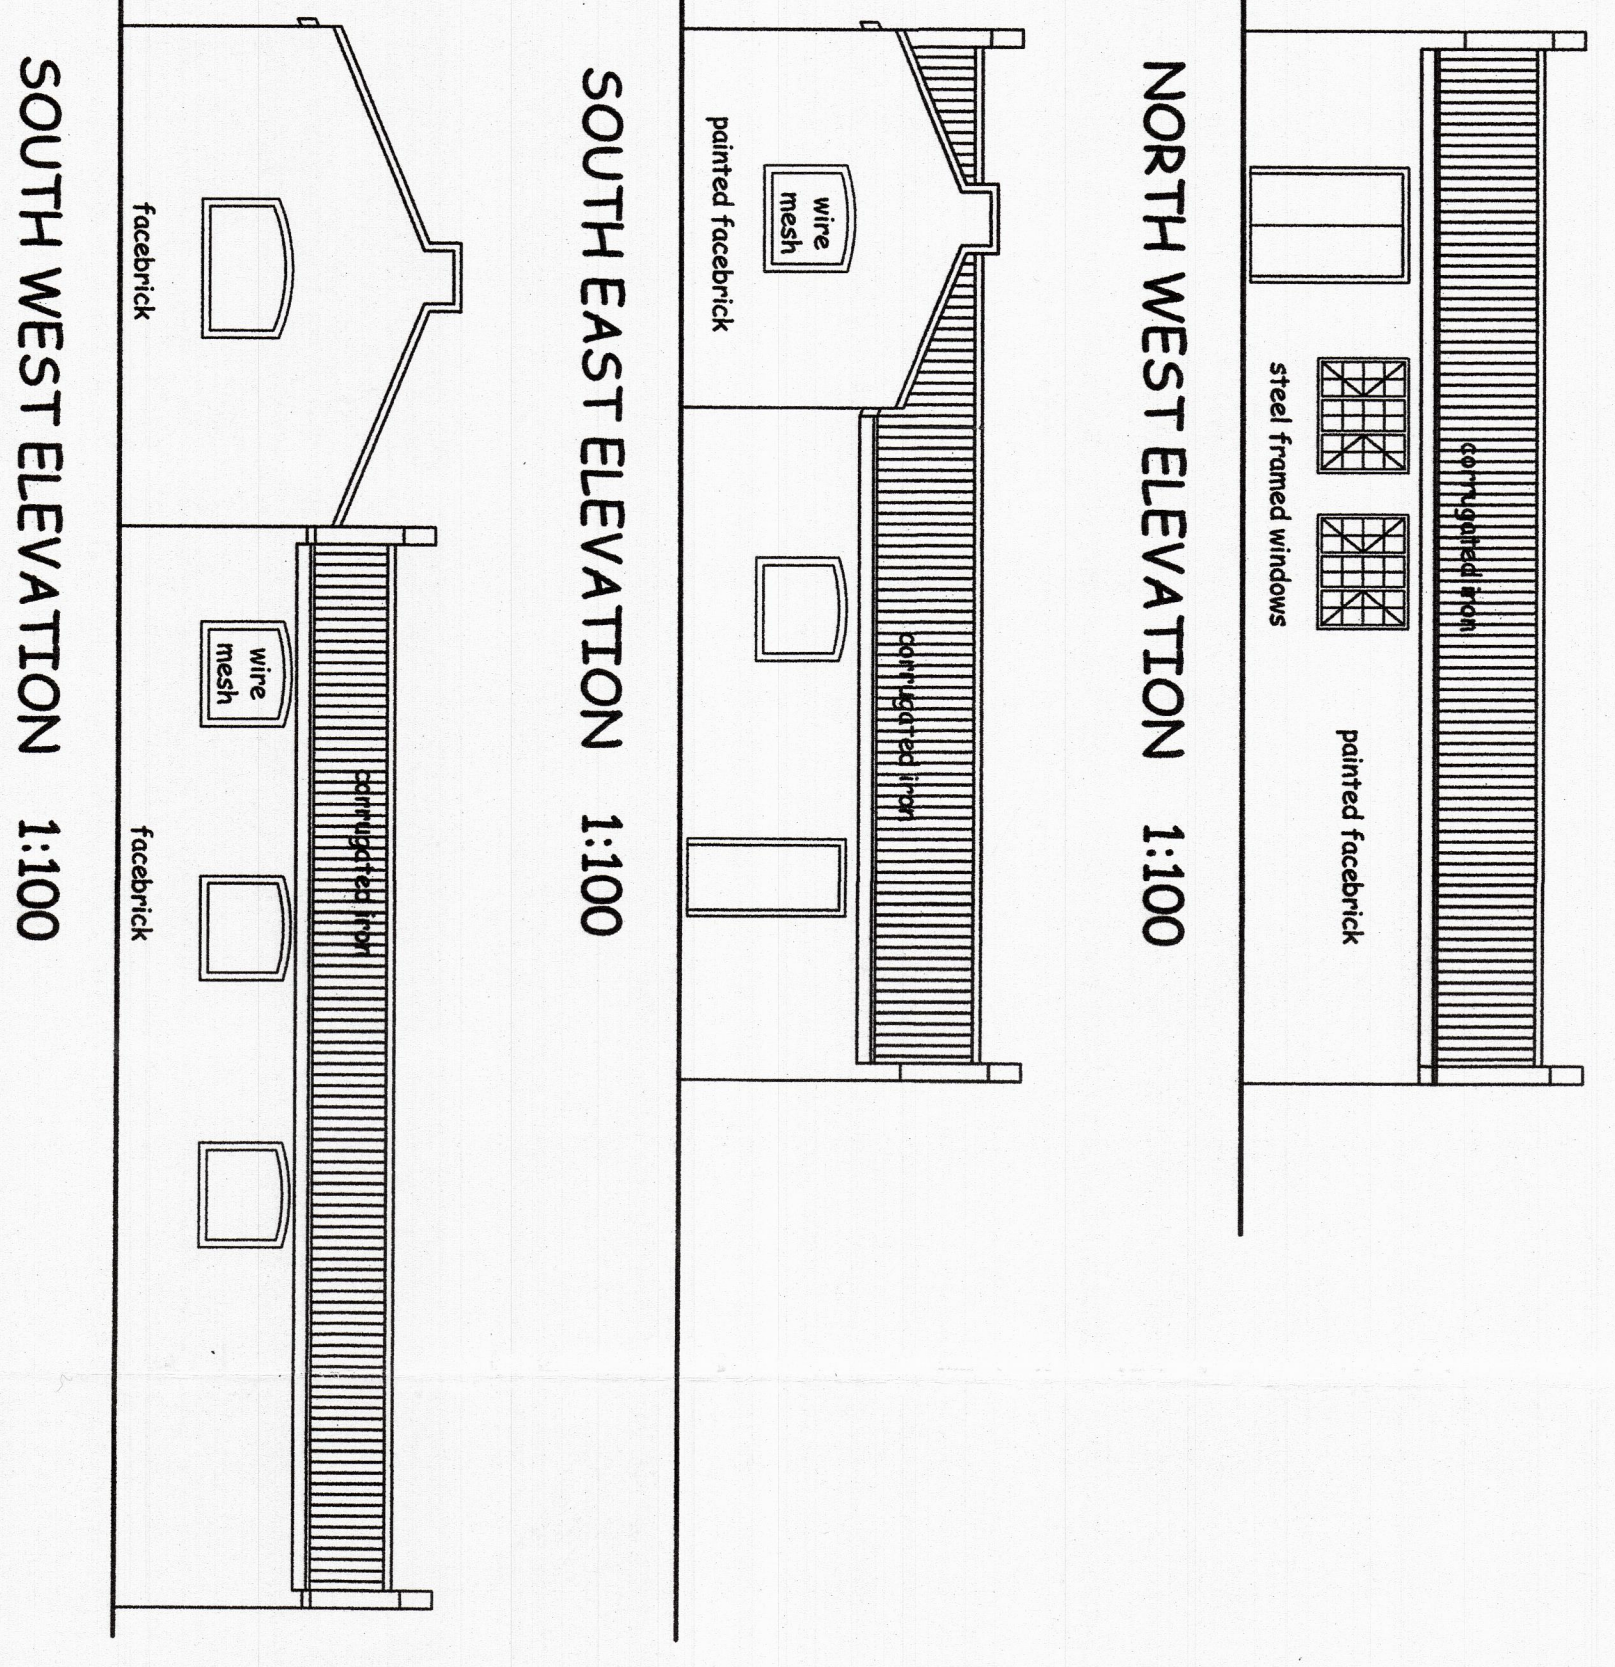

FRONT ELEVATION 1:100

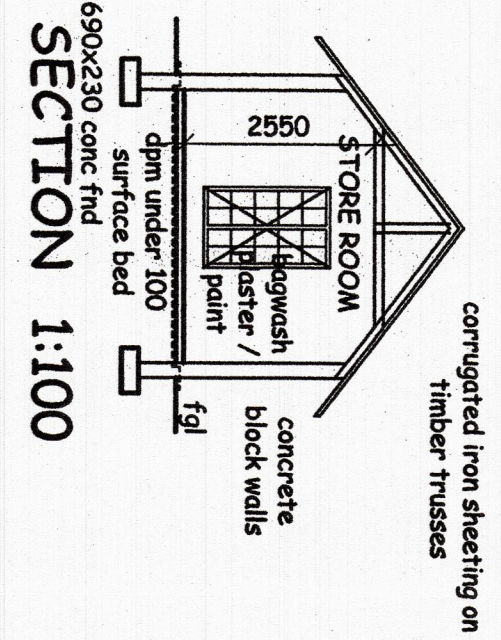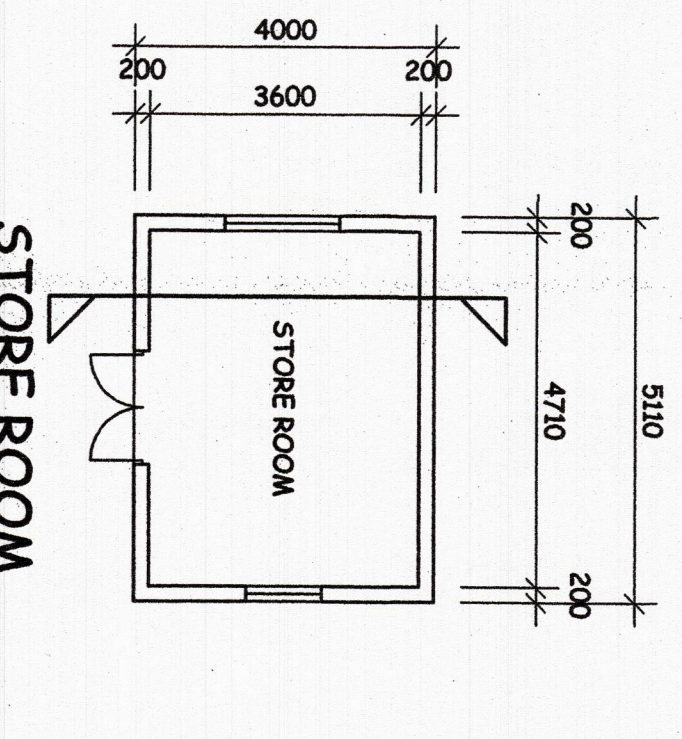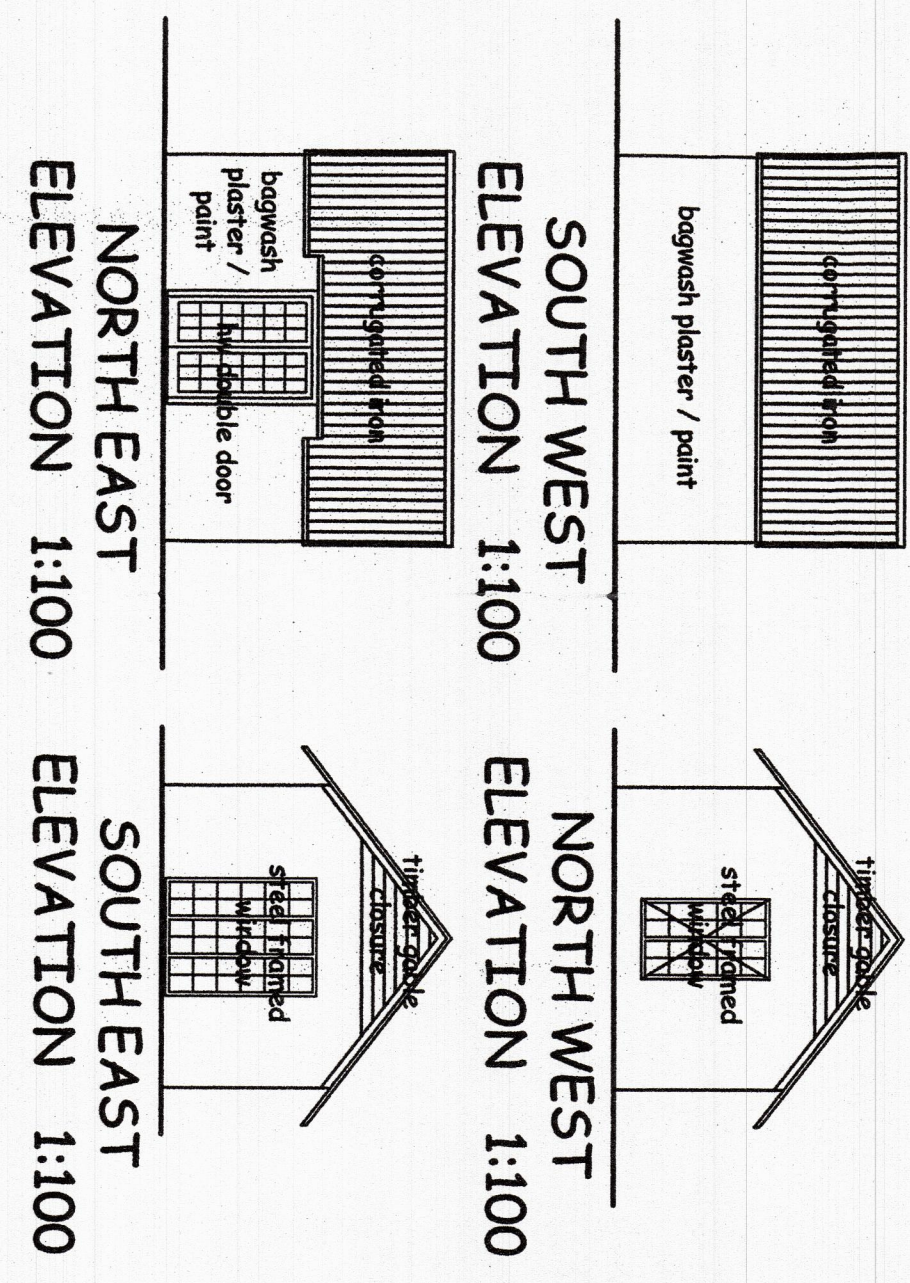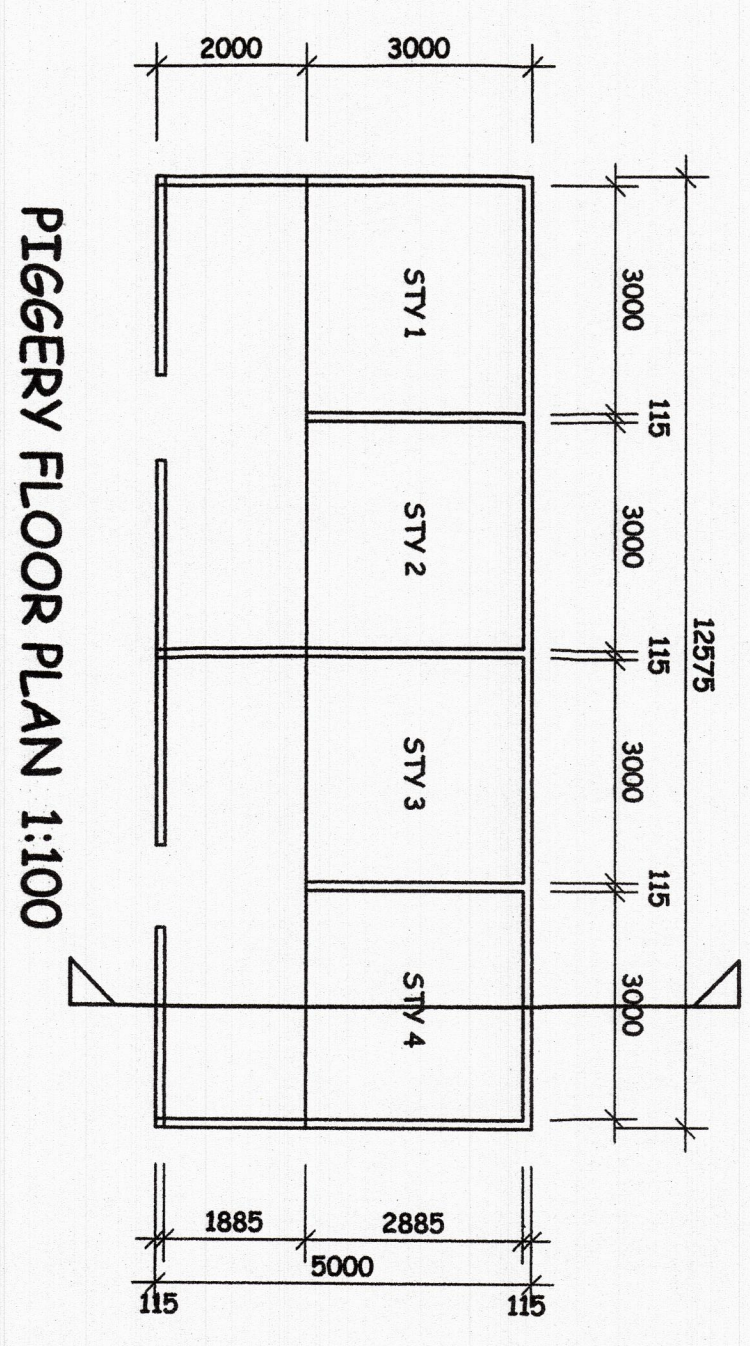

AREA 18 sq.m

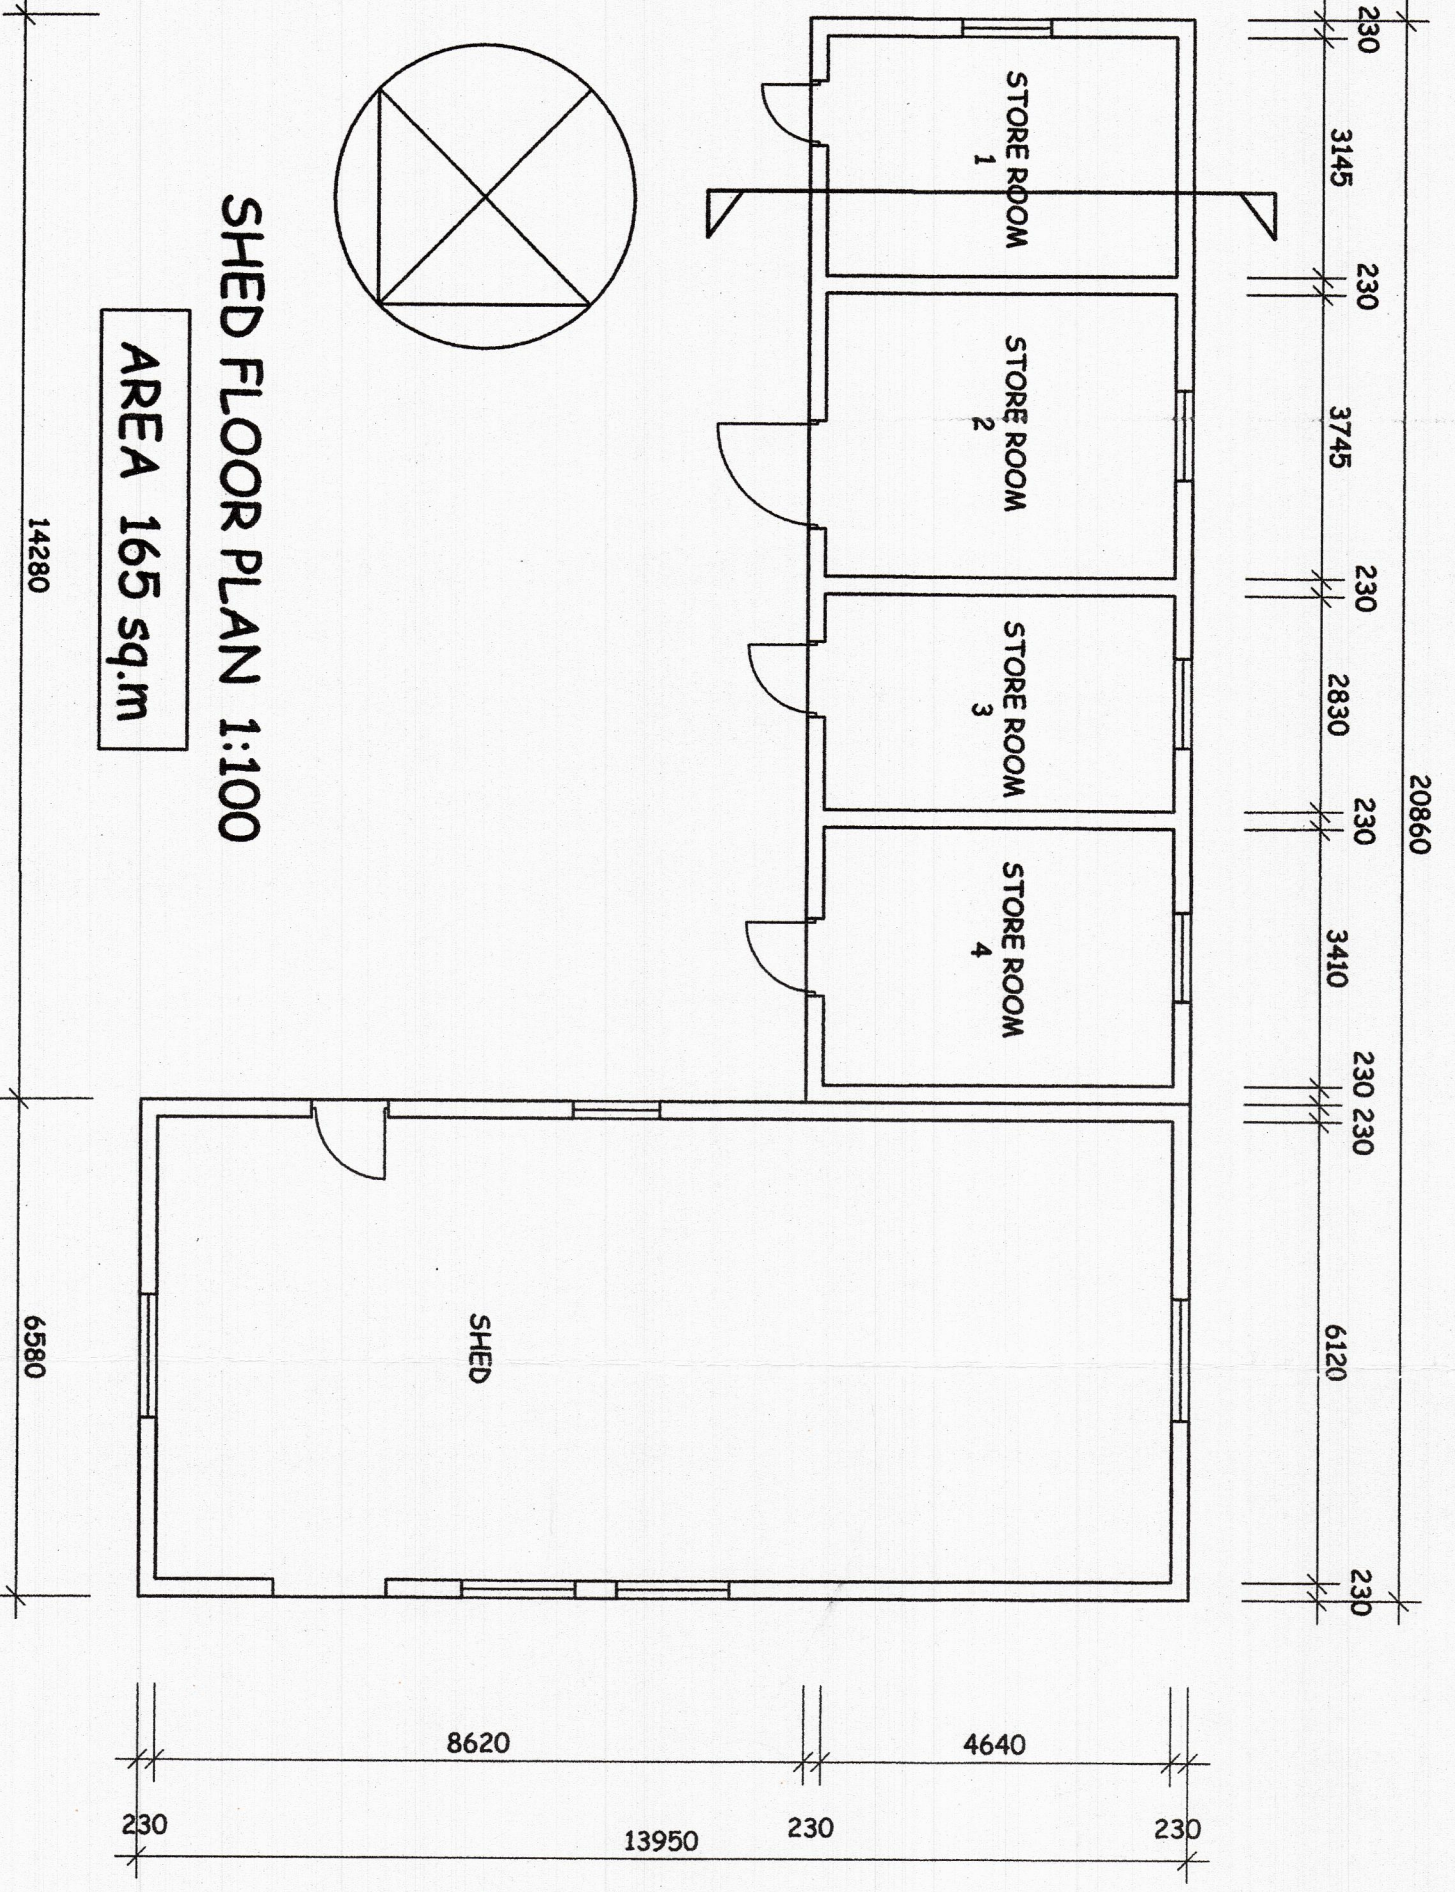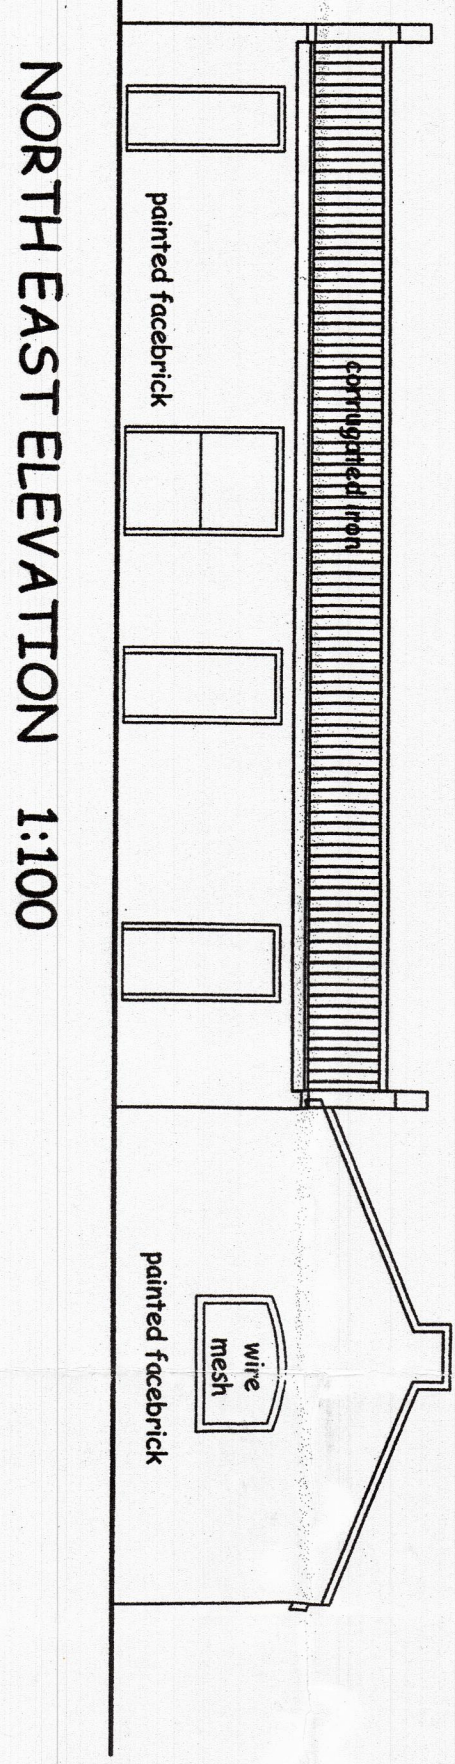

AREA 165 sq.m

owner's signature

STAFF QUARTERS BLOCK B AND C, PIGGERY, SHED AND STORE ROOM

AS-BUILT DRAWINGS
Foggozann Farm
Balgowan

Living Spaces Architectural Studio
P.O. Box 831 Hilton 3245
033 343 4045 / 083 672 9753
SACAP Reg No. 572142

Project Number: 2009 / 17
Drawing Number: AB02
Date: November 2009
Scale: 1:100
Drawn: B.D. Mackenzie