

ROLLER SHUTTER SCHEDULES

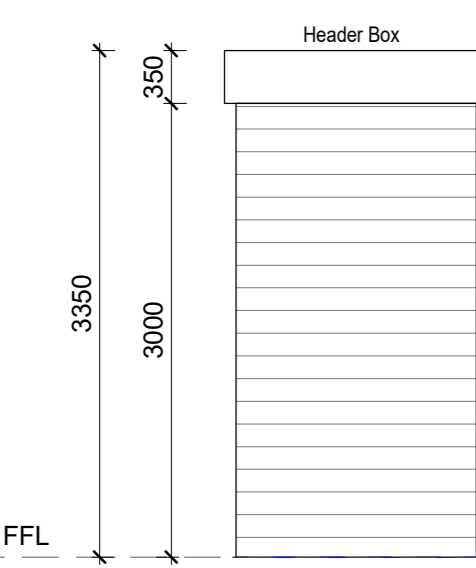


Table for RSD01 / SM01 roller shutter schedule with columns for Door Name, Location, Frame, Frame Finish, Door Panel, Door Panel Finish, Glazing, Ironmongery, and General Notes.

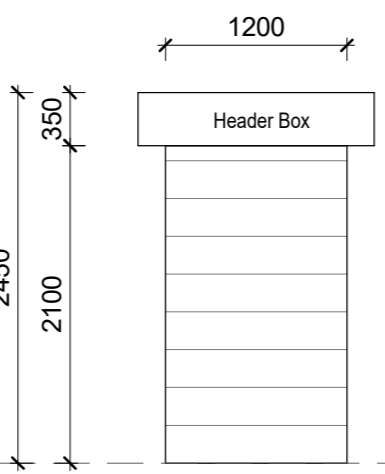


Table for RSD02 / FE01 roller shutter schedule with columns for Door Name, Location, Frame, Frame Finish, Door Panel, Door Panel Finish, Glazing, Ironmongery, and General Notes.

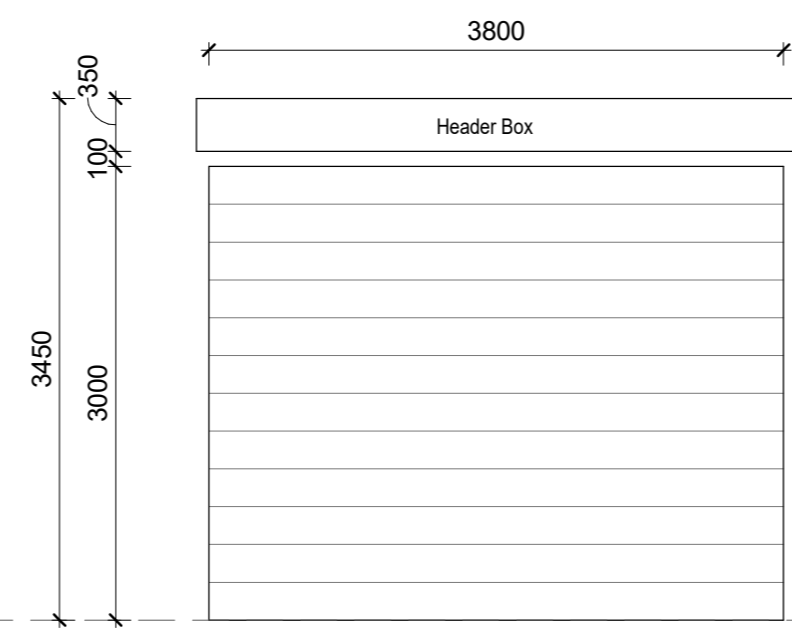


Table for RSD03 / SM02 roller shutter schedule with columns for Door Name, Location, Frame, Frame Finish, Door Panel, Door Panel Finish, Glazing, Ironmongery, and General Notes.

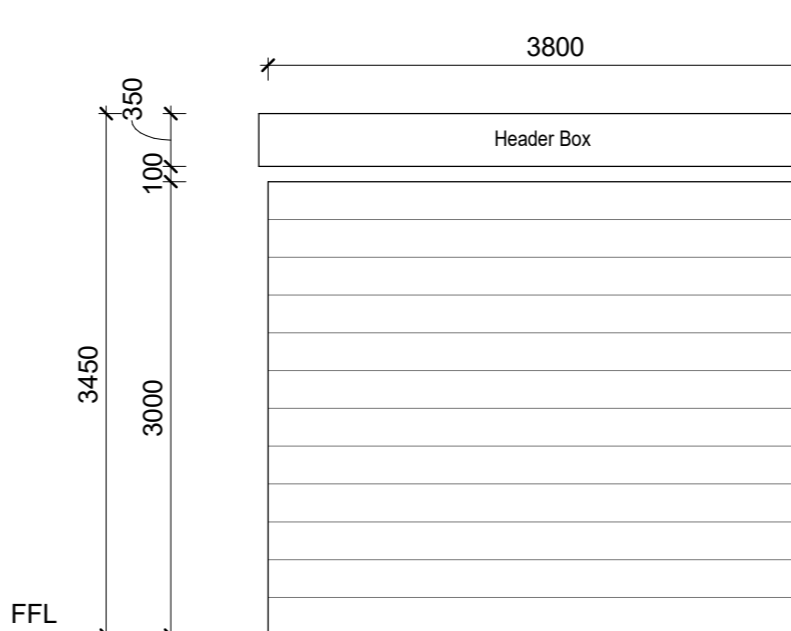


Table for RSD04 / SM03 roller shutter schedule with columns for Door Name, Location, Frame, Frame Finish, Door Panel, Door Panel Finish, Glazing, Ironmongery, and General Notes.

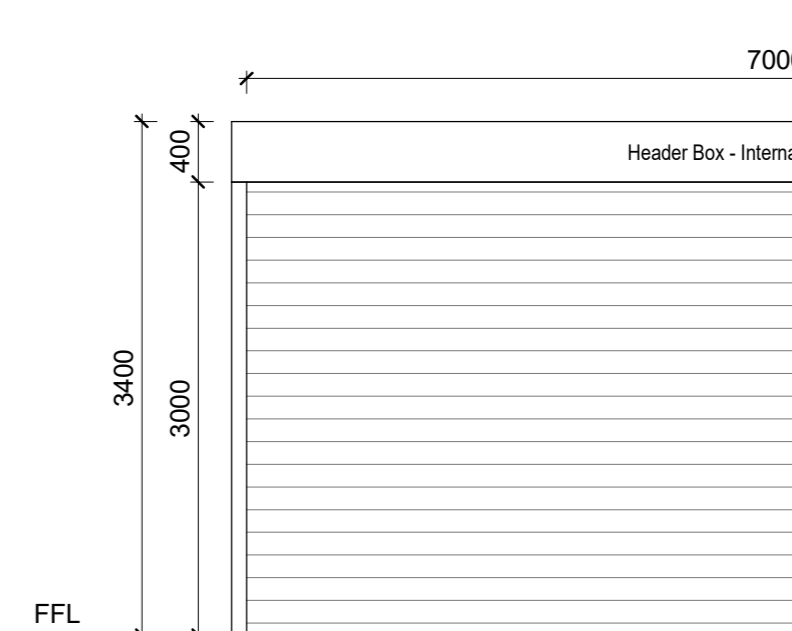


Table for RSD05 / SM04 roller shutter schedule with columns for Door Name, Location, Frame, Frame Finish, Door Panel, Door Panel Finish, Glazing, Ironmongery, and General Notes.

COPYRIGHT NOTICE and REVISIONS table with columns for No, Date, Description, SCA, and APPR.

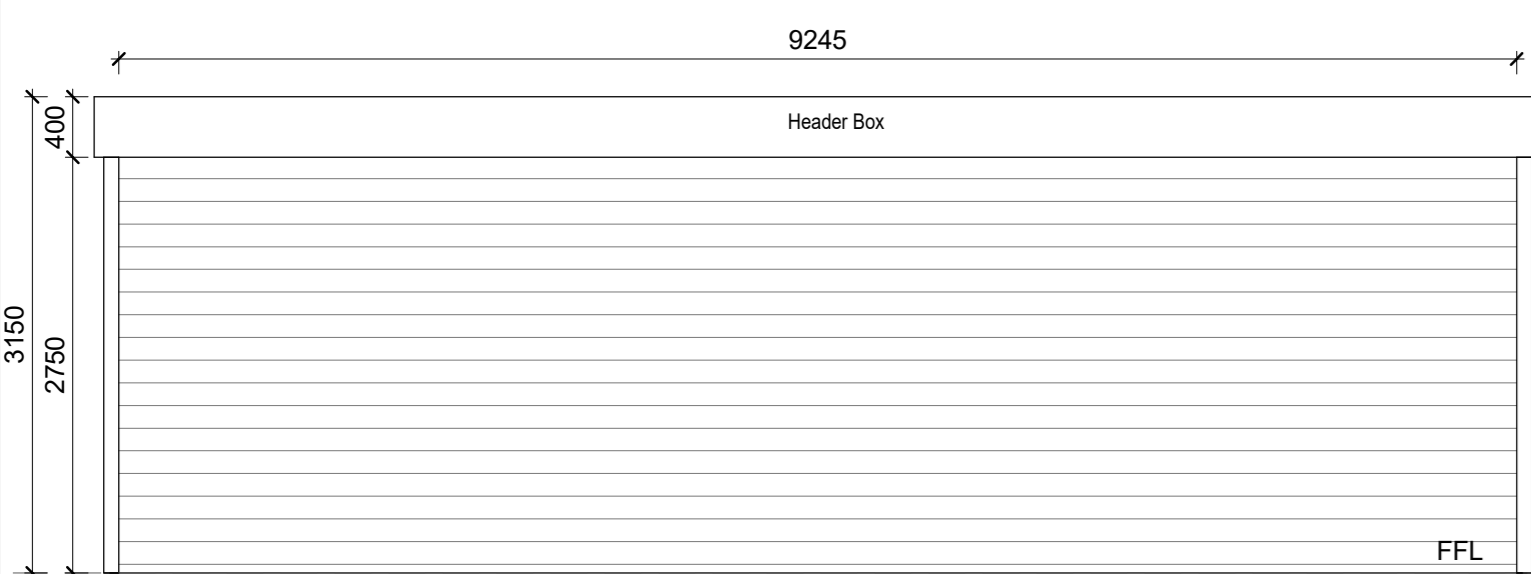


Table for RSD06 / SM05 roller shutter schedule with columns for Door Name, Location, Frame, Frame Finish, Door Panel, Door Panel Finish, Glazing, Ironmongery, and General Notes.

Table for window W01/A and W02/B with columns for Window Name, Quantity, Window Location, Window Opening, Window Description, Window Spec, Glazing, and Ironmongery.

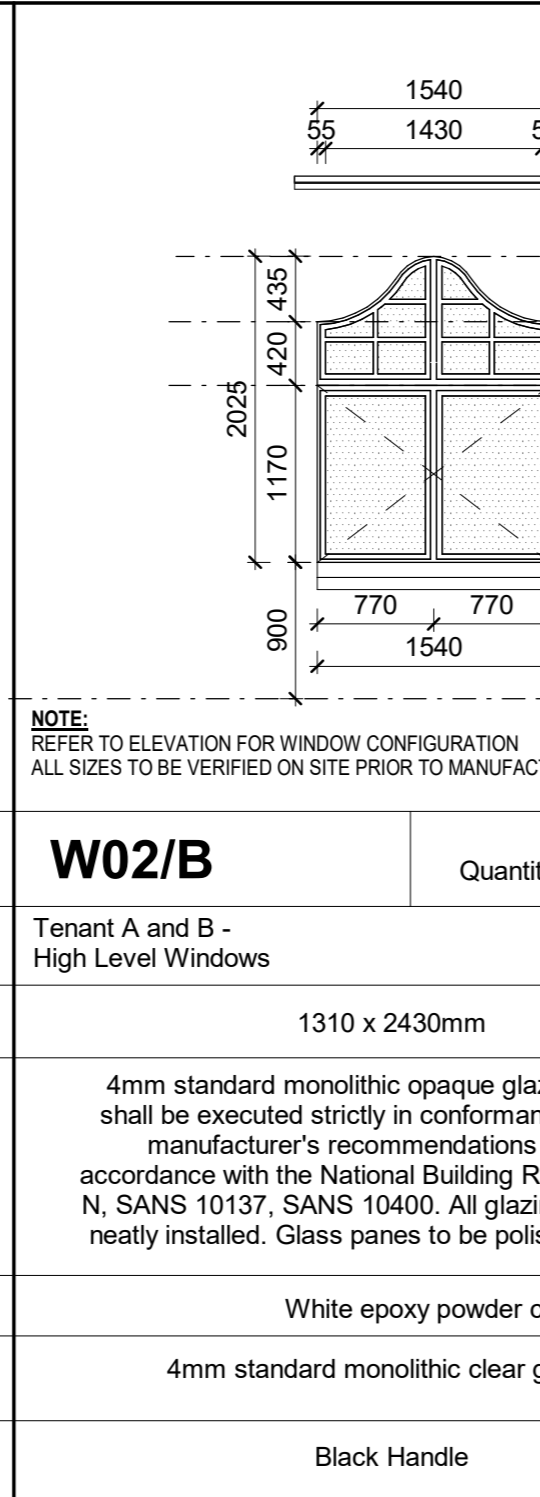
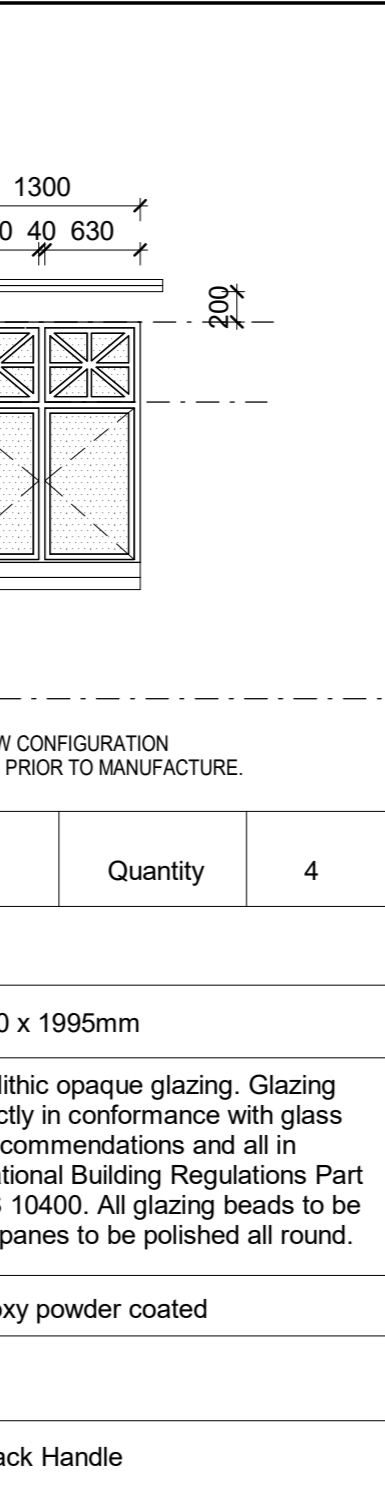


Table for window W03/C and W04/D with columns for Window Name, Quantity, Window Location, Window Opening, Window Description, Window Spec, Glazing, and Ironmongery.

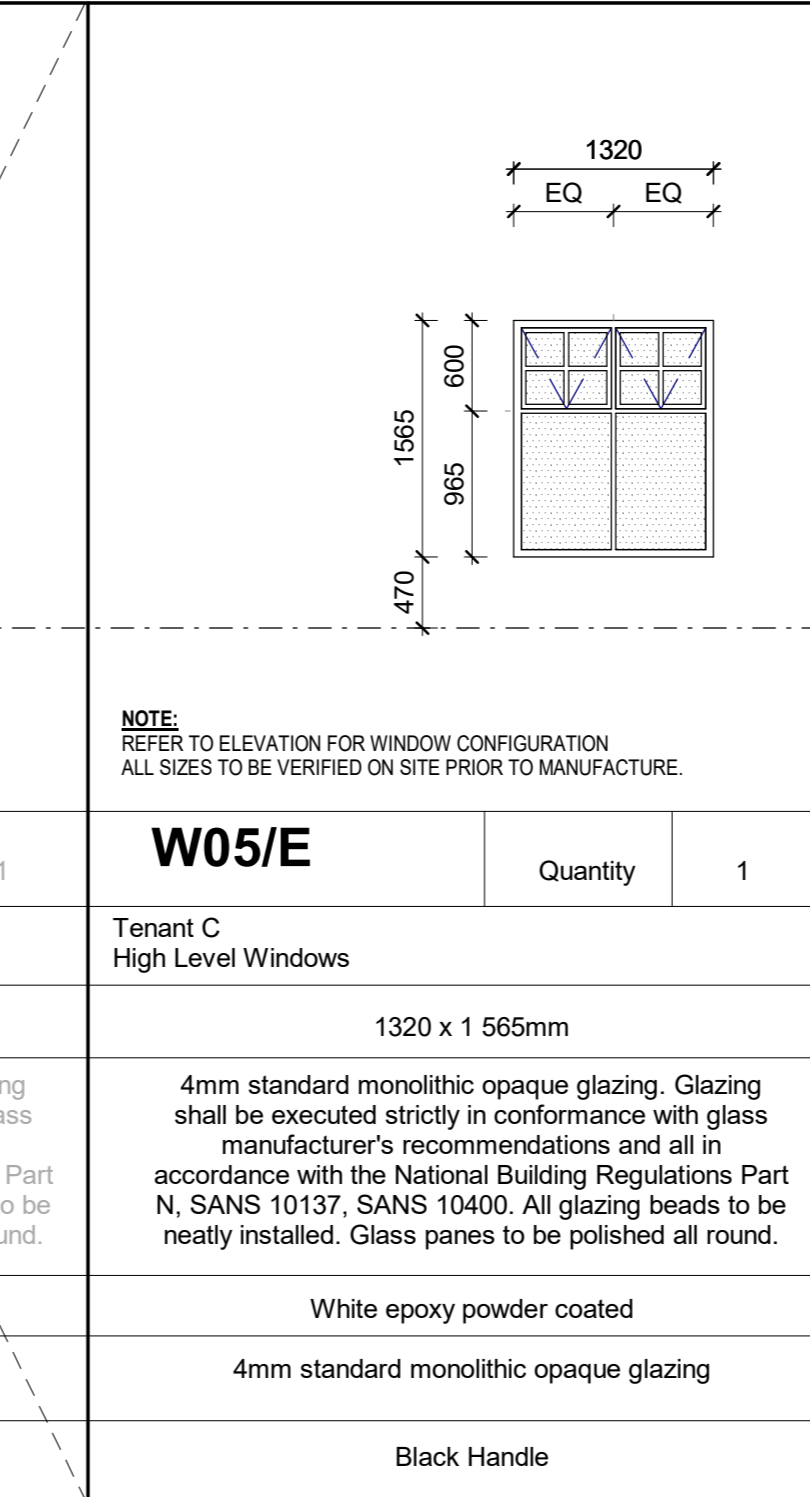
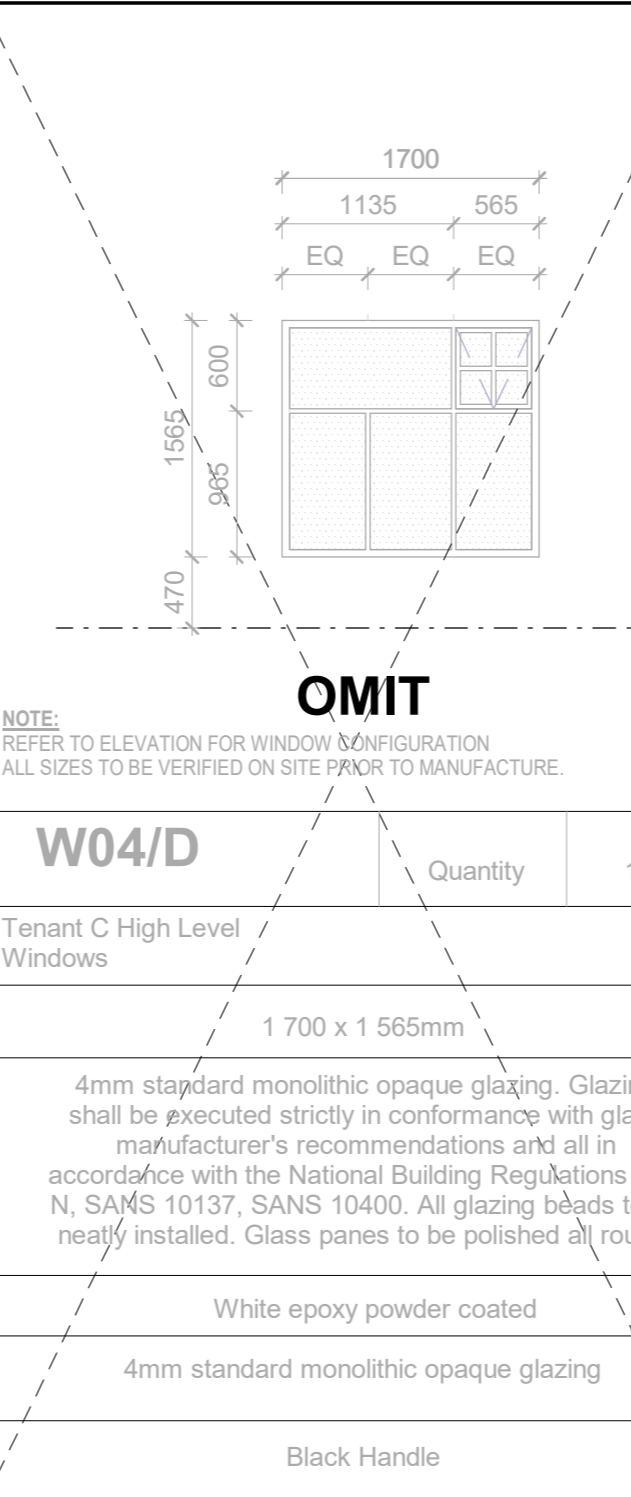


Table for window W05/E and W06/F with columns for Window Name, Quantity, Window Location, Window Opening, Window Description, Window Spec, Glazing, and Ironmongery.

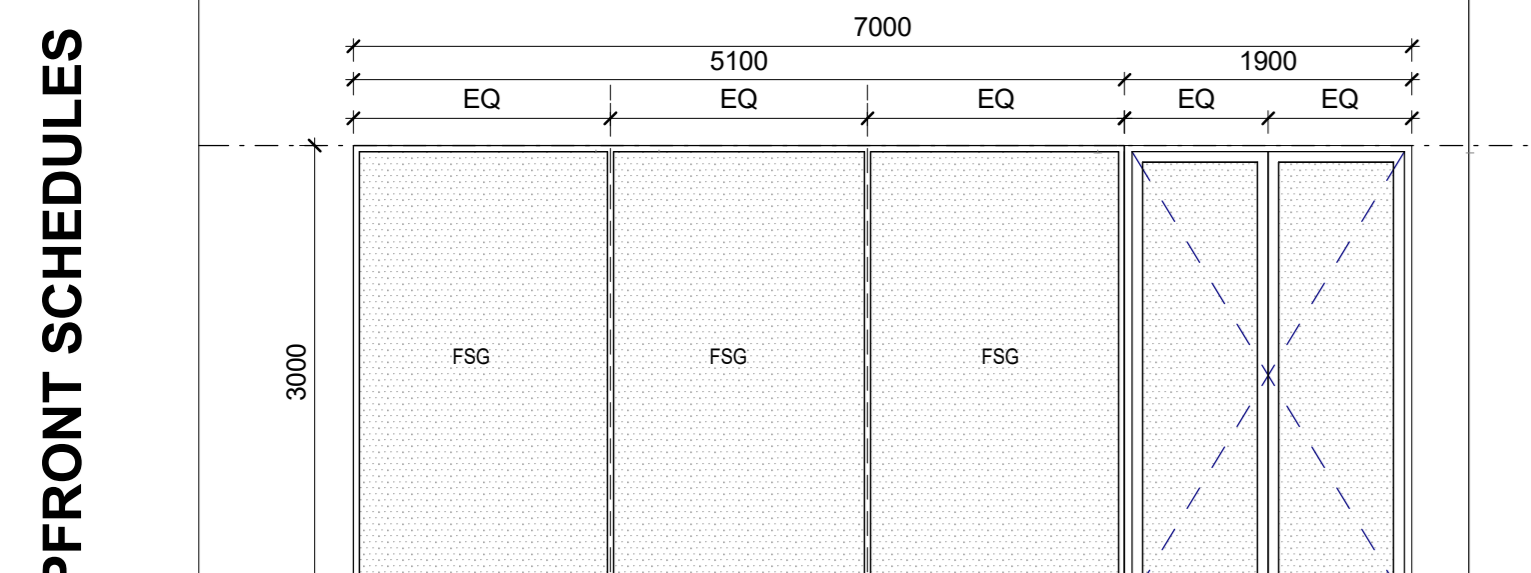
 
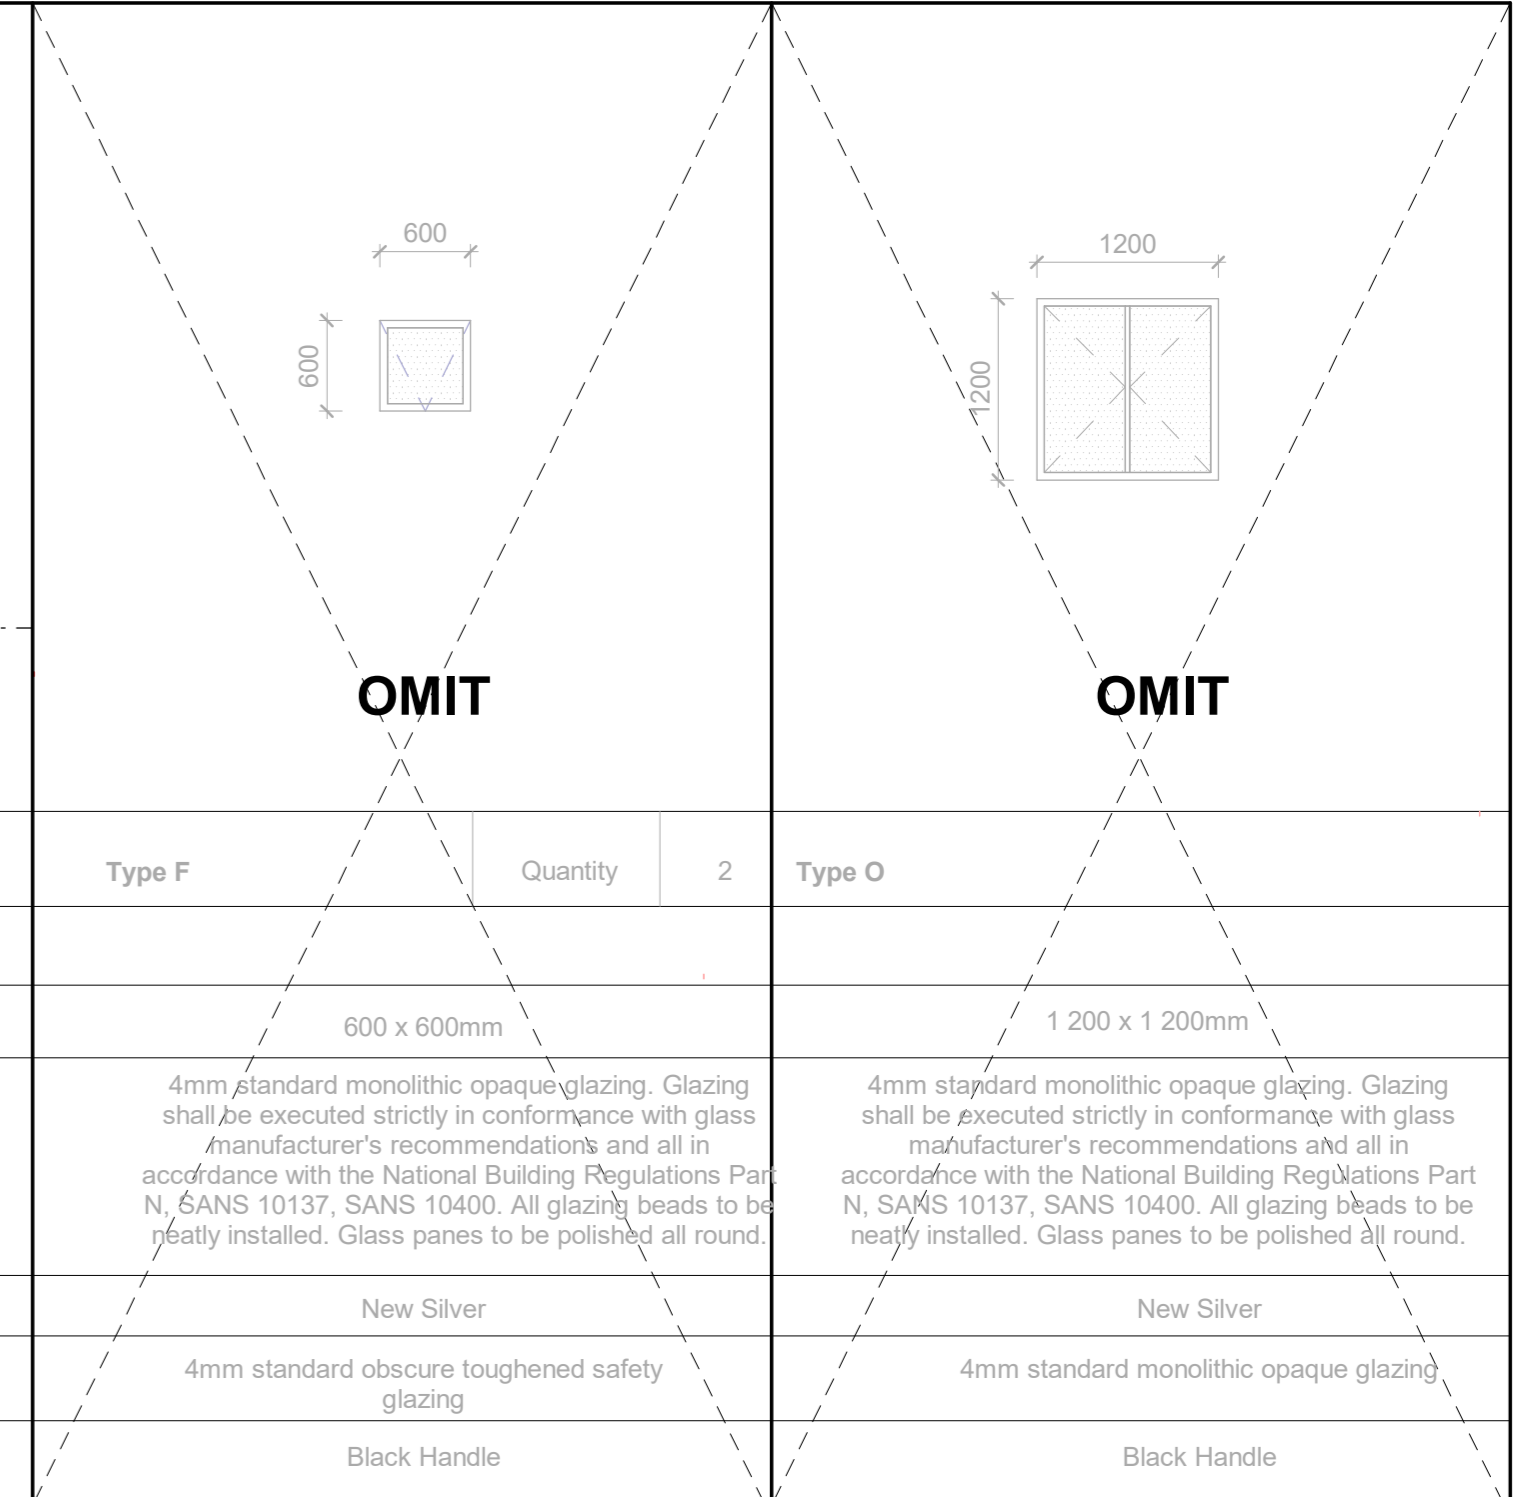


Table for shopfront SF01 with columns for Window Name, Location, Window Type, Window Finish, Glazing, Ironmongery, and Remarks.

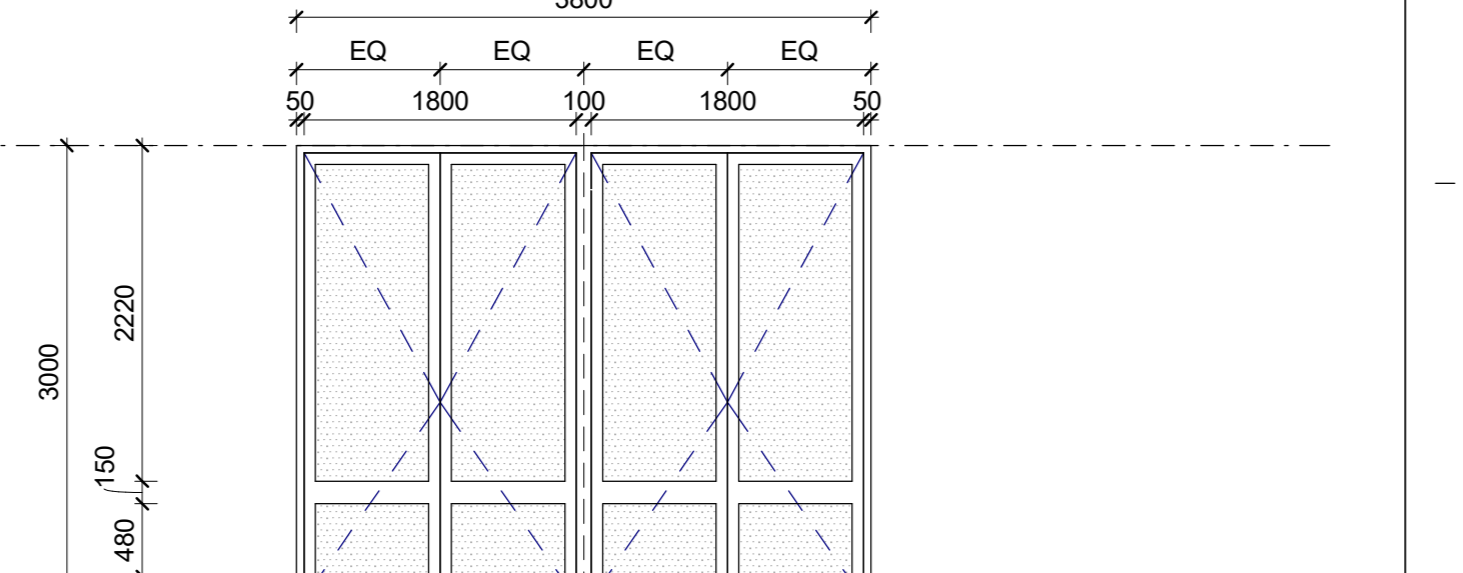


Table for shopfront SF02 with columns for Window Name, Location, Window Type, Window Finish, Glazing, Ironmongery, and Remarks.

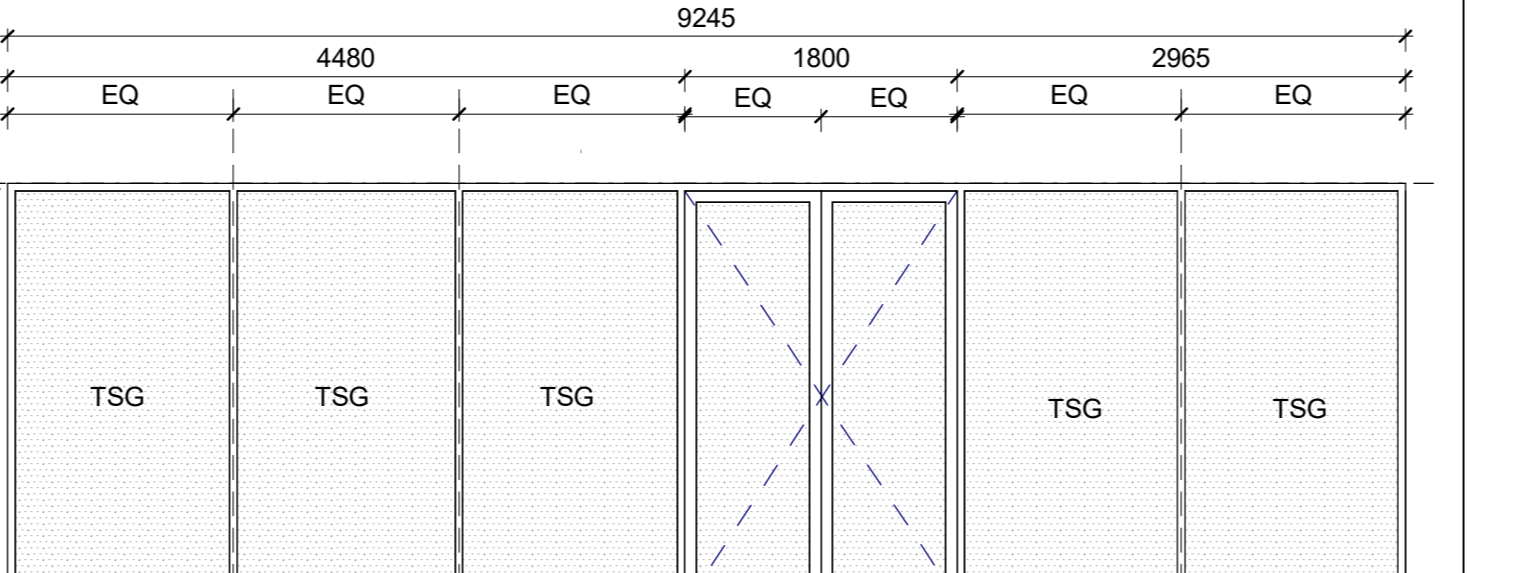


Table for shopfront SF03 with columns for Window Name, Location, Window Type, Window Finish, Glazing, Ironmongery, and Remarks.

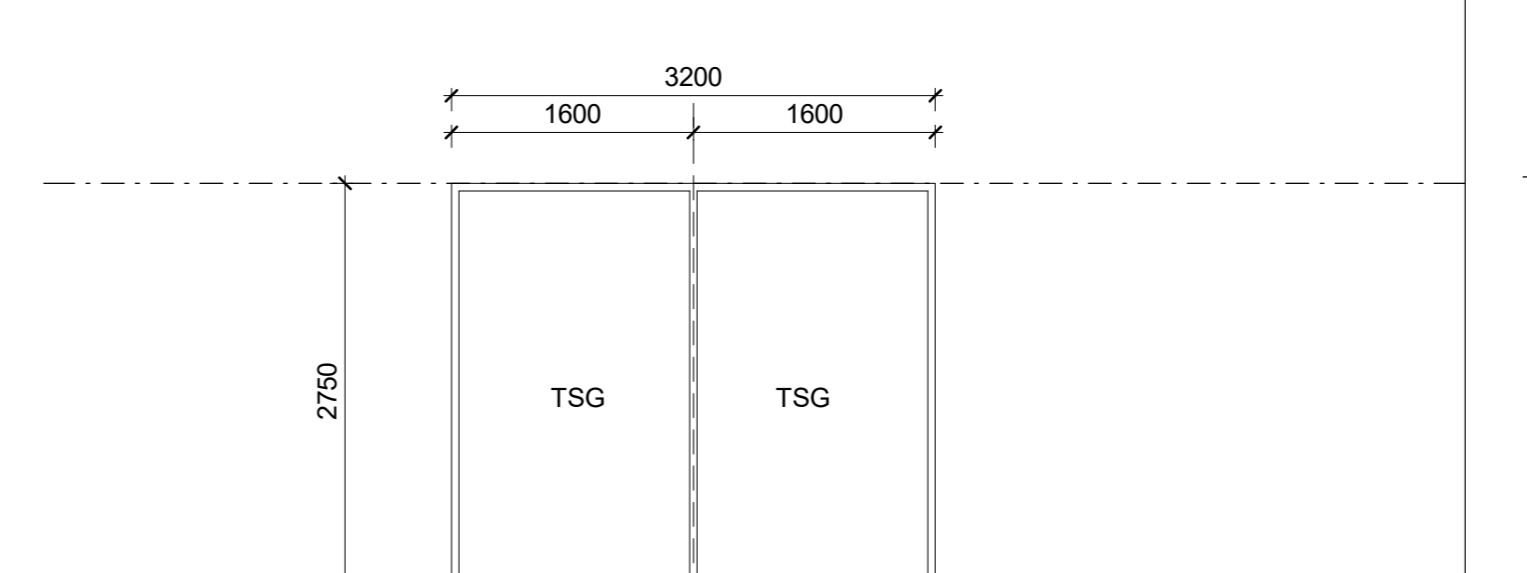


Table for shopfront SF04 with columns for Window Name, Location, Window Type, Window Finish, Glazing, Ironmongery, and Remarks.

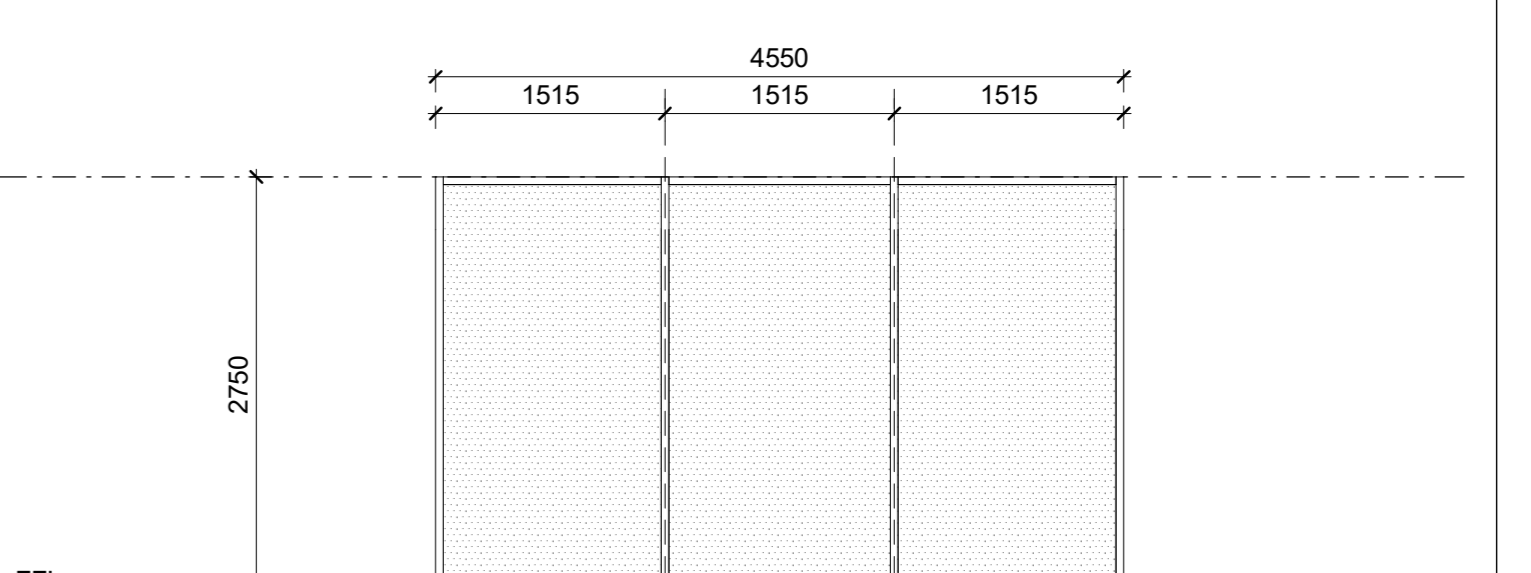


Table for shopfront SF05 with columns for Window Name, Location, Window Type, Window Finish, Glazing, Ironmongery, and Remarks.

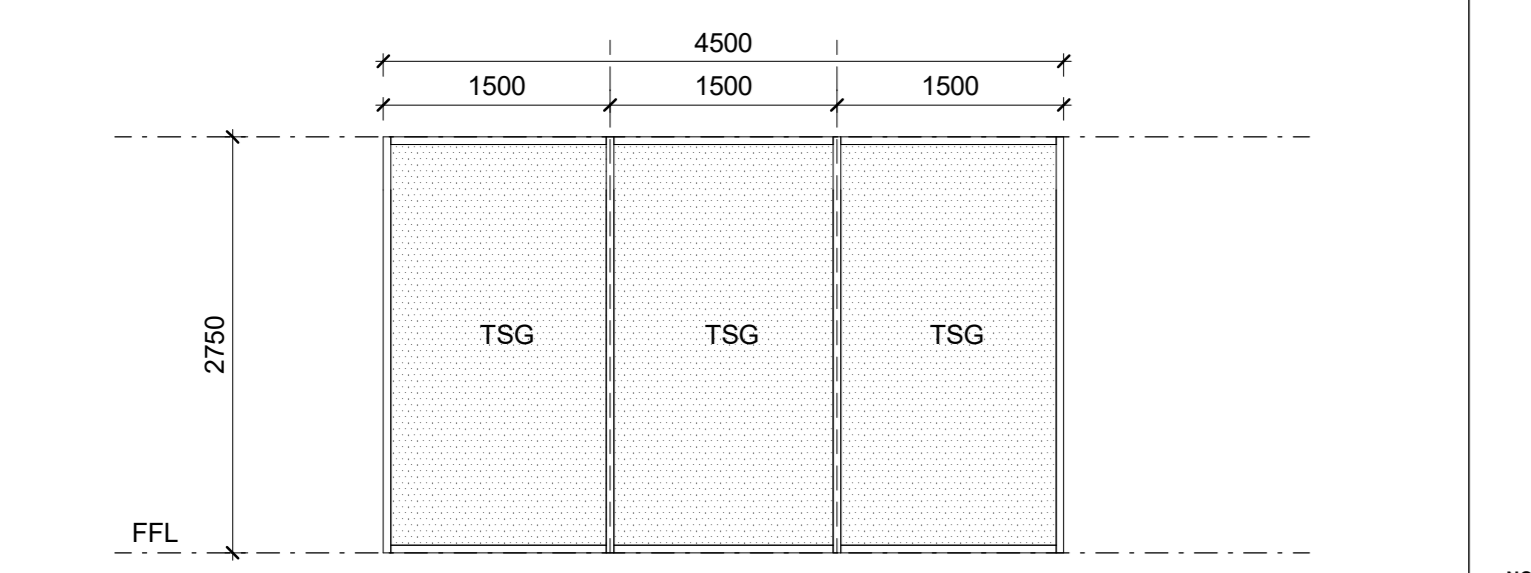


Table for shopfront SF06 with columns for Window Name, Location, Window Type, Window Finish, Glazing, Ironmongery, and Remarks.

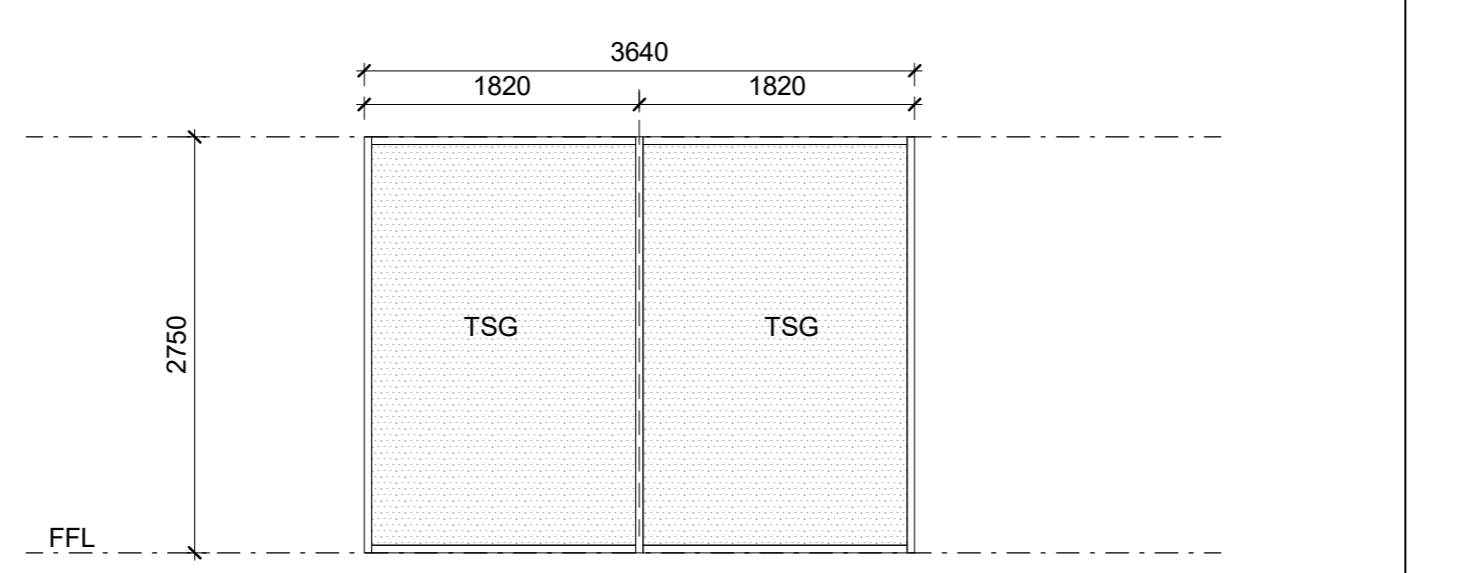


Table for shopfront SF07 with columns for Window Name, Location, Window Type, Window Finish, Glazing, Ironmongery, and Remarks.

KEYPLAN, FOR INFORMATION, DESIGN DEVELOPMENT, SKETCH PLAN, TENDER, CONSTRUCTION, MUNICIPAL SUBMISSION, AS BUILT, and MUNICIPAL SUBMISSION table.

tc rpv ARCHITECTS logo and contact information for Richard Circo, Tel +27 31 502 3625, Rigelstone Office Park, 4320, E-mail philip@trpvc.co.za, www.trpvc.co.za

Deviations to Approved Plan Nos. 198/22 (Ptn 3 of 2of ERF 2518, 180 Church Street), 199/22 (Ptn 2 of ERF 2518, 182 Church Street) and 200/22 (Ptn 4 of 2518, 184 Church Street) PROJECT NAME, Deviations to Approved Plan, PROJECT ADDRESS, Church Street, Pietermaritzburg, PROJECT ADDRESS, SIZE SCALE CURRENT REVISION DATE, DRAWING TITLE, Doors and Windows Schedules, Project Code, Originator, Zone, Level, Type, Reg, Date, No, Rev, 4265 -700

ROLLER SHUTTER DOORS ABOVE SHOPFRONTS

Table for roller shutter doors above shopfronts with columns for Window Types, Frame, Frame Finish, Door Panel, Door Panel Finish, Glazing, Ironmongery, and General Notes.