

96 Edmonds Rd.



PROPOSED COTTAGE EDMONDS ROAD

FOR


D. WILSON Esq.

Prepared by
The Durban Drawing & Printing Office
DURBAN


SCALE 1/8" = 1 FOOT

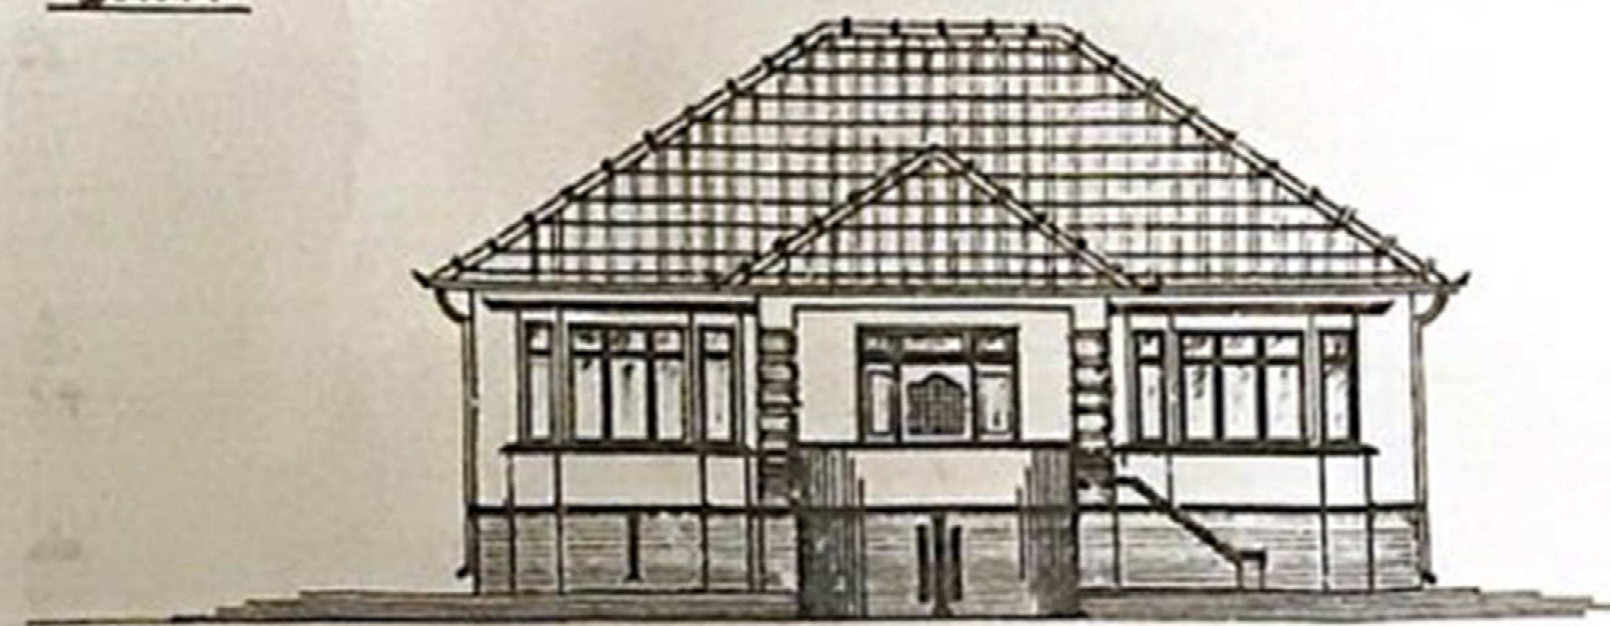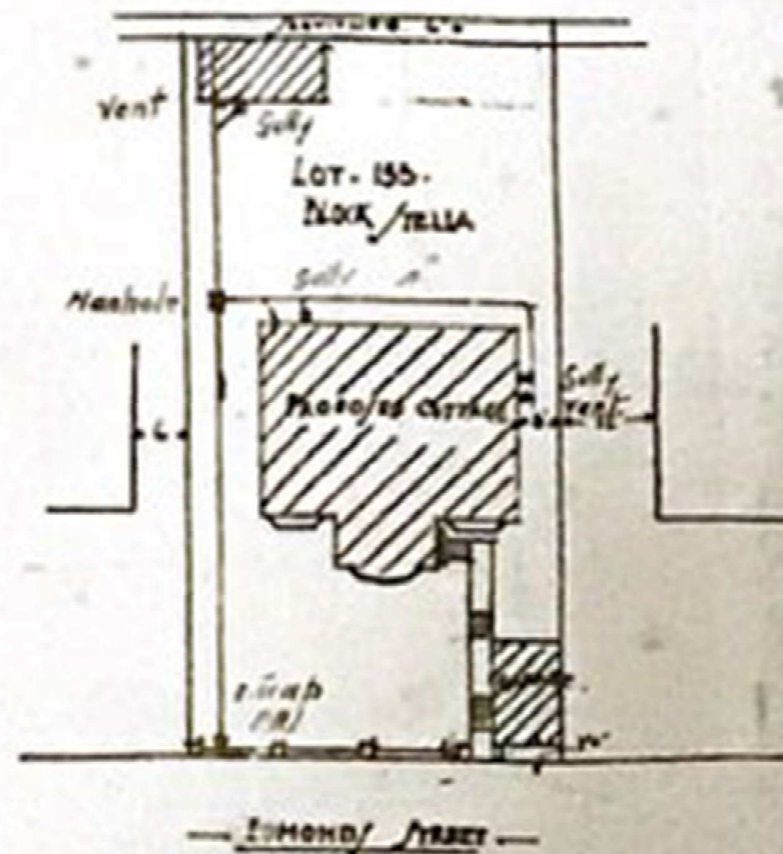



ELEVATION

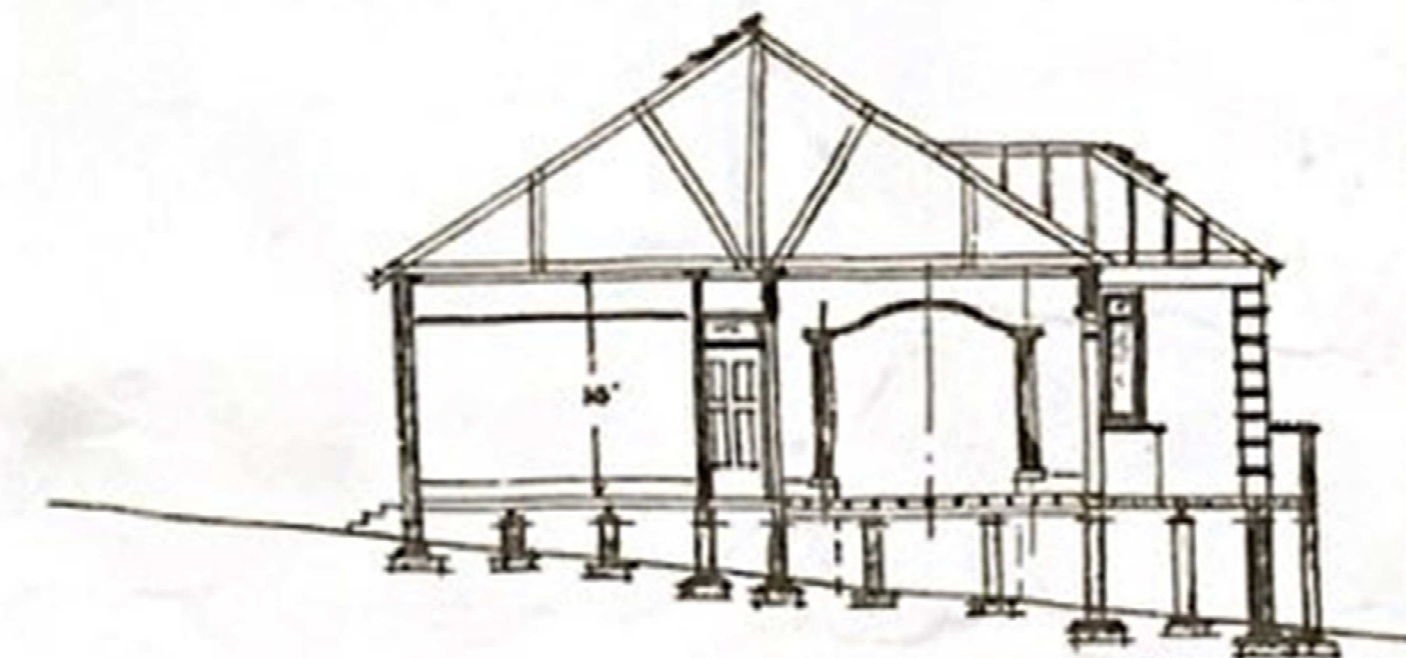



SECTION A-A

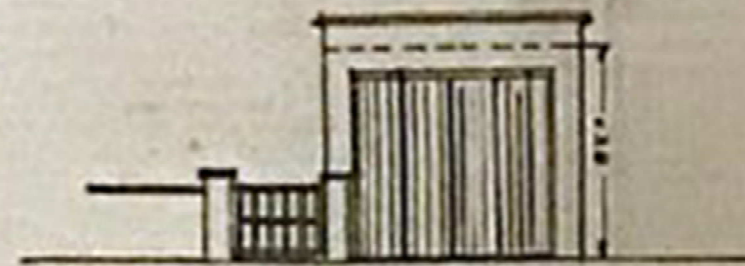


ELEVATION of MAIN
GARAGE

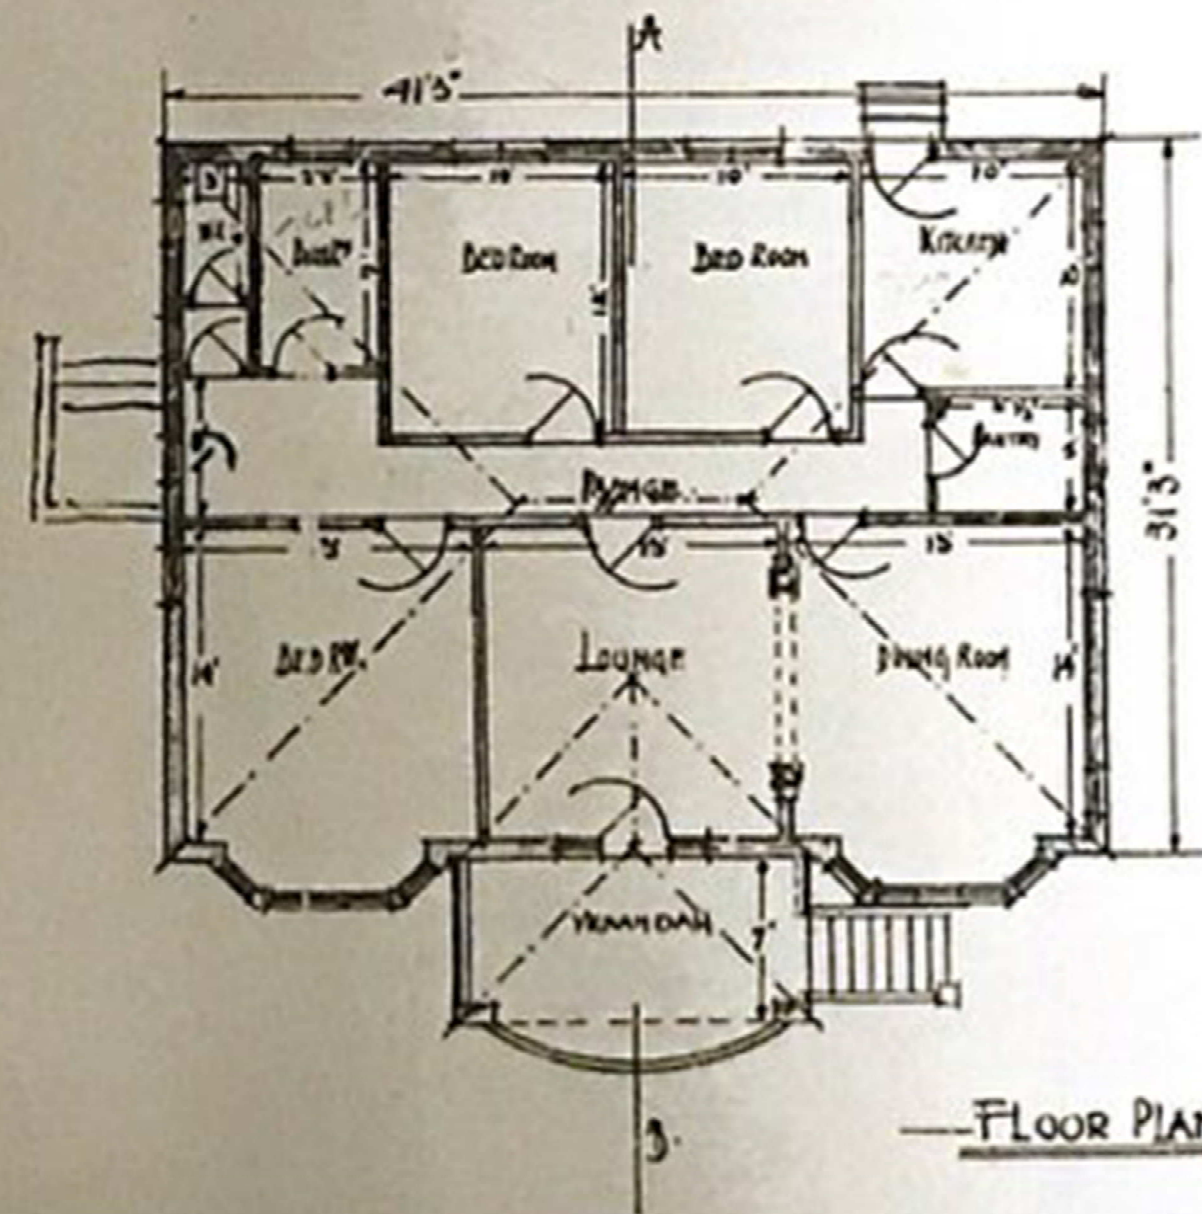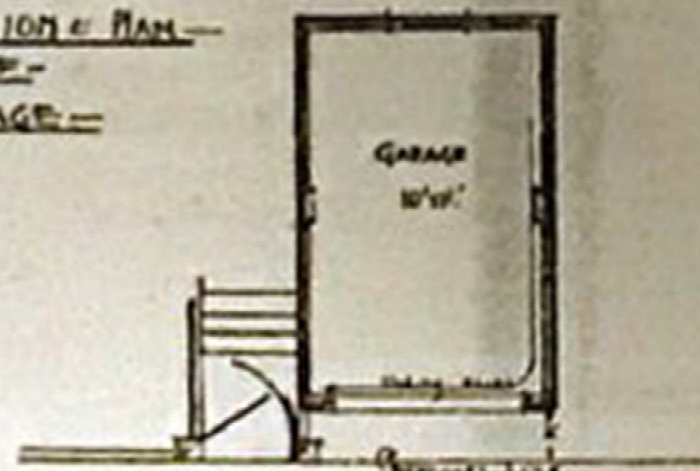

FLOOR PLAN

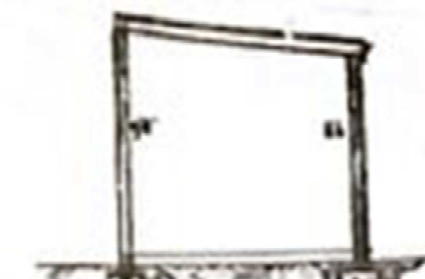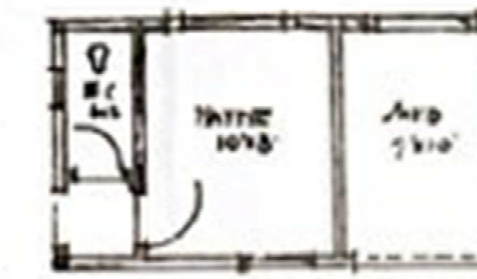

OUTBUILDING

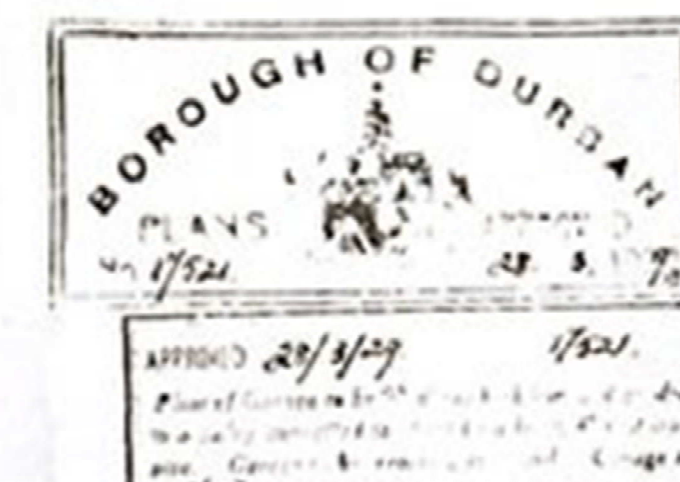

KINLOCH ARCHITECTURAL SERVICES
30 Bridgeview Road, 30 Morningview, Morningside, Durban, 4001
Cell: 0794612555

ARCHITECT SIGNATURE	REG NUMBER
CLIENT	Mr and Mrs Edwards
PROJECT DESCRIPTION	AS BUILT
CADASTRAL	ERF 566 SPRINGVALE
ADDRESS	96 Edmonds Road, Glenwood, Durban, 4001
DRAWING TITLE	Plans Sections and Elevations
DRAWN BY: T. KINLOCH	CHECKED BY: TK
DATE/SCALE	JOB NO. JOB STAGE
15 03 2022	ED001KAS SKETCH
1:100 A1 PAGE	OF 1
	OF 1
	D