
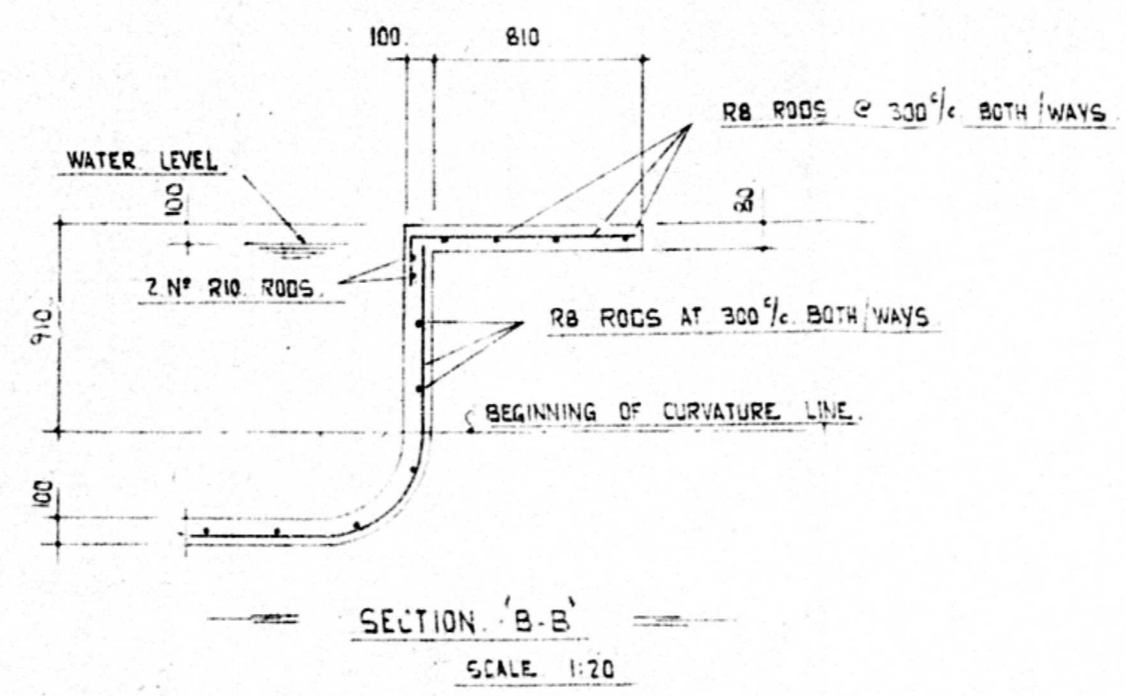



TOWN PLANNING SECTION  
 APPROVED  
 DATE 1979-12-07  
 SIGNATURE

EXTREME CARE TO BE EXERCISED WHEN  
 EXCAVATING IN VICINITY OF CABLE/S SHOWN  
 ON THIS PLAN. SHOULD CABLE/S BE DAMAGED  
 NOTIFY ELECT. DEPT. PH. 314040 EXT. 251  
 IMMEDIATELY.

**ORIGINAL  
 AS BUILT**

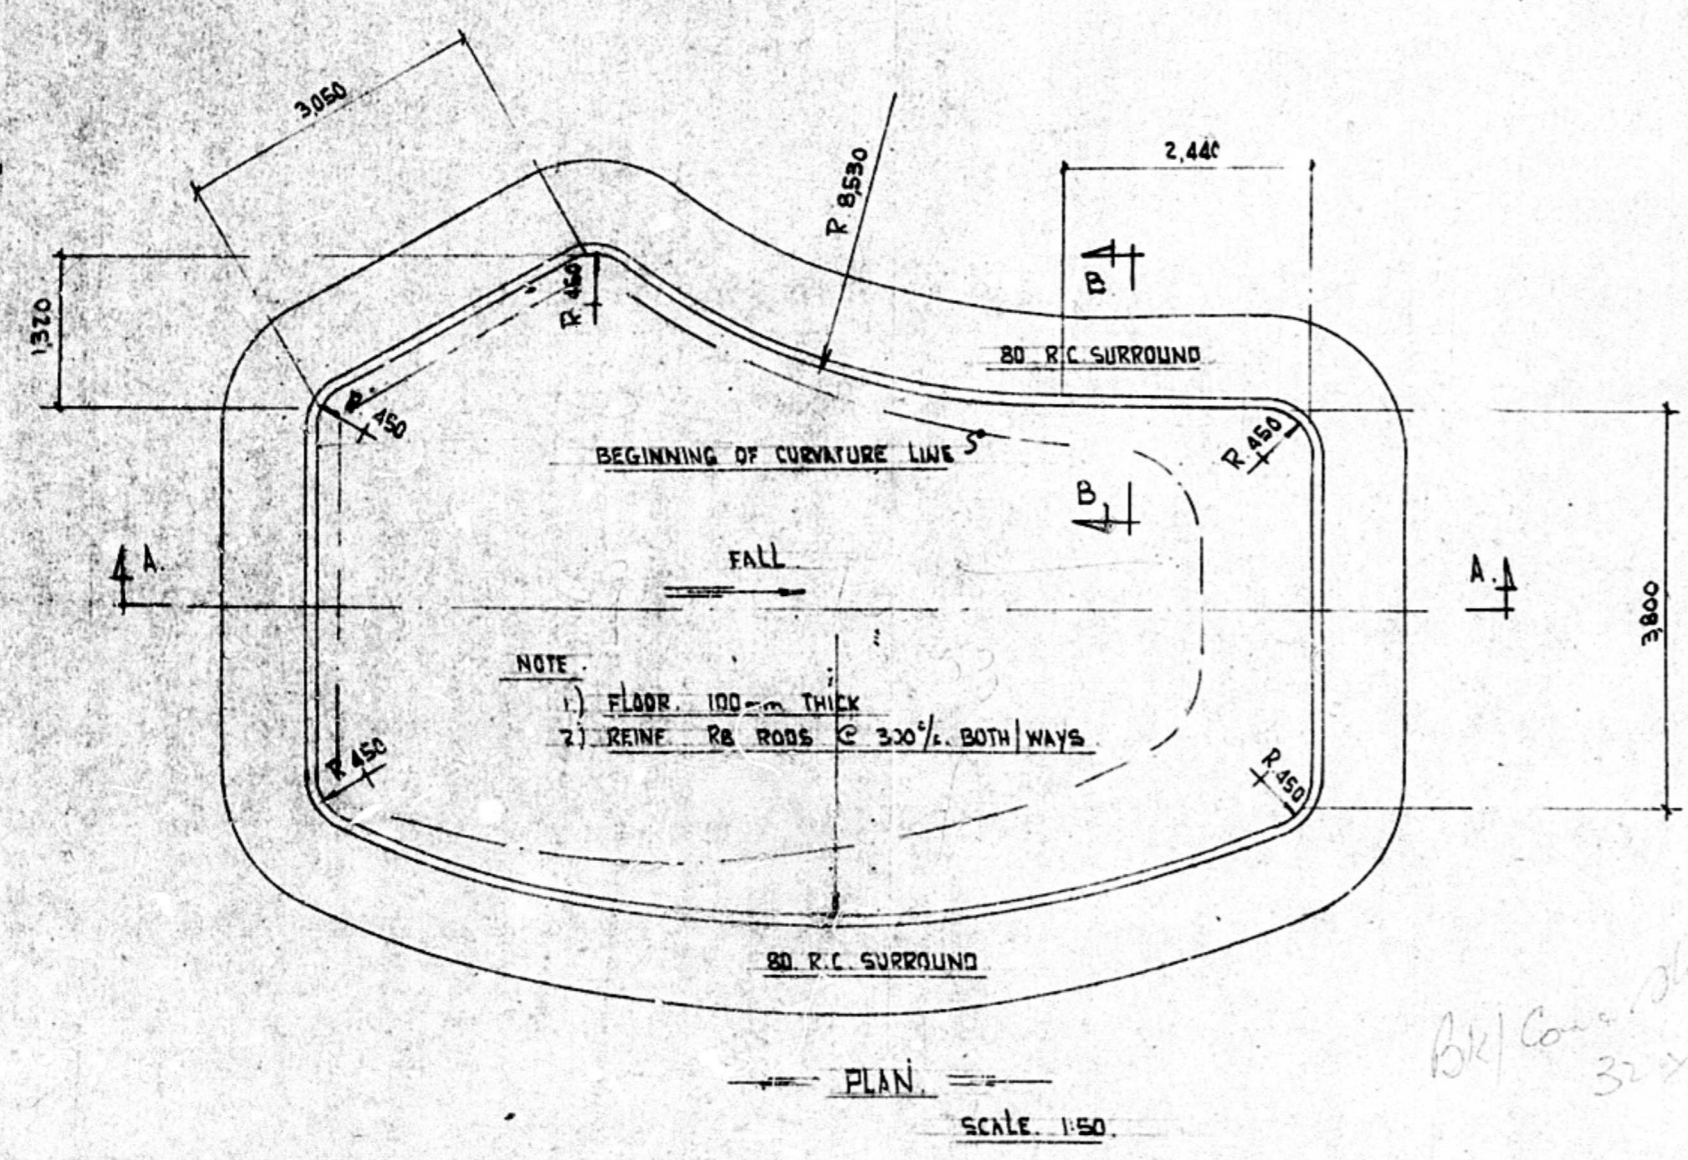

- NOTES:
- 1) GUNITE MIX: 1 PART CEMENT TO 4 PARTS WASHED SAND. WATER CONTENT NOT TO EXCEED 13 LITRES PER SACK CEMENT.
  - 2) GUNITE SHALL BE PLACED AGAINST UNDISTURBED SOIL OR OTHER FIRM SURFACE, AS DIRECTED BY ENGINEER.
  - 3) 12mm MIN COVER TO ALL REINFC.
  - 4) WHERE GROUND WATER IS ENCOUNTERED UNDERPOOL DRAINAGE SHALL BE PROVIDED AS DIRECTED BY ENGINEER.
  - 5) NO SURFACE LOADING WHATSOEVER SHALL BE IMPOSED WITHIN A DISTANCE OF 2m AT THE DEEP END AND 1.0m AT THE SHALLOW END.

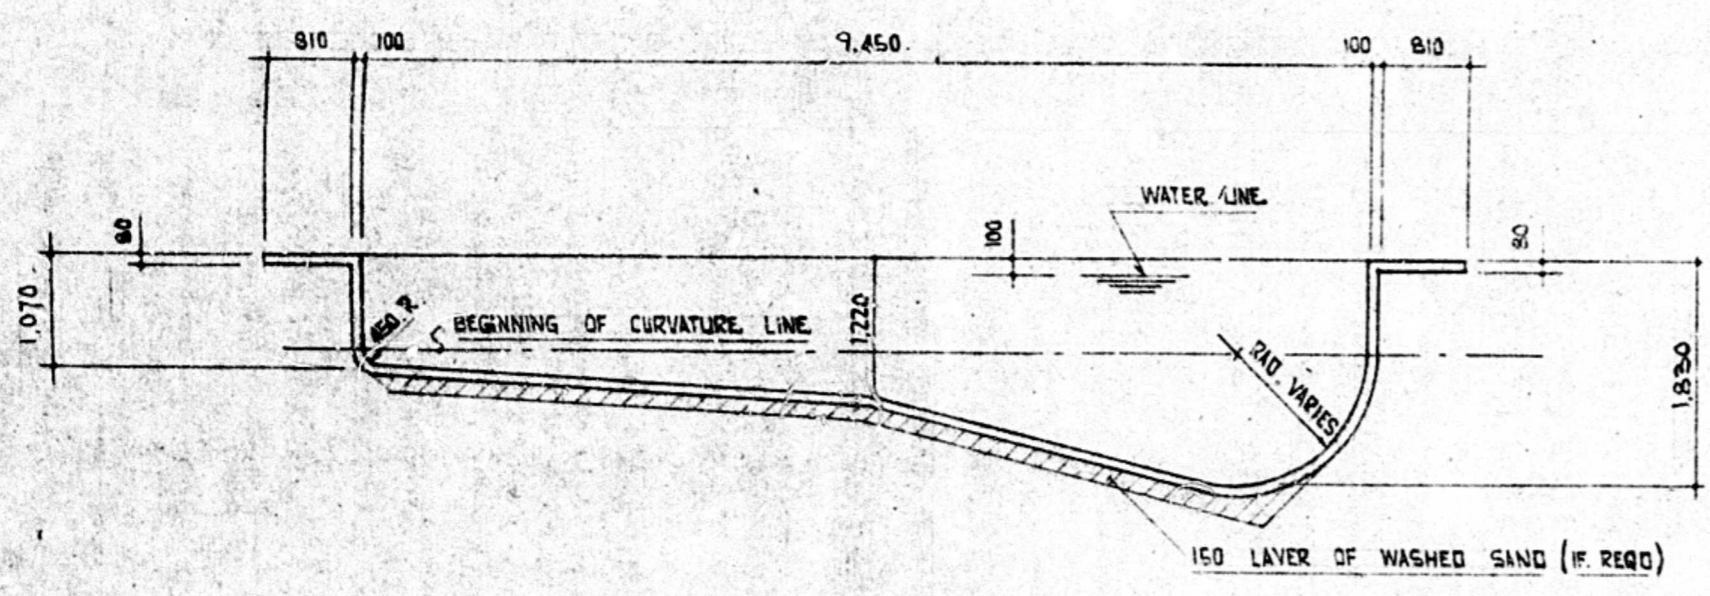

- NOTES:
- 1) EARTH LEAKAGE PROTECTION TO BE FITTED ON ELECTRICAL SUPPLY
  - 2) PRECAUTIONS TO BE TAKEN IN REGARD TO CONDENSATE
  - 3) PUMP CHAMBER TO BE ADEQUATELY DRAINED
  - 4) ELECTRICAL EQUIPMENT TO BE SIMILARLY HOUSED AND PRECAUTIONS TAKEN IN REGARD TO FLOODING, SEEPAGE & RAINWATER
  - 5) EFFLUENT DISPOSAL TO BE INTO EXIST. SEWER (VIA B.P. TANK)
  - 6) SOIL FROM EXCAVATION OF POOL TO BE SPREAD OVER SITE.

