


1:100 BLOCK A: SECTION A-A

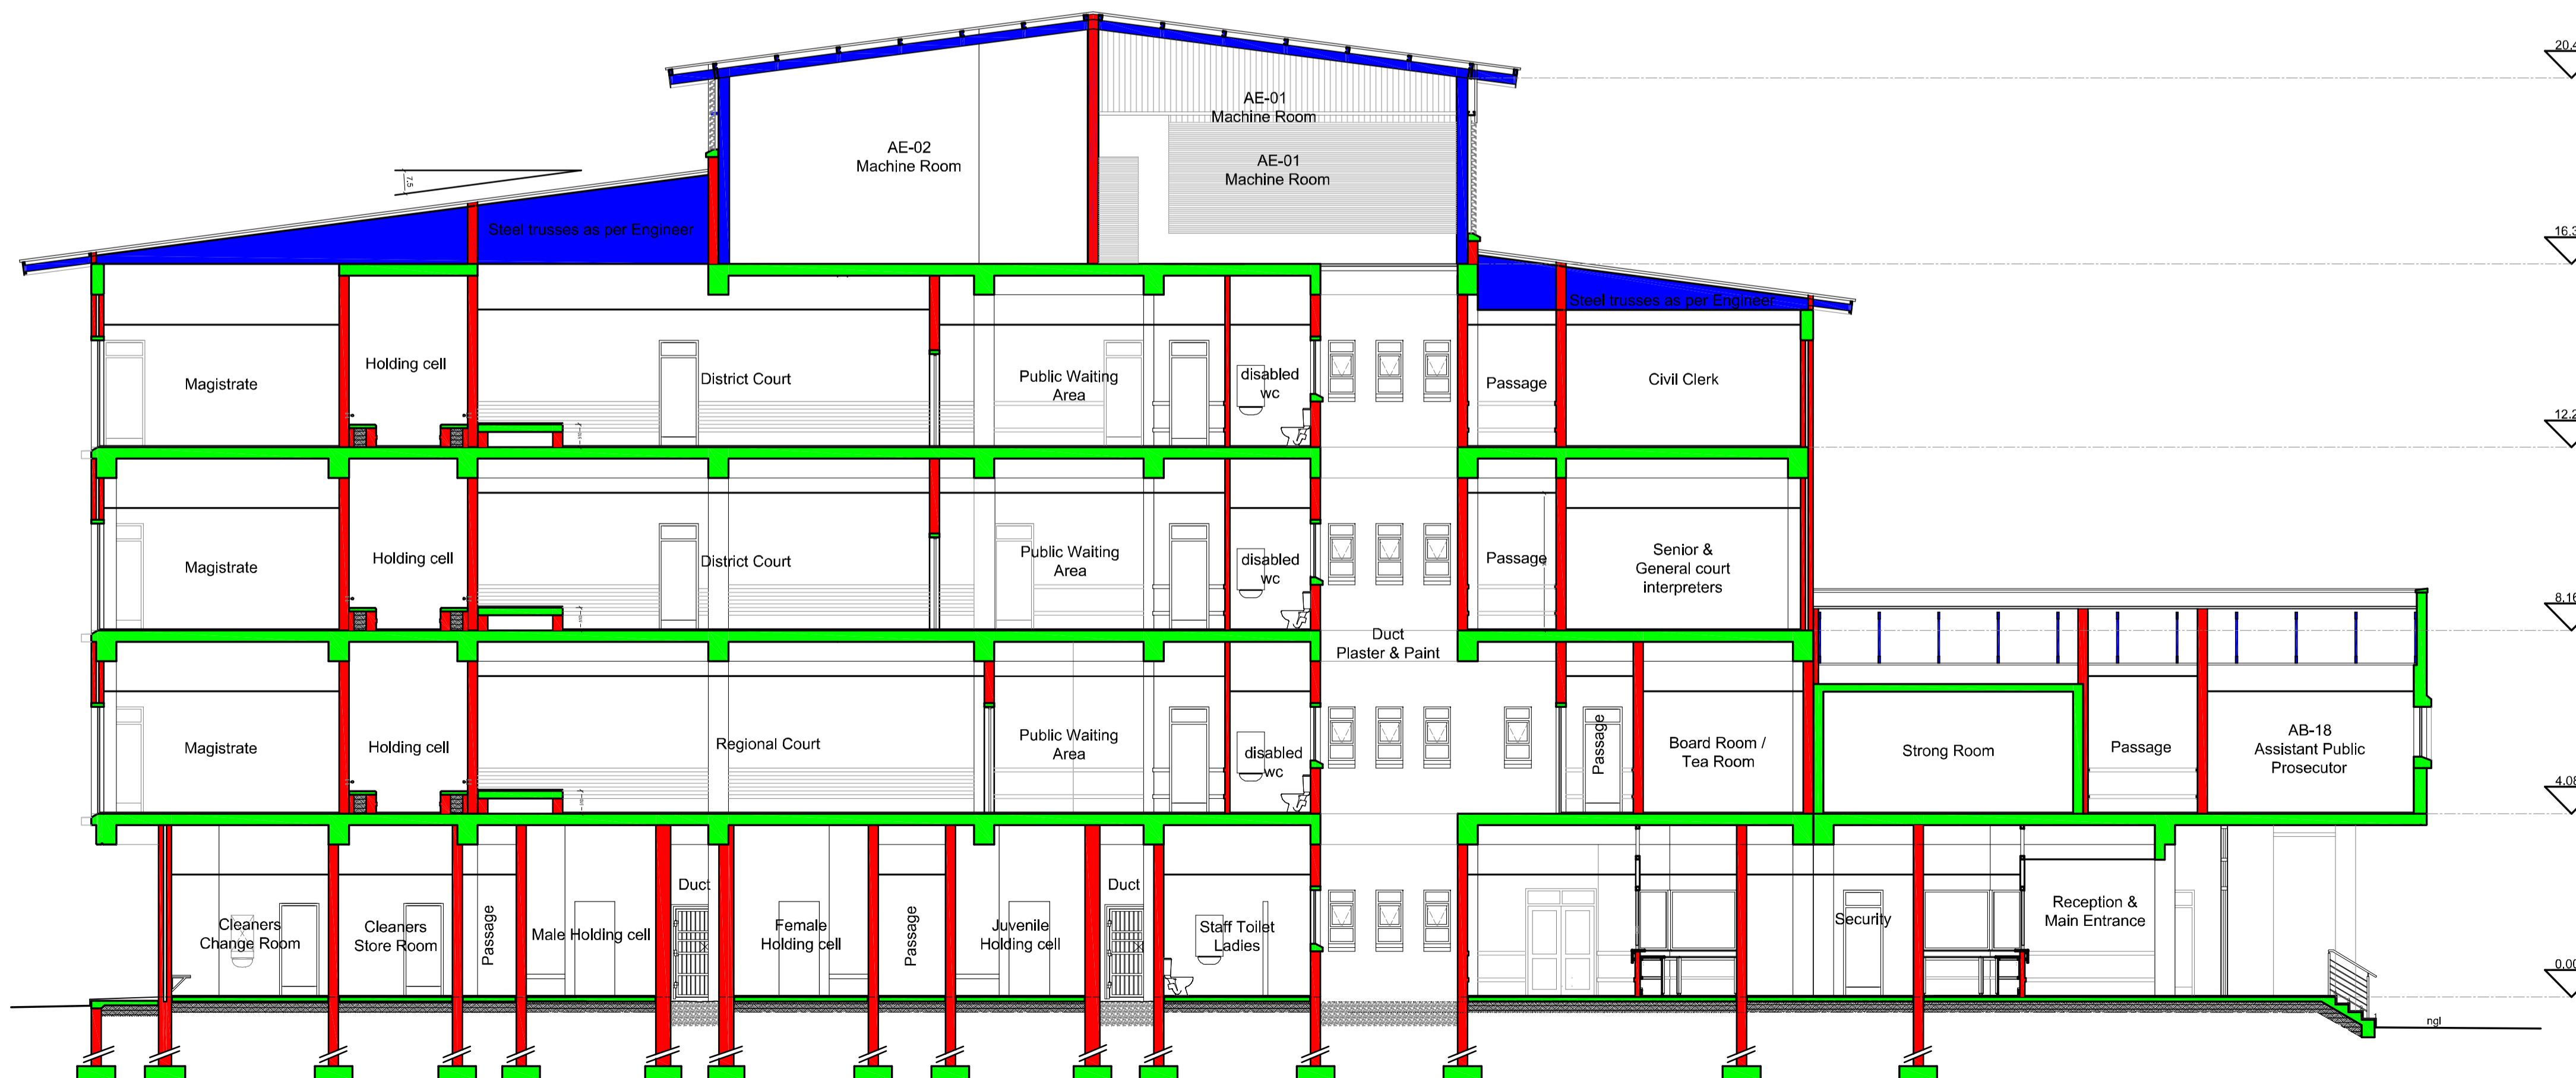

1:100 BLOCK A: SECTION B-B

ALL DIMENSIONS ARE TO BE CHECKED ON SITE PRIOR TO CONSTRUCTION TAKING PLACE. ANY DISCREPANCY BETWEEN ARCHITECTS DRAWINGS, ENGINEERS DRAWINGS AND THE BILLS OF QUANTITIES ARE TO BE CLARIFIED WITH THE ARCHITECT. ALL PRODUCT SPECIFICATION CODES ARE TO BE CHECKED WITH THE SUPPLIER PRIOR TO THE ORDERING AND BUILDING IN OF MATERIAL. ALL STRUCTURE TO BE CHECKED BY THE ENGINEER.

NO.	DATE	AMENDMENT	D.P.W.

Copyright vests in the Department of Public Works

as-built drawings


certified as-built drawings as per Centralised Drawing Archive AS-BUILT DRAWING REQUIREMENTS

name: C.D.H.SPARKS

date: 4661

professional registration no.: 4661

last file name: AMAFA BLOCK A.dwg page from: A 1

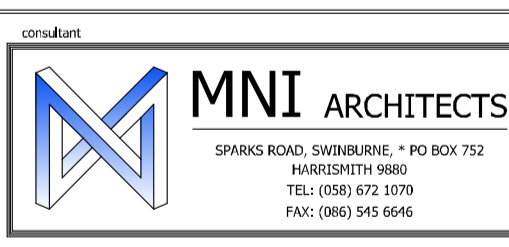

discipline: ARCHITECT
 name: NEWCASTLE MAGISTRATES COURT: UPGRADE, RENOVATION AND EXTENSION OF CURRENT BUILDINGS
 NEWCASTLE, Erf 16957, 33 & 35 MURCHISON STREET.
 WCS number: 45965

drawing title	drawing no.	checked	drawn
BLOCK A: SECTION A-A, SECTION B-B	L12/03/A/13 (WD)	CDHS	AM
scale	AS SHOWN	checked	CDHS
date	AUGUST 2021	checked	CDHS
departmental drawing number			
drawing number	L12/03/A/13 (WD)		

BLOCK A, SECTION A-A & B-B (IN CAD FILE) AMAFA BLOCK A.dwg printed on 05-Jul-2023 at 15:13:26