


1:100 BLOCK A: SECTION C-C.

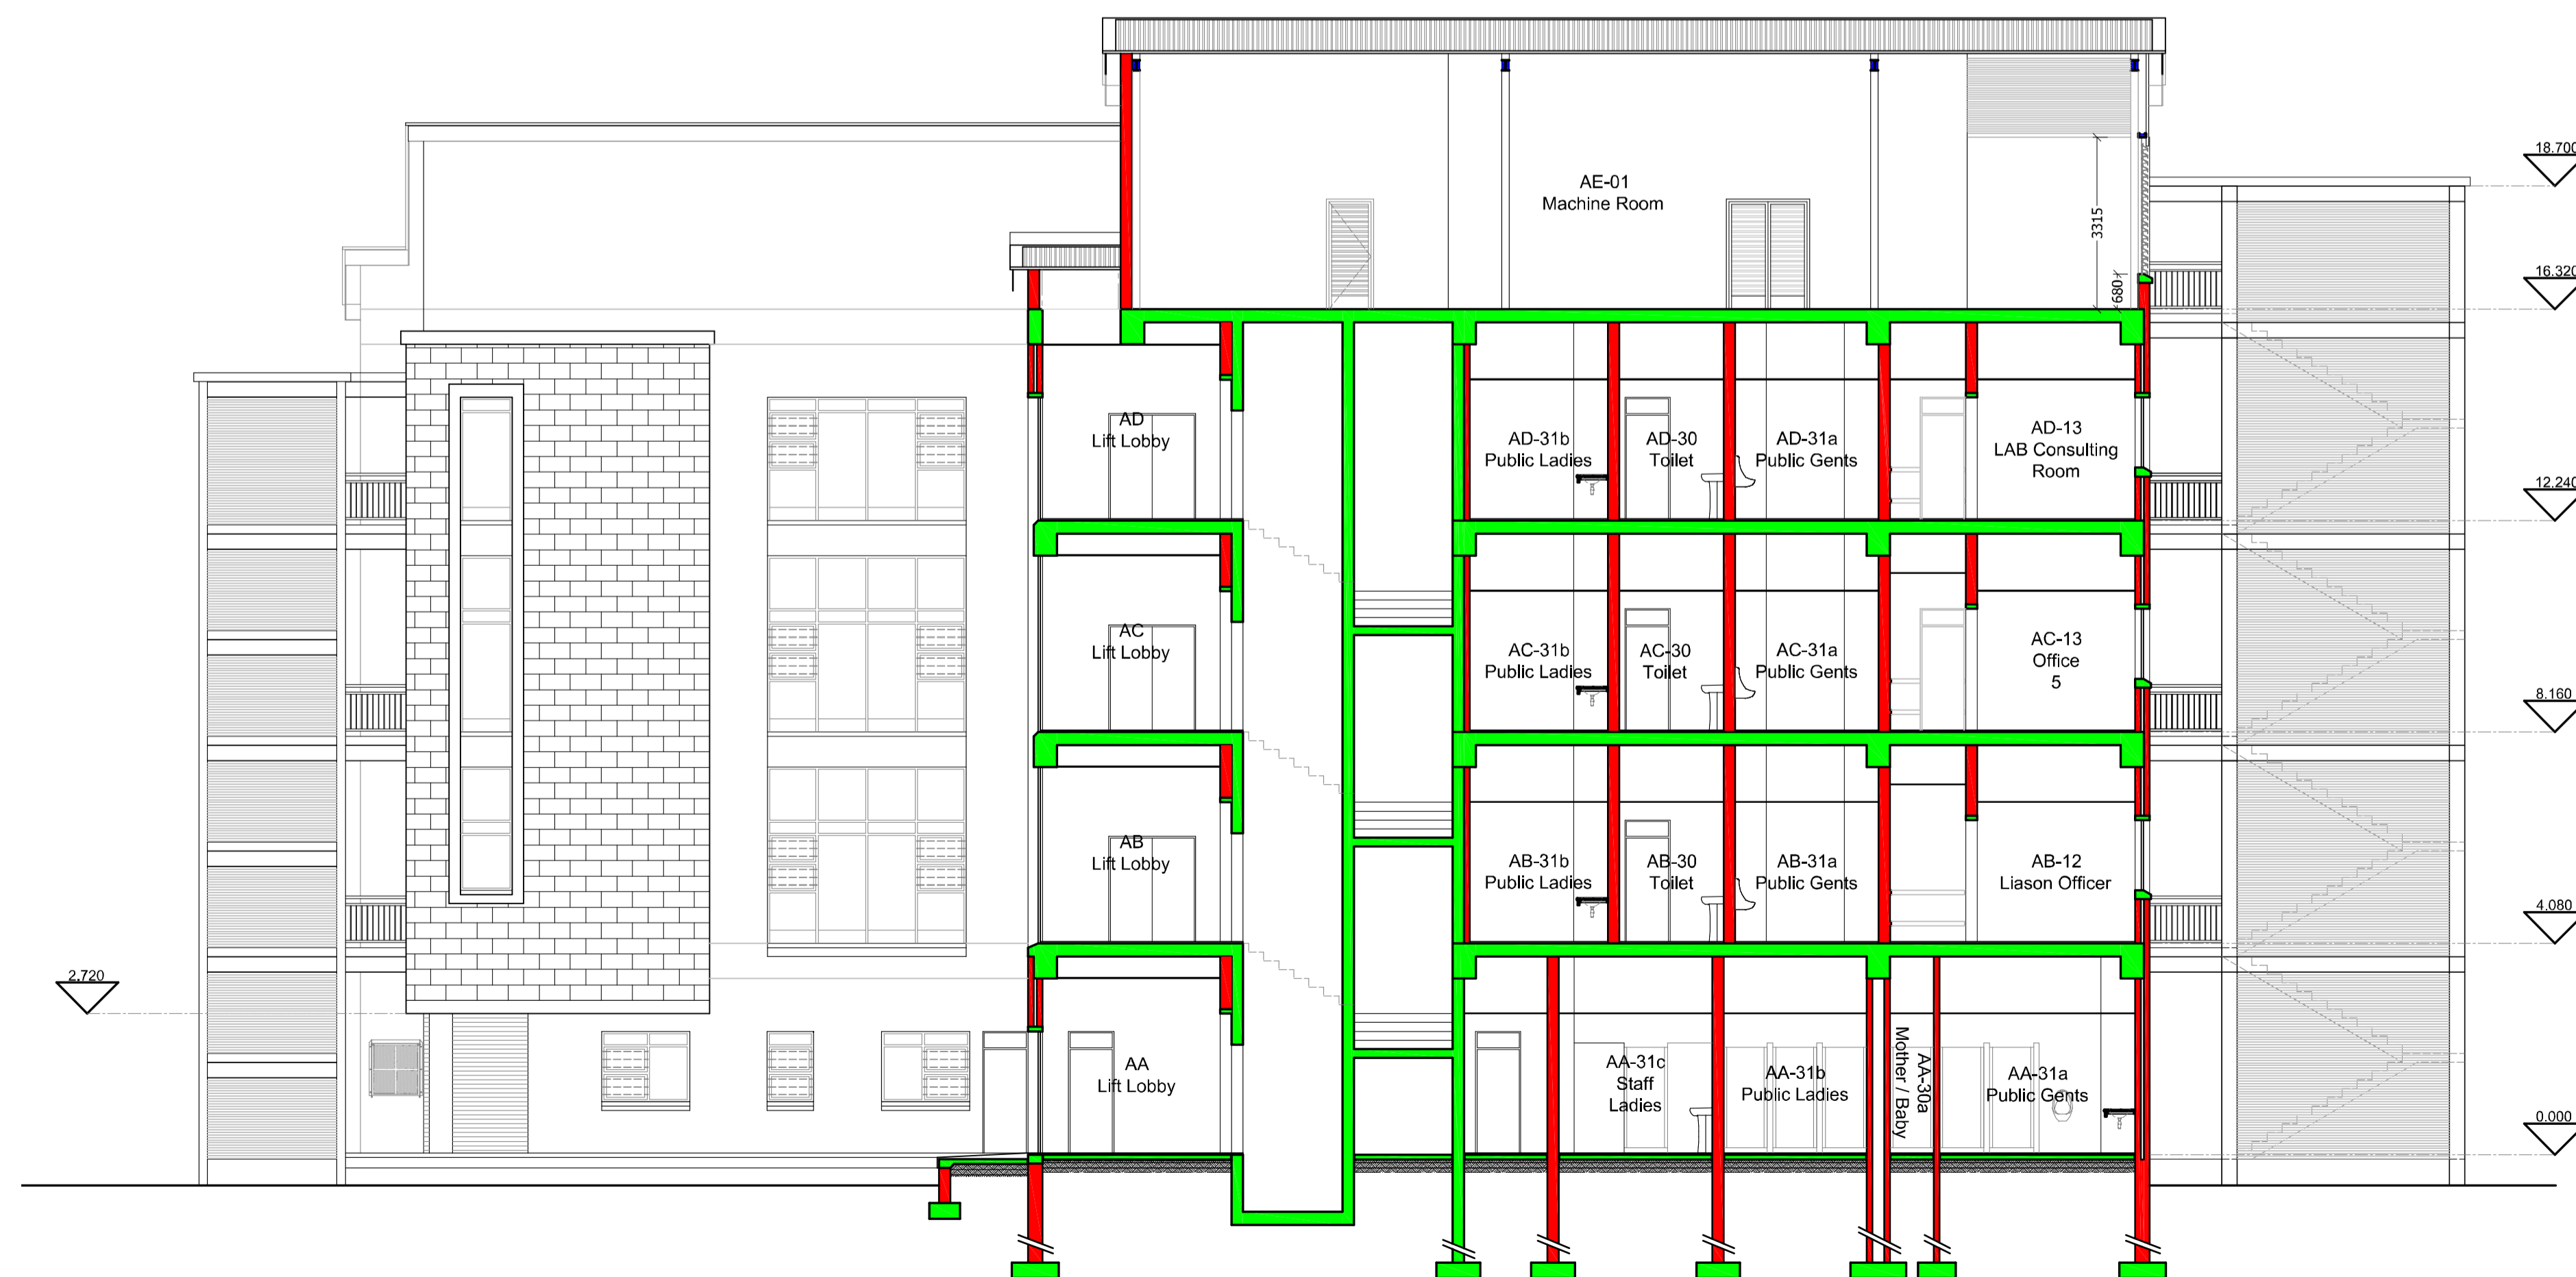

1:100 BLOCK A: SECTION D-D.

ALL DIMENSIONS ARE TO BE CHECKED ON SITE PRIOR TO CONSTRUCTION TAKING PLACE. ANY DISCREPANCY BETWEEN ARCHITECTS DRAWINGS, ENGINEERS DRAWINGS AND THE BILLS OF QUANTITIES ARE TO BE CLARIFIED WITH THE ARCHITECT. ALL PRODUCT SPECIFICATION CODES ARE TO BE CHECKED WITH THE SUPPLIER PRIOR TO THE ORDERING AND BUILDING IN OF MATERIAL. ALL STRUCTURE TO BE CHECKED BY THE ENGINEER.

NO.	DATE	AMENDMENT	D.P.W.

Copyright vests in the Department of Public Works

as-built drawings

certified as-built drawings as per Centralised Drawing Archive AS-BUILT DRAWING REQUIREMENTS

name: C.D.H.SPARKS

date: _____

professional registration no.: 4661

sheet name: AMAFA BLOCK A.dwg page type: A 1



ARCHITECT
 NEWCASTLE MAGISTRATES COURT:
 UPGRADE, RENOVATION AND EXTENSION
 OF CURRENT BUILDINGS
 NEWCASTLE, Erf 16957,
 33 & 35 MURCHISON STREET.
 WCS number: 45965

BLOCK A:
 SECTION C-C,
 SECTION D-D.

ref no	designed	CDHS
scale	AS SHOWN	drawn AM
date	AUGUST 2021	checked CDHS
departmental drawing number		
drawing number	L12/03/A/14 (WD)	

BLOCK A, SECTION C-C & D-D (IN CAD FILE) AMAFA BLOCK A.dwg printed on 05-Jul-2023 at 15:14:18