



1:100 SECTION F-F



1:100 SECTION G-G

ALL DIMENSIONS ARE TO BE CHECKED ON SITE PRIOR TO CONSTRUCTION TAKING PLACE. ANY DISCREPANCY BETWEEN ARCHITECT'S DRAWINGS, ENGINEERS DRAWINGS AND THE BILLS OF QUANTITIES ARE TO BE CLARIFIED WITH THE ARCHITECT. ALL PRODUCT SPECIFICATION CODES ARE TO BE CHECKED WITH THE SUPPLIER PRIOR TO THE ORDERING AND BUILDING IN OF MATERIAL. ALL STRUCTURE TO BE CHECKED BY THE ENGINEER.

NO.	DATE	AMENDMENT	D.P.N.

Copyright vests in the Department of Public Works

as-built drawings


Certified as-built drawings as per Centralised Drawing Archive AS-BUILT DRAWING REQUIREMENTS

name: C.D.H.SPARKS

date: \_\_\_\_\_

professional registration no.: 4661

cad file name: AMAFA BLOCK A.dwg page type: A 1

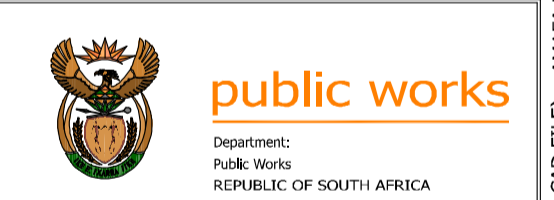

ARCHITECT  
 NEWCASTLE MAGISTRATES COURT:  
 UPGRADE, RENOVATION AND EXTENSION  
 OF CURRENT BUILDINGS  
 NEWCASTLE, Erf 16957,  
 33 & 35 MURCHISON STREET.  
 WCS number: 45965  
 BLOCK A:  
 SECTION F-F.  
 SECTION G-G.

ref.no		checked	CDHS
scale	AS SHOWN	drawn	AM
date	AUGUST 2021	checked	CDHS
departmental drawing number			
drawing number			L12/03/A/16 (WD)

BLOCK A: SECTION FF & GG (IN CAD FILE) AMAFA: BLOCK A.dwg printed on 05 Jul 2023 at 15:15:55