


1:100 BLOCK A: SOUTH ELEVATION.

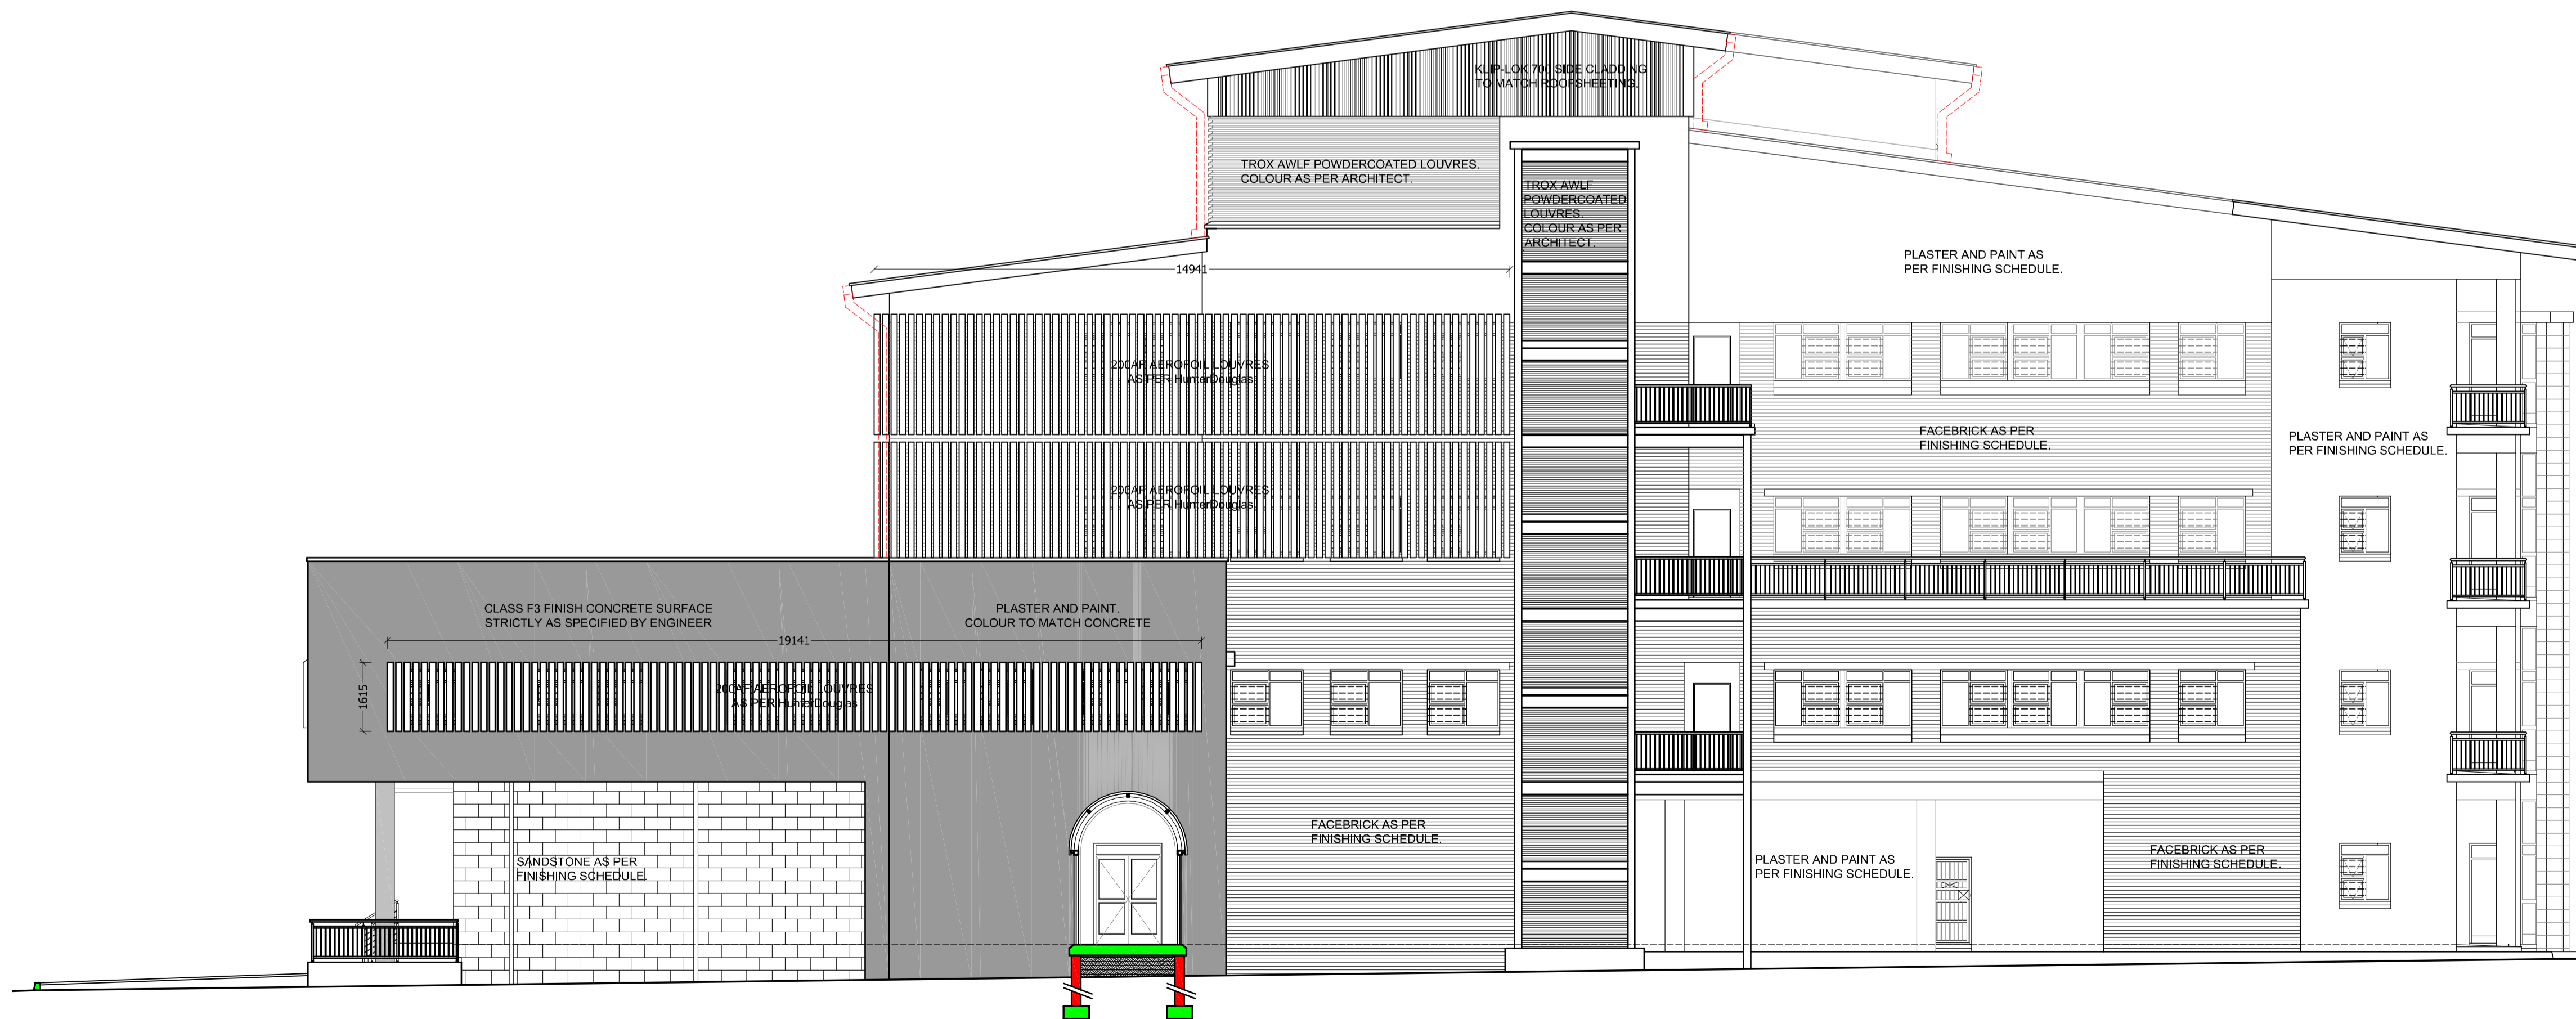

1:100 BLOCK A: WEST ELEVATION.

ALL DIMENSIONS ARE TO BE CHECKED ON SITE PRIOR TO CONSTRUCTION TAKING PLACE. ANY DISCREPANCY BETWEEN ARCHITECTS DRAWINGS, ENGINEERS DRAWINGS AND THE BILLS OF QUANTITIES ARE TO BE CLARIFIED WITH THE ARCHITECT. ALL PRODUCT SPECIFICATION CODES ARE TO BE CHECKED WITH THE SUPPLIER PRIOR TO THE ORDERING AND BUILDING IN OF MATERIAL. ALL STRUCTURE TO BE CHECKED BY THE ENGINEER.

NO.	DATE	AMENDMENT	D.P.W.

Copyright vests in the Department of Public Works

as-built drawings

certified as-built drawings as per Centralised Drawing Archive AS-BUILT DRAWING REQUIREMENTS

name: C.D.H.SPARKS

date: \_\_\_\_\_

professional registration no.: 4661

cat file name: AMAFA BLOCK A.dwg page 1006 A 1



ARCHITECT

NEWCASTLE MAGISTRATES COURT: UPGRADE, RENOVATION AND EXTENSION OF CURRENT BUILDINGS NEWCASTLE, Erf 16957, 33 & 35 MURCHISON STREET.

WCS number: 45965

BLOCK A: SOUTH ELEVATION. WEST ELEVATION.

ref.no	designed	CDHS
scale	drawn	AM
date	checked	CDHS
departmental drawing number		
drawing number	L12/03/A/17 (WD)	

BLOCK A: SOUTH & WEST ELEVATION (1/1 CAD FILE) AMAFA BLOCK A.dwg printed on 05 Jul 2023 at 15:17:14