


SHEET	1/1	COPY	1
<b>CITY OF DURBAN</b>			
PLAN No. <u>26/12/77</u>			
APPROVED			
			DATE <u>14 FEB 1978</u>
D. C. MACLEOD		CITY ENGINEER	
		PER <i>[Signature]</i>	

**ORIGINAL**  
**AS BUILT**  
3-5-78  
*[Signature]*

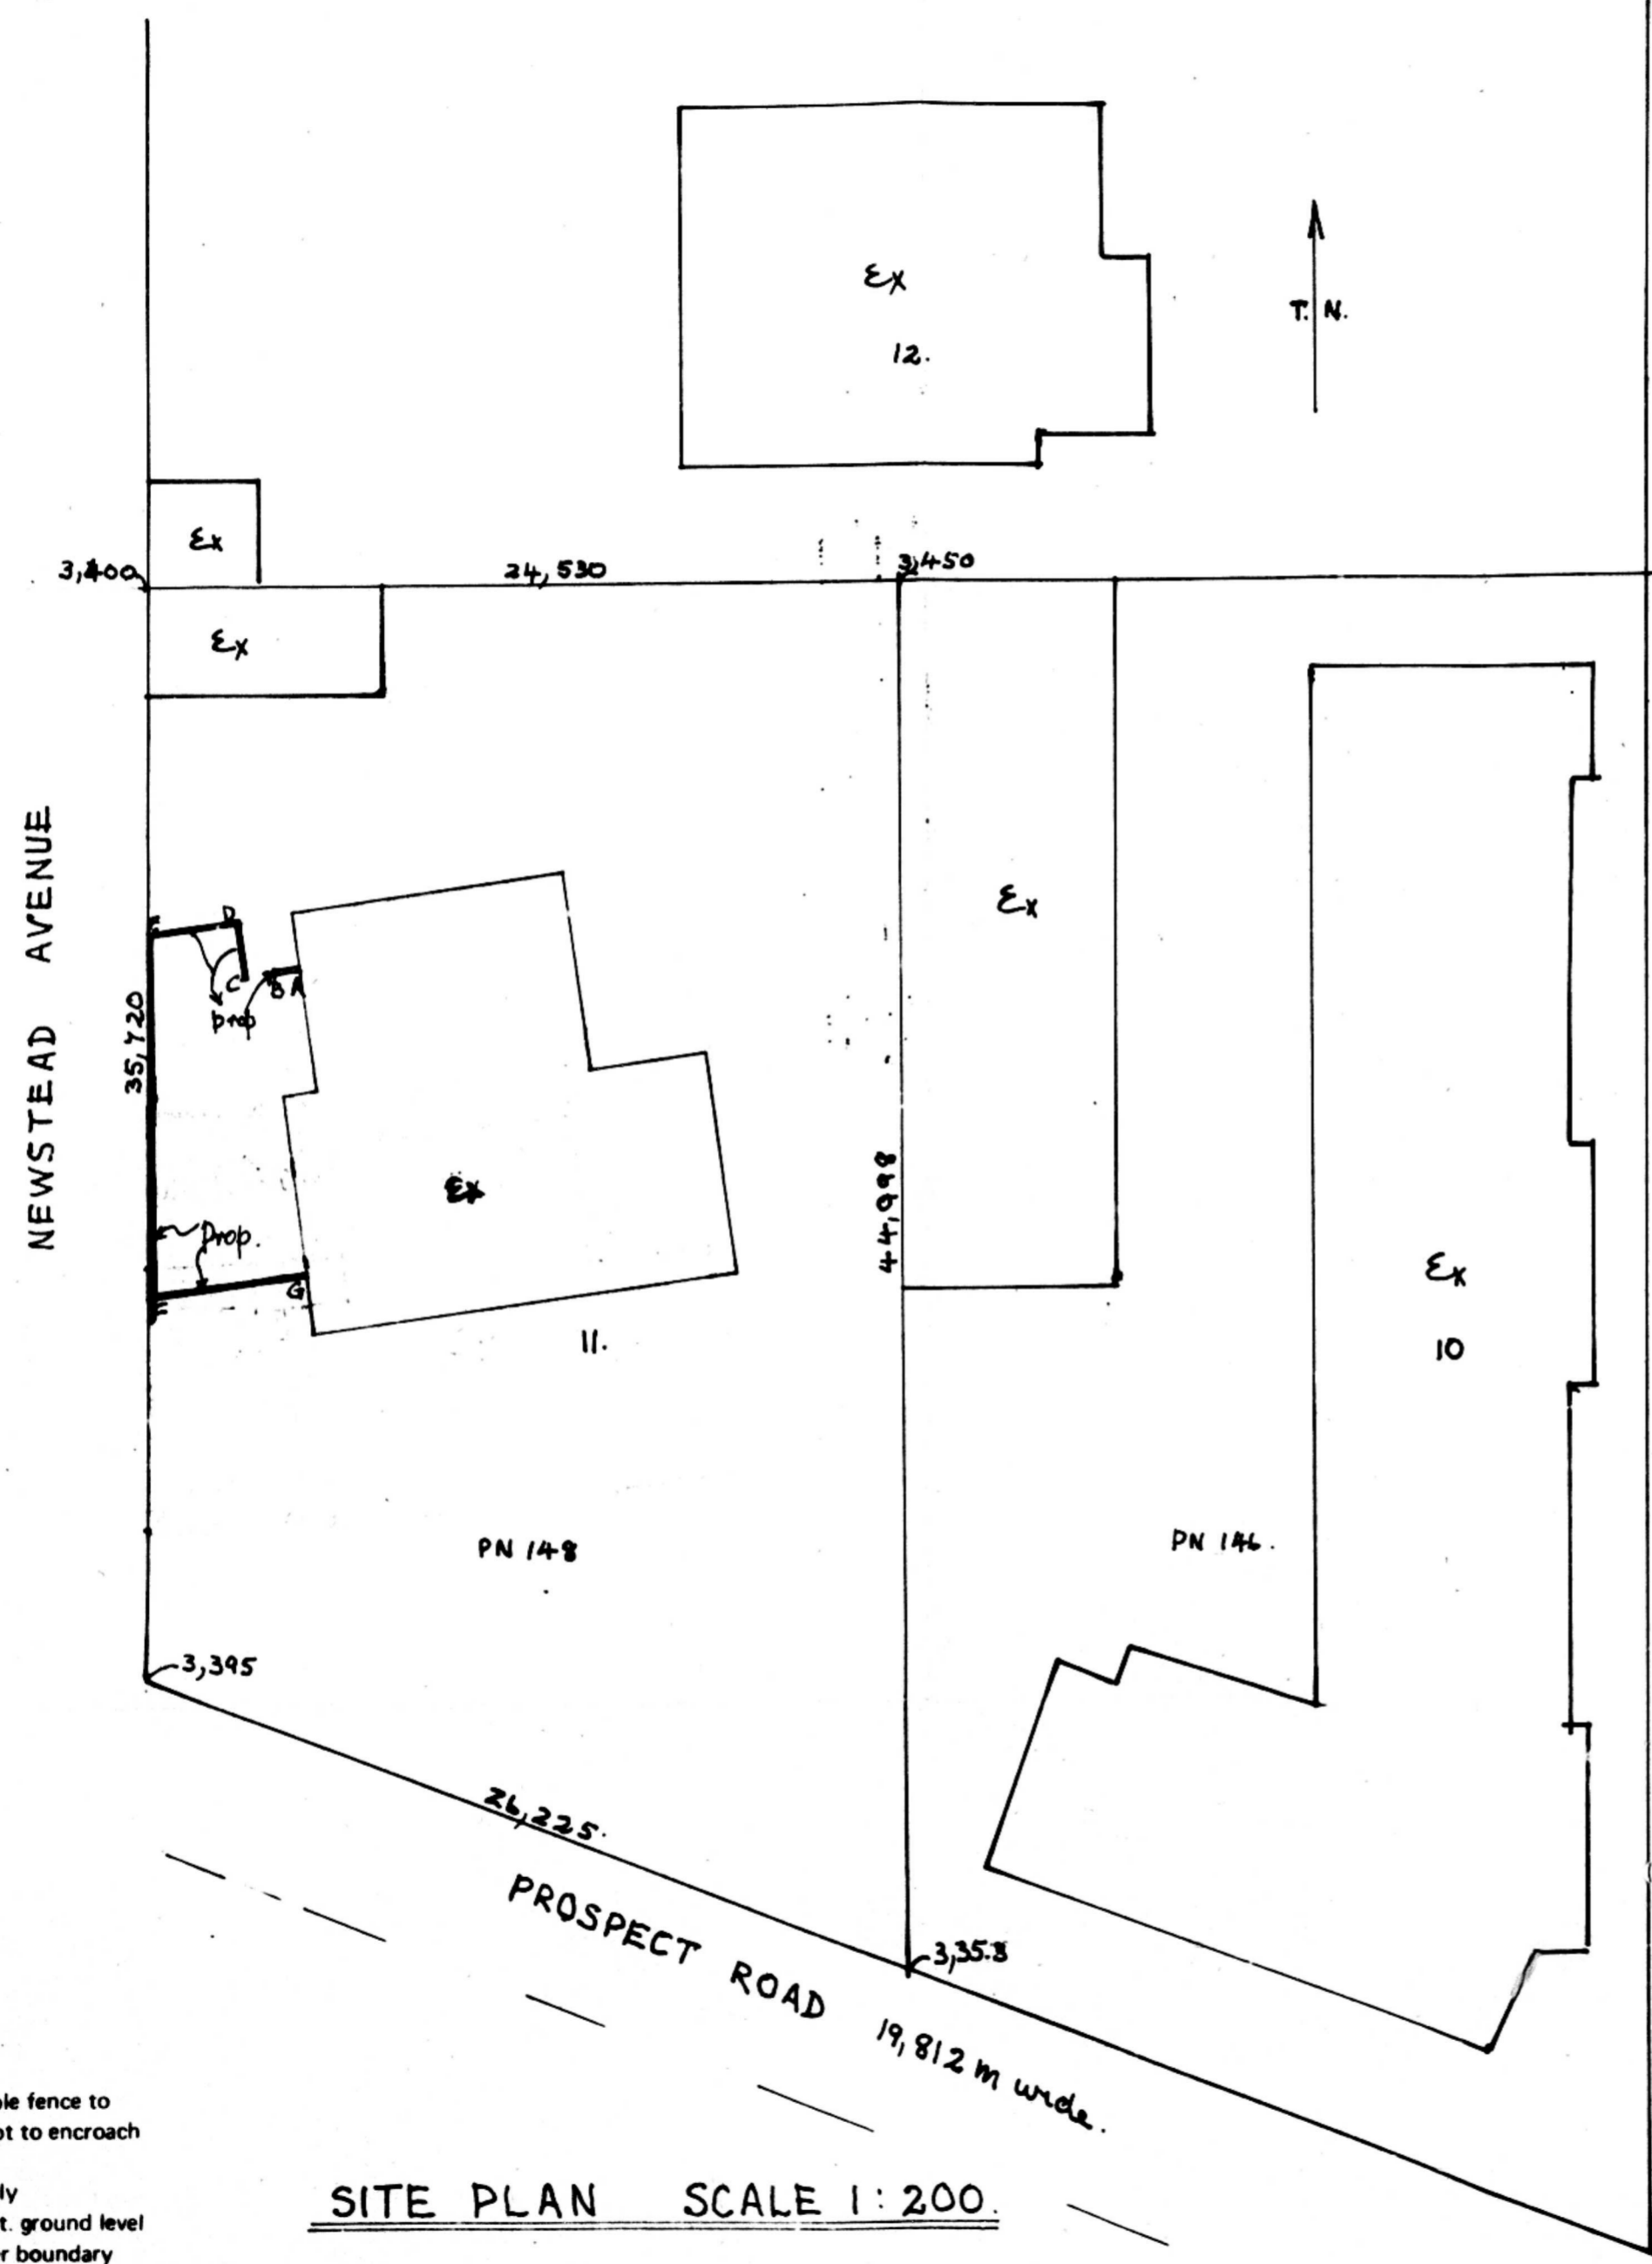

*LOUVER*

TYPE	LENGTH	HEIGHT
AB D22	965	X <del>2.134</del> (1.40) 2.000
BC	864 mm opening for gate.	
CD D22	1,829	X <del>2.134</del> 2.000
DE D22	3,586	X <del>2.134</del> 2.000
EF D22	13,918	X <del>2.134</del> 2.000
FG D22	5,283	X <del>2.134</del> 2.000

NOTE. HEIGHT OF WALLS NOT EXCEED 2. METRES. 27.1.78 PA.

**PRECAST CONCRETE GARDEN WALLS ON BOUNDARIES**  
BOUNDARY BEACONS TO BE EXPOSED AND POINTED OUT TO THE DISTRICT BUILDING INSPECTOR BY THE APPLICANT BEFORE ERECTION OF THE GARDEN WALLS ARE COMMENCED. THE BEACONS SHALL REMAIN EXPOSED AFTER COMPLETION OF THE WORK FOR A FINAL INSPECTION.


- NOTES:
- Fairface to Face Street
  - Servitudes. Where applicable fence to span serv. (bridged) and not to encroach more than 380 mm.
  - Use figured dimensions only
  - Fence to be erected on Nat. ground level
  - Fence not to encroach over boundary
  - P.C. Fence not to retain
  - Entrance to be 300 mm. above edge of existing road directly opposite proposed entrance

**SITE PLAN SCALE 1:200.**

DES. 11 OF 3A, 4A OF E UMBILO.  
RATE NO 135440/19.

**WATCRETE FENCING LTD.**  
290 UMBILO ROAD, DURBAN. PHONE 35-4347 35-4389

project: PROPOSED PRECAST CONC. FENCE FOR MR. M.J. AUBERTY AT 148 PROSPECT RD. UMBILO.

date	10:12:77		drawn by	<i>R. Hancock</i>
scale	1:200		No. 173.	