


FIRST STOREY SCALE 1:100

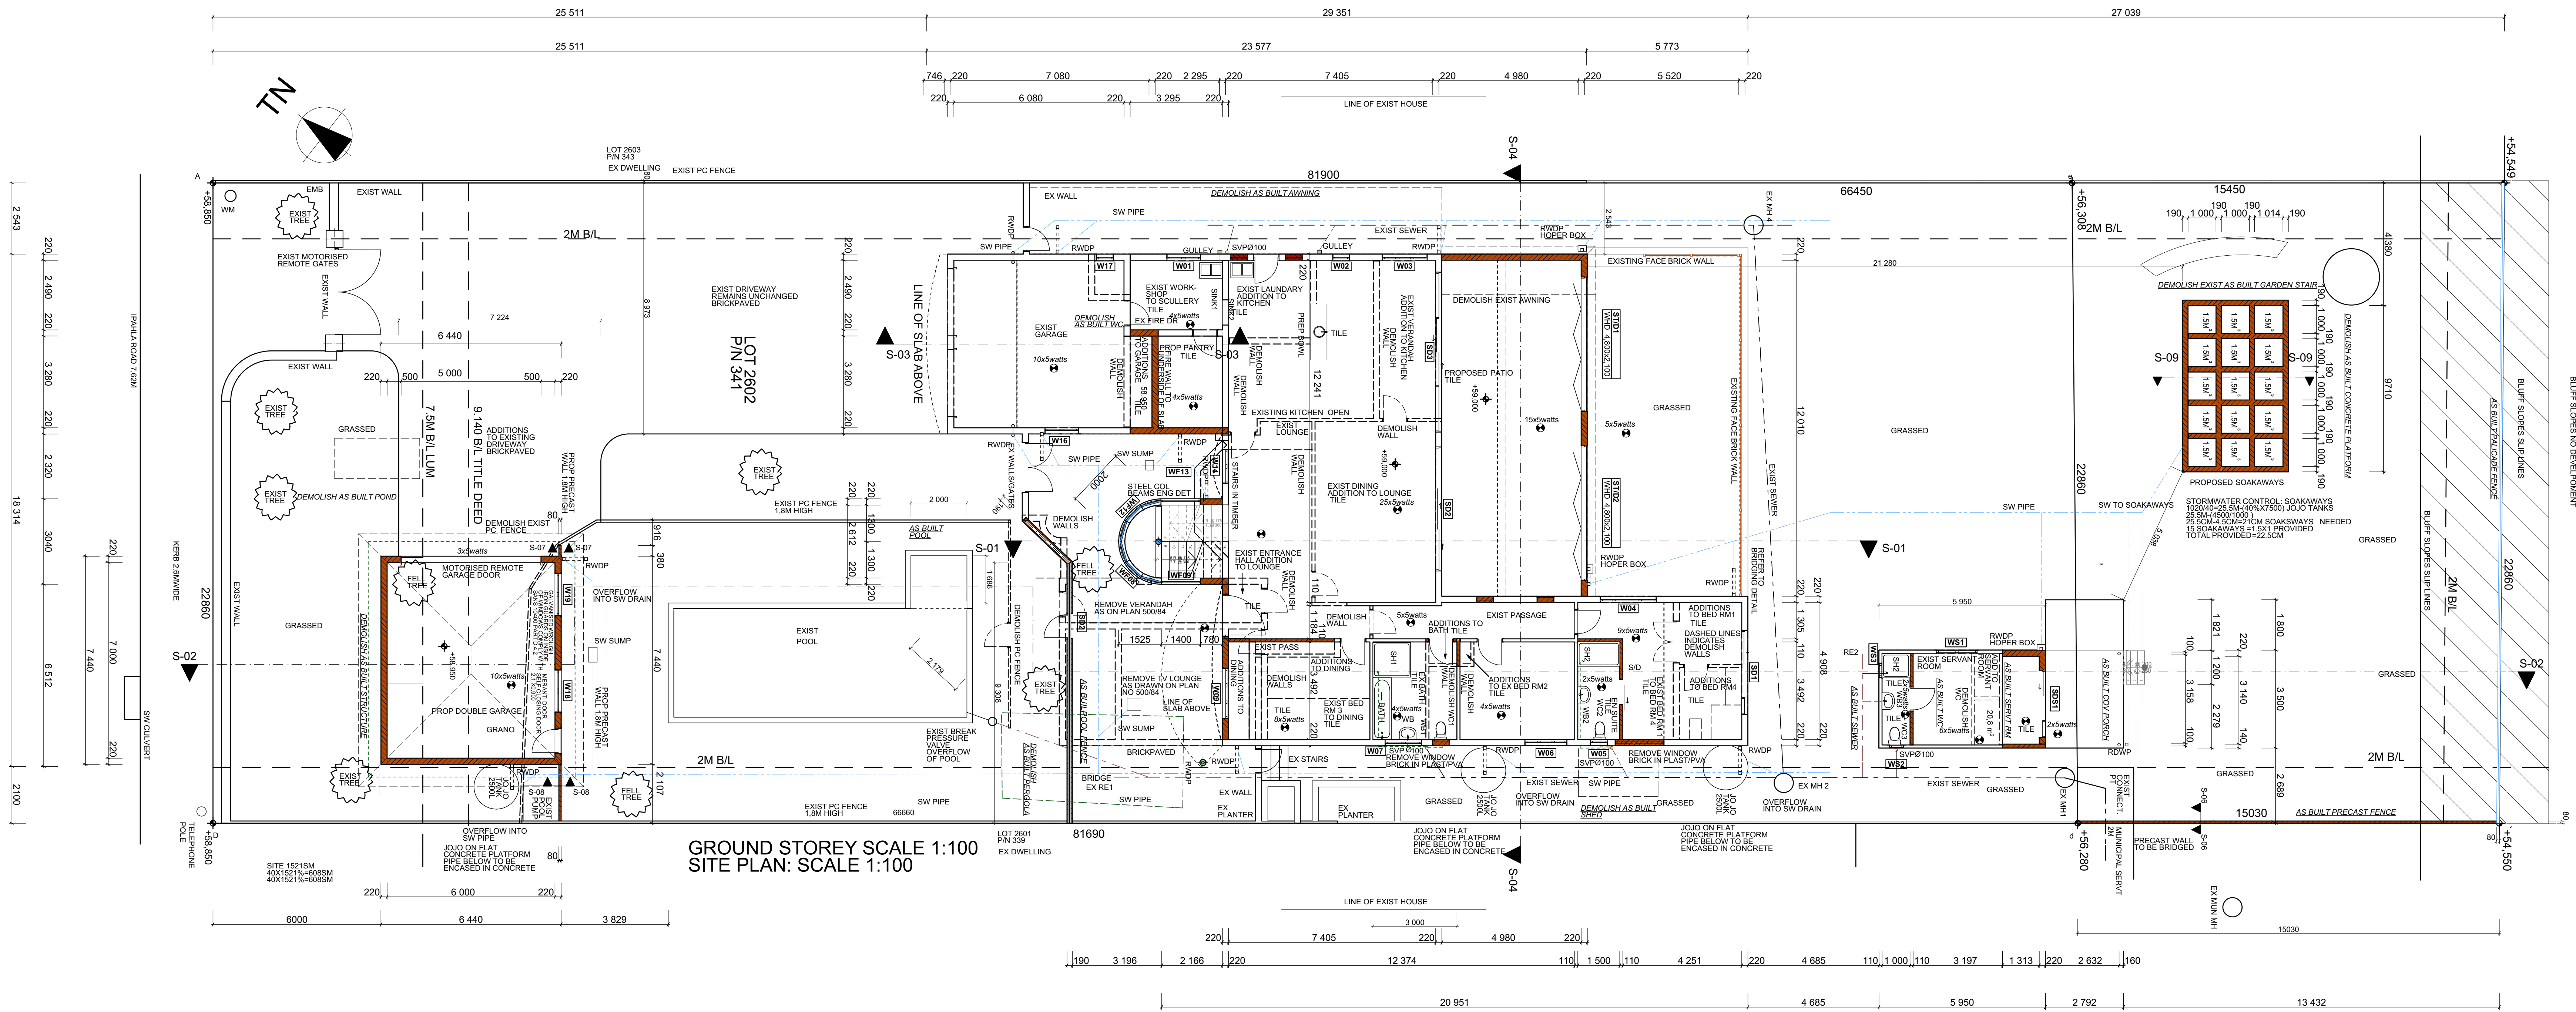

GROUND STOREY SCALE 1:100  
SITE PLAN: SCALE 1:100

SCHEDULE OF AREA IN SM  
AREA OF SITE=1869 SM  
ALLOWED FAR=747.6 SM  
ALLOWED COV= 747.6SM  
EXIST FAR=222.16SM  
EXIST COV=264.14SM  
PROPOSED FAR=95.63SM  
PROP COV=190.96 SM  
TOTAL FAR=317.79SM  
TOTAL COV=455.10 SM  
TOTAL AREA SUB-501.06M

"AS BUILT"

CATEGORY: H4

OWNERS SIGNATURE

OWNER CONTACT: 0833868335

AUTHORS SIGNATURE

PROPOSED ADDITIONS AND ALTERATIONS  
BOUNDARY WALL ON ERF 2602  
AMANZIMTOTI AT 341 IPHOLA ROAD  
ATHLONE PARK  
FOR:

GRAMANI FAMILY TRUST

REGISTRATION NUMBER: IT 128804N

DRAWN :  
DESIGN ZONE  
G.S.NACKER  
38 MERMAID AVENUE  
SEA TIDES  
TONGAAT  
4399

CONTACT: CELL 0837921721  
gn.designzone@gmail.com  
SACAP T0070