




**GROUND STOREY PLAN**

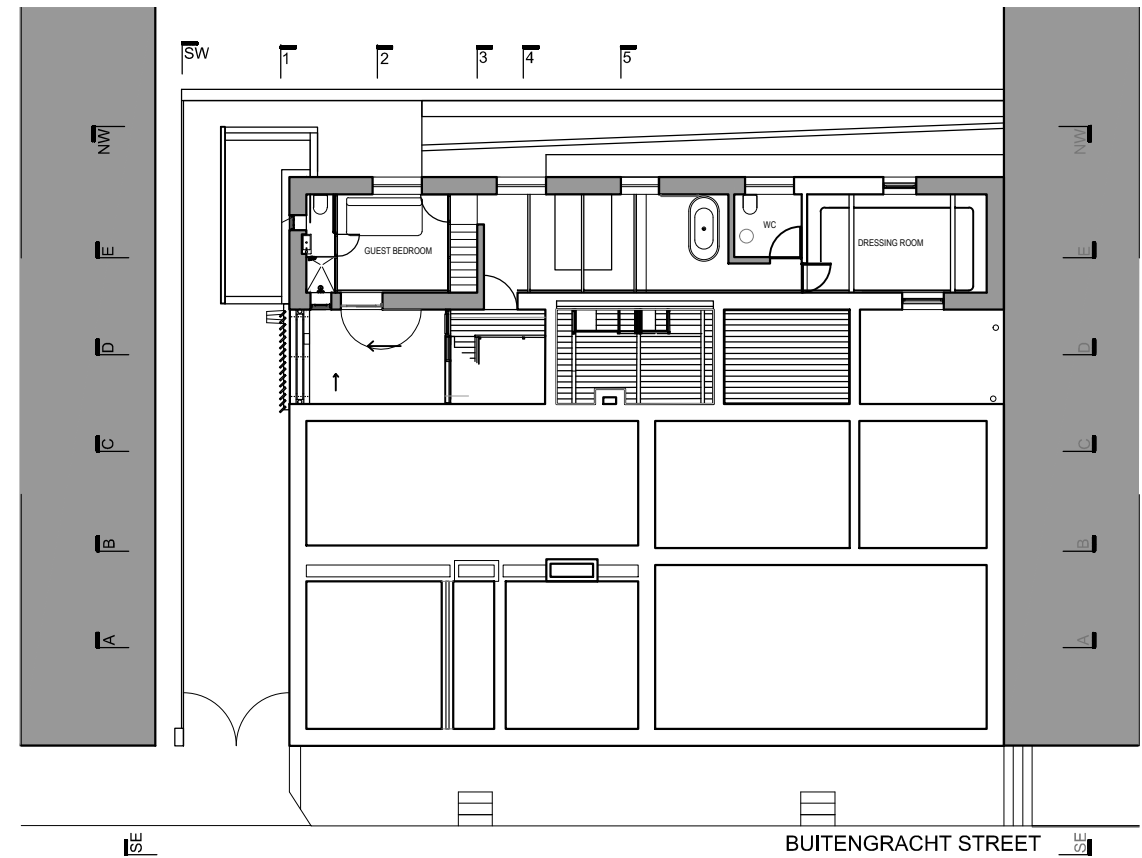


**GROUND STOREY MEZZANINE PLAN**

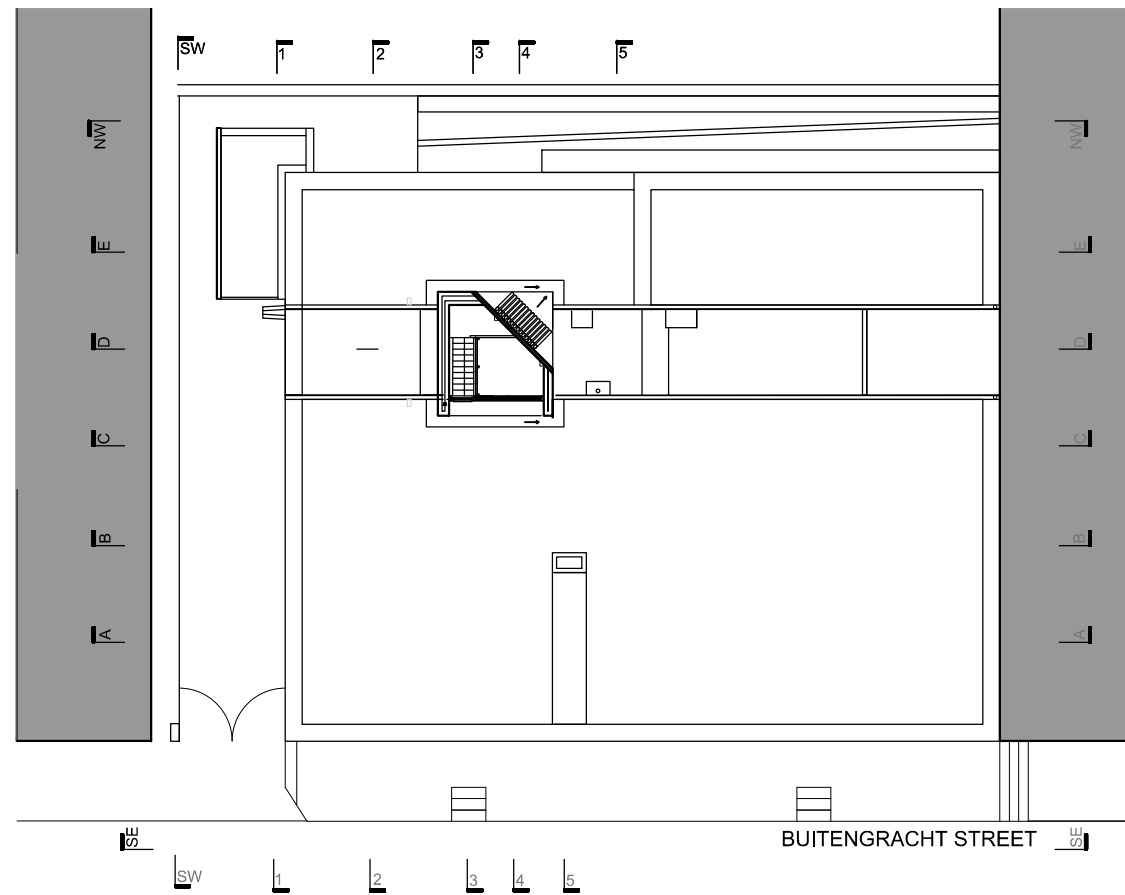

**TOWER PLAN**

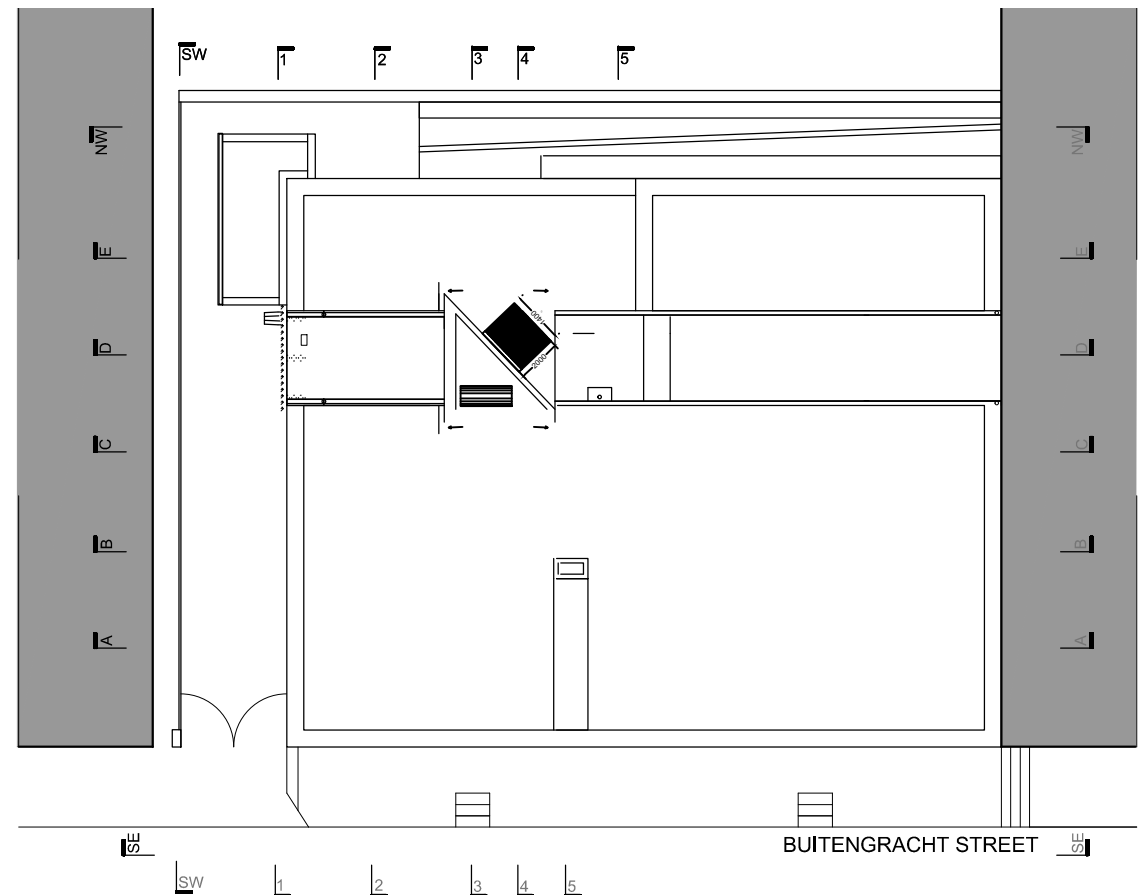


**ROOF PLAN**

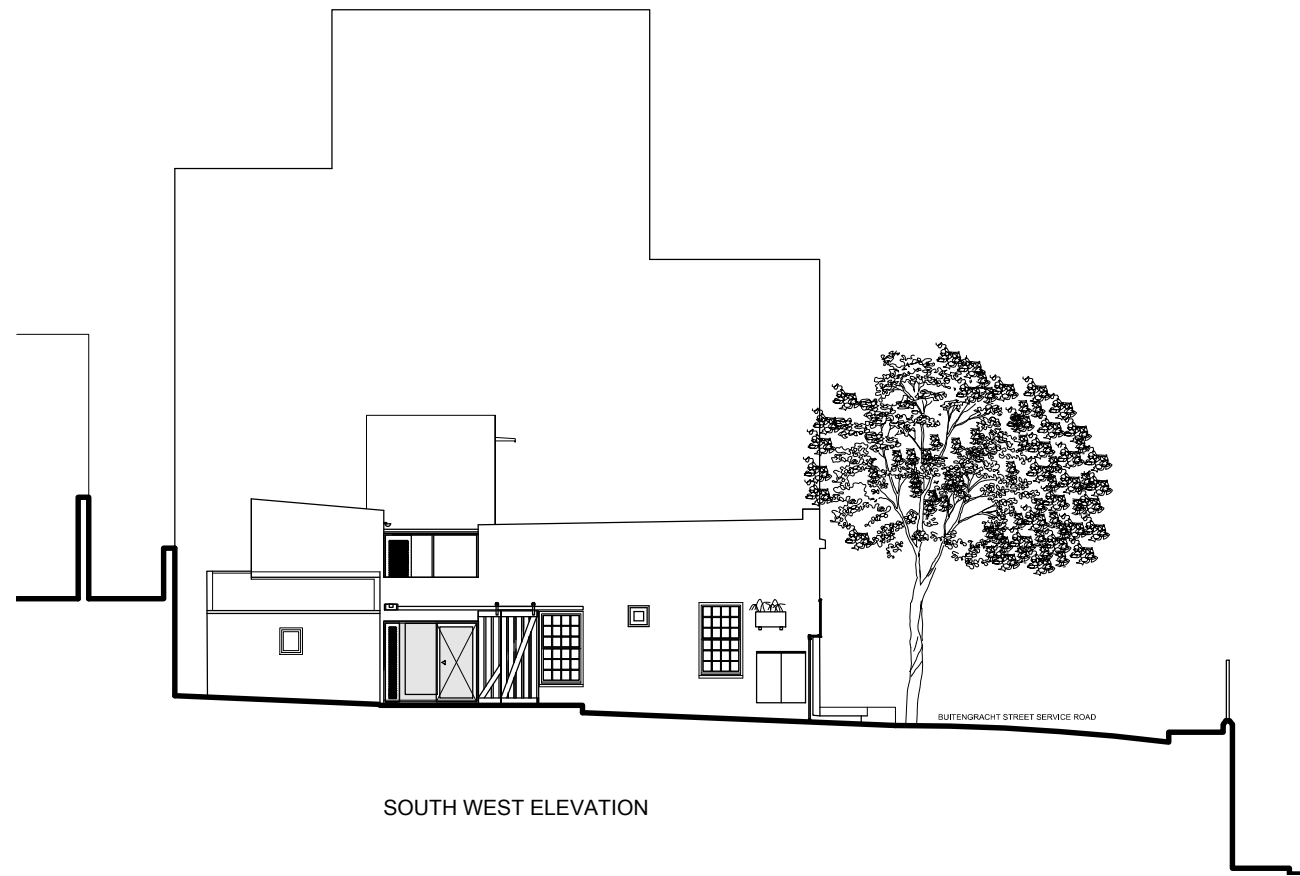

SOUTH WEST ELEVATION



212A  
SOUTH EAST BUITENGRACHT ELEVATION


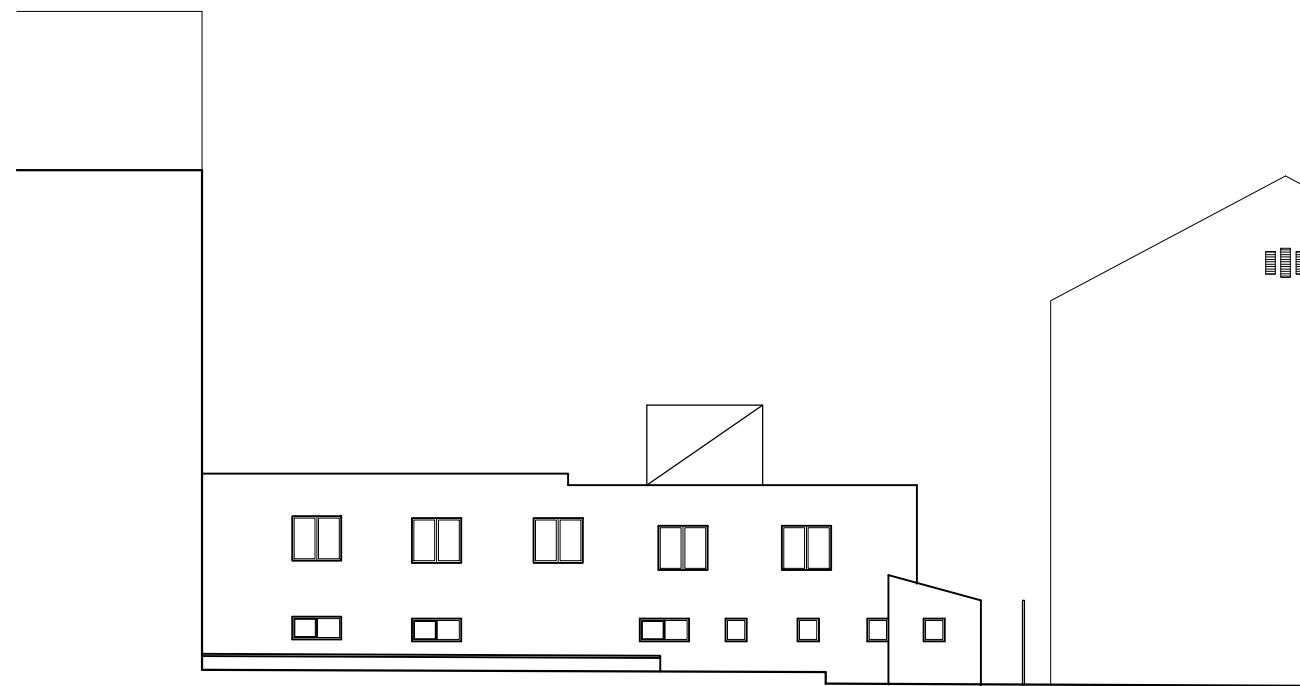


NORTH WEST ELEVATION

**AS-BUILT ELEVATIONS OF THE EXISTING - 212A BUITENGRACHT STREET. KFA**



AS-BUILT SECTIONS OF THE EXISTING - 212A BUITENGRACHT STREET. KFA

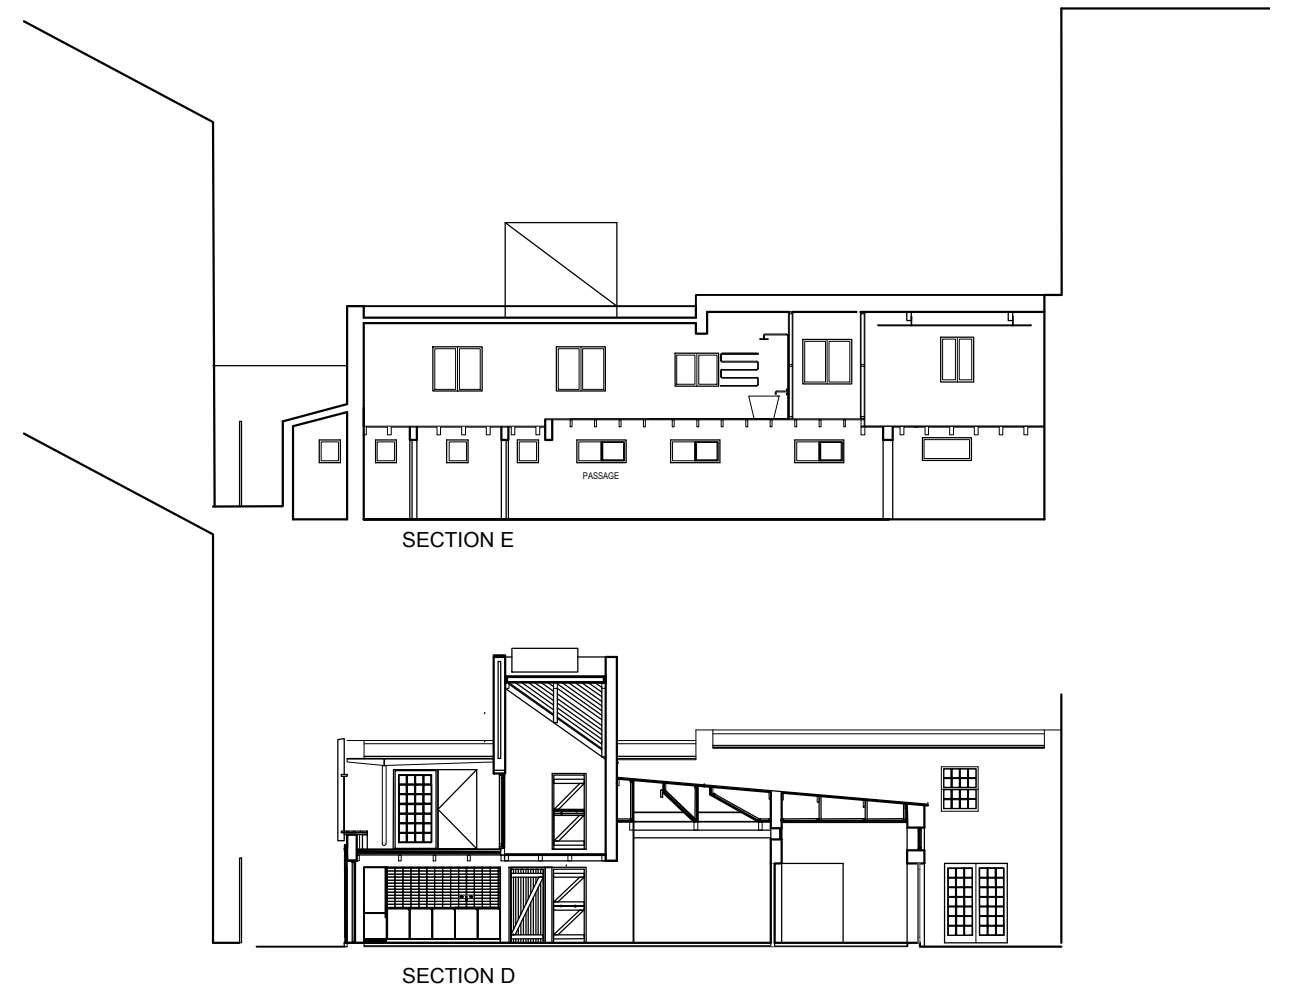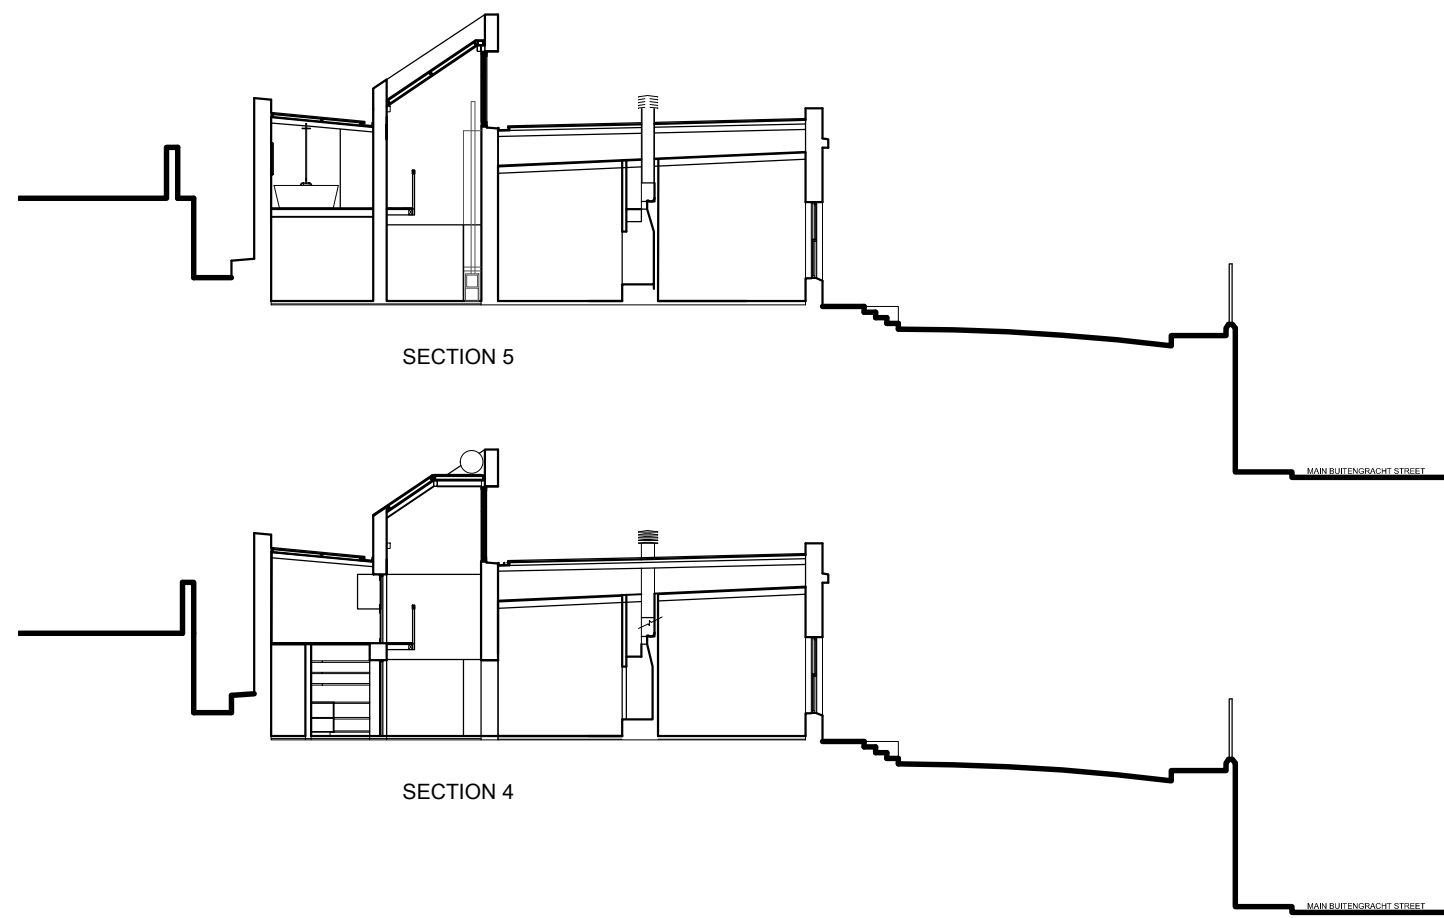

AS-BUILT SECTIONS OF THE EXISTING - 212A BUITENGRACHT STREET. KFA