

806 S. Douglas Road  
Suite 400  
Coral Gables, FL 33134  
www.obmi.com

T 305 537.7100  
F 305 537.7101  
Lic. # AA0003112

Antigua  
Bermuda  
British Virgin Islands  
Cayman Islands  
Miami  
Trinidad & Tobago  
Lic. # AA0003112

No.	Description	Date
1.	PROGRESS SCHEMATIC	5/22/2017
2	PROGRESS D.D	6/30/2017
RA	PROGRESS C.D.	7/29/2017
R0	C.D. ISSUE TO SITE	09/02/2017
R1	C.D. ISSUE TO SITE	09/18/2017
R2	C.D. ISSUE TO SITE	10/18/2017
R3	AS-BUILT DRAWING	31/07/2018

CONSULTANTS:


PROJECT:

**PROJECT ZEBRA  
/ MAIN LODGE  
ML-B4**

OWNER:

**MAIN LODGE  
OVERALL SITE  
PLAN**

DRAWN BY:	PROJECT #:
---	MI15026.102
CHECKED BY:	SCALE:
---	1: 1250
DRAWING #:	
<b>A-M00-001_R3</b>	

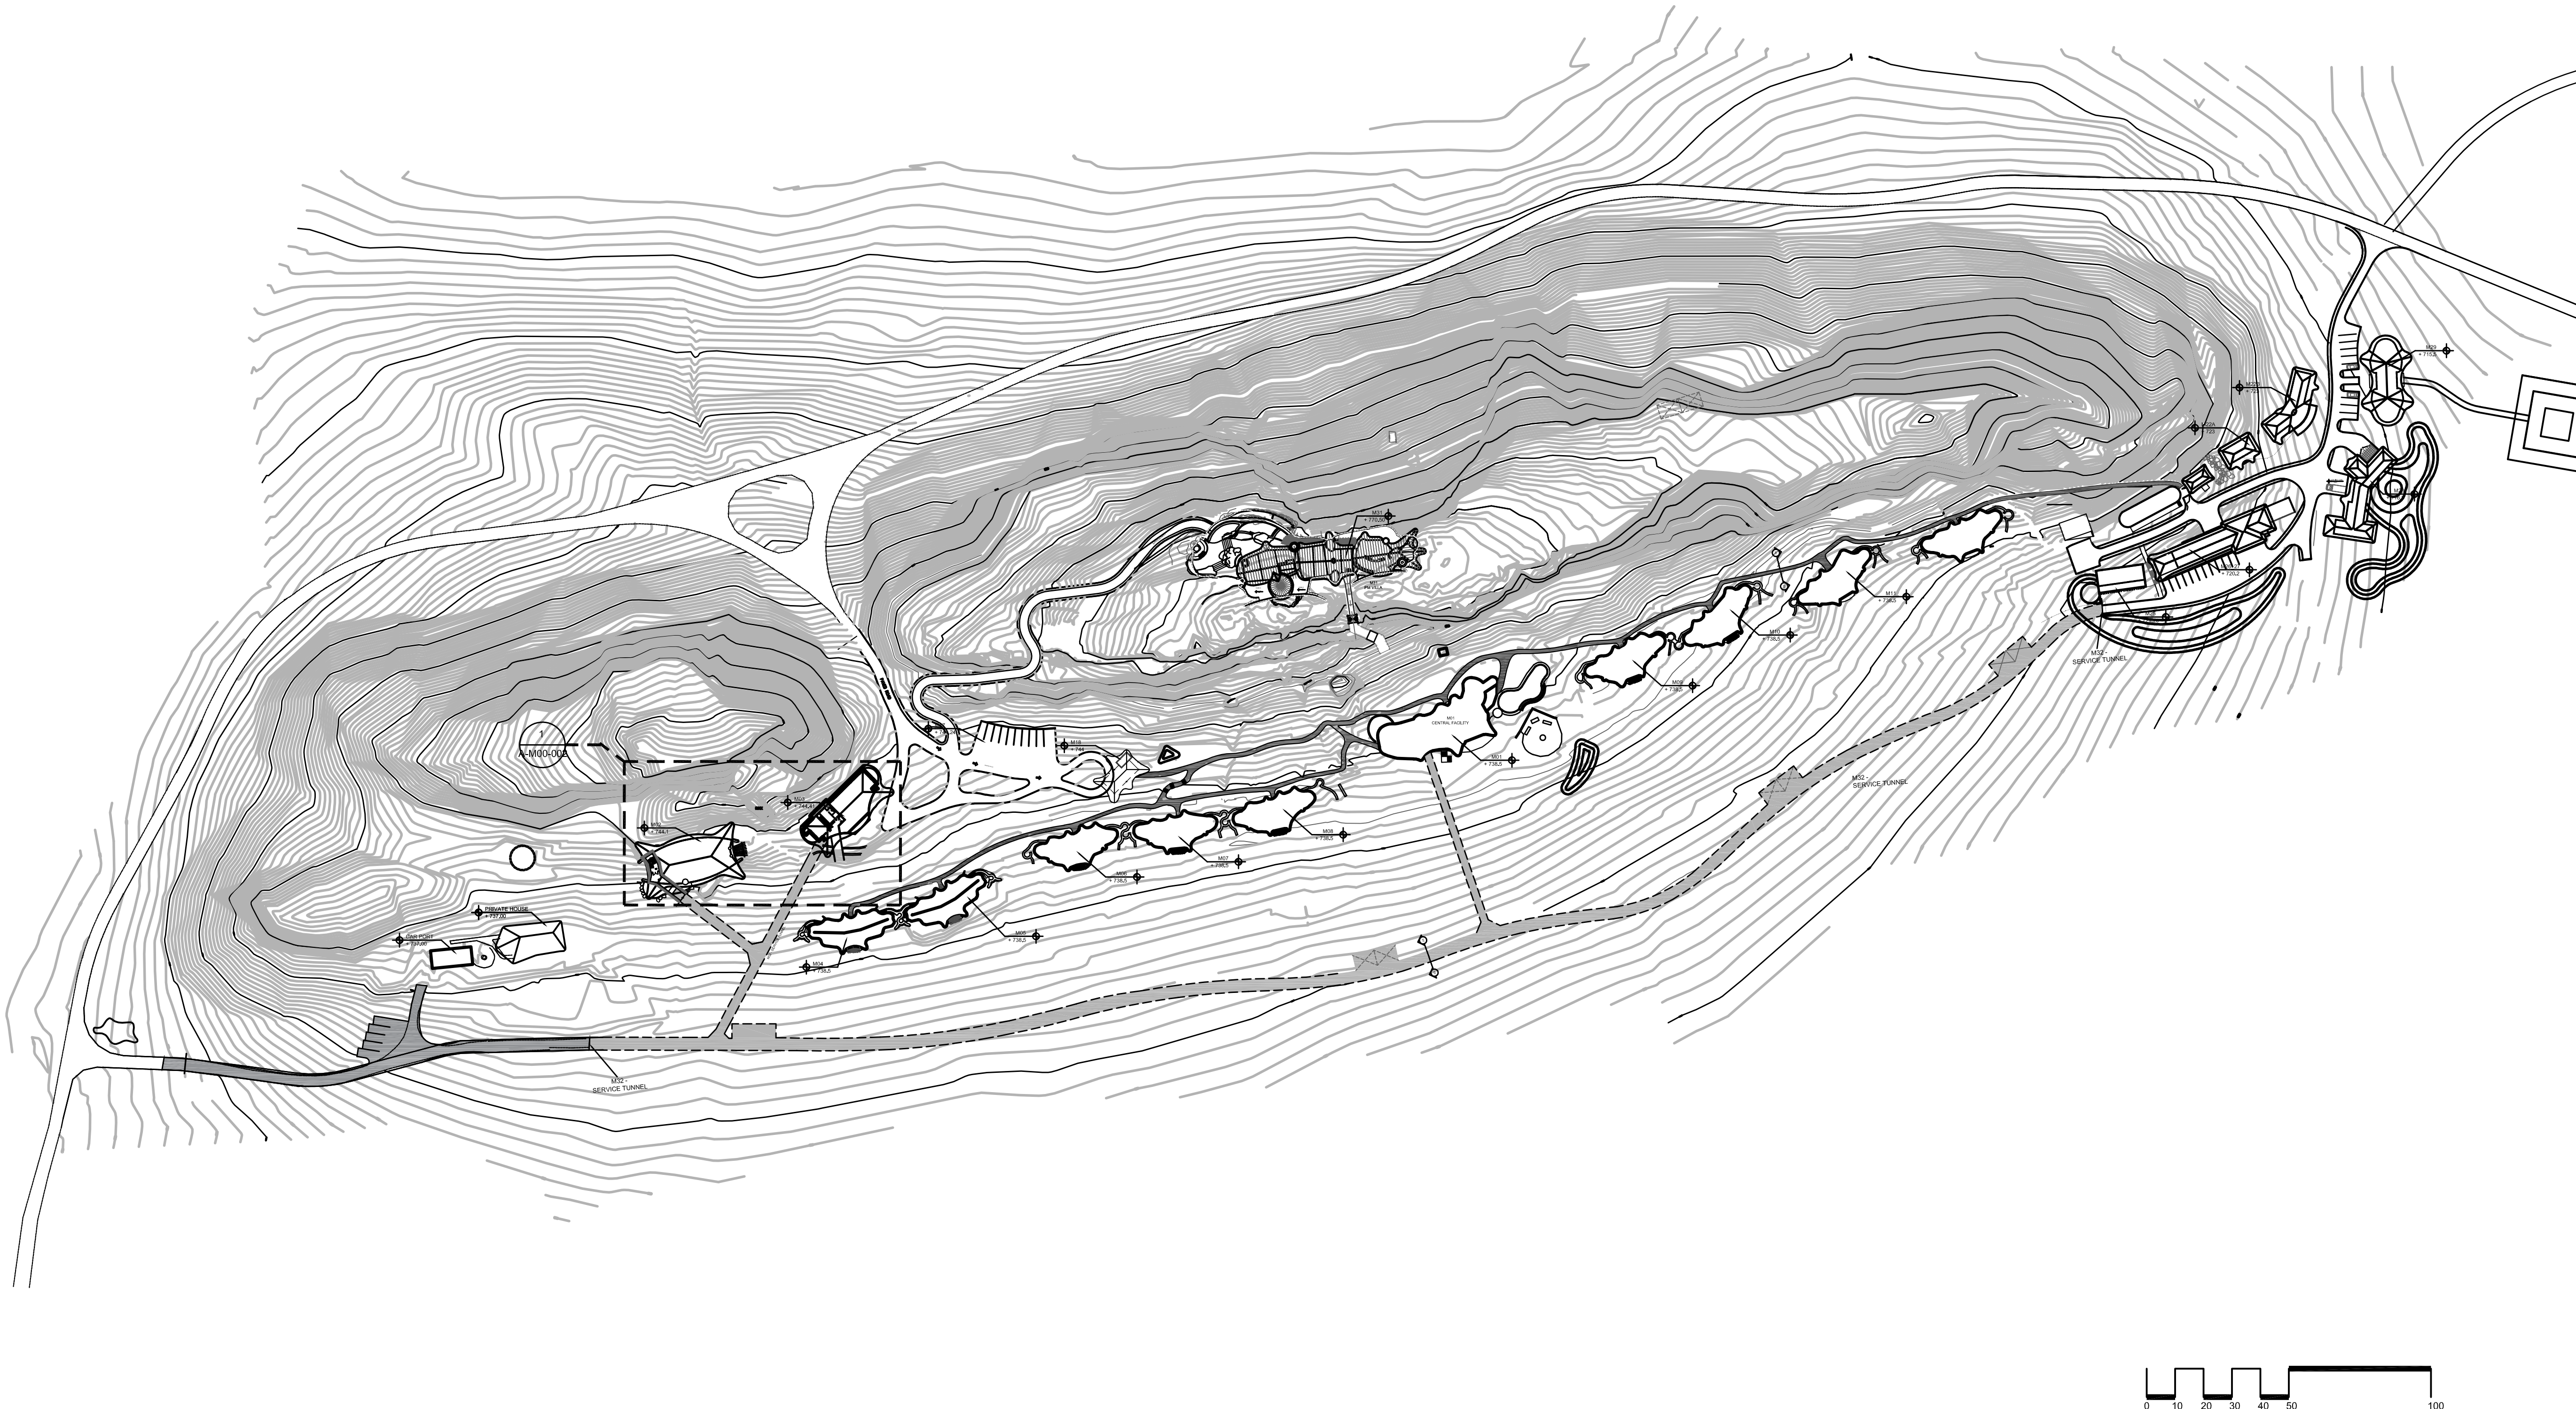

**1** OVERALL SITE PLAN  
A-M00-001 1: 1250

**AS-BUILT DRAWING**  
For OBMI / OSGLO For Client  
Date Date

Dec 14, 2017 - 8:43am