
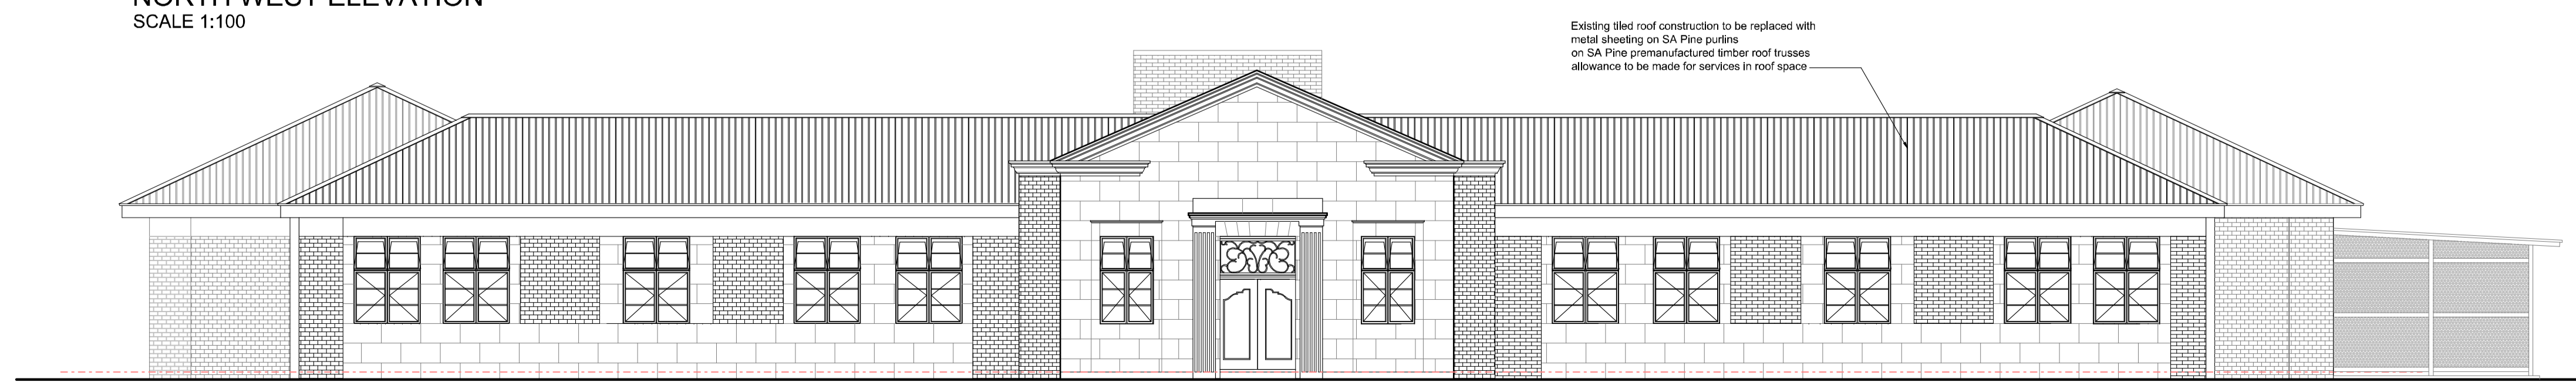
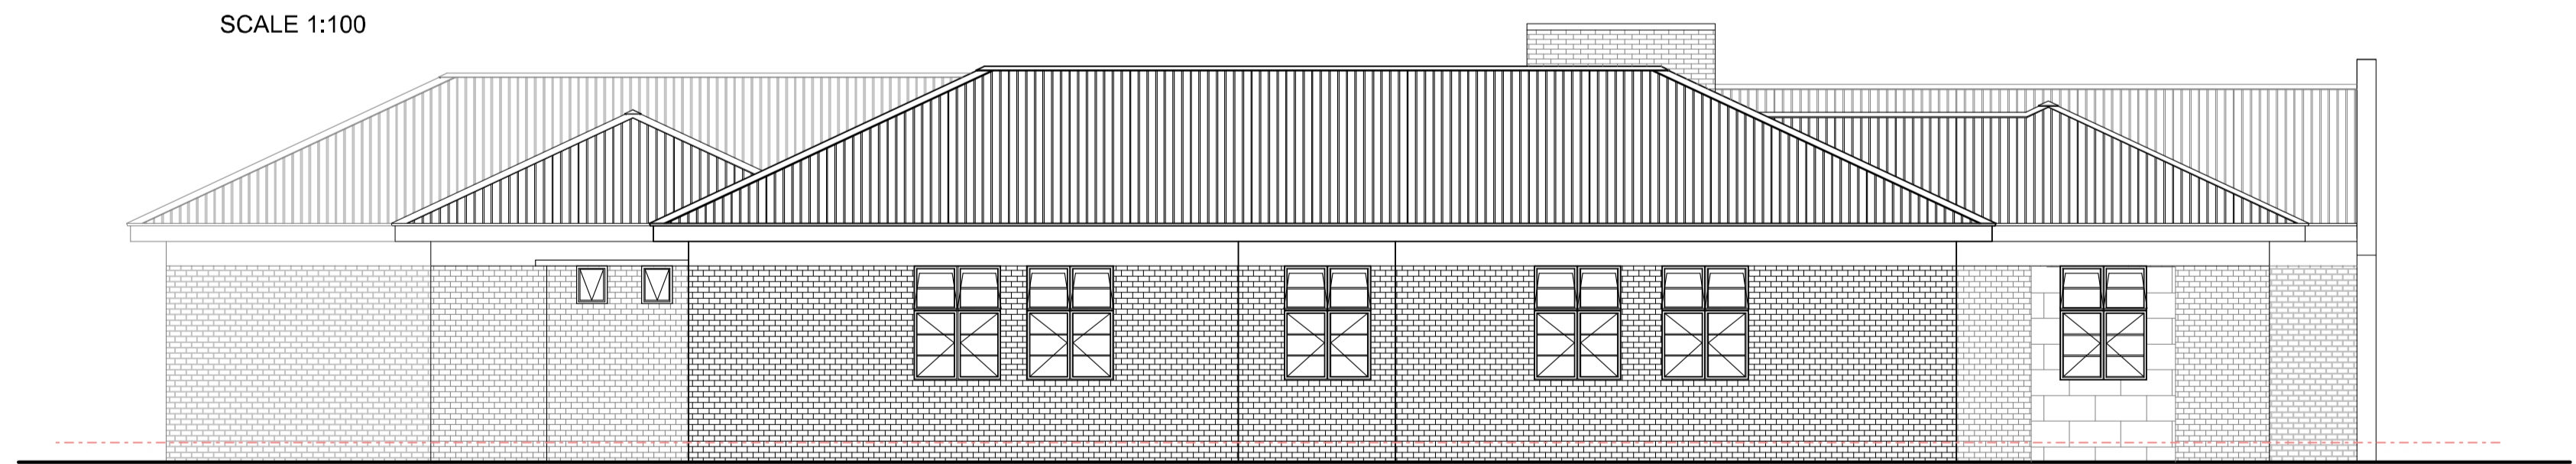
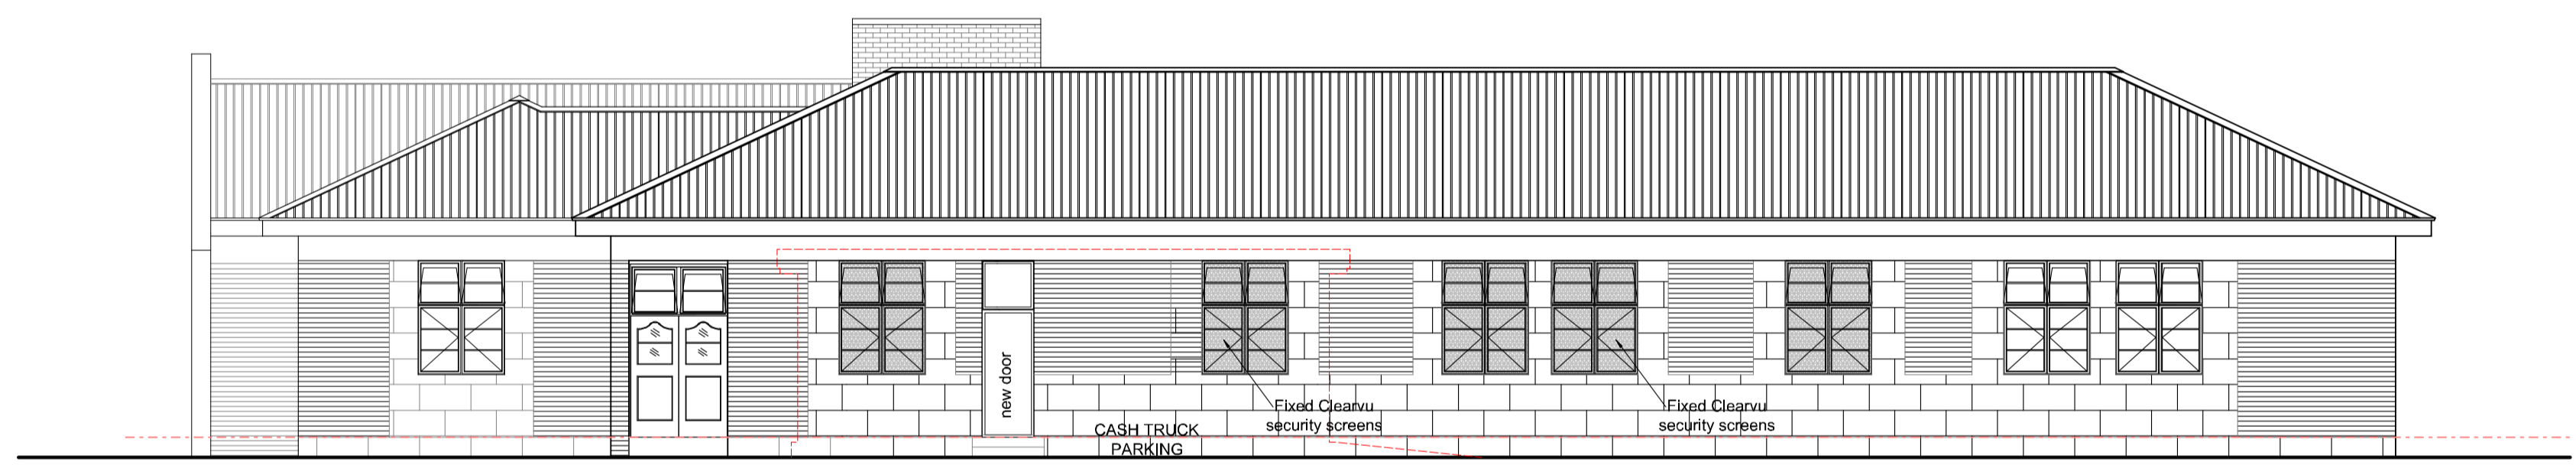
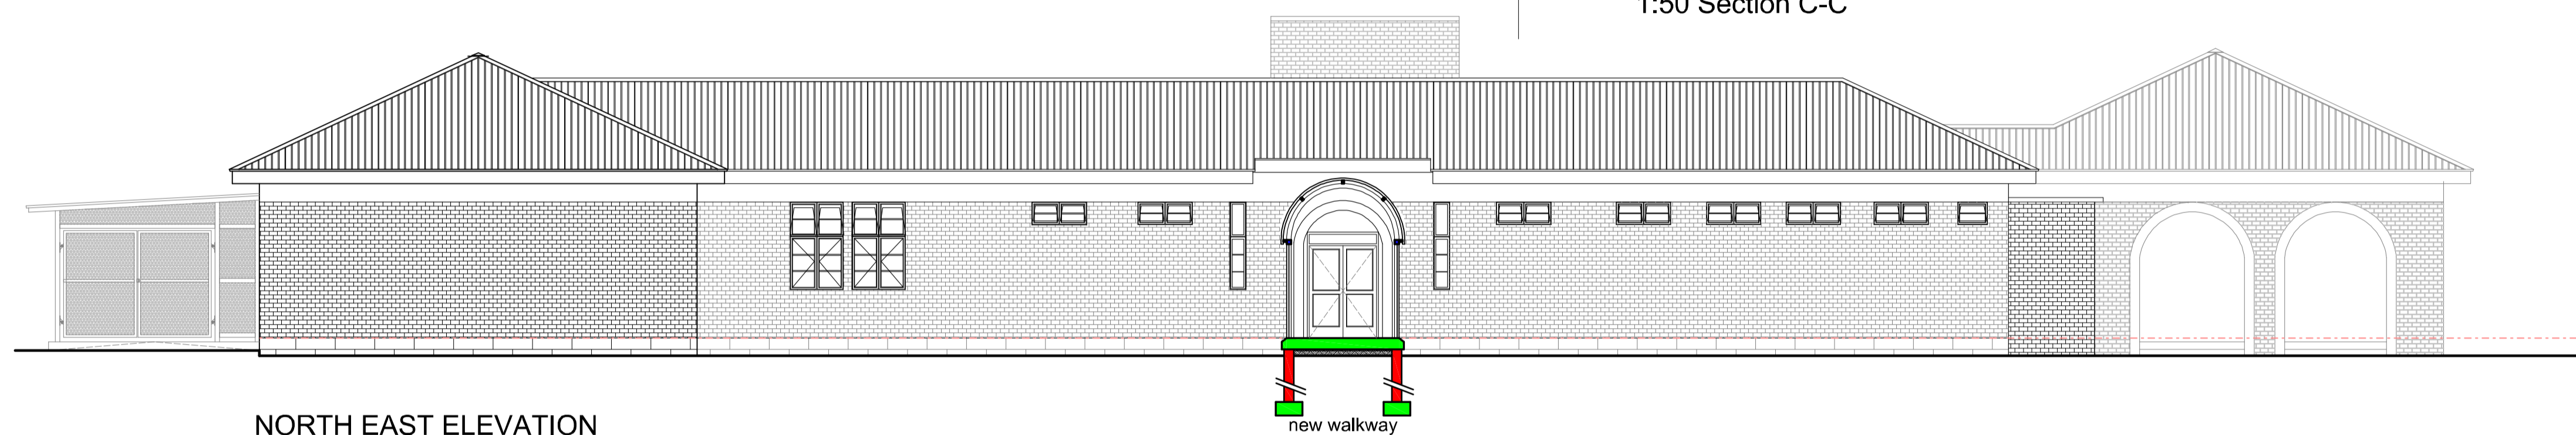


ALL DIMENSIONS ARE TO BE CHECKED ON SITE PRIOR TO CONSTRUCTION TAKING PLACE. ANY DISCREPANCY BETWEEN ARCHITECTS DRAWINGS, ENGINEERS DRAWINGS AND THE BILLS OF QUANTITIES ARE TO BE CLARIFIED WITH THE ARCHITECT. ALL PRODUCT SPECIFICATION CODES ARE TO BE CHECKED WITH THE SUPPLIER PRIOR TO THE ORDERING AND BUILDING IN OF MATERIAL. ALL STRUCTURE TO BE CHECKED BY THE ENGINEER.

NO.	DATE	AMENDMENT	D.P.W.

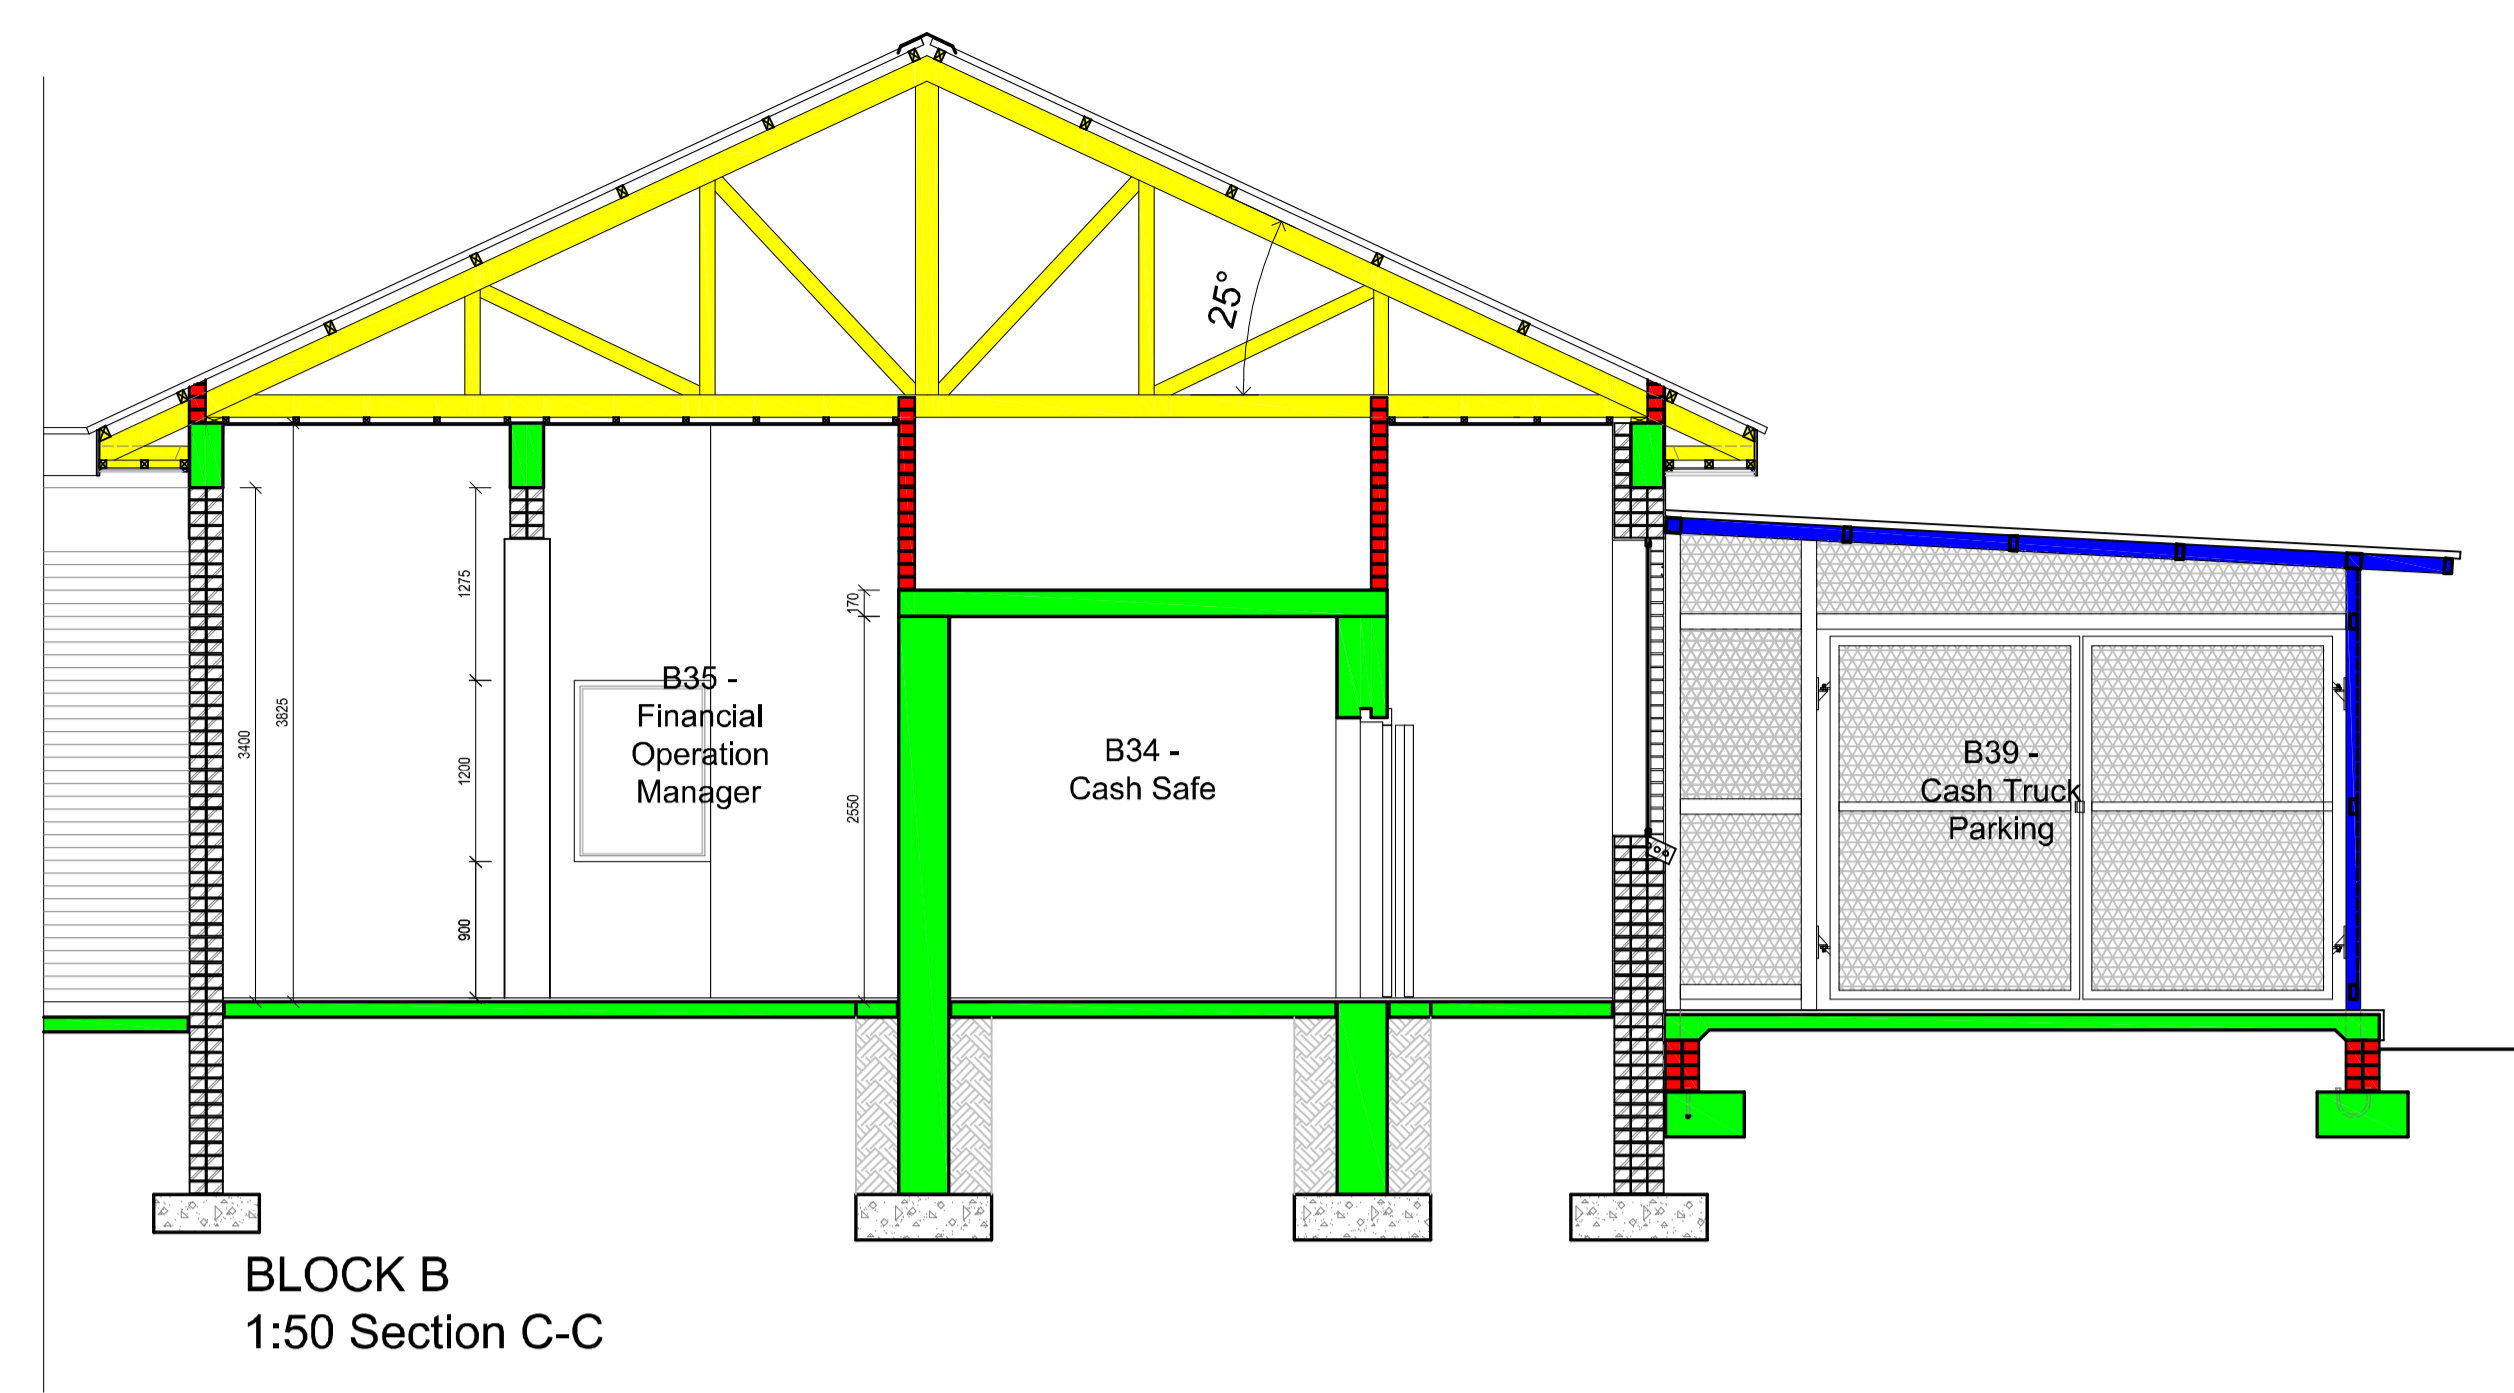


Copyright vests in the Department of Public Works

as-built drawings

certified as-built drawings as per Centralised Drawing Archive AS-BUILT DRAWING REQUIREMENTS

name: **C.D.H.SPARKS**
date: _____
professional registration no.: **4661**

sheet name: AMAFA Block B.dwg page type: **A 1**

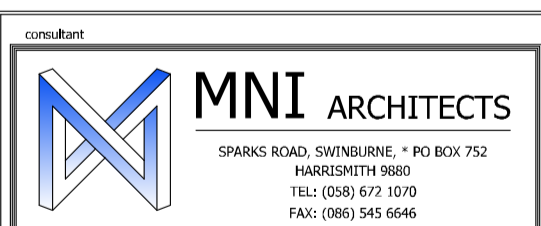

ARCHITECT

NEWCASTLE MAGISTRATES COURT:
UPGRADING, RENOVATION AND EXTENSION
OF CURRENT BUILDINGS
NEWCASTLE, Erf 16957,
33 & 35 MURCHISON STREET.

VCES number: **45965**

BLOCK B:
ELEVATIONS
SECTION C-C

scale	AS SHOWN	drawn	CIL
date	AUGUST 2021	checked	CDHS
departmental drawing number	-		
drawing number	L12/03/B/04 (WD)		

ELEVATIONS (IN CAD FILE) AMAFA Block B.dwg printed on 06 Jul 2023 at 15:37:15