


FIRST STOREY
1 : 100

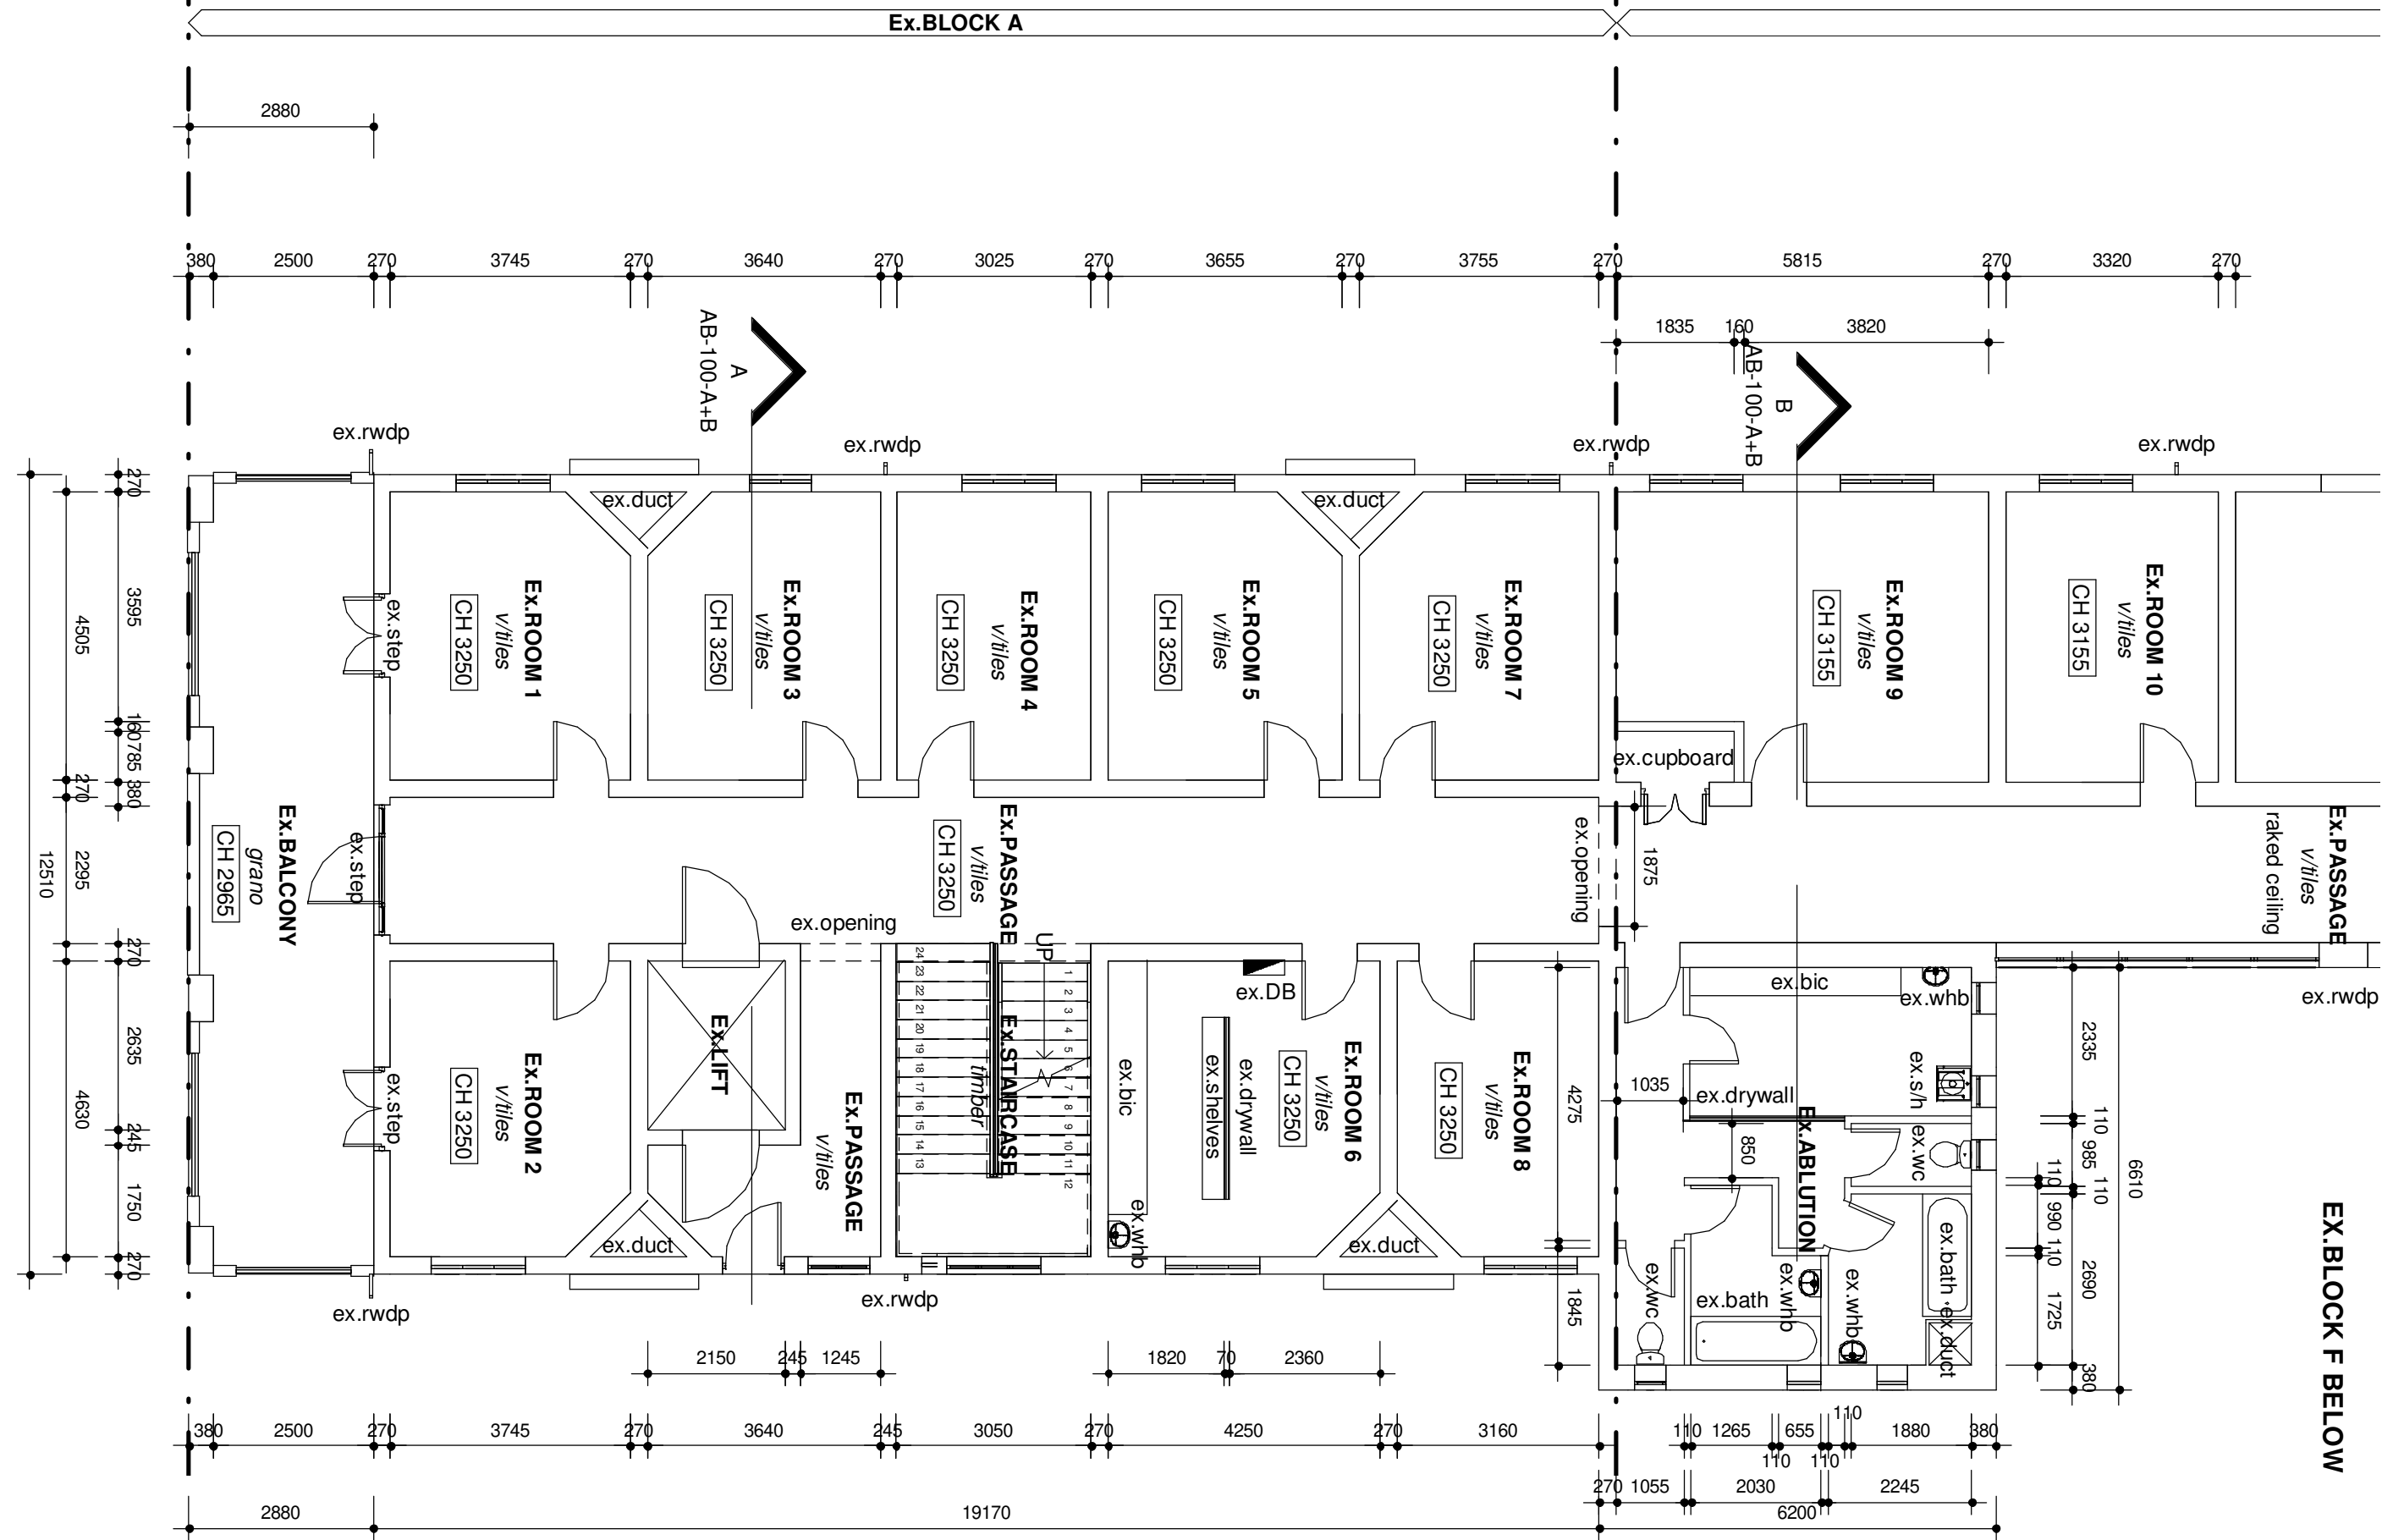

No.	Description	Date





AS-BUILT - BLOCK A+B - FIRST STOREY		
Project number	s511	AB-102-A+B
Date	Issue Date	
Drawn by	Author	Scale
Checked by	Checker	
		1 : 100

2/25/2021 1:45:04 PM

LOWER GROUND STOREY


1 : 100

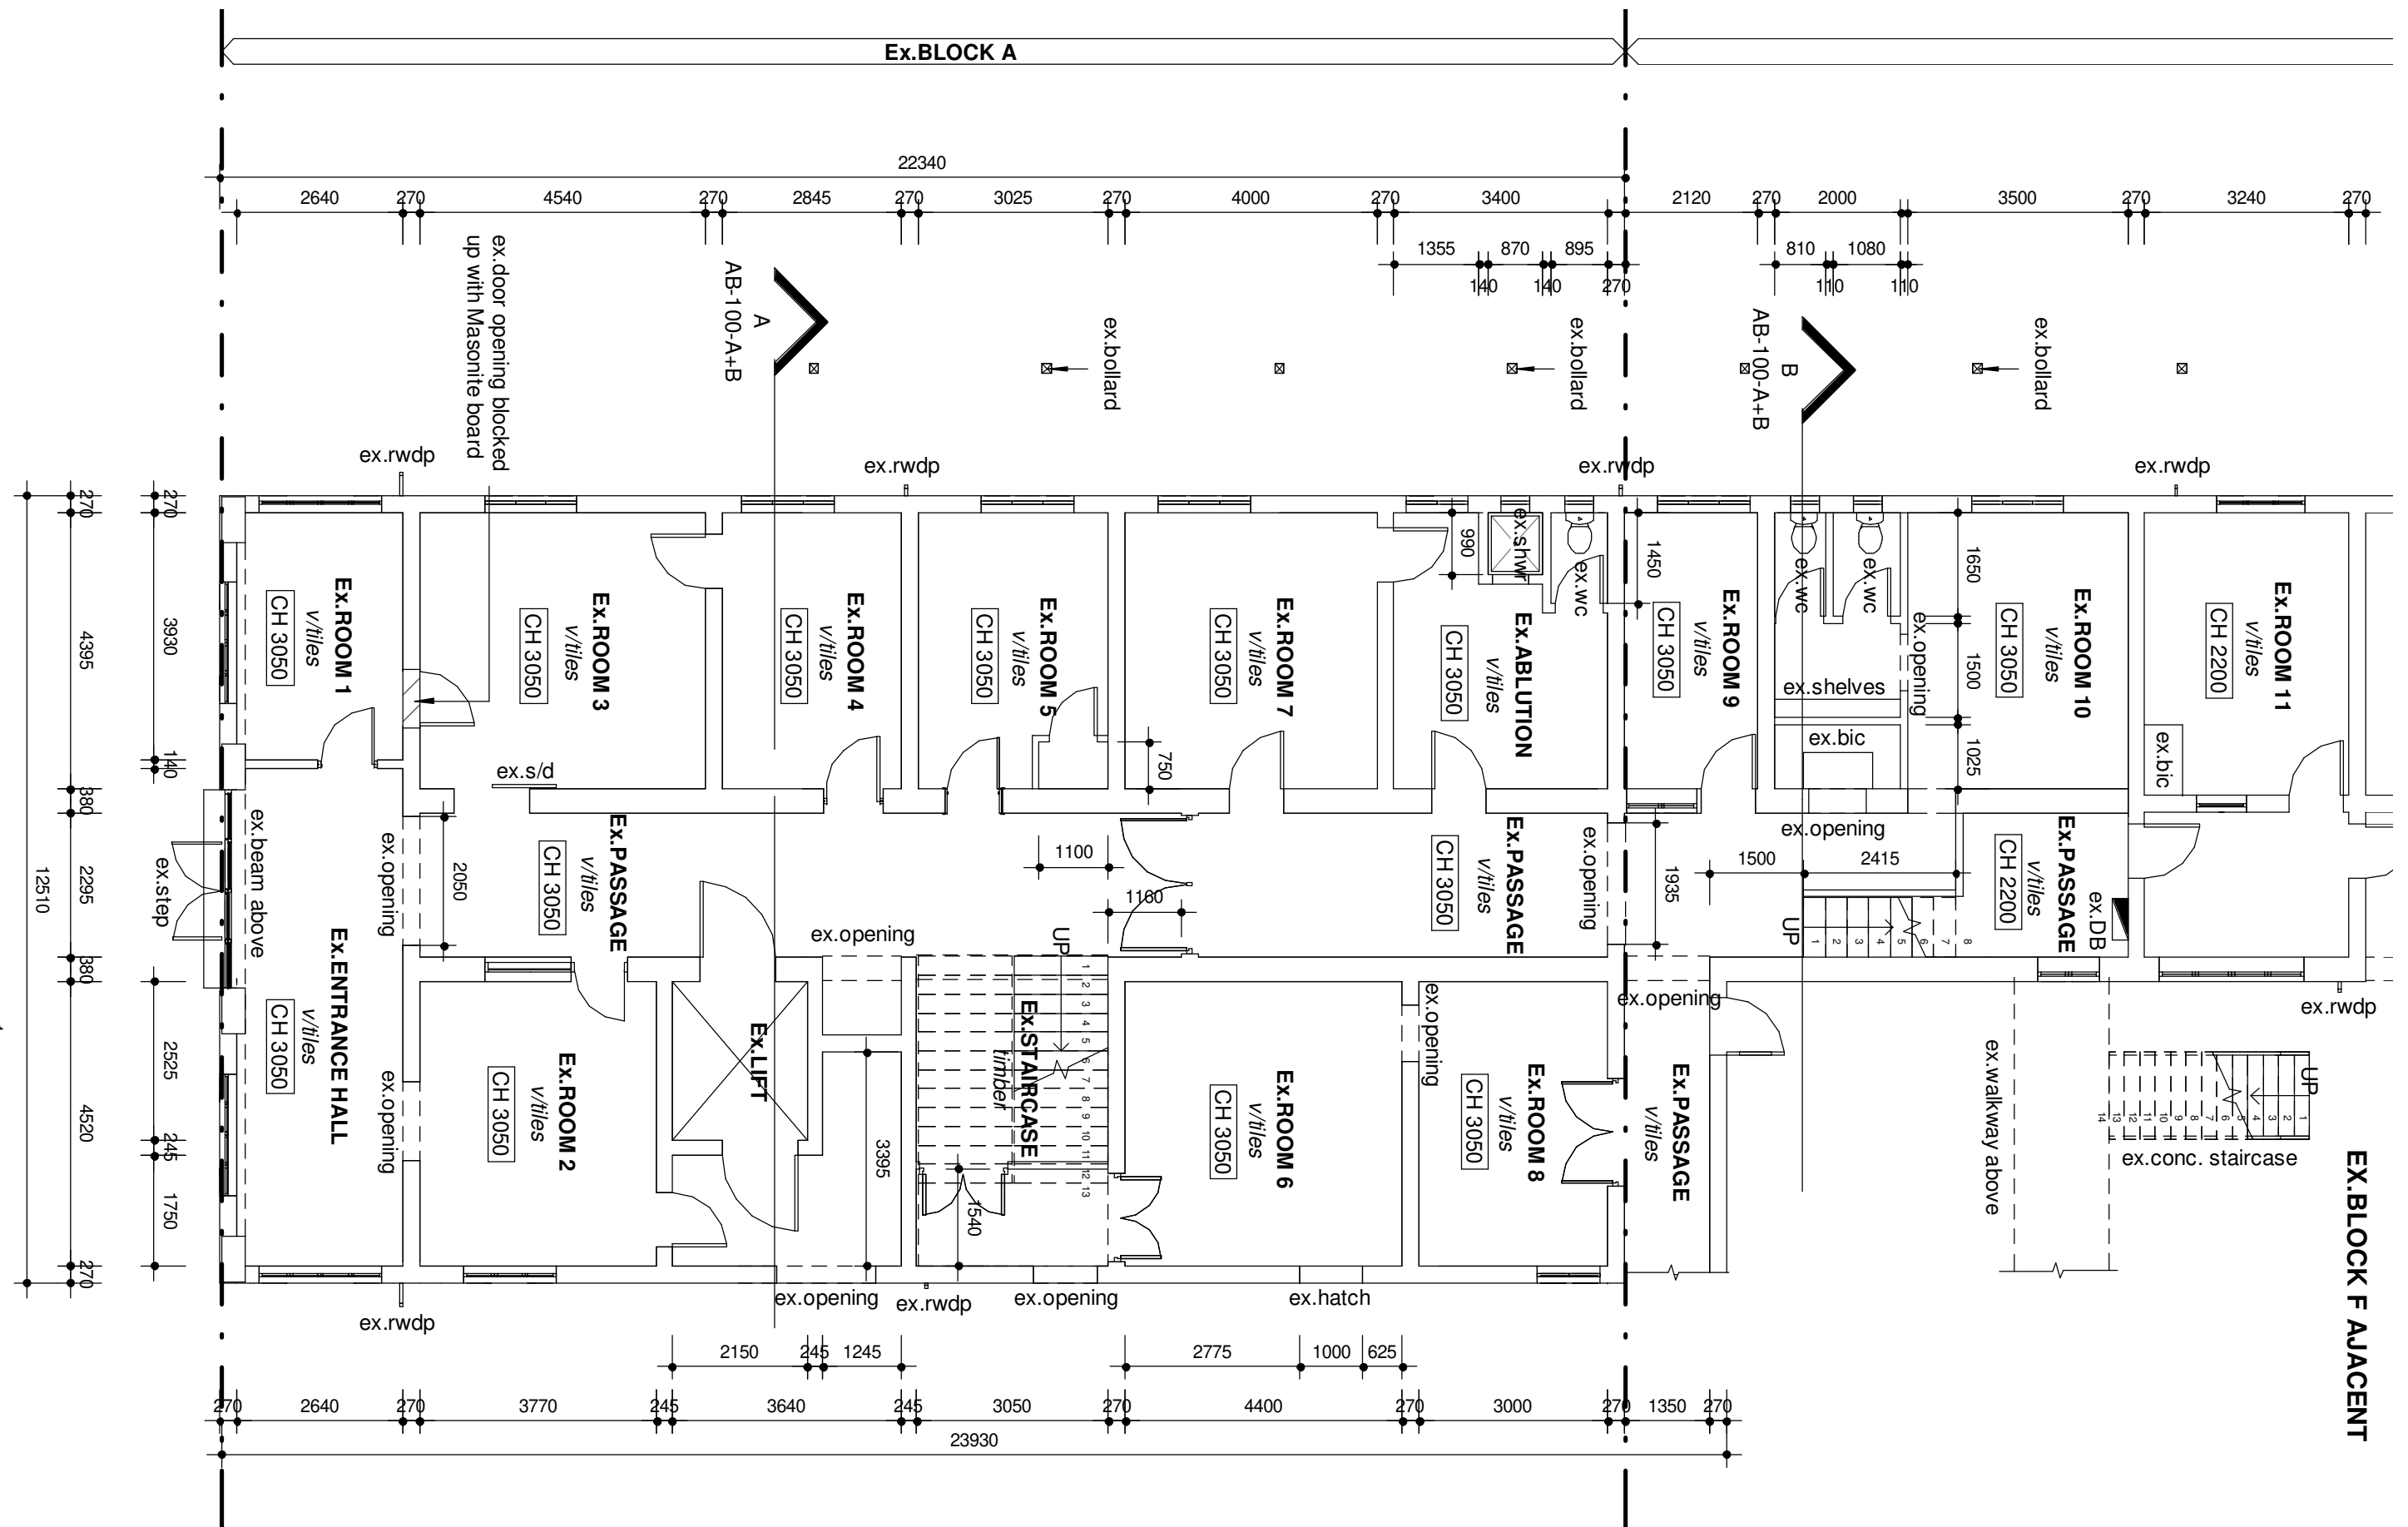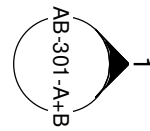

No.	Description	Date



AS-BUILT - BLOCK A+B - LOWER GROUND STOREY		
Project number	s511	AB-100-A+B
Date	Issue Date	
Drawn by	Author	
Checked by	Checker	
Scale		1 : 100

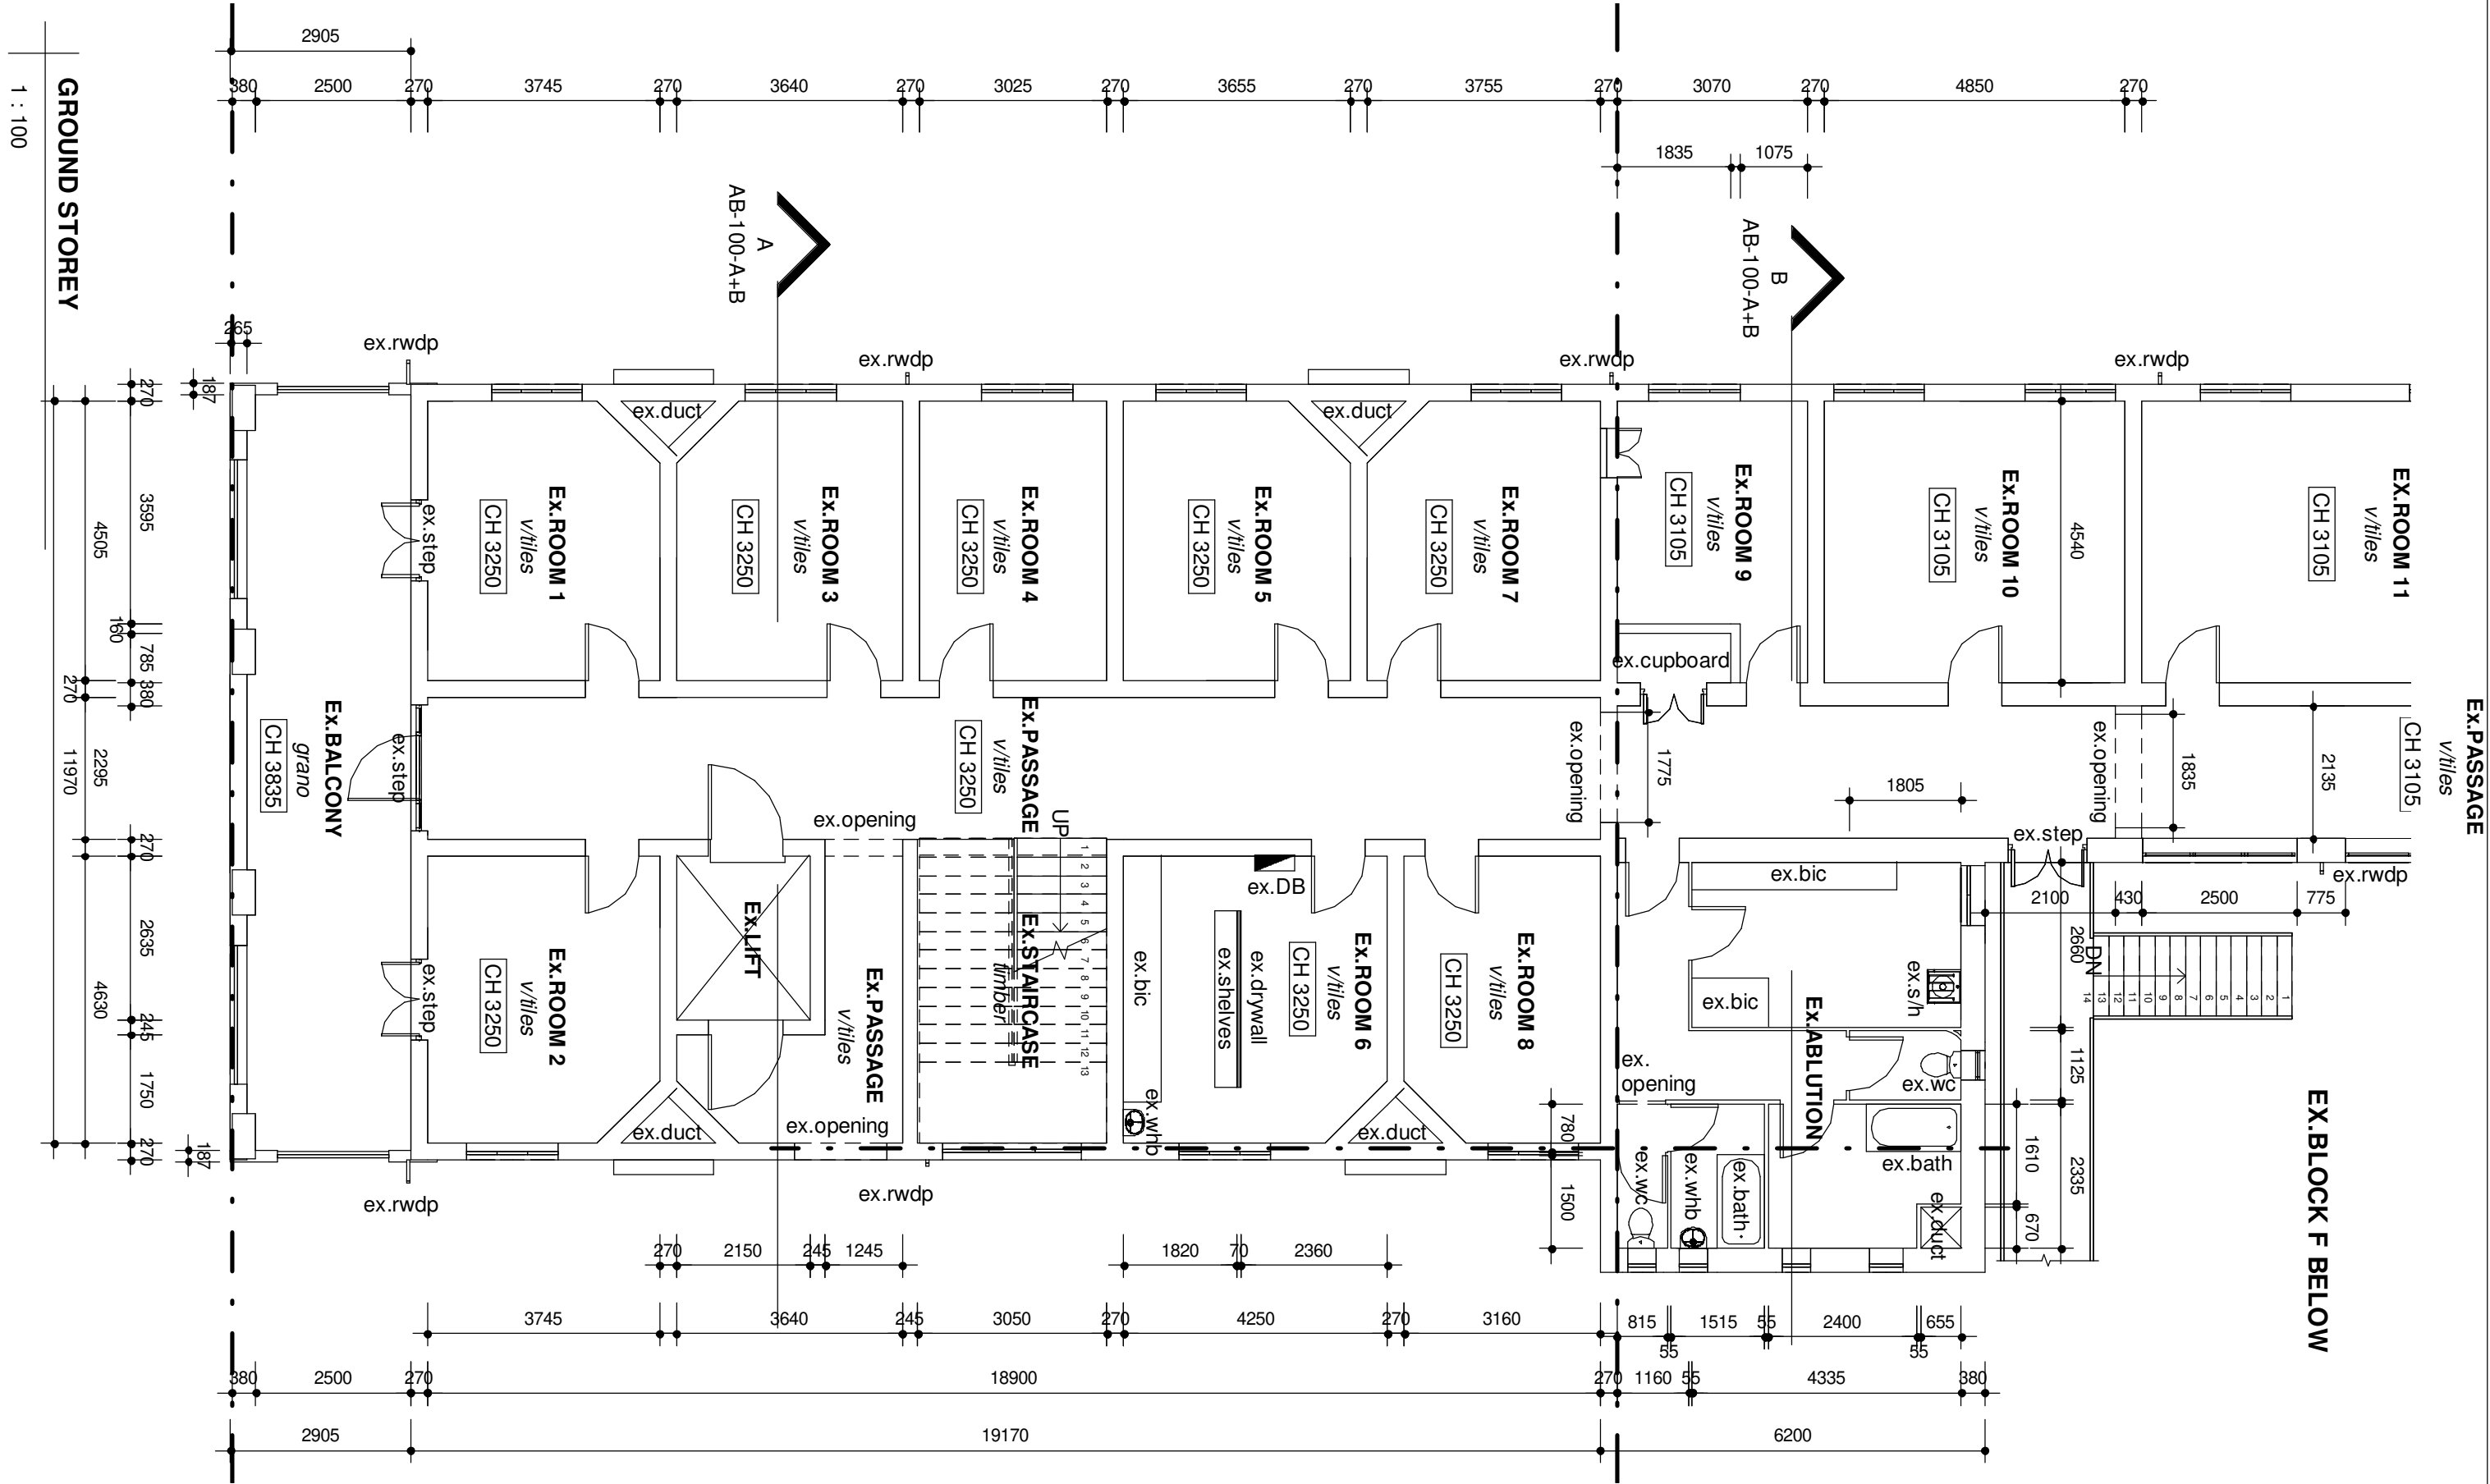


No.	Description	Date



AS-BUILT - BLOCK A+B - GROUND STOREY			
Project number	s511	AB-101-A+B	
Date	Issue Date		
Drawn by	Author		
Checked by	Checker		
		Scale	1 : 100

ROOF LEVEL
1 : 100

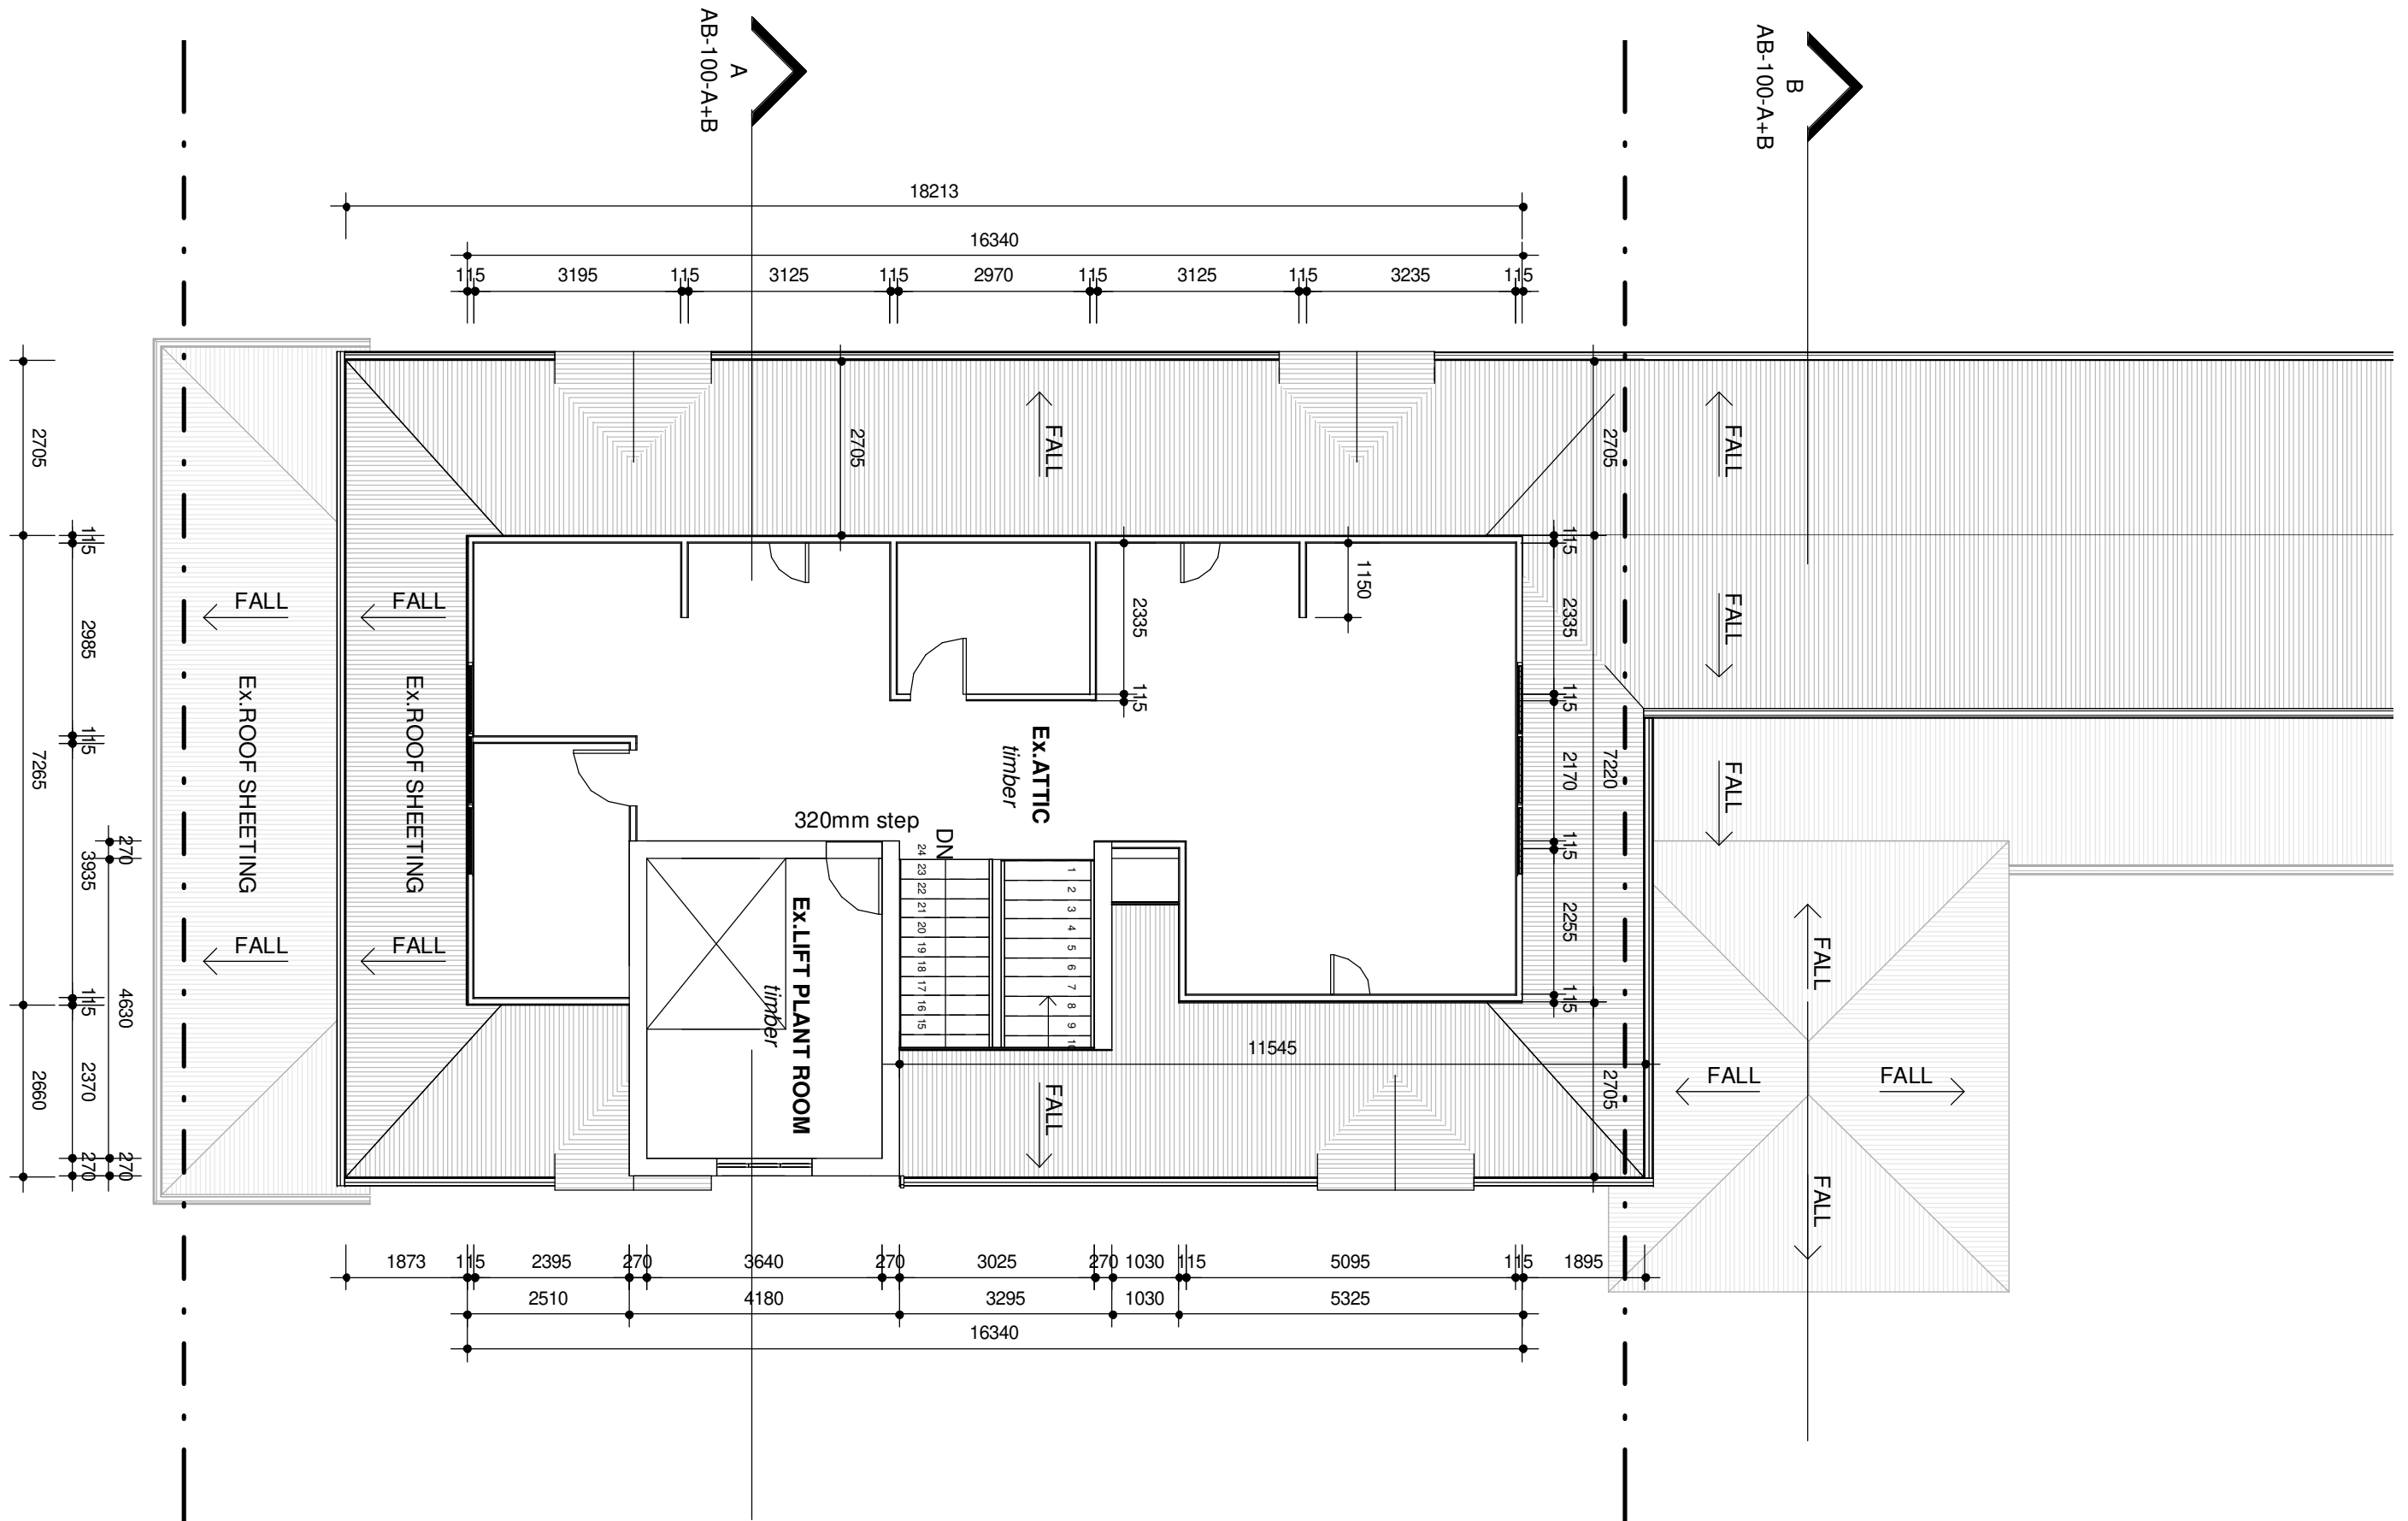

No.	Description	Date



AS-BUILT - BLOCK A+B - ROOF LEVEL

Project number	s511
Date	Issue Date
Drawn by	Author
Checked by	Checker

AB-103-A+B

Scale 1 : 100