

# LOXTON

## CIVIL SERVICES

36 SITES

### LYS VAN TEKENINGE / LIST OF DRAWINGS

NR.	NO.	TITEL	TITLE
SK2374/1		LIST OF DRAWINGS, DRAWING CONVENTION, DESIGN DATA AND GENERAL NOTES	
-/2		LOCALITY PLAN	
-/3		WATER LAYOUT PLAN	
-/4		SEWER LAYOUT PLAN SHEET 1	
-/5		SEWER LAYOUT PLAN SHEET 2	
-/6		SEWER LAYOUT PLAN SHEET 3	
-/7		WATER DETAILS SHEET 1	
-/8		WATER DETAILS SHEET 2	

### TEKENKONVENSIE / DRAWING CONVENTION

Kolom bo	Column above
Kolom onder alleenlik	Column below only
Opening in blad	Opening in slab, etc.
Voorafgegotte betonkolom	Precast concrete column
Onafgewerkte hoogte (bv. onafgewerkte vloerhoogte, ens.)	Unfinished level (eg. unfinished floor level, etc)
Afgewerkte hoogte (bv. afgewerkte vloerhoogte, ens.)	Finished level (eg. finished floor level, etc)
Steenwerk bo	Brickwork above
Lasdraende steenwerk onder	Loadbearing brickwork below
Balk nr.	Beam no.
Trigonometriese baken	Trigonometrical beacon
Opmetingstasle	Survey station
Hoogtemerk	Bench mark
Rioollyn	Sewer line
Waterpyplyn	Water main
Stormwaterlyn	Storm water line
Eskom kragroete - oorhoofs	Eskom power lines - overhead
Kragkabel - ondergronds	Power lines - Overhead
Kraglyne - Oorhoofs	Power cables - underground
Telefoonroetes	Telephone lines
Telefoonkabels - ondergronds	Telephone cables - underground
Heining met hek	Fence with gates
Veiligheidsheining met hek	Security fence with gate
Dorpsgebiedgrens	Township boundary
Spoorlyne	Railway lines

### ONTWERPDATA / DESIGN DATA

#### STRUKTURE / STRUCTURES

FONDAMENT DRAADRUK hoogstens	250 kPa	FOUNDATION BEARING PRESSURE not exceeding
COLAS VR KERREURE normodeweg langs poole		SURCHARGE PRESSURE TO RETAINING WALLS generally adjacent roadways
GRONDDRUK vir aktiewe druk vir possele druk		SOIL PRESSURE for active pressure for passive pressure
HARDE ASTE stabilitet hegstrukke	0,7 kN/m <sup>2</sup> 0,9 kN/m <sup>2</sup>	WIND LOADS stability fixings
LEIDSTOKERKES		CONCRETE GRADES
	CLASS C 1:3:6 E 1:2:4 F 1:1:5:3	MATERIAL MIX MAS. AMPLITUDE GRD MAS. AMPLITUDE SIZE
		STEENSTEEN STRENGTH
STRUCTUURSTAAL grond		binding general columns
KOESTRUKTUURHOUT bruikbare grond S.A. Denenhout	SABS 563	STRUCTURAL STEEL grade
BAKKERKONSTRUKSIJN volgens S.A.B.S. 876		CONSTRUCTION TIMBER merchandise S.A. pine
houltipe grond digtheid		LAMINATED TIMBER according to S.A.B.S. 876 type of timber
blootstellingskategorie verwagte gemiddelde ewigligvoggehole voorkoms klas		grade density exposure category expected average equilibrium moisture content appearance class
LAASRAADDE STEENSTEEN steene mortel klas		LOADBEARING BRICKWORK brick mortar class inner and outer leaves of cavity walls are to be tied together to Engineers satisfaction
binne en buitemure van spoumure moet verbind word tot Ingenieur se bevrediging		LIVE LOADS
LEWENDE BELASTING		2

### SIVIELE WERK / CIVIL WORK

#### PAAIE EN STRATE / ROADS AND STREETS

geselekteerde lae	Laagdikte Layer thickness (mm)	Digtheid Density %	Materiale Material (beskryf - describe)
in-situ laag			selected layers
stutlaag			insitu layer
kroonlaag			subbase
slylaag			base course
			wearing course

### ALGEMENE NOTAS / GENERAL NOTES

#### ALGEMEEN / GENERAL

Lees hierdie stel tekeninge soom met argiteks, mekaniese en elektriese tekeninge (waar v.t.) en met die algemene spesifikasies soos uitgereik deur die Ingenieur.  
Downpipes in columns are shown, but these must be checked against Architects drawings before commencing to cast concrete.  
Alleenlik geskrewe afmetings moet gebruik word.  
Alle afmetings, hoogtes en uitsteppings moet op die terrein nagegaan word en enige verskille, afwykings of onduidelikhede word of die betrokke materiaal bestel word.  
moet aan die Ingenieur gerapporteer word voordat die werk begin.  
Geen veranderinge mag geopengebring word aan enige tekening of spesifikasie sonder die skriflike toestemming van die Ingenieur nie.  
Alle materiaal moet voldoen aan die spesifikasies en/of vereistes in die dokument en op die tekeninge.

All dimensions, levels and setting out pegs must be checked on site and any discrepancy, variation or ambiguity reported to the Engineer before commencing work or ordering relevant materials.

No alterations may be made to drawings or specifications without written approval of Engineer.

All materials to comply with specifications and/or requirement as shown in documents or on drawings.

Internal control tests as required by specifications are to be performed as laid down and submitted to the Engineer.

Standard specifications as applicable for each activity will be latest edition of S.A.B.S. - 1200 series tensy anders gespesifieer in die dokument of op die tekeninge.

### NOTAS / NOTES

#### GENERAL



NOTAS / NOTES

22/02/11	1	AS BUILD	JN
DATUM	NR.	WYSIGING	HANDT.
DATE	NO.	AMENDMENT	SIGN.

KUENT / CLIENT  
UBUNTU MUNICIPALITY

**STABILIS**  
Development(Pty)Ltd  
Postal Suite 136  
KIVBERLEY  
8300  
Tel: (034) 8316159  
Fax: (034) 8313786  
E-mail: info@stabilis.co.za

DIENS / SERVICE  
LOXTON  
CIVIL SERVICES: 36 SITES


TITEL / TITLE  
LOCALITY PLAN

TEKENING NR. / DRAWING NO.  
**SK2374/2**

SKALA / SCALE	1:500	GETEKEN DRAWN	J Nel
LEER NR. / FILE NO.	SK2374	ONTWERP DESIGNED	
DATUM DATE	MRT 2011	NAGESIEN CHECKED	



NOTAS / NOTES

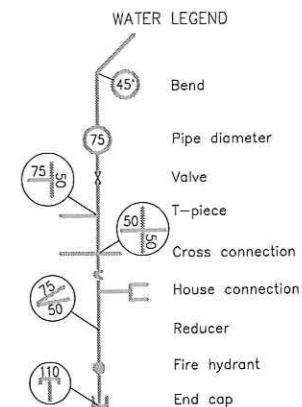

**NOTE:**  
50mm pipes - HDPE CLASS 10  
75mm & 110mm pipes - uPVC class 9

22/02/11	1	AS BUILT	JN
DATUM	NR.	WYSIGING	HANDT.
DATE	NO.	AMENDMENT	SIGN.
AFDRUK UITGEREIK PRINT ISSUED			

KLIENT / CLIENT





DIENS / SERVICE  
LOXTON  
CIVIL SERVICES: 36 SITES


TITLE / TITLE


TEKENING NR. / DRAWING N.  
SK2374/3

SKAAL / SCALE	1:500	GETEKEN DRAWN	J Nel
LEER NR. / FILE NO.	SK2374	ONTWERP DESIGNED	<i>RE/NGR</i>
DATUM DATE	MRT 2011	NAGESIEN CHECKED	<i>✓</i>

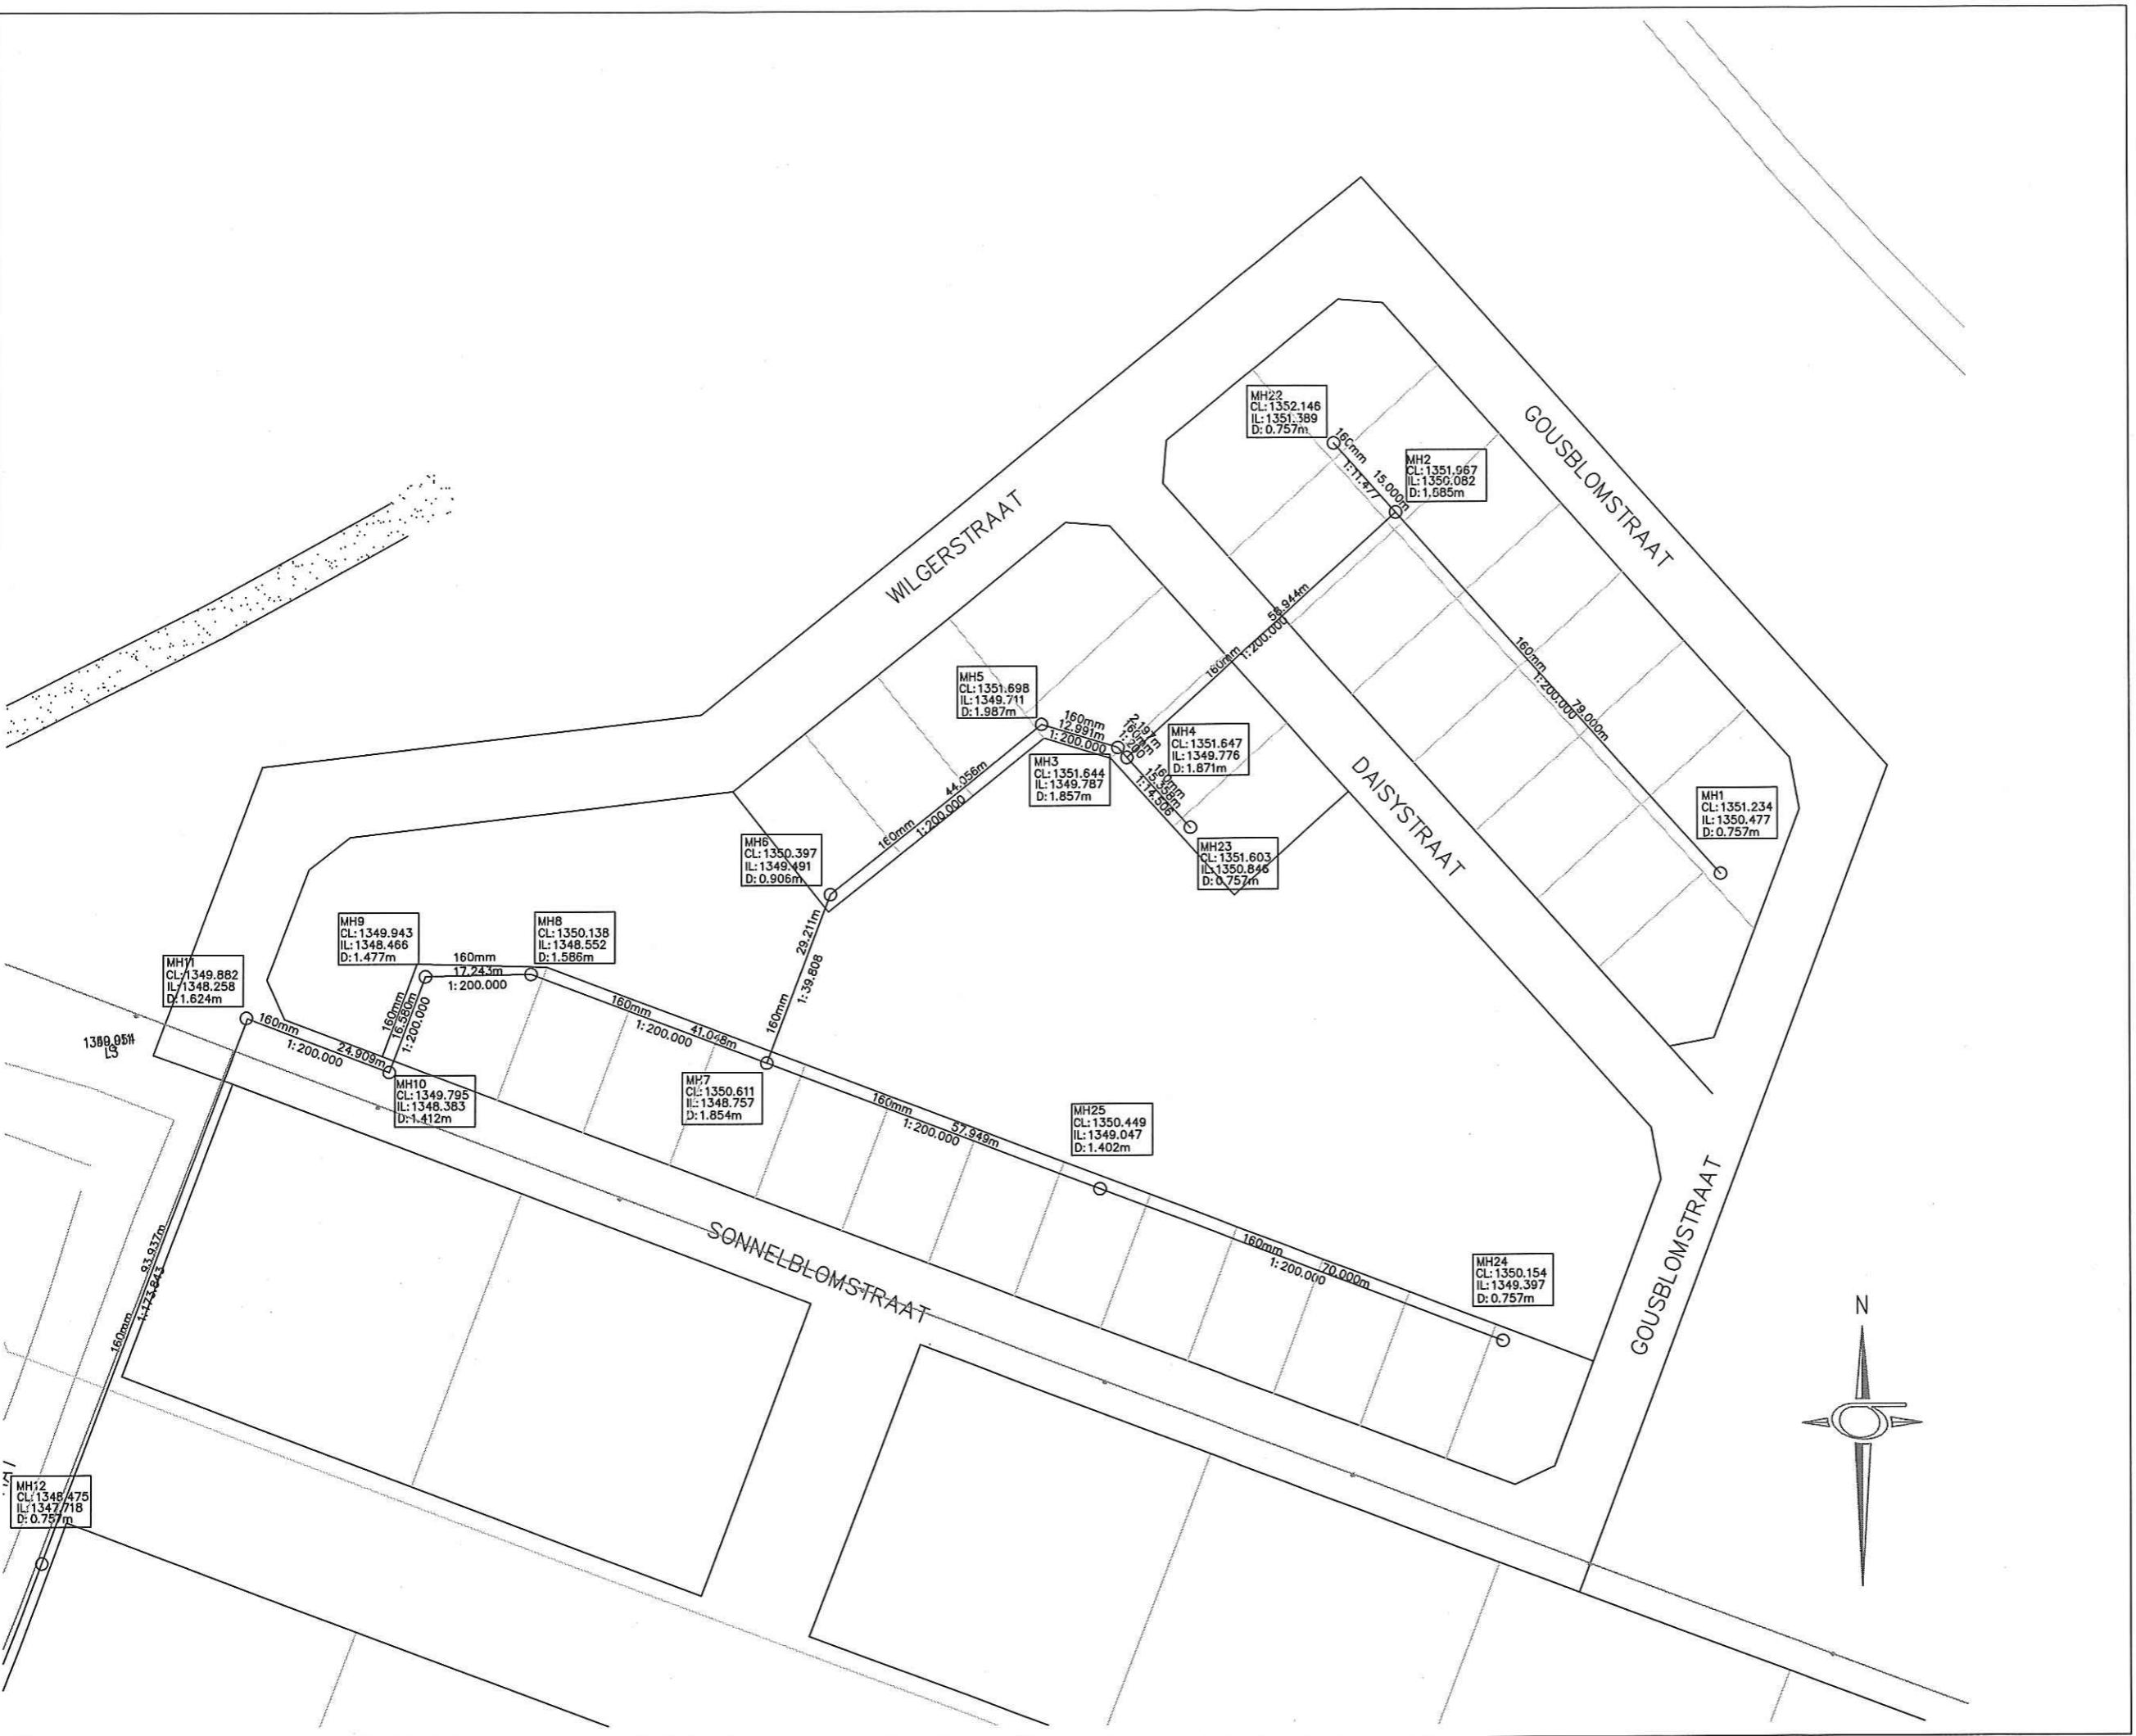

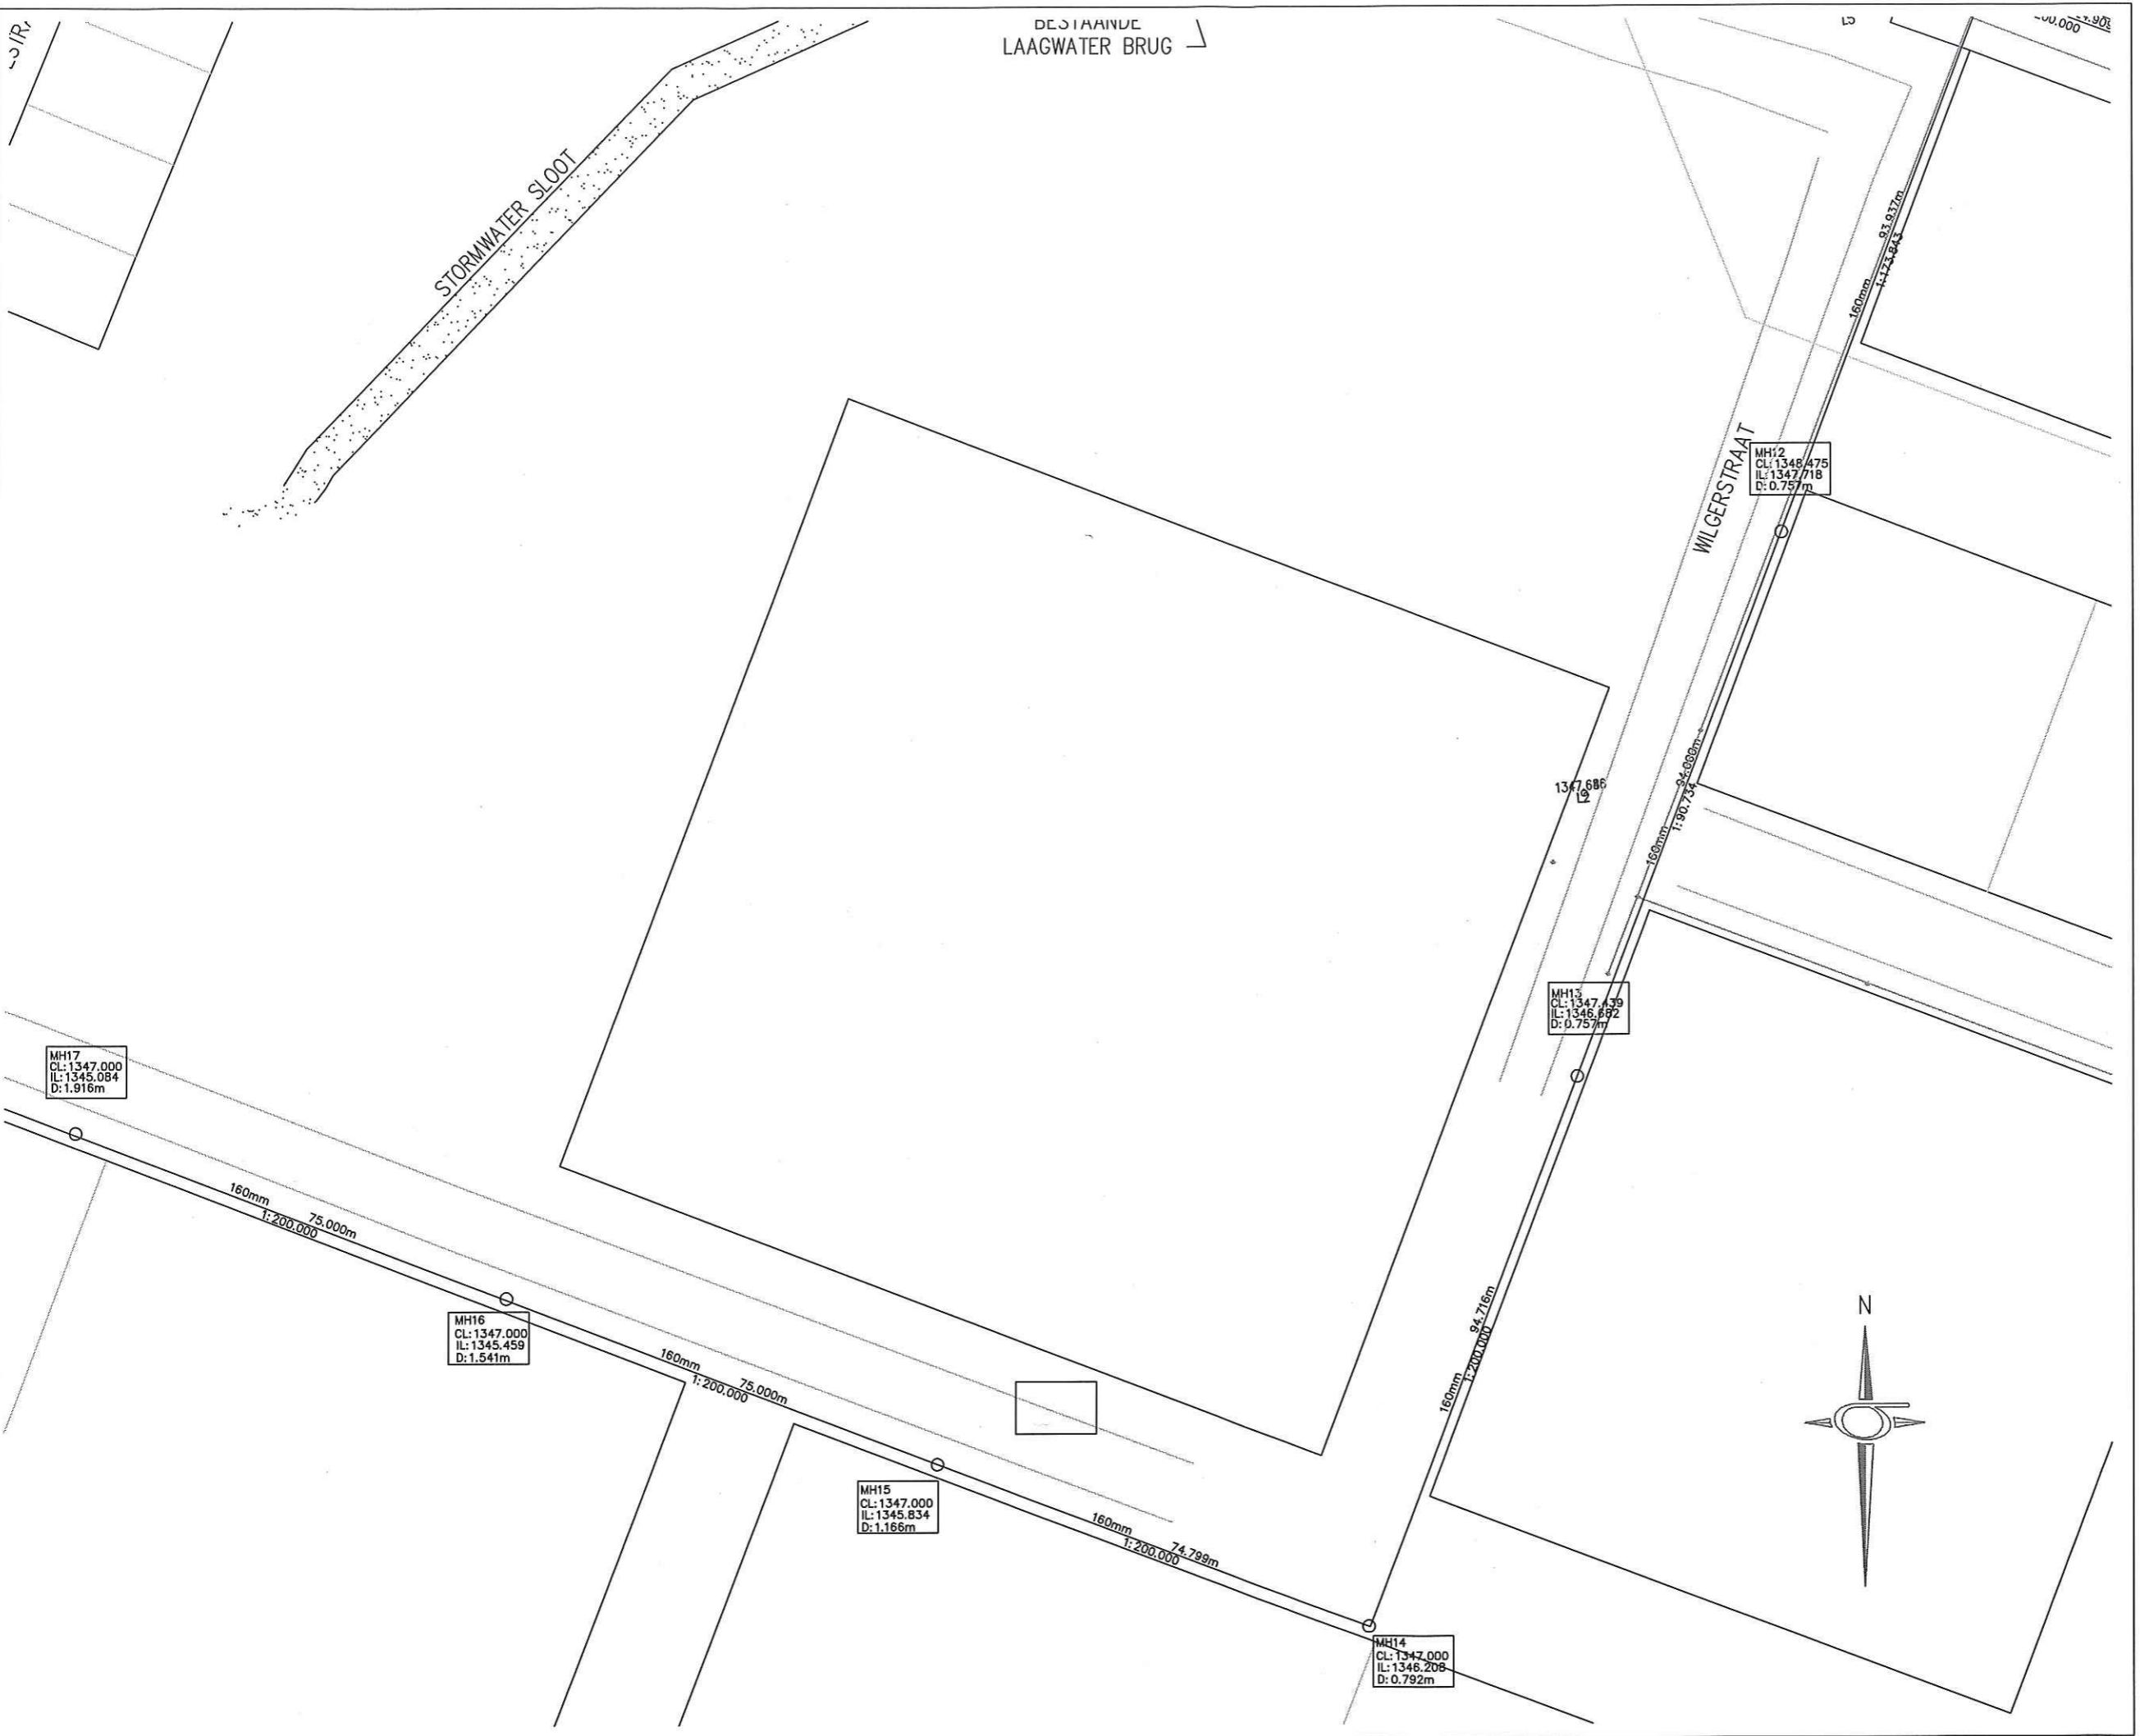

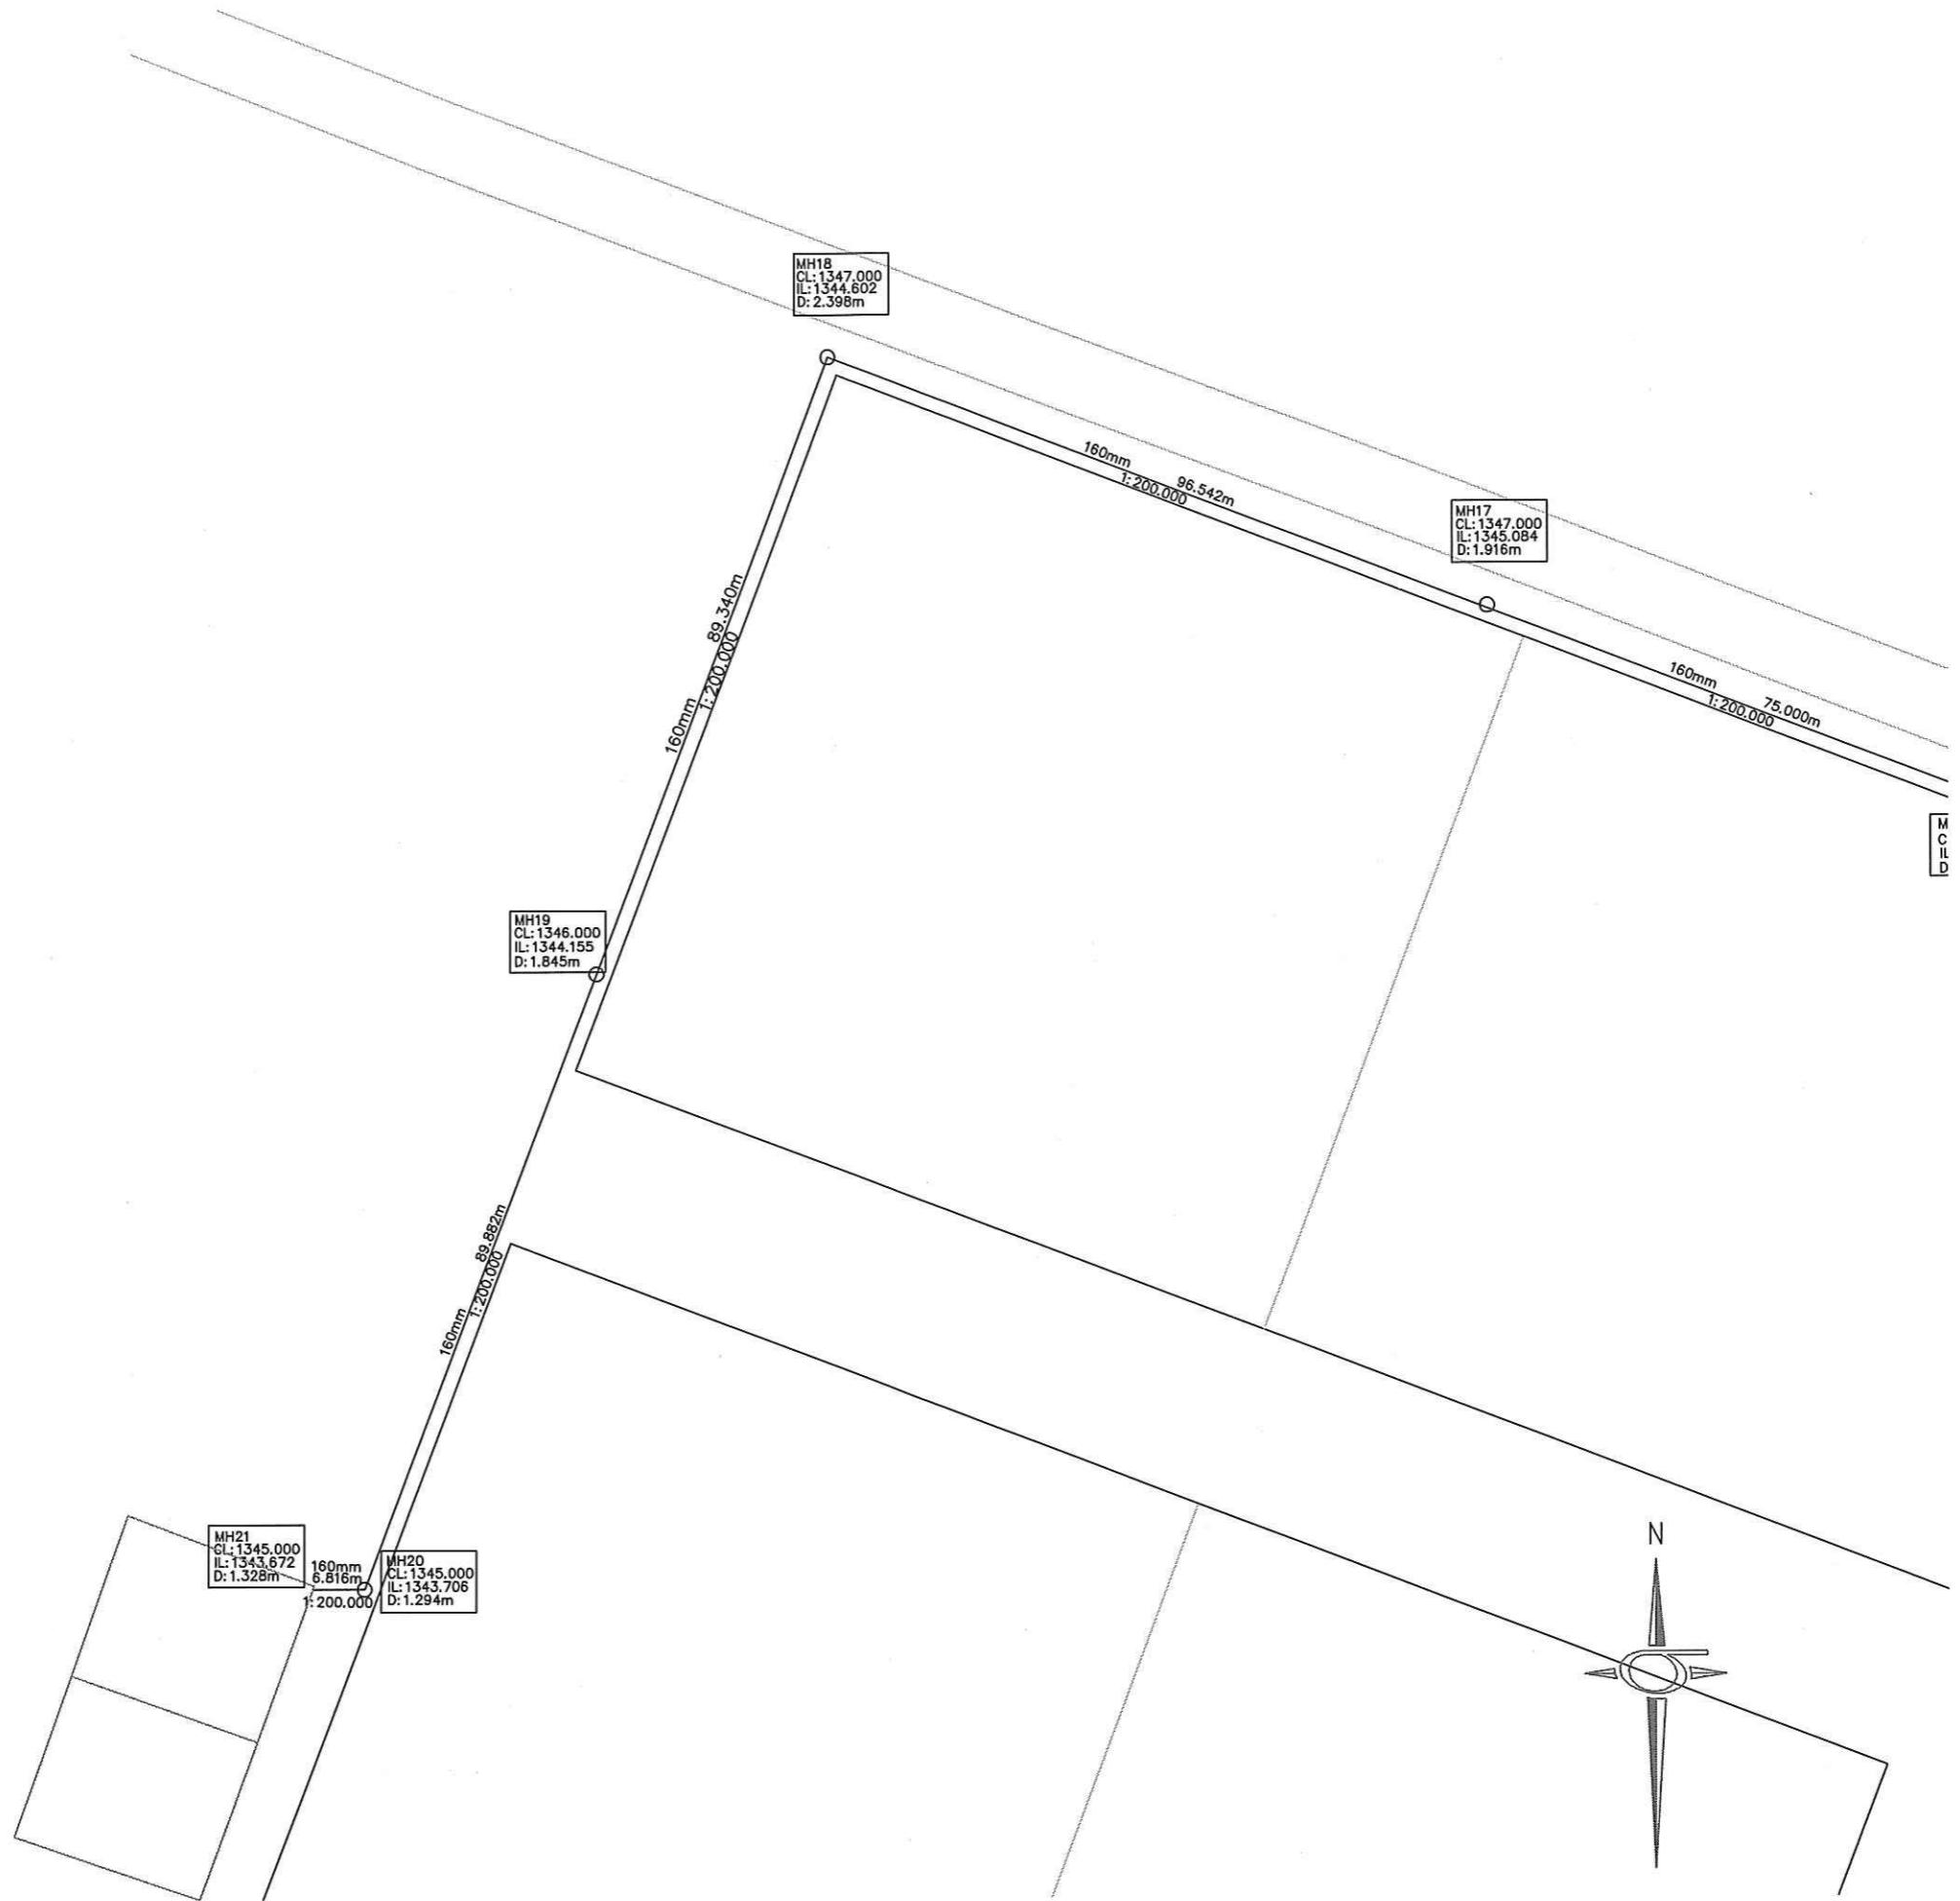

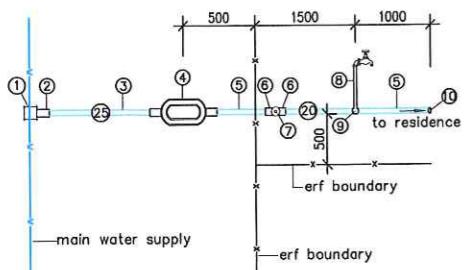


**LIST OF COMPONENTS**

1. Saddle with 25mmØ outlet
2. 25mm x 1" Male adaptor
3. 25mmØ HDPE water pipe Type 4 Class 10
4. 15mmØ water meter complete with lockable above ground meter box, meter, stop cock and compression fittings for 25mmØ incoming and 20mmØ outgoing HDPE pipes
5. 20mmØ HDPE water pipe Type 4 Class 10
6. 20mm x  $\frac{3}{4}$ " Male adaptor
7. 20mm brass stop cock
8. 20mm bib tap with post to DETAIL W17, see dwg. SK 2374/7
9. 20mm x  $\frac{3}{4}$ " Female T-piece
10. 20mm end cap

NOTE: ALL FITTINGS TO BE PLASSON COMPRESSION FITTINGS OR SIMILAR APPROVED.

#### SINGLE WATER CONNECTION WITH BIB TAP AND POST


N.T.S.  
DETAIL Nr. 8

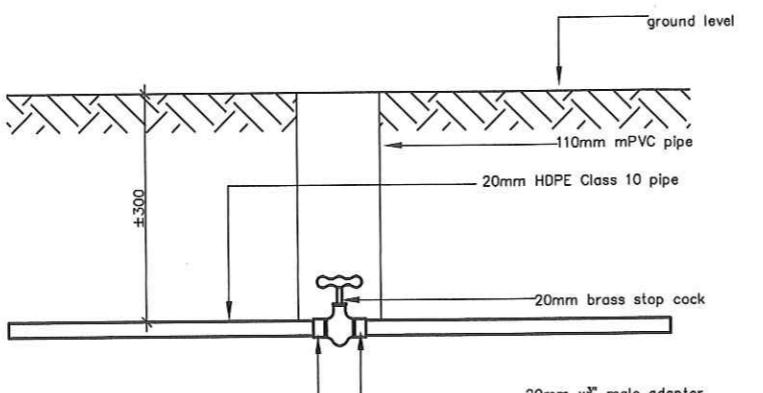


DETAIL BRASS STOP COCK

N.T.S.

DETAIL Nr. 10

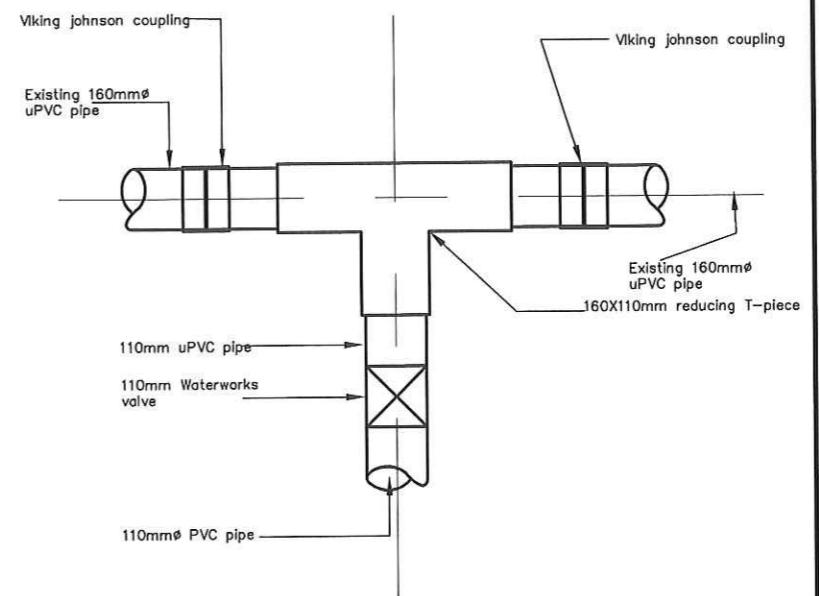

DETAIL 12

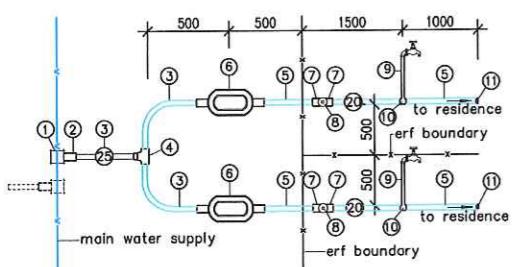

**LIST OF COMPONENTS**


1. Saddle with 25mmØ outlet
2. 25mm x 1" Male adaptor
3. 25mmØ HDPE water pipe Type 4 Class 10
4. 25x25mm T-piece
5. 20mmØ HDPE water pipe Type 4 Class 10
6. 15mmØ water meter complete with lockable above ground meter box, meter, stop cock and compression fittings for 25mmØ incoming and 20mmØ outgoing HDPE pipes
7. 20mm x  $\frac{3}{4}$ " Male adaptor
8. 20mm brass stop cock
9. 20mm bib tap and post to DETAIL, see dwg SK 2374/7
10. 20mm x  $\frac{3}{4}$ " Female T-piece
11. 20mm end cap

NOTE: ALL FITTINGS TO BE PLASSON COMPRESSION FITTINGS OR SIMILAR APPROVED.

#### DOUBLE WATER CONNECTION WITH BIB TAP AND POST


N.T.S.

DETAIL Nr. 7

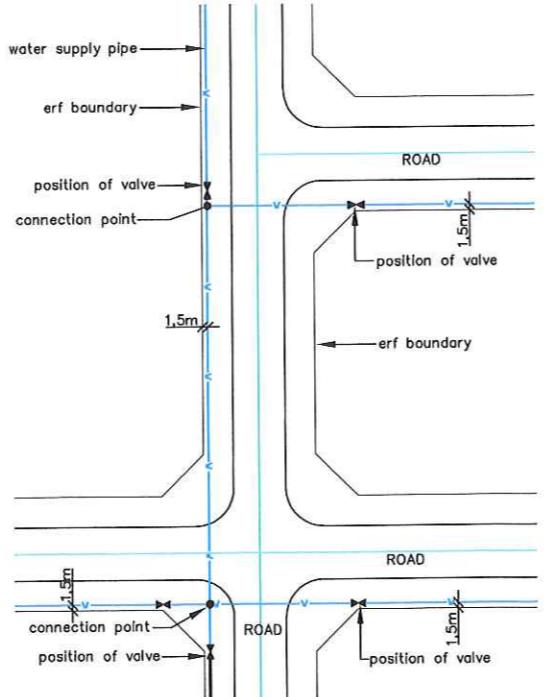


PIPE LAYOUT AT STREET JUNCTION  
N.T.S.

DETAIL Nr. 9

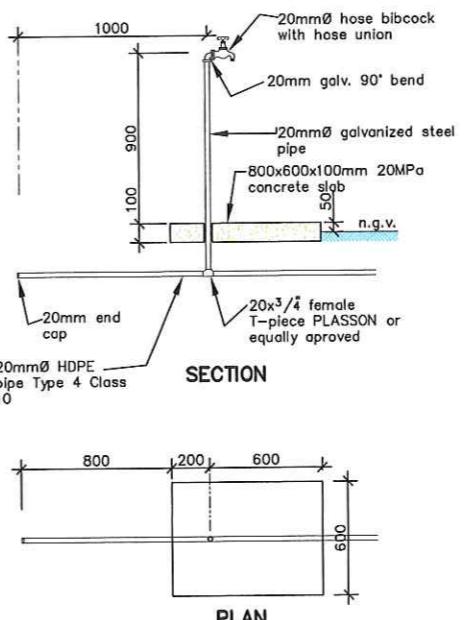

SECTION

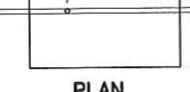

PLAN

DETAIL OF HOSE TAP

N.T.S.

DETAIL Nr. 11

DATUM	NR.	WYSIGING	HANOT.
DATE	NO.	AMENDMENT	SIGN.
AFDRUK UITGEBERIK PRINT ISSUED			

KUENT / CLIENT  
**UBUNTU MUNICIPALITY**


**STABILIS**  
Development(Pty)Ltd  
Postal / P.O. Box 861  
KIMBERLEY  
8300  
Tel. (054) 8331659  
Fax. (054) 8331706  
E-mail: info@stabilis.co.za  
Branch Office / Tokantoor  
Postal / P.O.Box 342  
KEMERS  
8360  
Tel. (054) 4610018  
E-mail: edon@stabilis.net

DIENS / SERVICE  
**LOXTON:**  
CIVIL SERVICES: 31 ERVEN


TITEL / TITLE  
DETAIL

TEKENING NR. / DRAWING NO.  
**SK2374/7**

SKAAL / SCALE	AS SHOWN	GETEKEN DRAWN	J. NEL
LEER NR. / FILE NO. SK 2374	ONTWERP DESIGNED		
DATUM DATE MART 2011	HAGESIEN CHECKED		

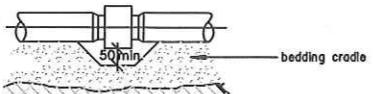


CLASS A, B AND C BEDDING

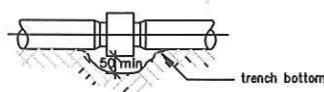

CLASS D BEDDING

PIPE BEDDING DETAILS: TYPICAL JOINT POCKETS  
N.T.S.

DETAIL Nr. 1

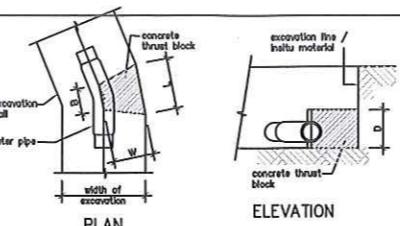


## NOTES:

1. Thrust area "A" is square meters.
2. Concrete volume "V" allowed in cubic meters.
3. Thrust block of class 15 concrete and to be cast against in situ material.

Thrust block for 45° bends and less and line pressure < 0,9 MPa						
Pipe Ø	A m <sup>2</sup>	B mm	D mm	L mm	V m <sup>3</sup>	W mm
50	0,02	100	150	200	0,01	300
75	0,03	100	150	200	0,01	300
100	0,08	150	200	300	0,01	300
150	0,14	200	300	400	0,02	300
200	0,18	250	350	650	0,05	300
250	0,38	300	400	850	0,09	400
300	0,54	350	500	1000	0,15	450
350	0,74	400	600	1150	0,23	500

THRUST BLOCK FOR 45° AND LESS  
N.T.S.

DETAIL Nr. 2

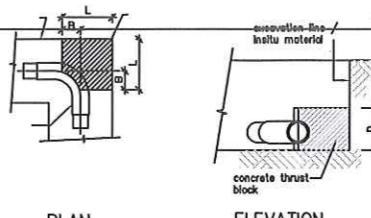


NOTES:

1. Concrete strength 15 MPa at 28 days.
2. Thrust block to be cast against in situ material.
3. Thrust area "A" in square meters.
4. Concrete volume "V" allowed in cubic meters.

Dimensions of thrust blocks for different Ø pipes, end caps, t-pieces, cross and 90° bends.						
Pipe Ø	A m <sup>2</sup>	B mm	D mm	L mm	V m <sup>3</sup>	W mm
50	0,03	75	150	300	0,01	300
70	0,06	100	150	350	0,02	350
100	0,11	100	200	400	0,03	400
150	0,25	150	300	450	0,06	450
200	0,44	300	400	600	0,14	600
250	0,69	350	500	700	0,21	700
300	1,00	450	600	800	0,32	800
350	1,36	500	700	1000	0,52	1000

THRUST BLOCK FOR 90° BENDS  
N.T.S.

DETAIL Nr. 3

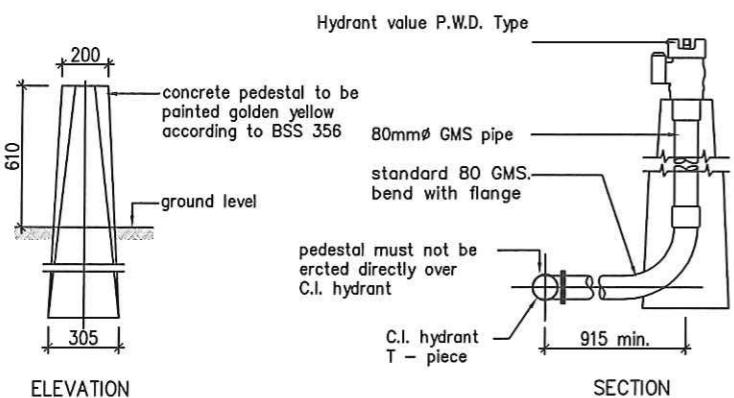

Hydrant value P.W.D. Type

ground level

610

concrete pedestal to be painted golden yellow according to BSS 356

200

305

pedestal must not be erected directly over C.I. hydrant

T - piece

80mmØ GMS pipe

standard 80 GMS bend with flange

NOTE: pedestal must not be erected directly over C.I. hydrant


C.I. hydrant T - piece

915 min.

SECTION

ELEVATION


SECTION

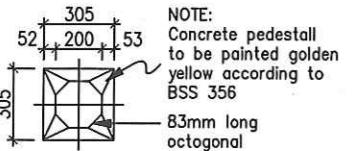

TYPE A VALVE HYDRANT STANDPOST

SCALE 1:20

DETAIL Nr. 4

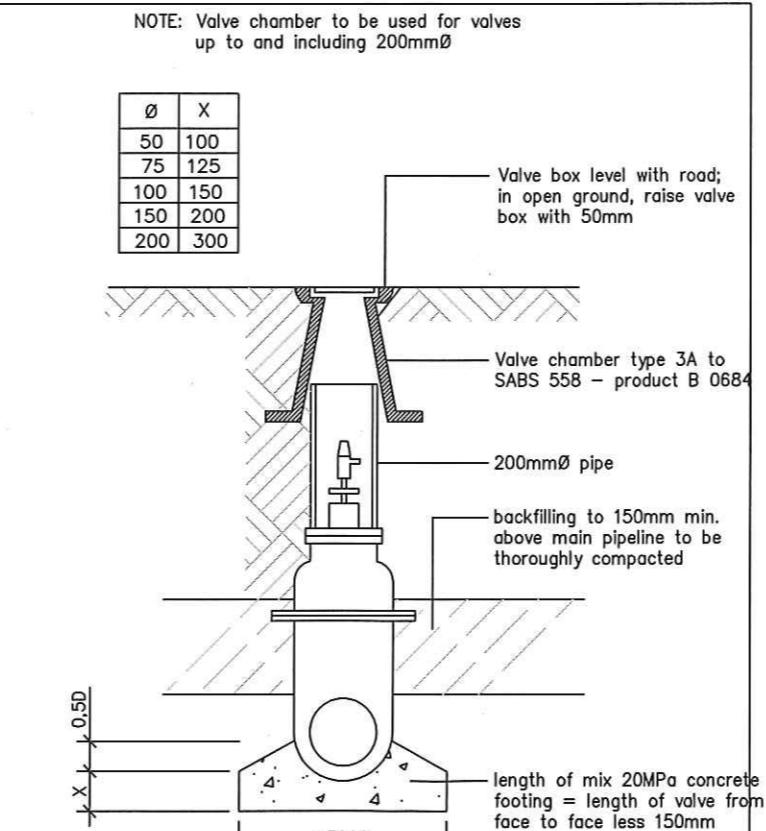

VALVE CHAMBER TYPE 3

N.T.S.

DETAIL Nr. 5

DATUM / DATE	NR. / NO.	WYSIGING / AMENDMENT	HANDT. SIGN.
AFDRUK UITGEREIK / PRINT ISSUED			

CITY ENGINEER — DATE

KUENT / CLIENT  
UBUNTU MUNICIPALITY

**STABILIS**  
Development(Pty)Ltd  
Postnet Suite 136  
KIMBERLEY  
043-8313650  
Tel. (053) 8313650  
Fax. (053) 8313750  
E-mail: Info@Stabilis.co.za  
Tel. / Fax. (053) 3311779  
E-mail: stabilis@icloud.net

DIENS / SERVICE  
LOXTON  
CIVIL SERVICES: 36 SITESTITEL / TITLE  
WATER DETAILS: SHEET 2TEKENING NR. / DRAWING NO.  
**SK2374/8**

SKALA / SCALE	AS SHOWN	GETEKEN DRAWN	J. Nel
LEER NR. / FILE NO.	ONTWERP DESIGN		
SK2374			
DATE	MRT 2011	NAGESSEN CHECKED	