



ALL DIMENSIONS ARE TO BE CHECKED ON SITE PRIOR TO CONSTRUCTION TAKING PLACE. ANY DISCREPANCY BETWEEN ARCHITECTS DRAWINGS, ENGINEERS DRAWINGS AND THE BILLS OF QUANTITIES ARE TO BE CLARIFIED WITH THE ARCHITECT. ALL PRODUCT SPECIFICATION CODES ARE TO BE CHECKED WITH THE SUPPLIER PRIOR TO THE ORDERING AND BUILDING IN OF MATERIAL. ALL STRUCTURE TO BE CHECKED BY THE ENGINEER.

NO.	DATE	AMENDMENT	D.P.N.

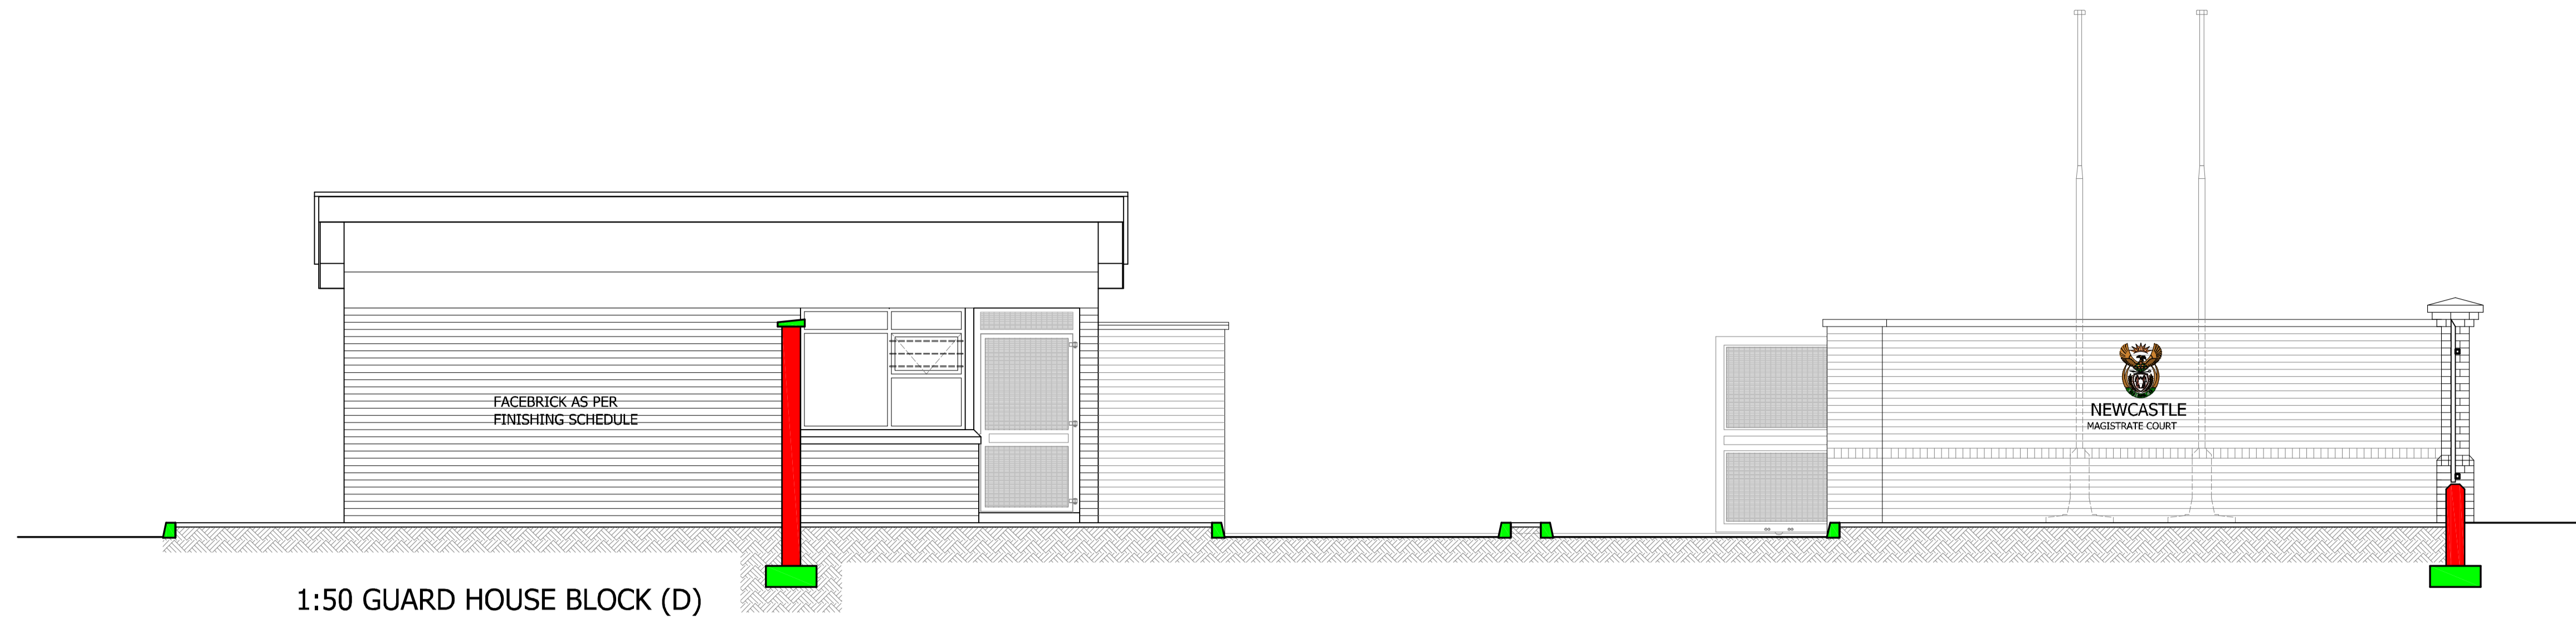


1:50 GUARD HOUSE BLOCK (D)
SECTION A-A

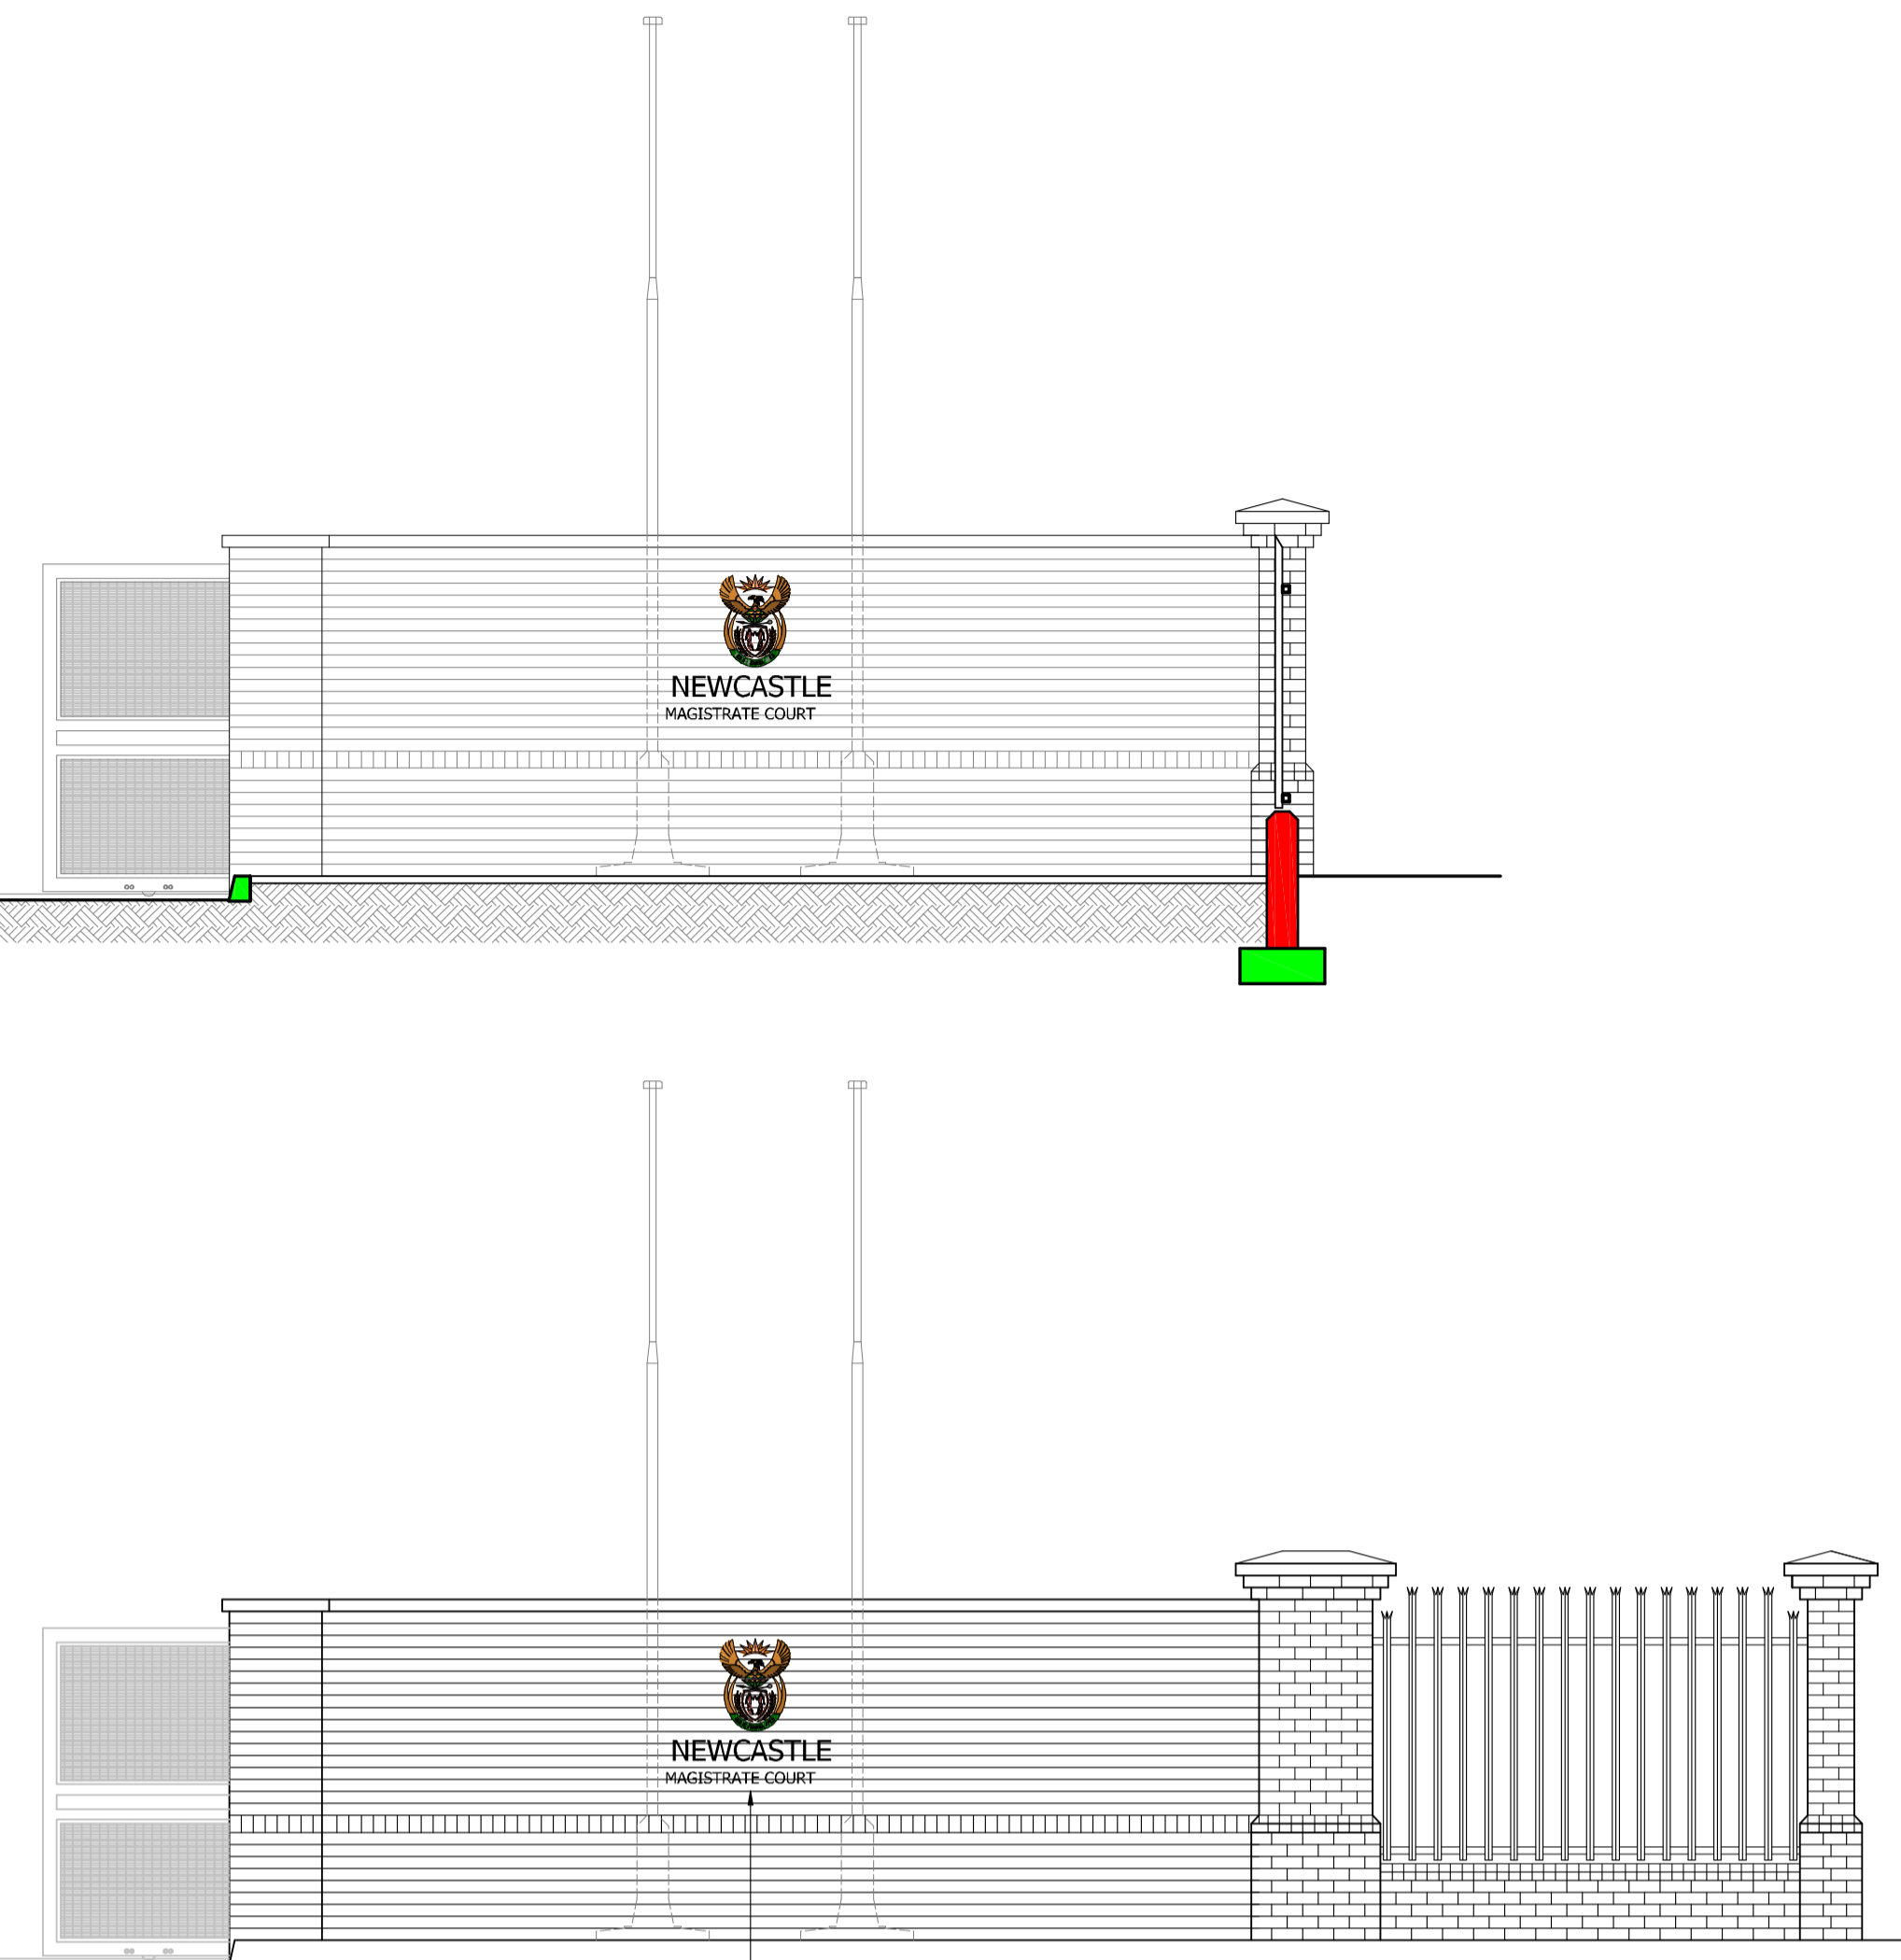


1:50 GUARD HOUSE BLOCK (D)
NORTH ELEVATION


NATURAL ANODISED ALUMINIUM CUT OUT LETTERS 200 mm HIGH AND 2,5mm THICK WITH CONCEALED FIX. AS SUPPLIED BY MANUFACTURER. SAMPLES TO BE SUBMITTED. FACILITY NAME TO BE APPROVED BY CLIENT.

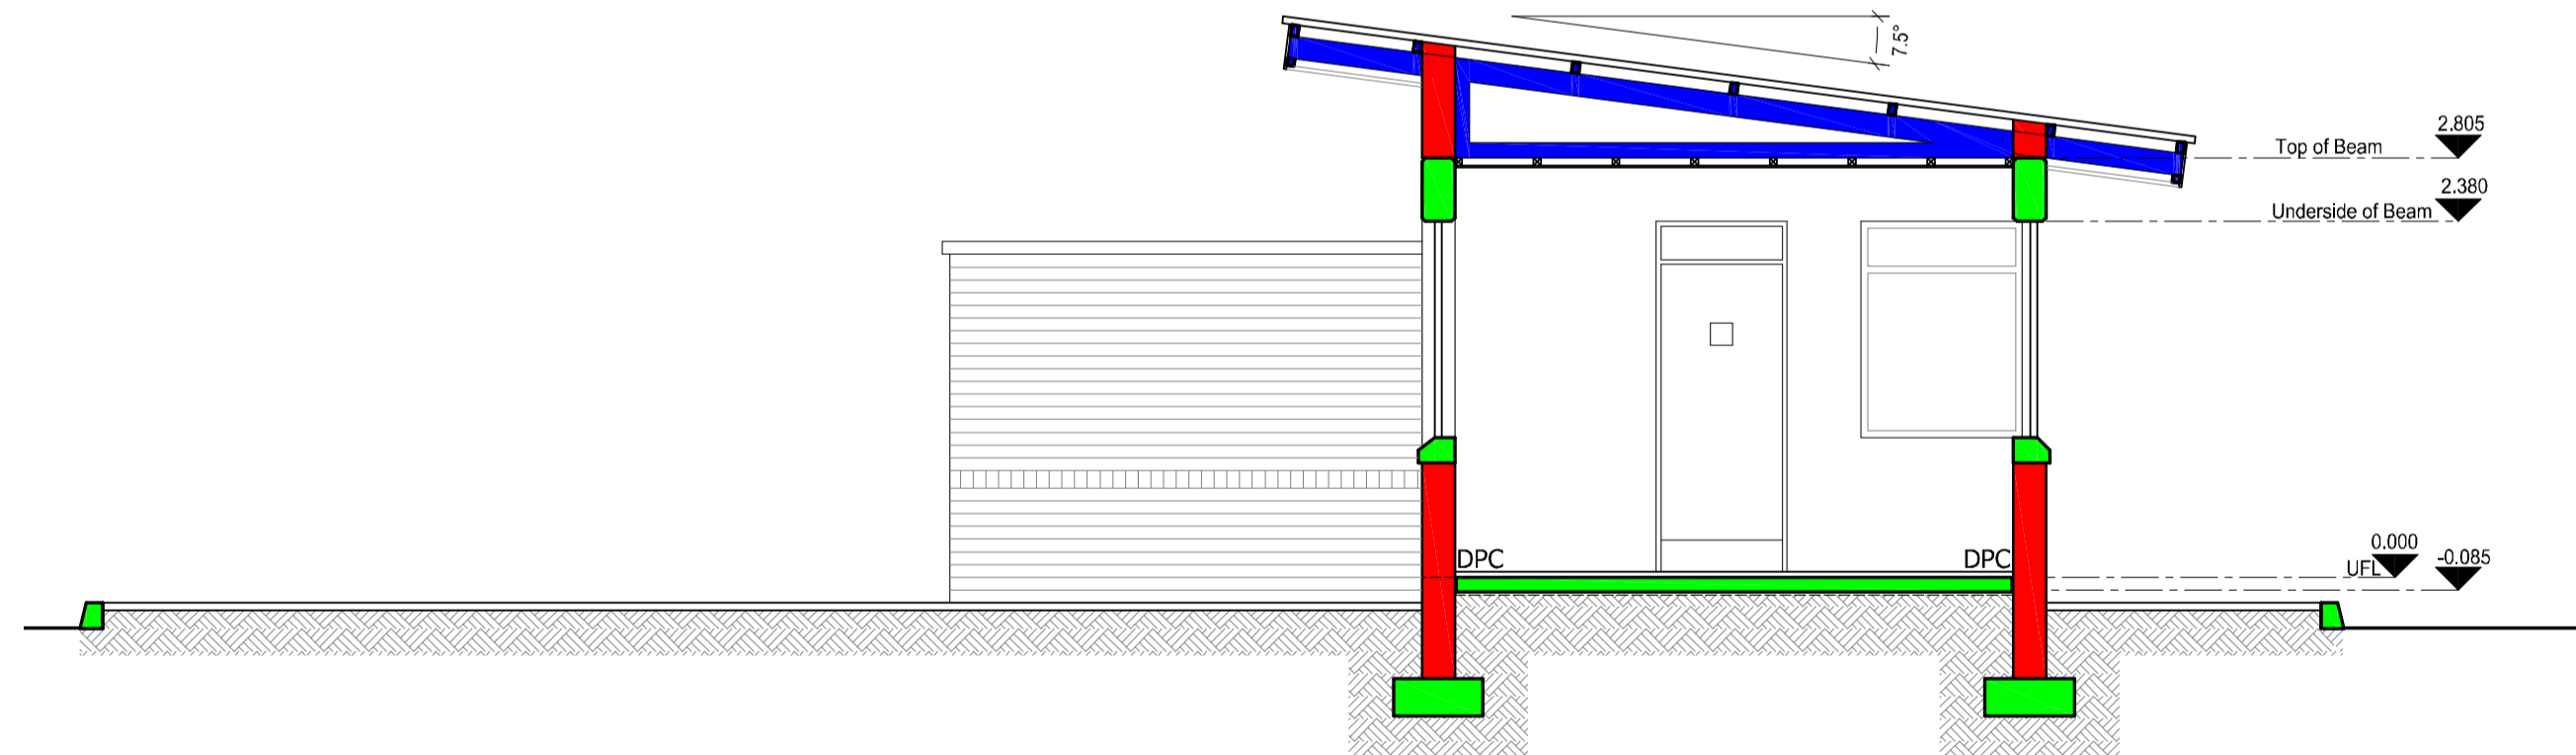


1:50 GUARDHOUSE BLOCK (D)
SECTION B-B

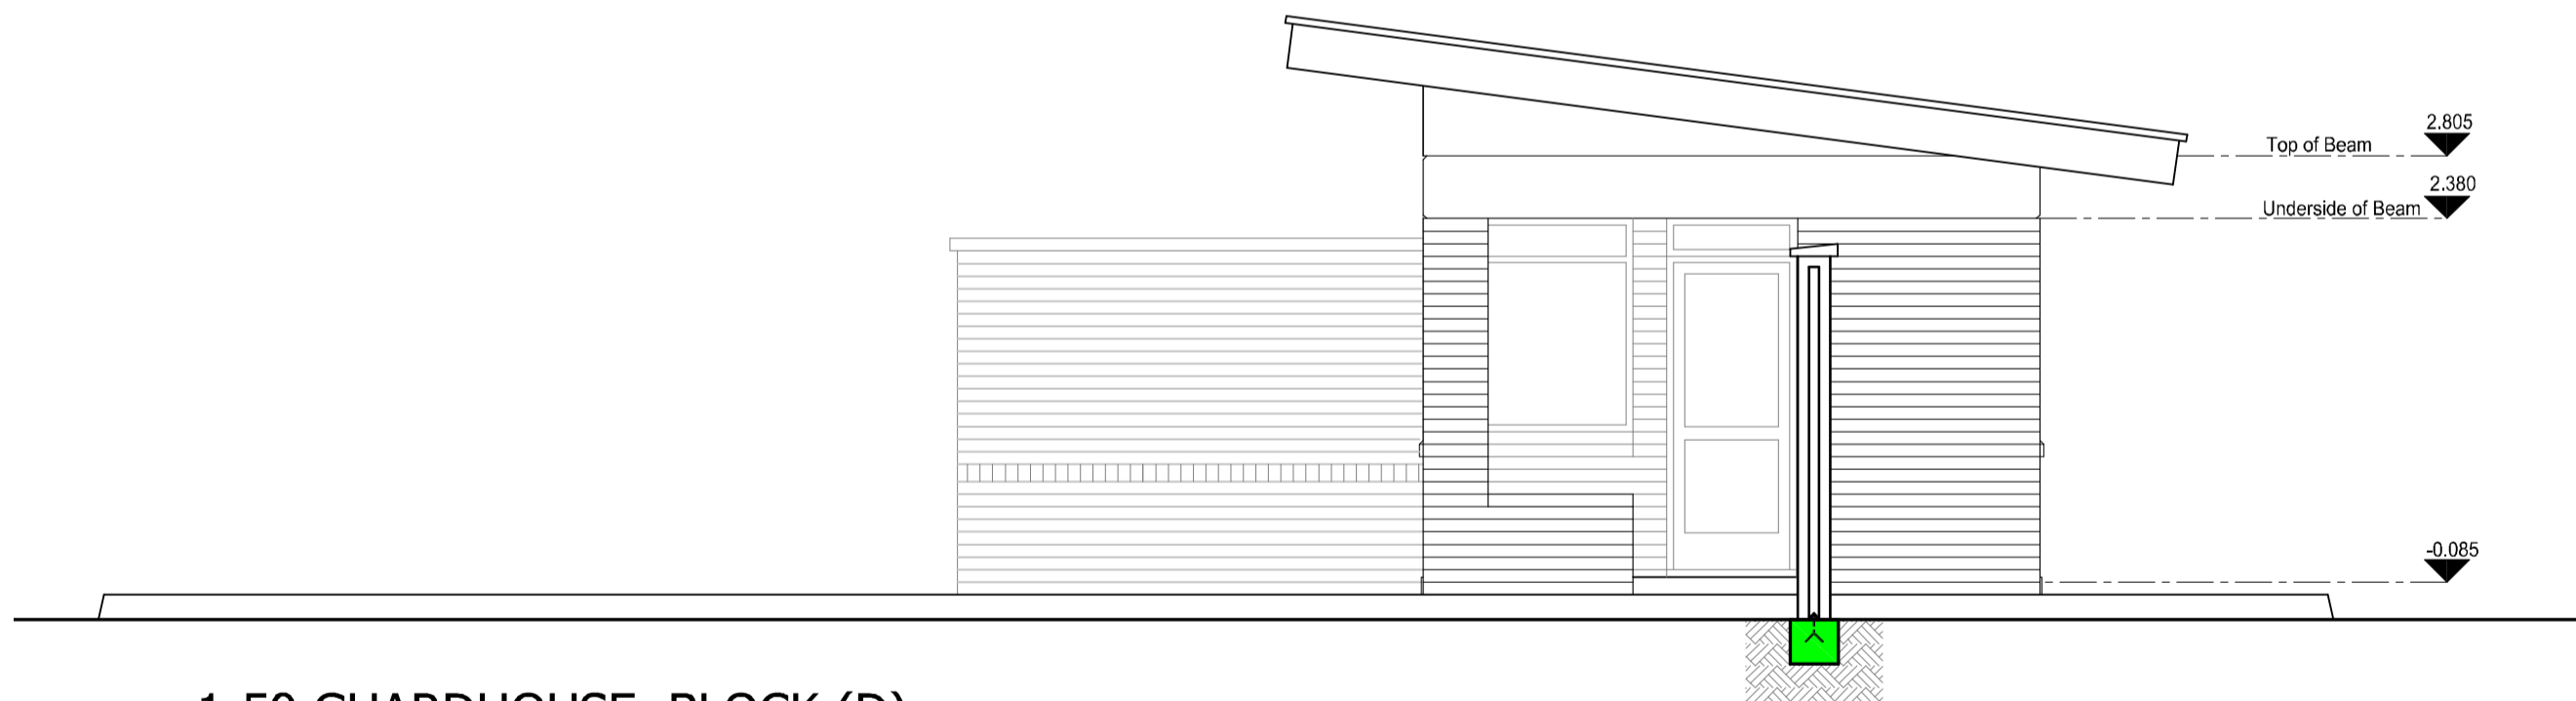

1:50 GUARDHOUSE BLOCK (D)
SECTION D-D

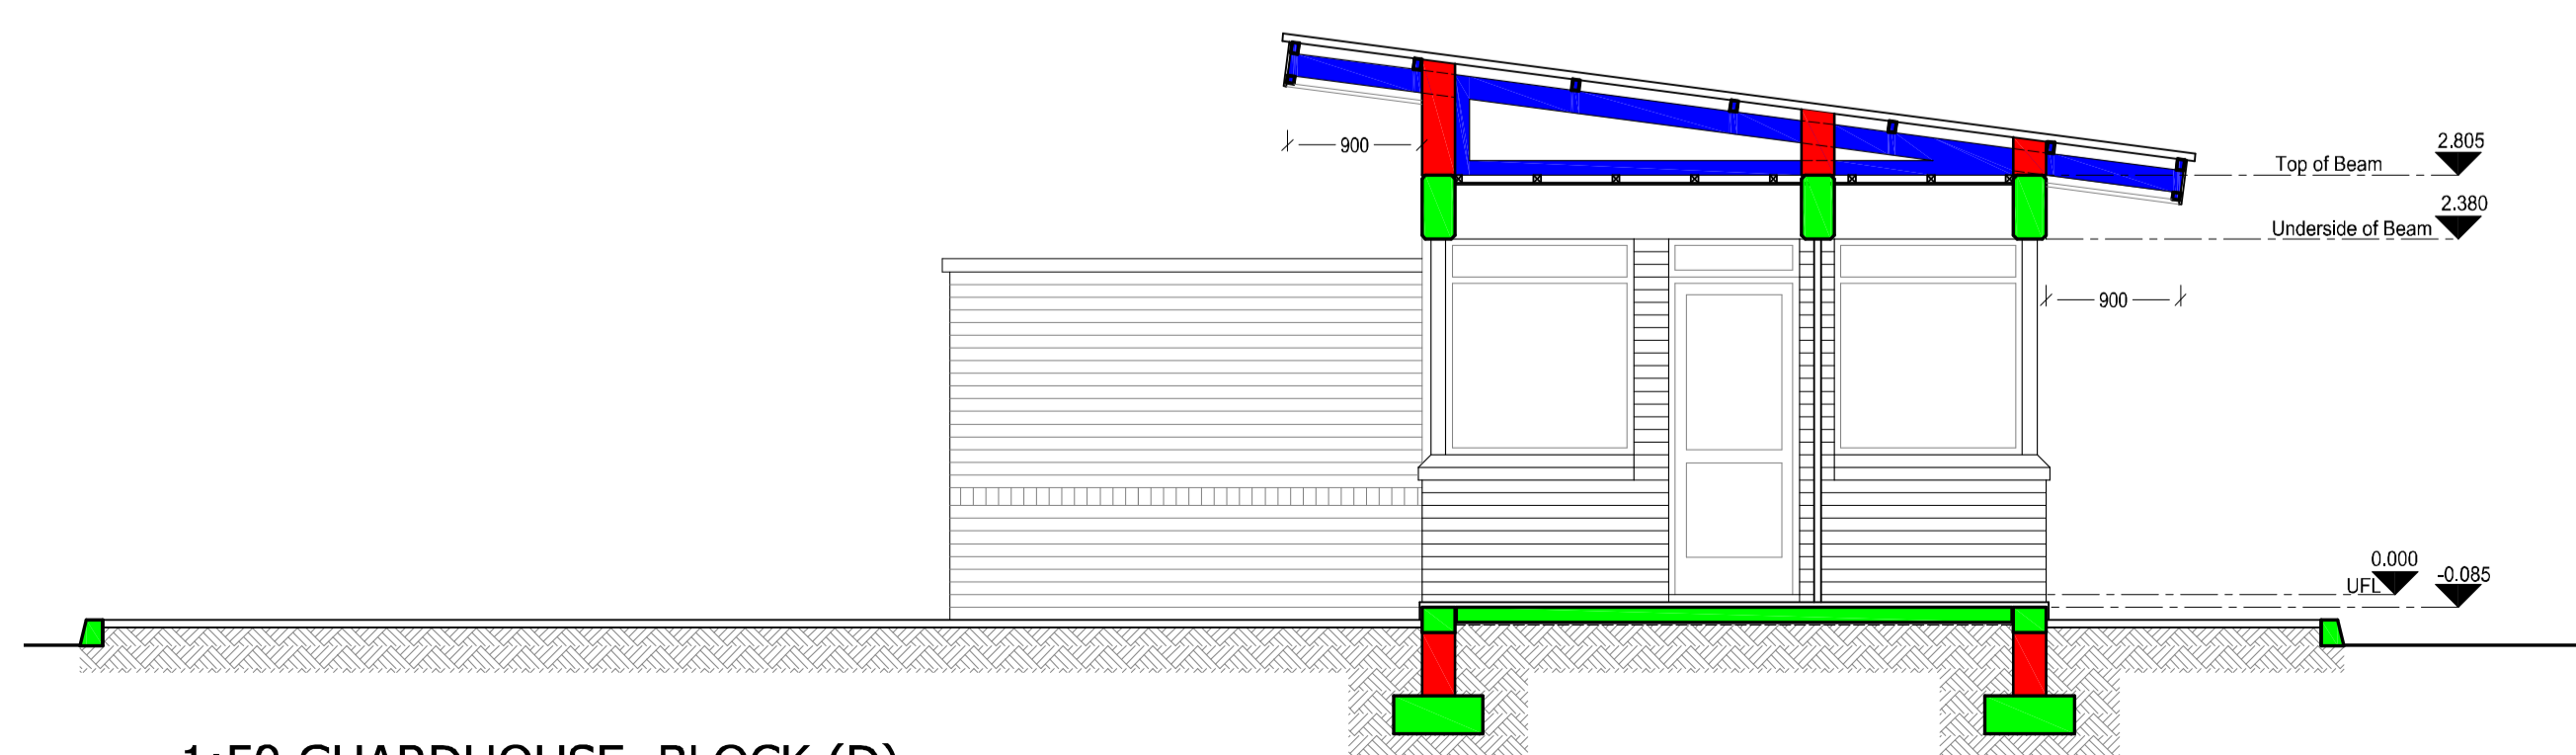

1:50 GUARDHOUSE BLOCK (D)
SECTION C-C

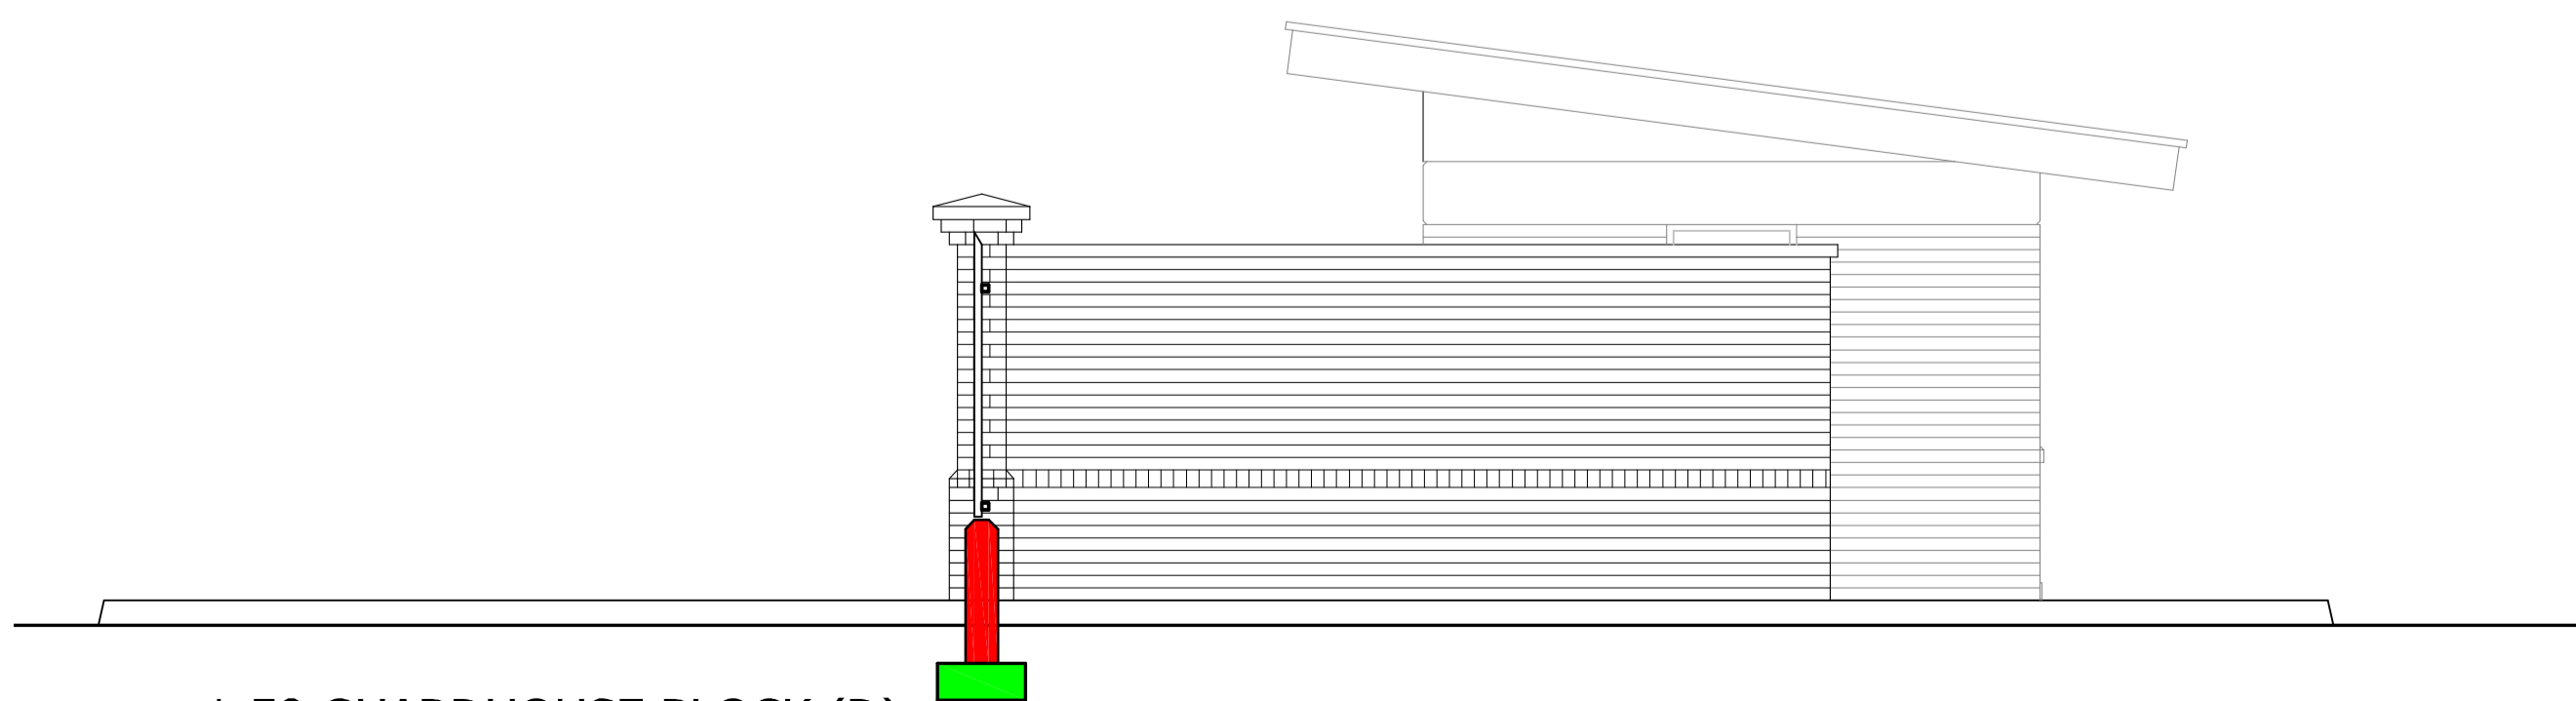

1:50 GUARDHOUSE BLOCK (D)
WEST ELEVATION

Copyright vests in the Department of Public Works
as-built drawings
Certified as-built drawings as per Centralised Drawing Archive AS-BUILT DRAWING REQUIREMENTS
name: C.D.H.SPARKS
date: _____
professional registration no.: 4661

cad file name: AMAFA SUBSTATION & GATEHOUSE.dwg page size: A 1



consultant: ARCHITECT
service: NEWCASTLE MAGISTRATES COURT: UPGRADE, RENOVATION AND EXTENSION OF CURRENT BUILDINGS NEWCASTLE, Erf 16957, 33 & 35 MURCHISON STREET.
WCS number: 45965
drawing title: BLOCK D: SECTIONS & ELEVATIONS.

ref no: _____ designed: CDHS
scale: AS SHOWN drawn: AM
date: AUGUST 2021 checked: CDHS
departmental drawing number: _____
drawing number: L12/03/D/09 (WD)

GUARDHOUSE BLOCK D SECTIONS & ELEVATIONS (IN CAD FILE) AMAFA SUBSTATION & GATEHOUSE.dwg printed on 05 Jul 2023 at 14:21:17