


1:50 GUARD HOUSE BLOCK (D)
SOUTH ELEVATION

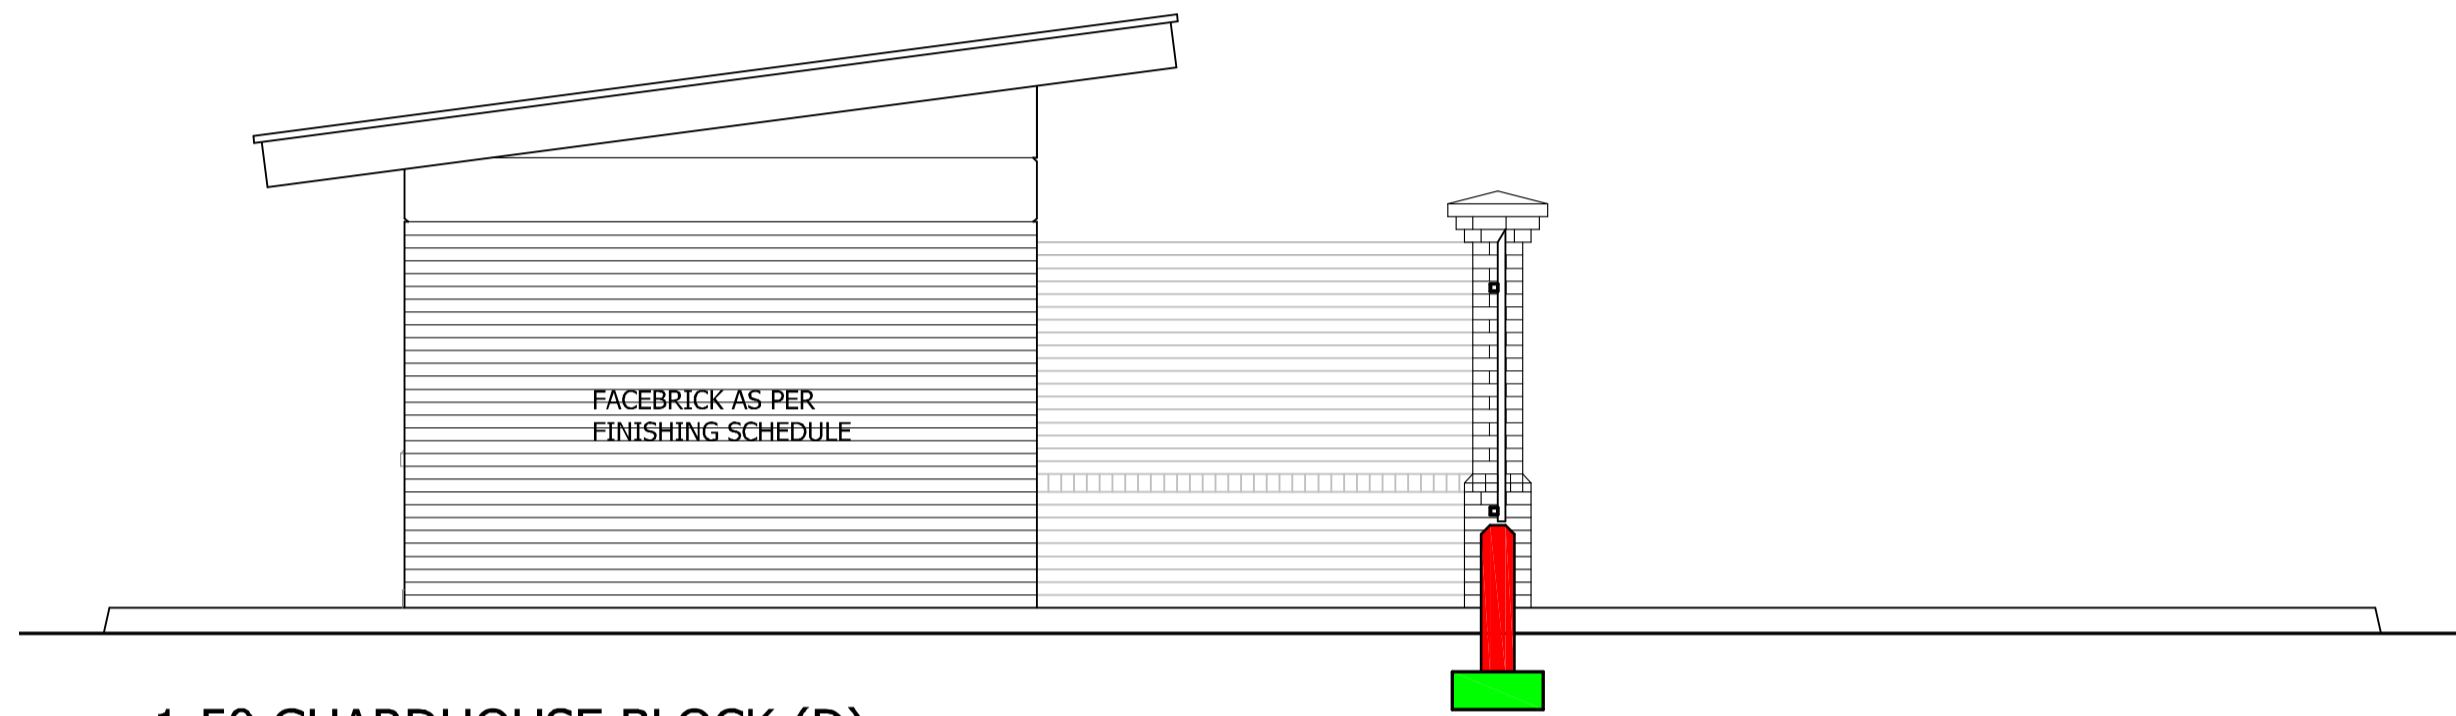

1:50 GUARDHOUSE BLOCK (D)
EAST ELEVATION

WINDOW SCHEDULE	WINDOW 1		WINDOW 2		WINDOW 3		WINDOW 4		WINDOW 5	
	SCALE 1:50	PURPOSE MADE ALUMINIUM WINDOW	PURPOSE MADE ALUMINIUM WINDOW	PURPOSE MADE ALUMINIUM WINDOW	PURPOSE MADE ALUMINIUM WINDOW	PURPOSE MADE ALUMINIUM WINDOW	PURPOSE MADE ALUMINIUM WINDOW	PURPOSE MADE ALUMINIUM WINDOW	PURPOSE MADE ALUMINIUM WINDOW	PURPOSE MADE ALUMINIUM WINDOW
WINDOW NO:	W1	W2	W3	W4	W5					
QUANTITY:	1	1	2	1	1					
GLAZING:	6.4mm LAMINATED SAFETY GLASS. (OBSCURED IN ALL BATHROOMS & TOILETS)	6.4mm LAMINATED SAFETY GLASS.	6.4mm LAMINATED SAFETY GLASS.	6.4mm LAMINATED SAFETY GLASS.	6.4mm LAMINATED SAFETY GLASS.					
FURNITURE:	AS SUPPLIED BY MANUFACTURER.	AS SUPPLIED BY MANUFACTURER. POWDER COATED ALUMINUM BURGLAR BARS AS SUPPLIED BY DUROWIN, OVER ALL OPENING SECTIONS.	AS SUPPLIED BY MANUFACTURER. POWDER COATED ALUMINUM BURGLAR BARS AS SUPPLIED BY DUROWIN, OVER ALL OPENING SECTIONS.	AS SUPPLIED BY MANUFACTURER. POWDER COATED ALUMINUM BURGLAR BARS AS SUPPLIED BY DUROWIN, OVER ALL OPENING SECTIONS.	AS SUPPLIED BY MANUFACTURER. POWDER COATED ALUMINUM BURGLAR BARS AS SUPPLIED BY DUROWIN, OVER ALL OPENING SECTIONS.					
FINISH:	POWDER COATED ALUMINIUM. COLOUR TO ARCHITECT.	POWDER COATED ALUMINIUM. COLOUR TO ARCHITECT.	POWDER COATED ALUMINIUM. COLOUR TO ARCHITECT.	POWDER COATED ALUMINIUM. COLOUR TO ARCHITECT.	POWDER COATED ALUMINIUM. COLOUR TO ARCHITECT.					

NOTE:
ALL QUANTITIES TO BE CHECKED AND VERIFIED BY QUANTITY SURVEYOR. DIMENSIONS TO BE CHECKED ON SITE PRIOR TO MANUFACTURING.

ALL DIMENSIONS ARE TO BE CHECKED ON SITE PRIOR TO CONSTRUCTION TAKING PLACE. ANY DISCREPANCY BETWEEN ARCHITECTS DRAWINGS, ENGINEERS DRAWINGS AND THE BILLS OF QUANTITIES ARE TO BE CLARIFIED WITH THE ARCHITECT. ALL PRODUCT SPECIFICATION CODES ARE TO BE CHECKED WITH THE SUPPLIER PRIOR TO THE ORDERING AND BUILDING IN OF MATERIAL. ALL STRUCTURE TO BE CHECKED BY THE ENGINEER.

NO.	DATE	AMENDMENT	D.P.N.

Copyright vests in the Department of Public Works

as-built drawings

Certified as-built drawings as per Centralised Drawing Archive AS-BUILT DRAWING REQUIREMENTS

name: C.D.H.SPARKS

date: _____

professional registration no.: 4661

cad file name: AMAFA SUBSTATION & GATEHOUSE.dwg page from: A 1



consultant: ARCHITECT

WORKS:
NEWCASTLE MAGISTRATES COURT: UPGRADE, RENOVATION AND EXTENSION OF CURRENT BUILDINGS
NEWCASTLE, Erf 16957, 33 & 35 MURCHISON STREET.

WCS number: 45965

drawing title: BLOCK D: ELEVATIONS & WINDOW SCHEDULE.

ref.no: _____ designed: CDHS
scale: AS SHOWN drawn: AM
date: AUGUST 2021 checked: CDHS
departmental drawing number: _____
drawing number: L12/03/D/10 (WD)

GUARDHOUSE BLOCK D ELEVATIONS & WINDOW SCHEDULE (IN CAD FILE) AMAFA SUBSTATION & GATEHOUSE.dwg printed on 05 Jul 2023 at 14:21:55