
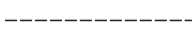
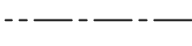

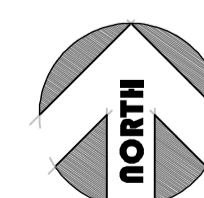
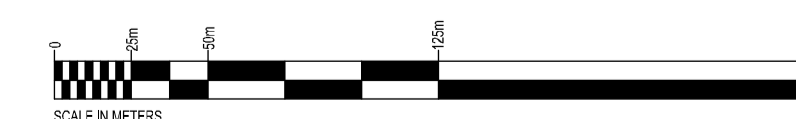


LEGEND:

-  EXISTING BUILDINGS
-  SURROUNDING CONTEXT
-  FARM BOUNDARY
-  BUILDING LINE



DETAIL SITE LAYOUT PLAN



PROJECT DIRECTOR

SIGNATURE DATE

PROJECT MANAGER

SIGNATURE DATE CONSULTANT

**DESTUDIO**



Architects & Urban Planners

DEJONG DESIGN STUDIO CC Trading as DESTUDIO Reg no.: CK 2006/1157/1/23  
 6 Plettenberg Street Dan Pienaar 9310  
 +27 (0) 51 436 1177 studio@dejongdesign.co.za  
 Adèle de Jong Pr. Arch 21159, Pr. Pln A/1423/2011 +27 (0) 84 400 9364  
 Alphonse de Jong Pr. Arch 7532 +27 (0) 82 946 0777

CLIENT

W. BASSON

PROJECT

PERMIT APPLICATION: PORTION 4 OF THE FARM PALMIET NO. 585

DRAWING

SITE PLAN SHOWING EXISTING BUILDINGS

SURVEYED	DATE
SURVEYED PLOTTED	DATE
DRAWN	CHECKED
A.d.J	2015-06-11
SCALE	REVISION
AS SHOWN	REV 0

DRAWING No  
**15-117-02**