


- AMENDMENTS:
1. STORE RMS. ADDED ADJACENT KITCHENS.
 2. PARTY WALL ADDED TO SERVICE YARD.
 3. SOUTH WEST BOUNDARY WILL CHANGE TO 230 BRICK
 4. PARTY WALL ADDED TO FRONT YARD.
 5. FRONT VERANDAHS ENCLOSED TO FORM STORE RMS
 6. UNIT 35 NOW HAS SEPARATE LITTER CONNECTION
- 83-11-02.
 M. N. C. [Signature]

FRONTAGE LEVEL REQUIREMENTS
 Type of foundations of any frontage walls to be at least 0.23m below the levels given below.
 Where no level is required, foundations shall not be higher than the nearest edge of the adjacent hardened road.
 Vehicular and pedestrian surfaces on the road reserve boundary shall be constructed on the same grade as the level of road and shall abutment to front of existing footpath.
 (a) above/below ground existing level. (b) above/below the ground level of the boundary.
 Date: _____ Signature: _____
 It is confirmed:
 (A) Existing frontage level is under.
 (B) Existing frontage level NOT IN ORDER.
 (C) Underlying frontage to be submitted.
 Date of Second Creation: _____ Signature: _____


AS BUILT
 TOWN PLANNING BRANCH
 APPROVED
 DATE 27 MAR 1984
 Signature: [Signature]

AMENDMENTS TO APPROVED
 PLAN NO. 1055/5/81
 DATED 1982-03-09
 SUB 53 OF 7 OF BLOCK C
 TOWNLANDS OF DURBAN 1737
 AT 33-35 RYDE AVE DURBAN
 REGISTERED OWNER
 B. TAVARES 33 RYDE AVE DURBAN
 SIGNED: [Signature]
 DRAWN BY
 M.A.N.P. CRETIKOS, ARCHITECT M.A.
 77 ST. THOMAS RD. DURBAN, 400T.
 TEL. 213082, 3103973
 SIGNED: M. N. C. [Signature]
 DRAWINGS NO. MANPC19831102.
 DATE 1983-11-02.
 SCALE AS SHOWN.
 AMENDMENT 4

SOUTH EAST ELEVATION TO OUTBLDG.

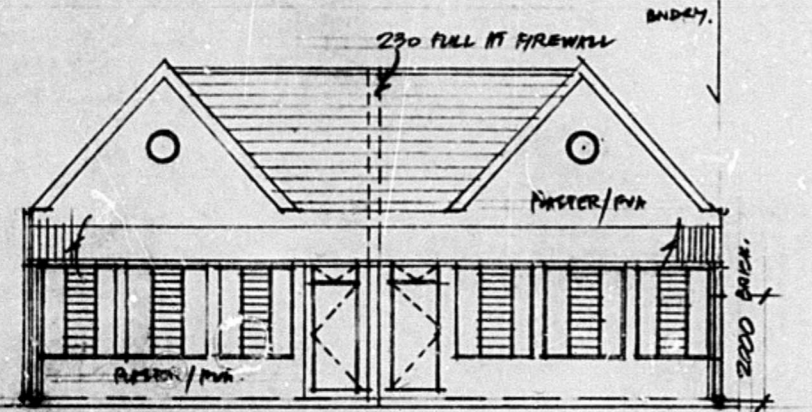


NORTH WEST ELEVATION.

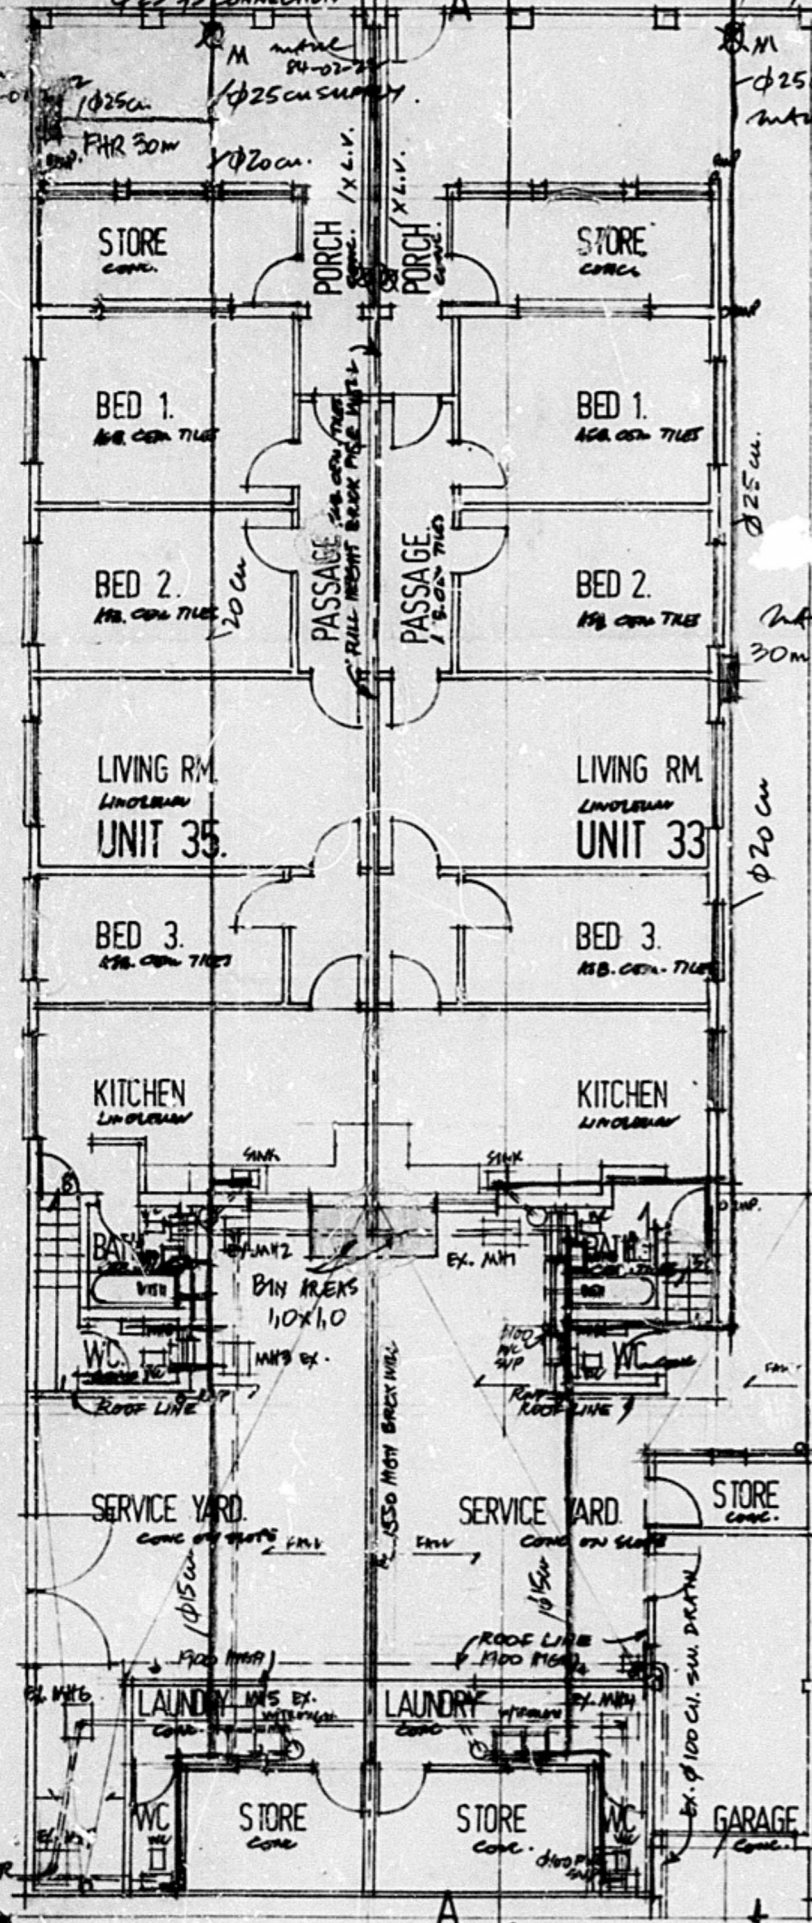


PLAN scale 1/100.


SOUTH WEST ELEVATION

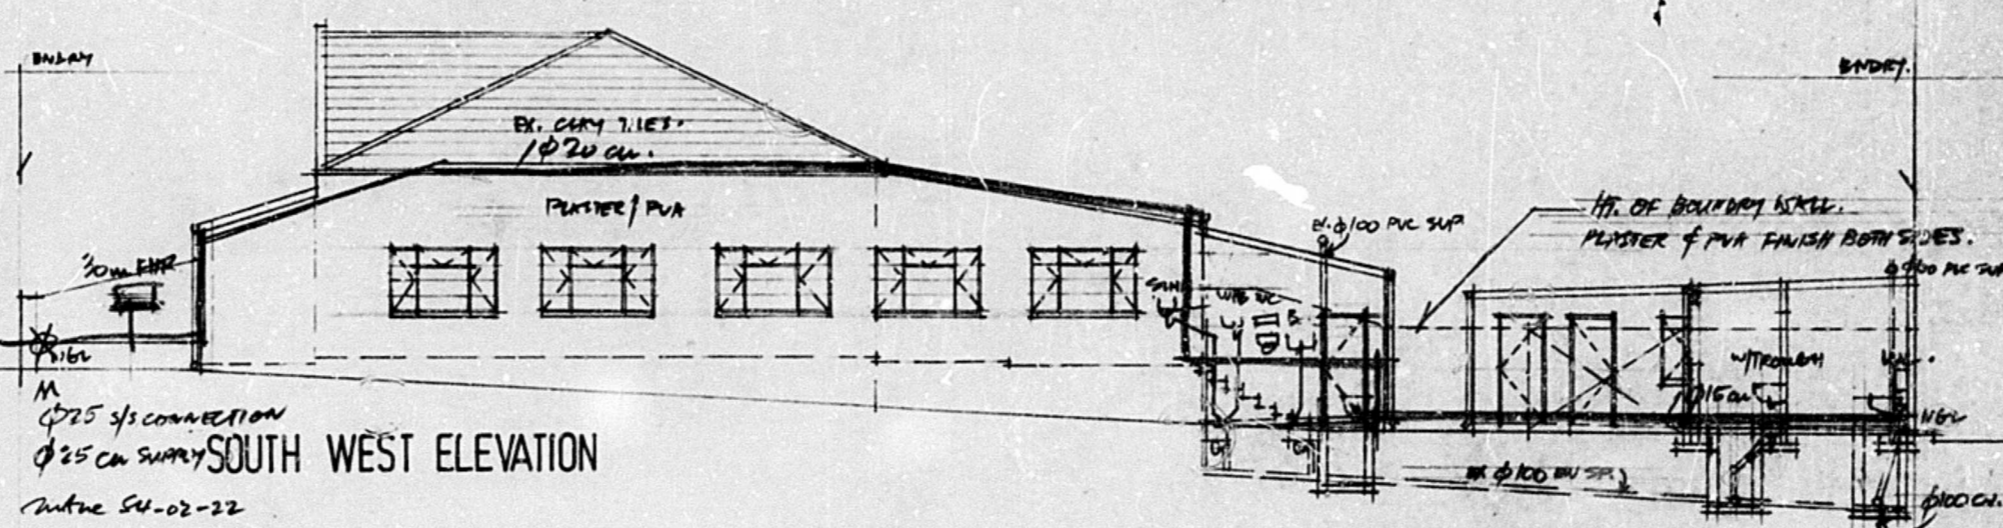


NORTH EAST ELEVATION

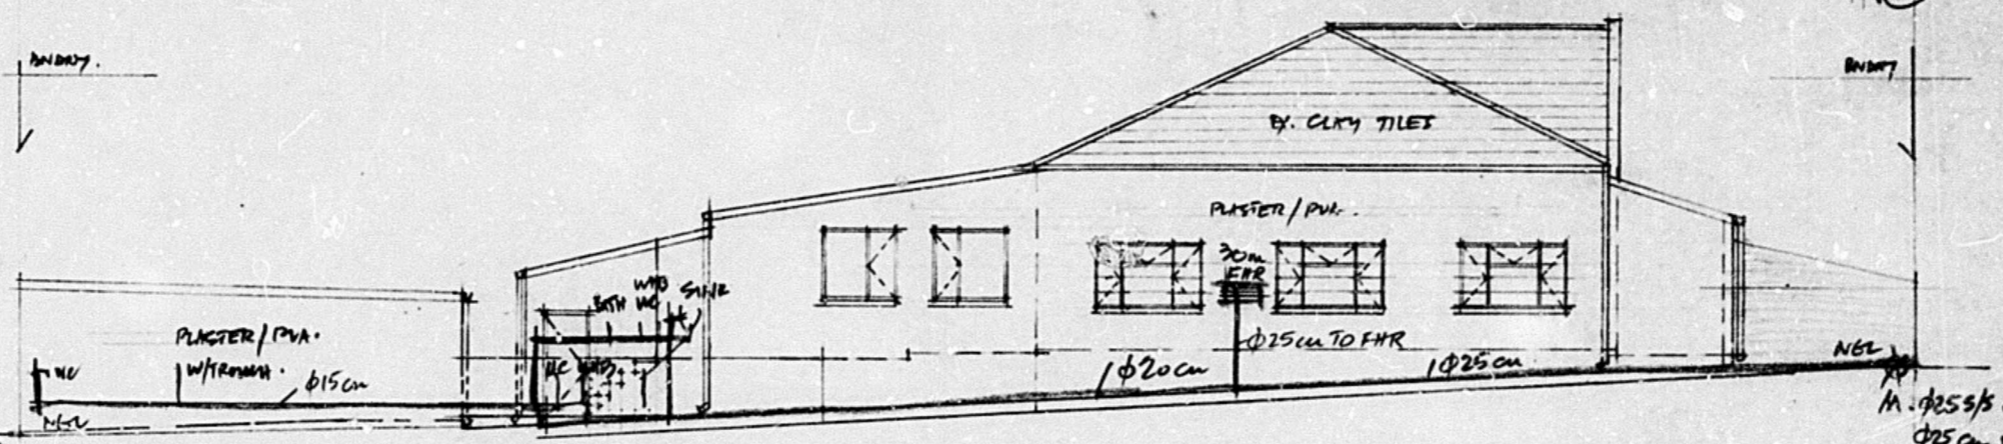


SECTION A-A

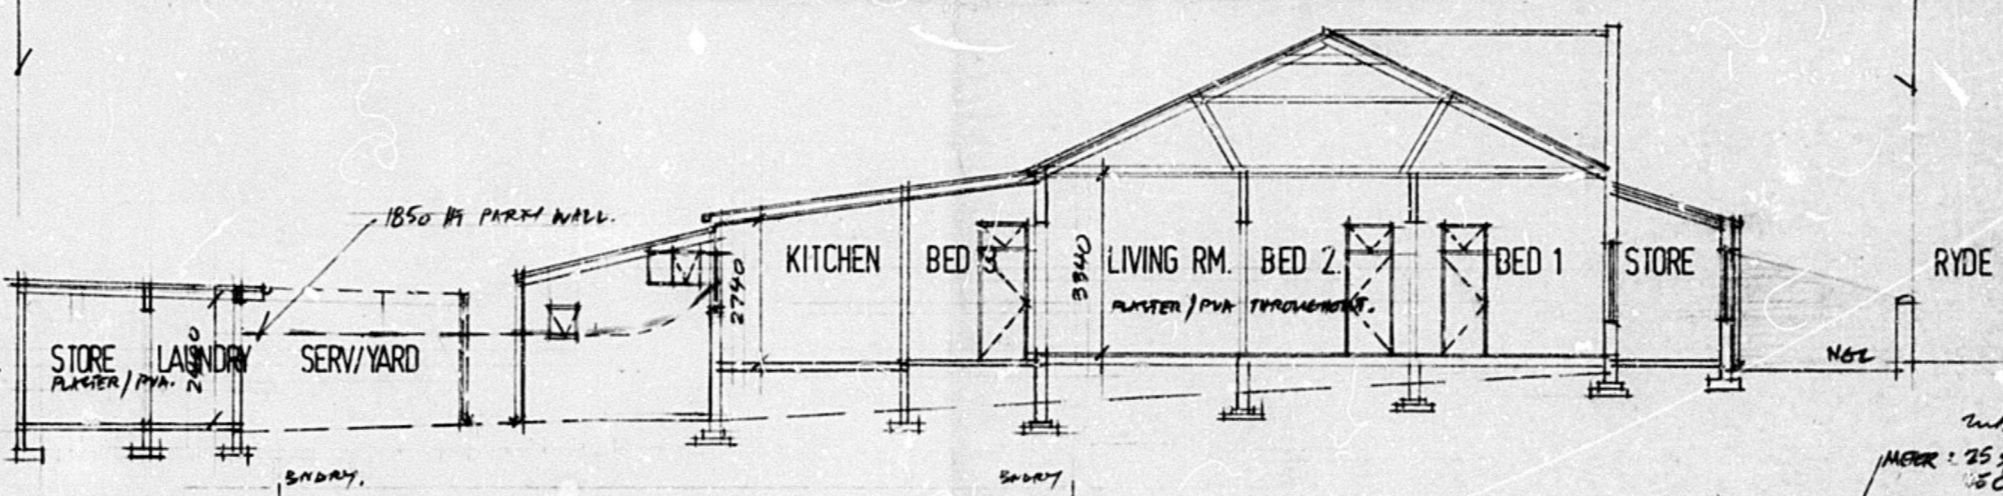

NORTH WEST ELEVATION

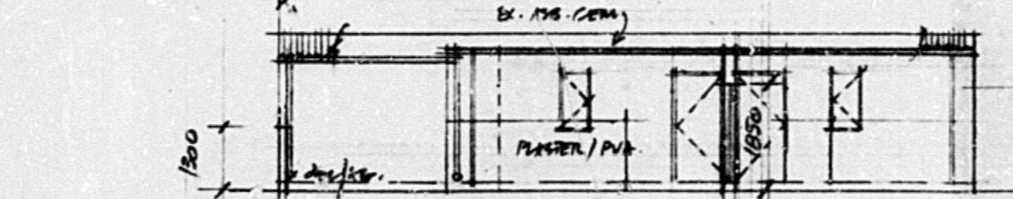

SOUTH EAST ELEVATION.

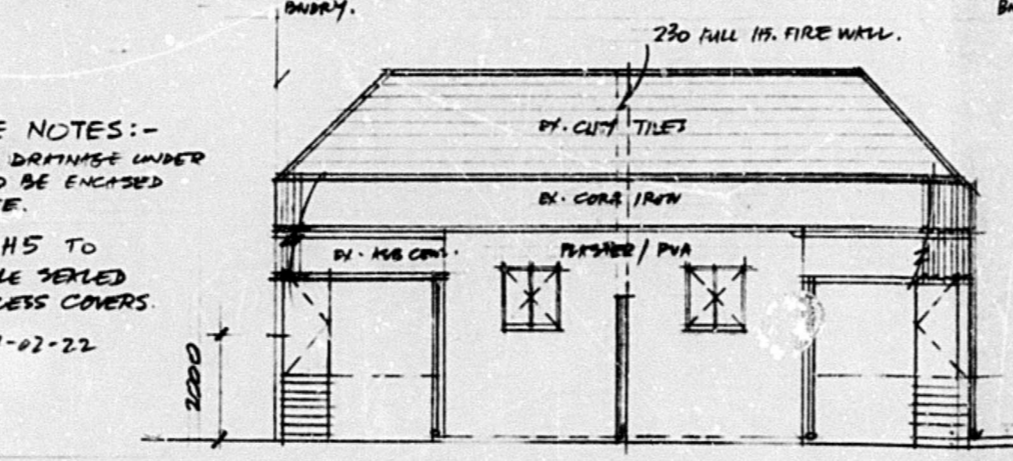

- DRAINAGE NOTES:-
1. SECTIONS OF DRAINAGE UNDER BUILDINGS TO BE ENCASED IN CONCRETE.
 2. MHH & MHS TO HAVE DOUBLE SERLED BOLTED ACCESS COVERS.

NOTE:
 DRAWINGS TO FALL ON FIRST SERVICE AREA TO 100 C.I. OUTLET TO CURB AT CORNER OF GARAGE.



SITE PLAN scale 1/500.

BUILDING AREA = 344.59 m²
 SITE AREA = 556.60 m²

NO ADDITIONAL PAPER