

INCORPORATING
APPROVED PLAN

No. 148/10/64 APP. 30/5/65

No. 07/10/65 APP. 28/1/65

No. APP.


No. APP.

No. APP.


No. APP.

AS BUILT


11/7/65

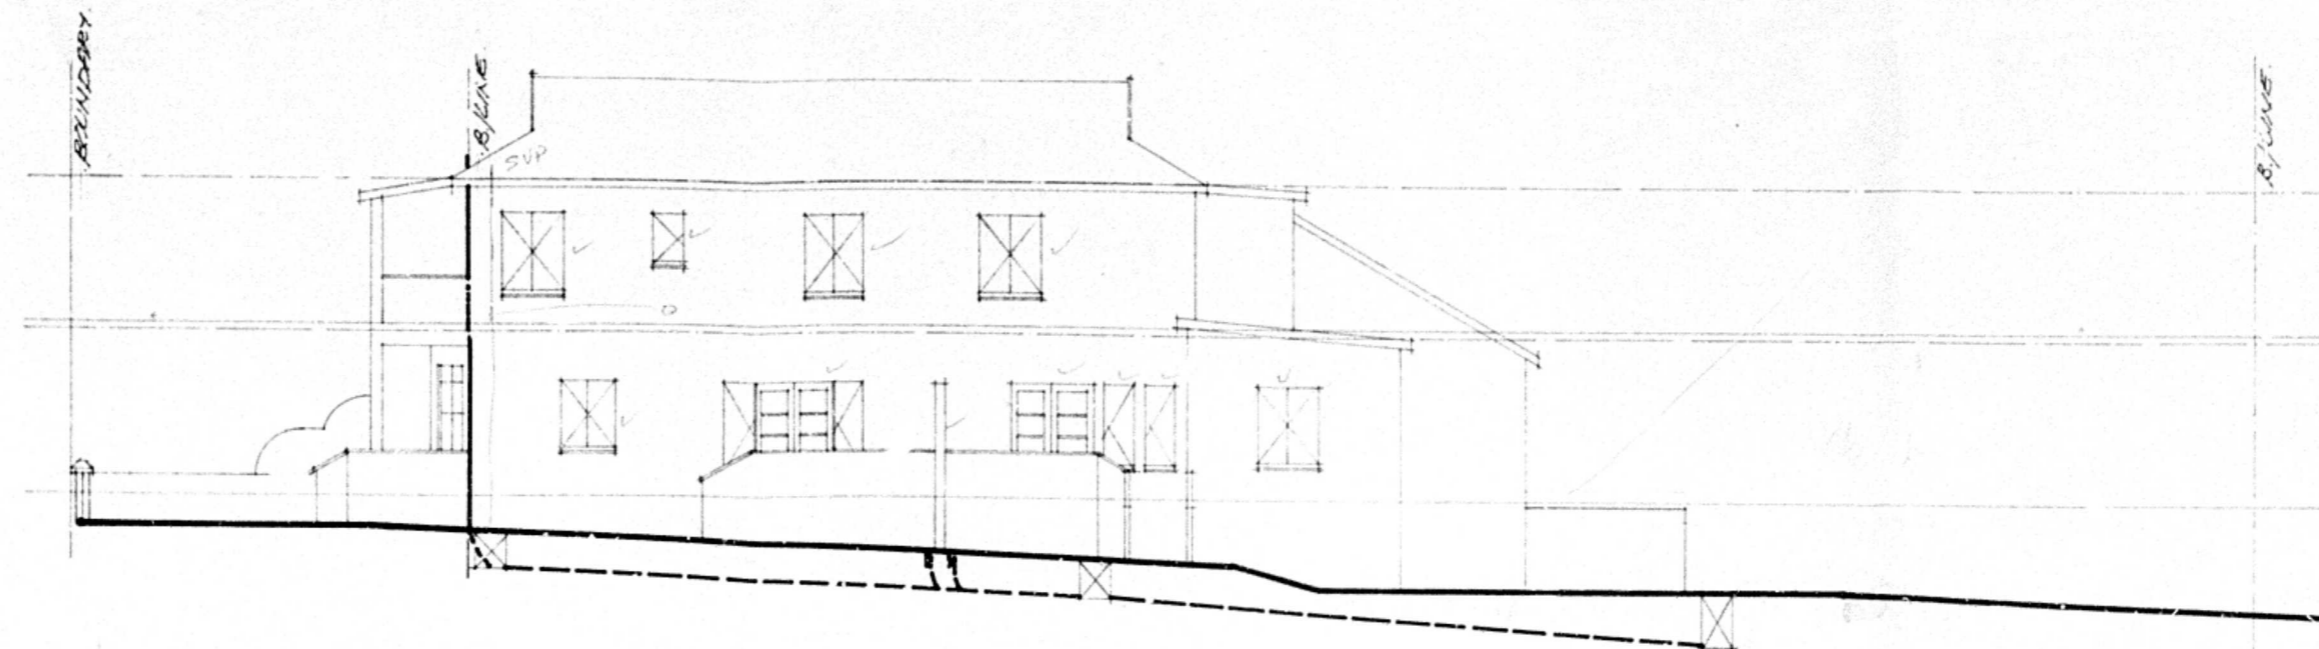


● south east elevation

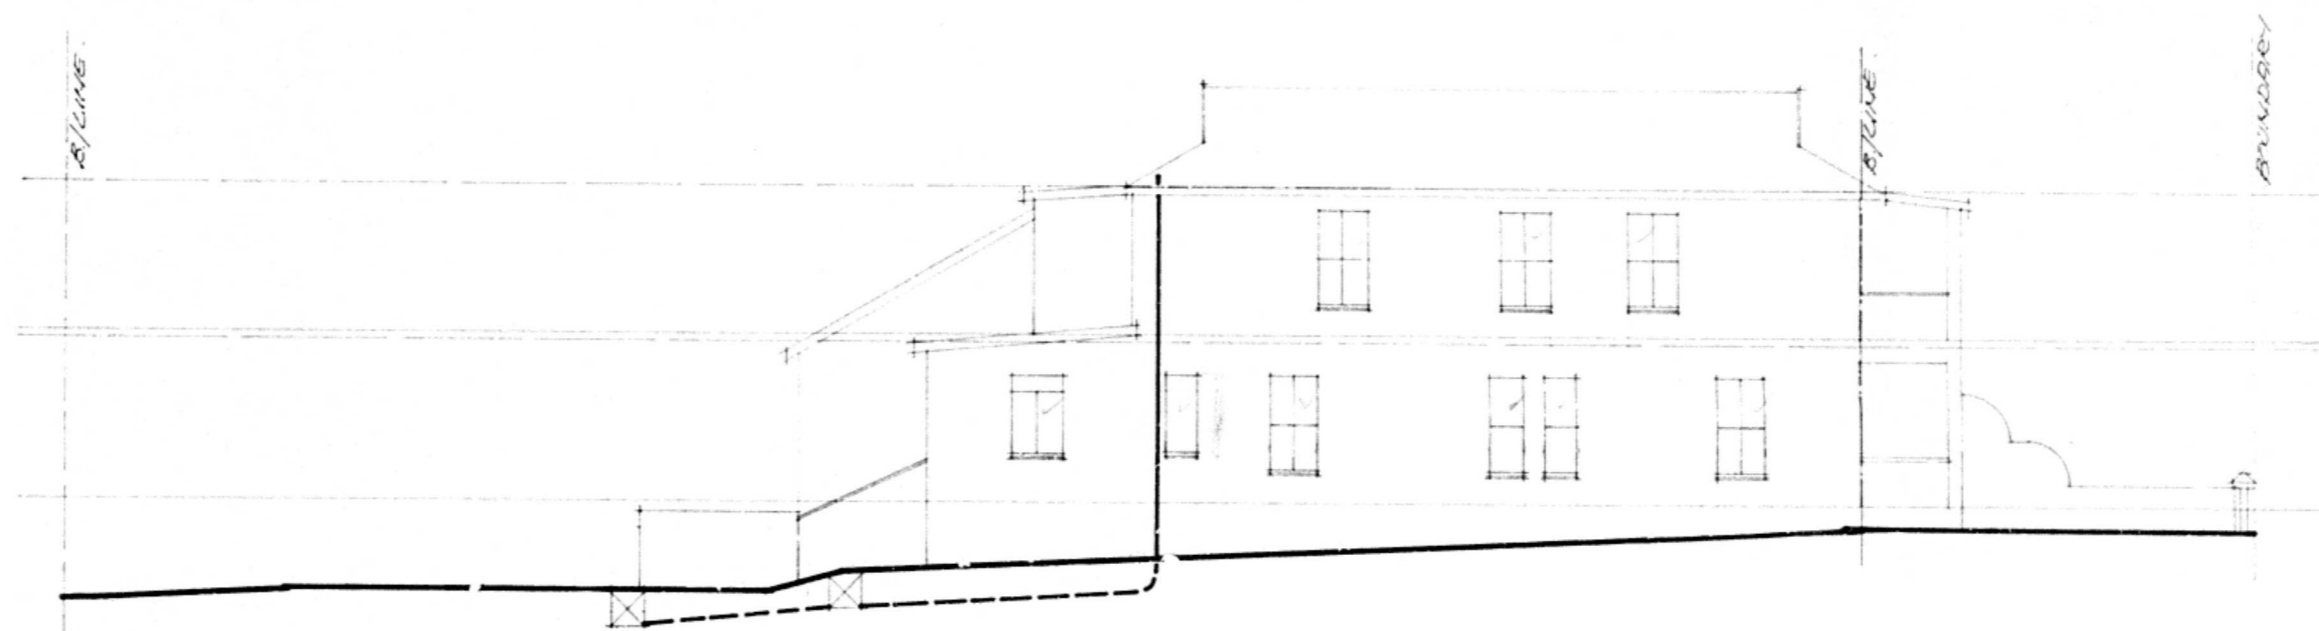

● north west elevation

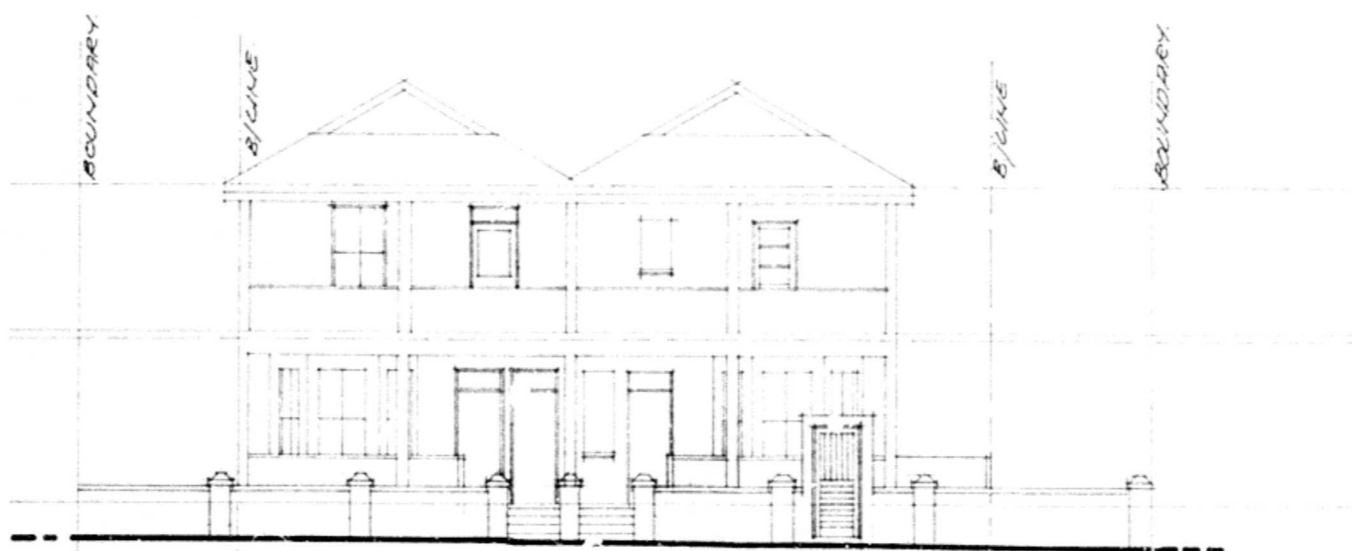

● south west elevation

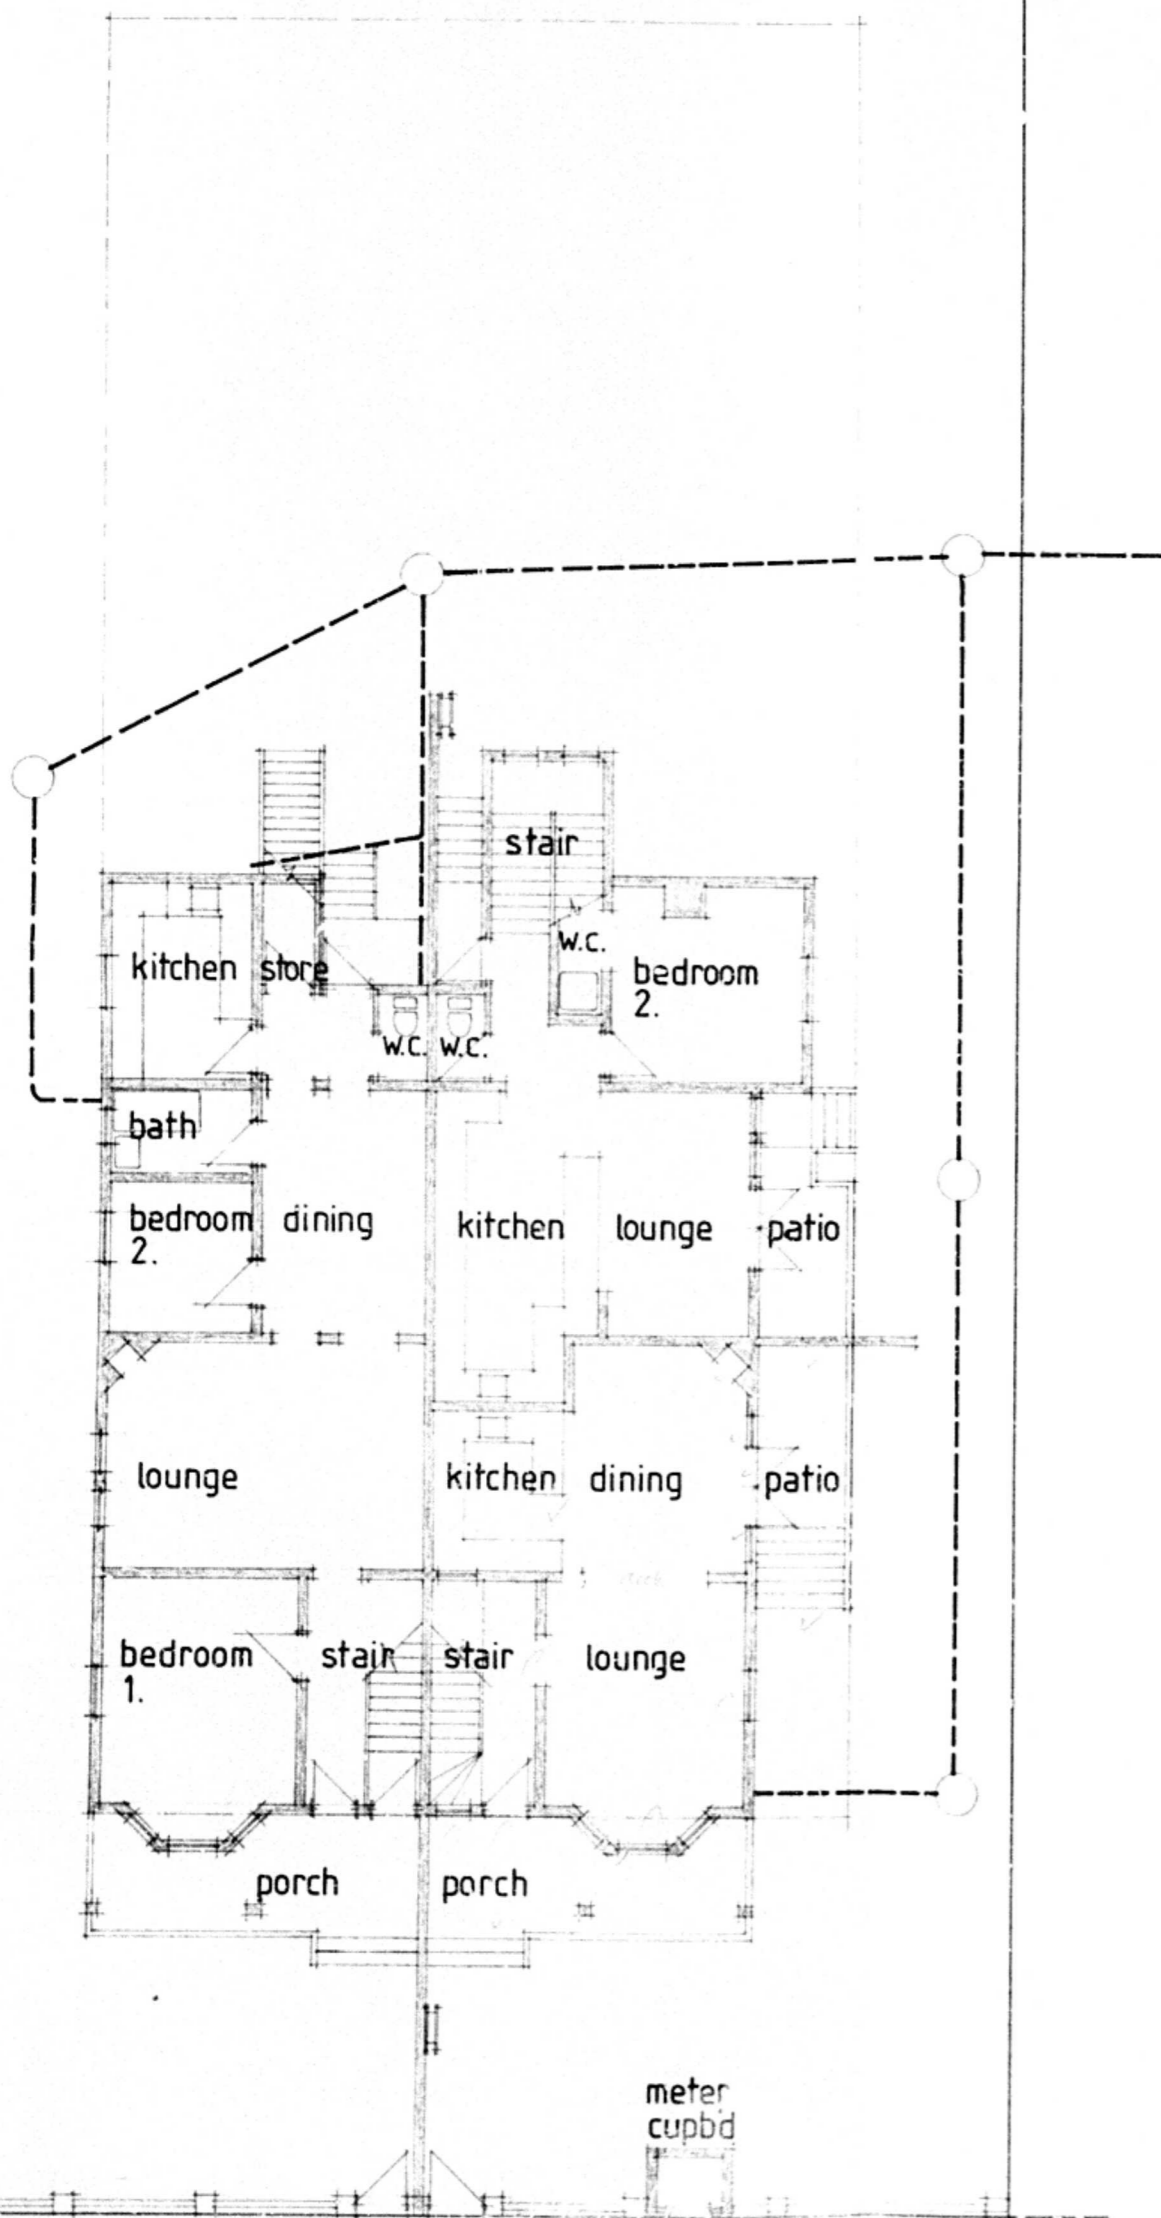

● ground floor plan

proposed as built drawings
for mr j. d. dold
at 26-32 clark road
durban

DOLD *J.O.A.U.*

design
for modern
living

dwg no
444-3.

scale 1:100 (date) FEB '66 *J.O.A.U.*