

| | |
|--------------------------------|--------|
| SHEET 11 | COPY 1 |
| CITY OF DURBAN | |
| PLAN No. 220/11/77 | |
| APPROVED 28 NOV 1977 | |
| DATE | |
| D. C. MACLEOD CITY ENGINEER | |
| PER <i>[Signature]</i> | |

IMPORTANT

APPLICATION FOR REFUND OF PORTION OF BUILDING FEES ON ABANDONED PLANS MUST BE RECEIVED BY THE CITY ENGINEER'S DEPARTMENT BEFORE FOURTEEN (14) DAYS PRIOR TO THE EXPIRY DATE OF APPROVAL OF THIS PLAN.

PRECAST CONCRETE GARDEN WALLS ON BOUNDARIES

BOUNDARY BEACONS TO BE EXPOSED AND POINTED OUT TO THE DISTRICT BUILDING INSPECTOR BY THE APPLICANT BEFORE ERECTION OF THE GARDEN WALLS ARE COMMENCED. THE BEACONS SHALL REMAIN EXPOSED AFTER COMPLETION OF THE WORK FOR A FINAL INSPECTION.

ORIGINAL
AS BUILT

Notes

THE LEVEL OF SOIL ON EITHER SIDE OF THE P-C-F TO BE THE SAME FOR A MINIMUM DISTANCE OF .305m EXCEPT WHERE P-C-F RETAINS NO MORE THAN .305m - FAIR FACE TO ROADWAY -

| LOCATION | TYPE | LENGTH | HEIGHT |
|----------|------------------|--------|--------|
| A TO B | ALT FLORENCE R/B | 9.5m | 1.8m |
| B TO C | " | 7.1m | 1.5m |
| C TO D | " | 7.1m | 1.2m |
| D TO E | " | 8.7m | 0.9m |
| E TO F | " | 7.4m | 0.9m |

Scale: As indicated Metres

New precast concrete fence for:

D BOTHA



Registered postal address:
104 CATO ROAD GLENWOOD

Registered site description:
C OF 1 OF 2 OF E TOWNLEND


Drawn by *P. J. Rankin* Date 17-10-77

CONRITE WALLS PTY

2, Schwegmann Rd. New Germany
Telephone 726821

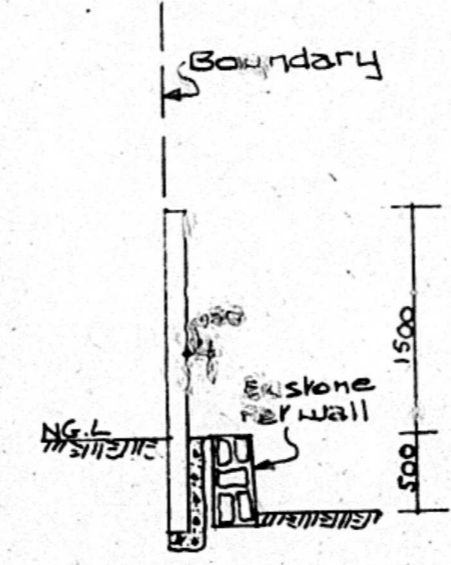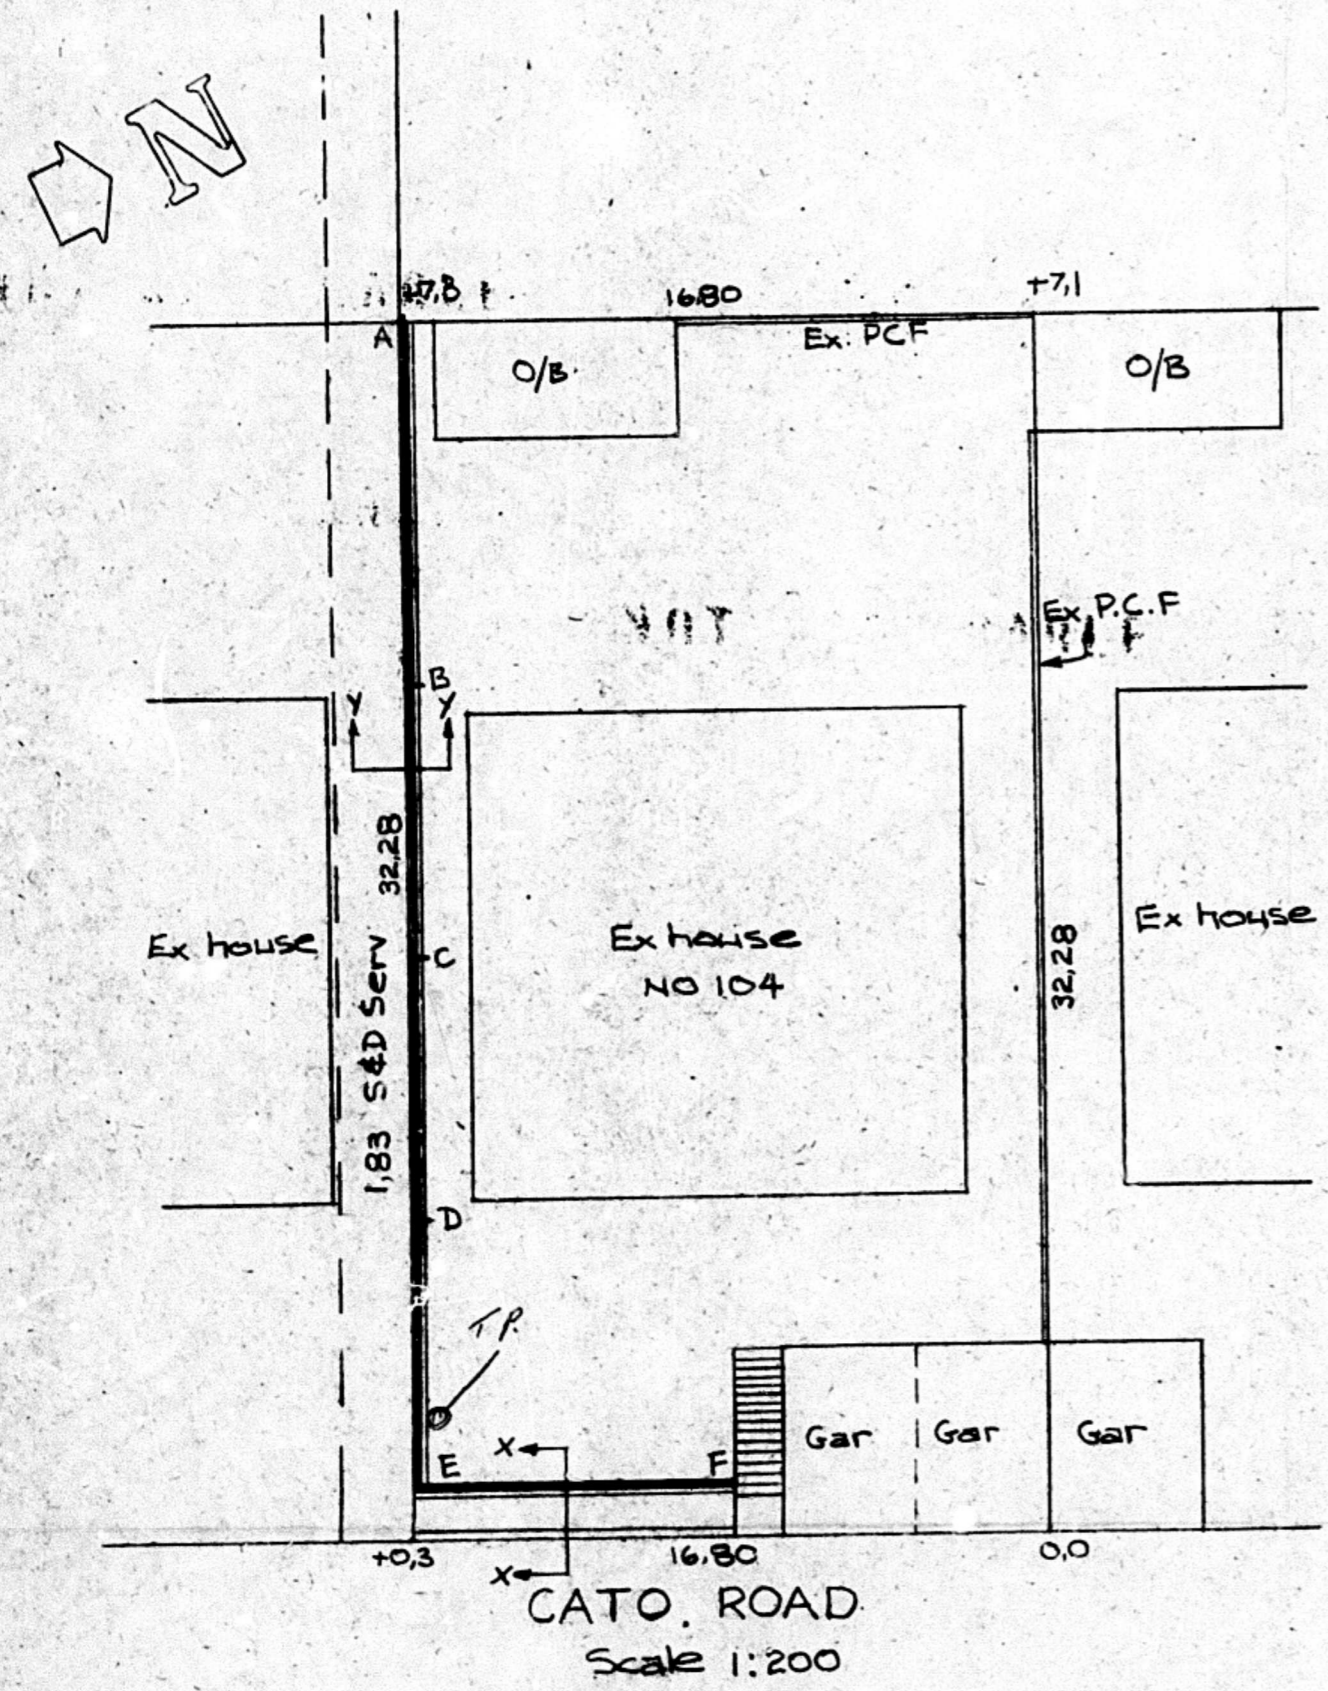

SECTION Y-Y
Scale 1:50

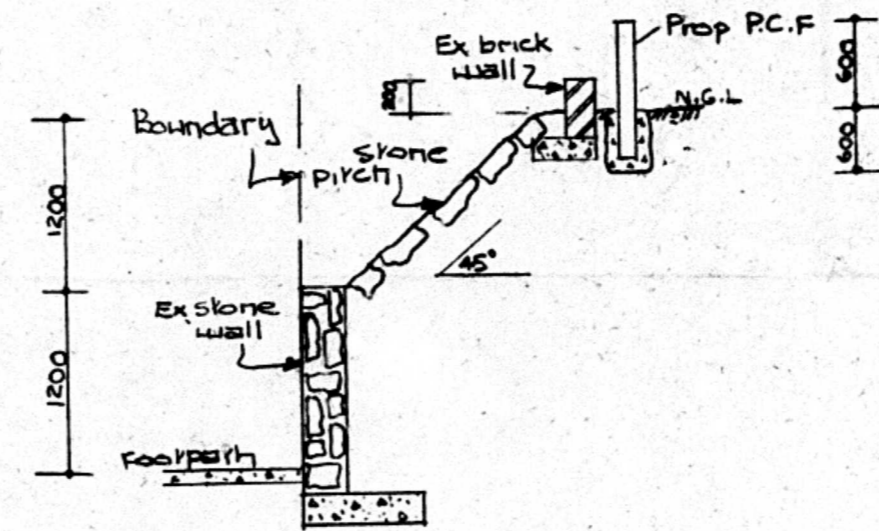

SECTION X-X
Scale 1:50

