

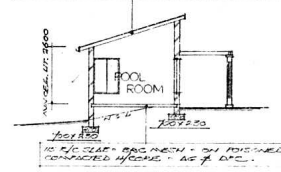


POOL ROOM ELEVATIONS


ROOF: THESE TILES TO MATCH ROSE OF RESIDENCE, ON 18 x 18 PATTERNS ON CEILING. BARRELS ARE QUARTZ ON ROOF. TILES TO BE BOARDING ON 300 x 50 P.L.R. THE BARRELS TO BE 200 x 200. ALIGNMENT GUTTERS, DRAIN & FACIAL, MATCH ROSE OF RES.

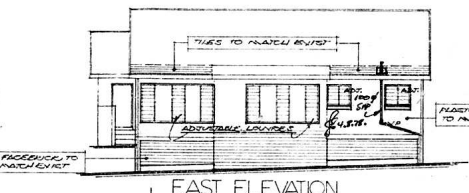


SECTION BB

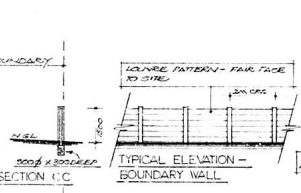


EAST ELEVATION

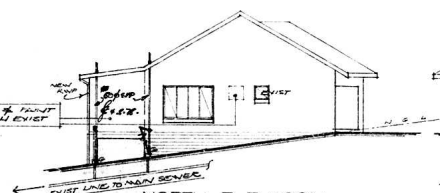


NORTH ELEVATION

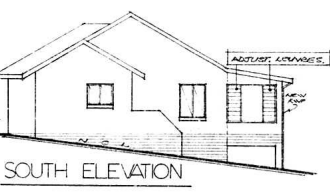


SOUTH ELEVATION

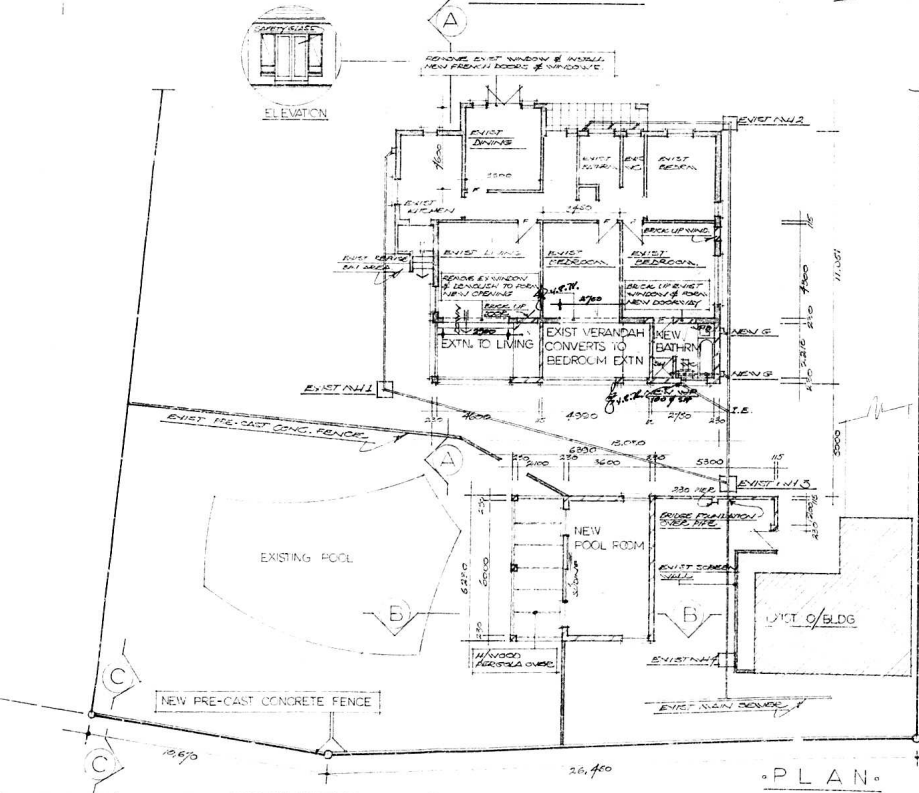

PLAN

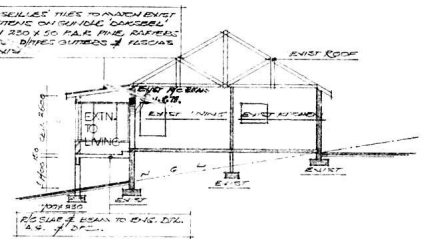

SECTION A-A

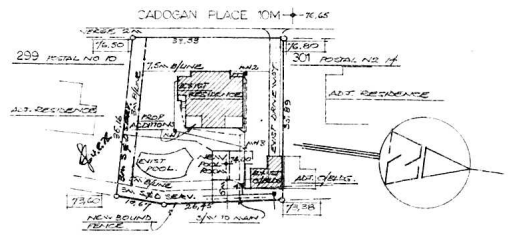

SITE PLAN - 1:500

NOTES  
 1. ALL LEVELS & DIMENSIONS TO BE CHECKED ON SITE BY CONTRACTOR PRIOR TO ANY WORK BEING COMMENCED.  
 2. TWO COURSES OF BRICKWORK REQUIRED FOR FOUNDATION WITH SAND DRAINS IN DOWNHILL ASPECT TO BE PROVIDED IN ALL WALLS AT WINDOW SILL & ROOF MAKE UP. ALL NEW FINISHES, FITTINGS & MATERIALS TO MATCH EXIST & BE TO OWNER'S APPROVAL.

R/C DETAIL REQUIRED

SHEET 1/1 COPY  
 CITY OF DUF  
 PLAN NO. 756/3  
 APPROVED 1978  
 D. C. MACLEOD  
 City Engineer

CITY HEALTH DEPT., BUREAU PLANS SECTION  
 RECEIVED 1978-06-01  
 Report No.  
 Approved 2/1/78

IMPORTANT  
 APPLICATION FOR PERMIT OF POSSESSION FOR ALTERING PLANS MADE BY THE CITY ENGINEER, LEVING POINT (M) DISTRICT, IN USE OF APPROVAL OF THIS PLAN

I, Cecily Dorothea, P.M., the registered owner of property on Lot 300 of 15 of 1556 Victoria County, hereby acknowledge that any present or future building erected upon the said Council's servitude area on the said lot is created and will remain there at all if damaged in the course of any work carried out within the said lot and I, the owner, shall indemnify and hold the Council harmless in respect of such damage.

Date: 22-7-78 Signed:

FEISONS

INSPECIPLAN  
 P.O. BOX 171  
 JARILANDA ROAD 4320  
 TEL 01446-2507

FROP ALTERATIONS & ADDITIONS TO EXIST RESIDENCE, NEW POOL ROOM & BOUNDARY FENCE ON LOT 300 OF 15 OF 1556 VICTORIA COUNTY FOR MRS W. PATTERSON-ROBERTS

POSTAL ADDRESS:  
 12 CADOGAN PLACE - DEN NORTH


ADDITIONAL AREA:	
RESIDENCE	18.50
POOL ROOM	28.50
TOTAL	47.00

DATE MAY 78 SCALE DRG. NO. 1:100  
 DRN BY [Signature] S.P.  
 REVISION 1/10/1

**AS BUILT**

*u/b.*  
15/9/80

**ORIGINAL**

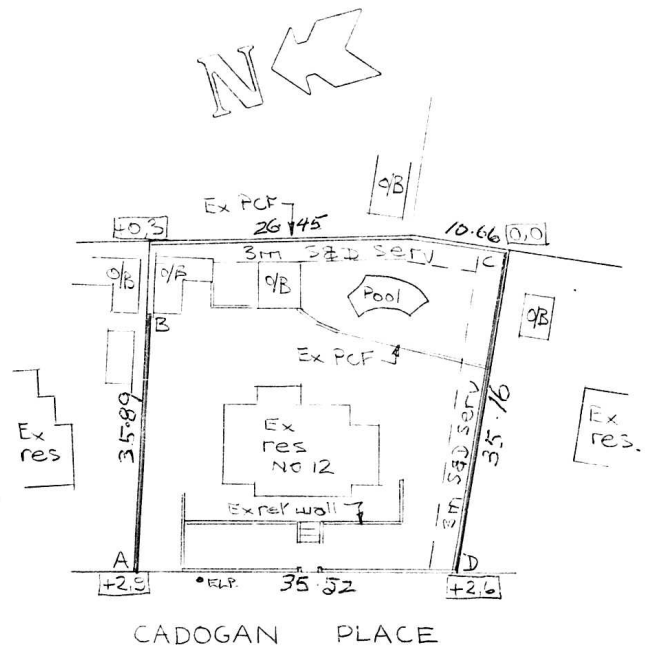

**SITE PLAN**

Scale 1:500

PRECAST CONC. FENCE DETAILS			
POSN.	TYPE	LENGTH	HEIGHT
ATO3	ALT ATHENS.	27.3m	1.8m
CTOD	" "	34.8m	1.8m

**PRECAST CONCRETE FENCES ON BOUNDARIES**  
 BOUNDARY BEACONS TO BE EXPOSED AND POINTED OUT TO THE DISTRICT BUILDING INSPECTOR BY THE APPLICANT BEFORE ERECTION OF THE FENCE IS COMMENCED. THE BEACONS SHALL REMAIN EXPOSED AFTER COMPLETION OF THE WORK FOR A FINAL INSPECTION.

- NOTES:**
1. THE LEVEL OF SOIL ON EITHER SIDE OF THE P-C-F TO BE THE SAME FOR A MINIMUM DISTANCE OF 305mm EXCEPT WHERE P-C-F RETAINS NO MORE THAN 305mm.
  2. P-C-F NOT TO ENCRoACH OVER BOUNDARY.
  3. FAIRFACE TO ROADWAY



New P.C.F. For : T. O'BRIEN  
 Reg. Postal Address : 12 CADOGAN PL  
 Reg. Site Description : 300 OF 15 NO 1556 V.C  
 Drawn By: [Signature] Date: 15-6-80

**CONRITE WALLS PTY.**  
 2 Schwegmann Rd. New Germany  
 Telephone 714-311

PROPOSED BUILDING for MR F.C. COOMBE

Est. 1941

Prepared for  
H.H. Bunting  
July 1941

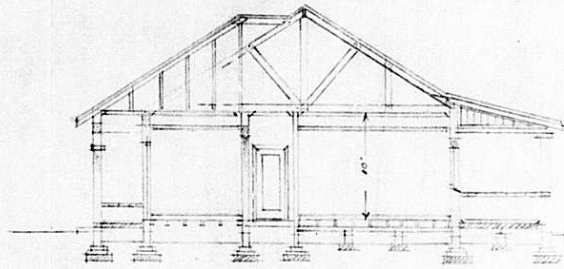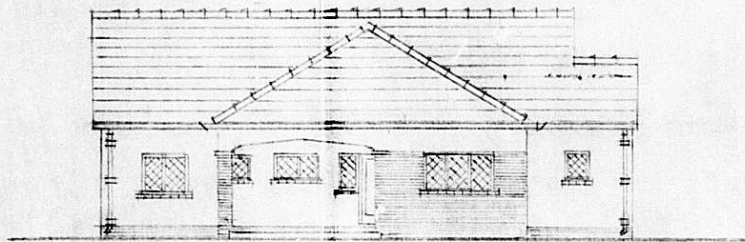


ELEVATION & SECTION AB



SEPTIC TANK  
BUILDING NOT TO BE COMMENCED  
UNTIL SITE IS APPROVED.



Inspections for  
E-1-1-0

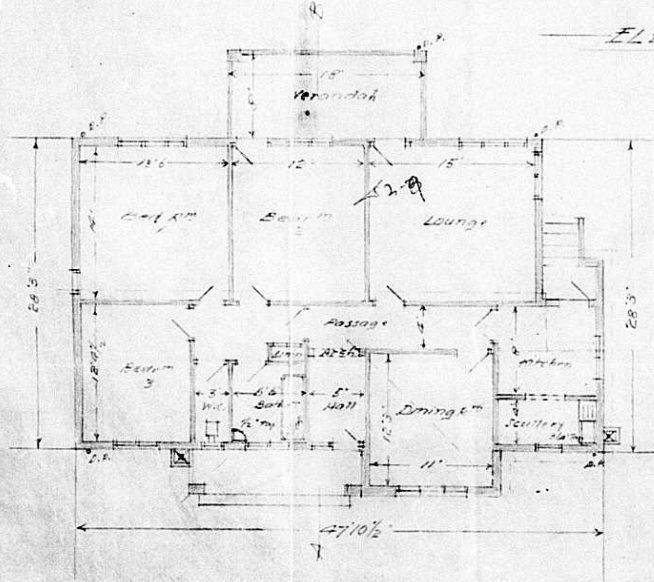

FLOOR PLAN

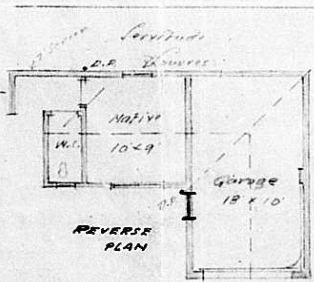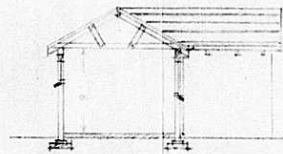

OUTBUILDINGS

