



1:50 SUB-STATION SECTION A-A

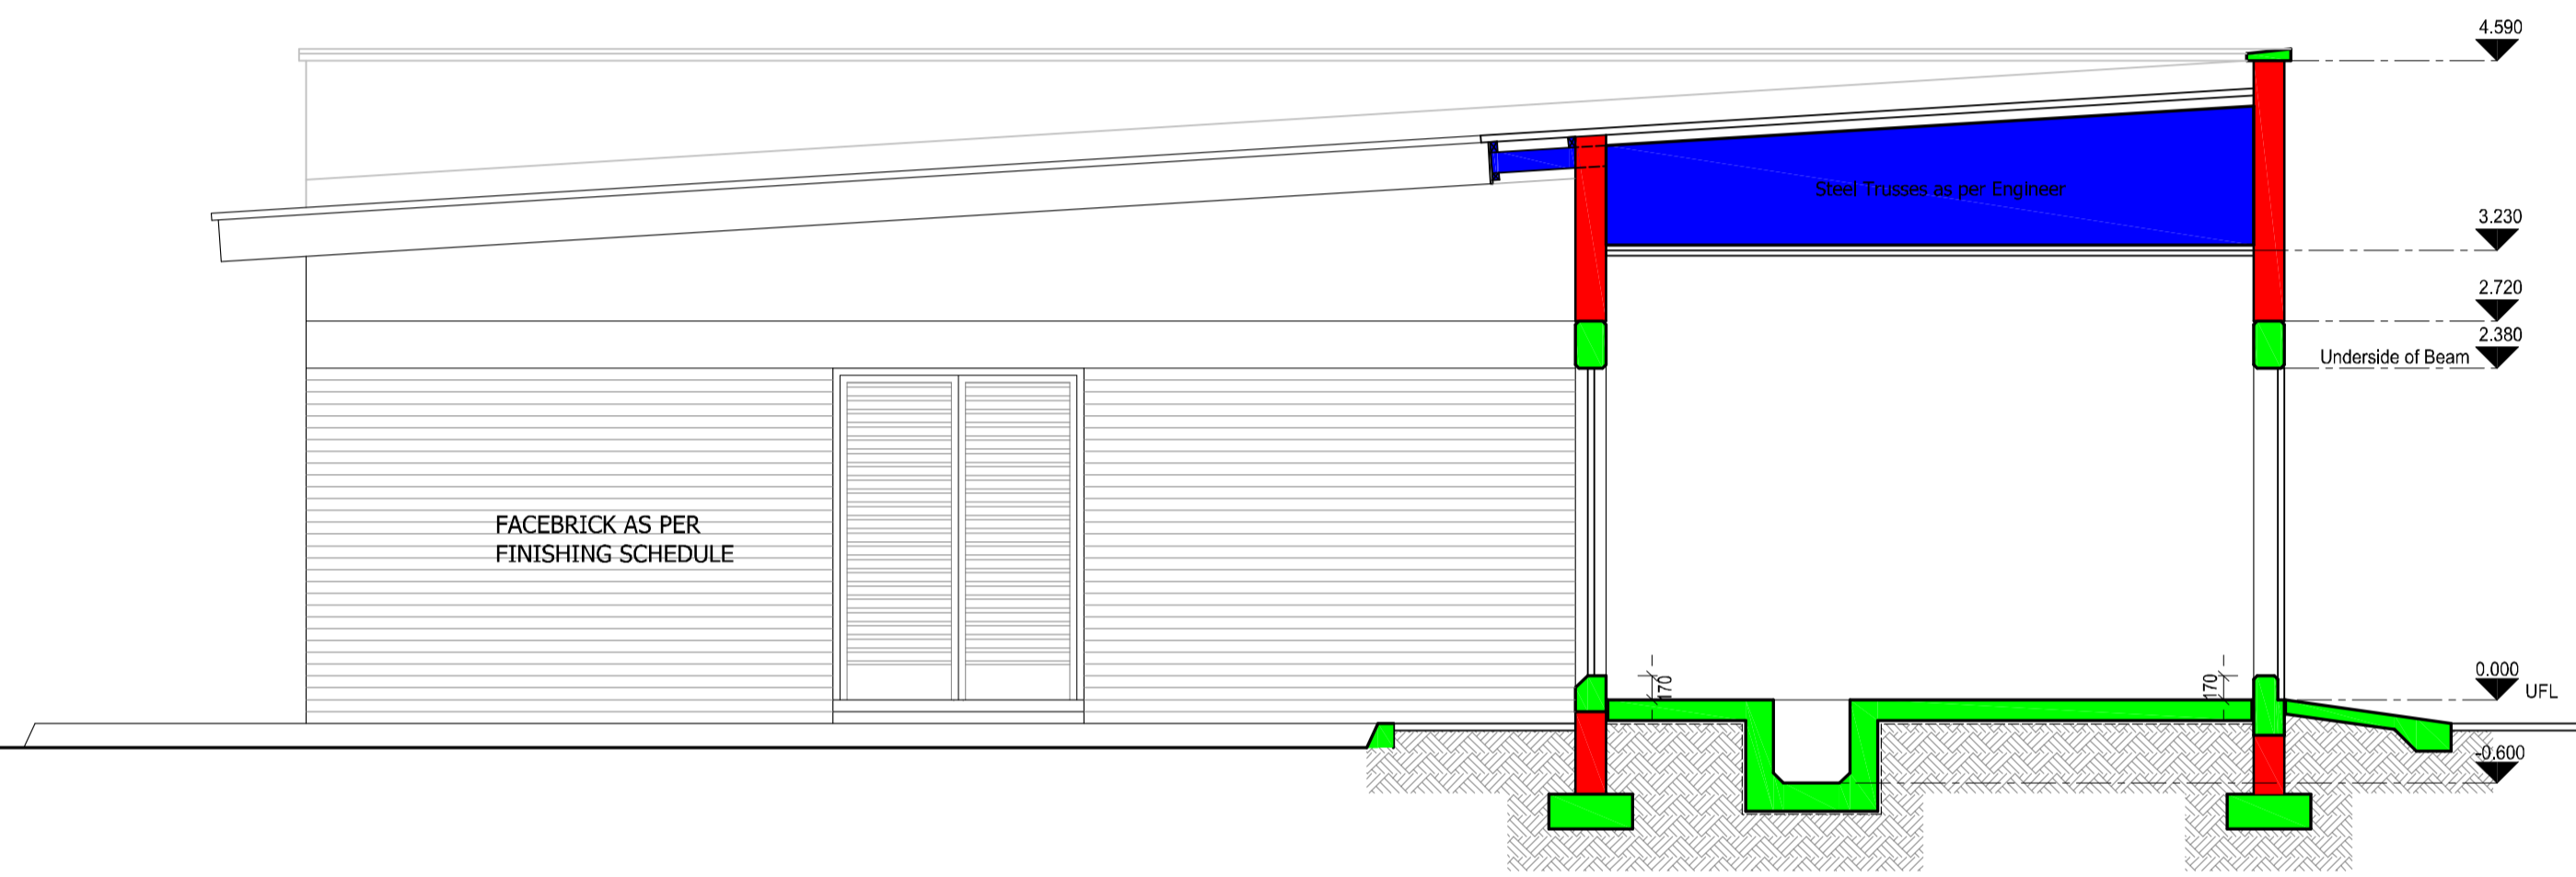


1:50 SUB-STATION SECTION B-B

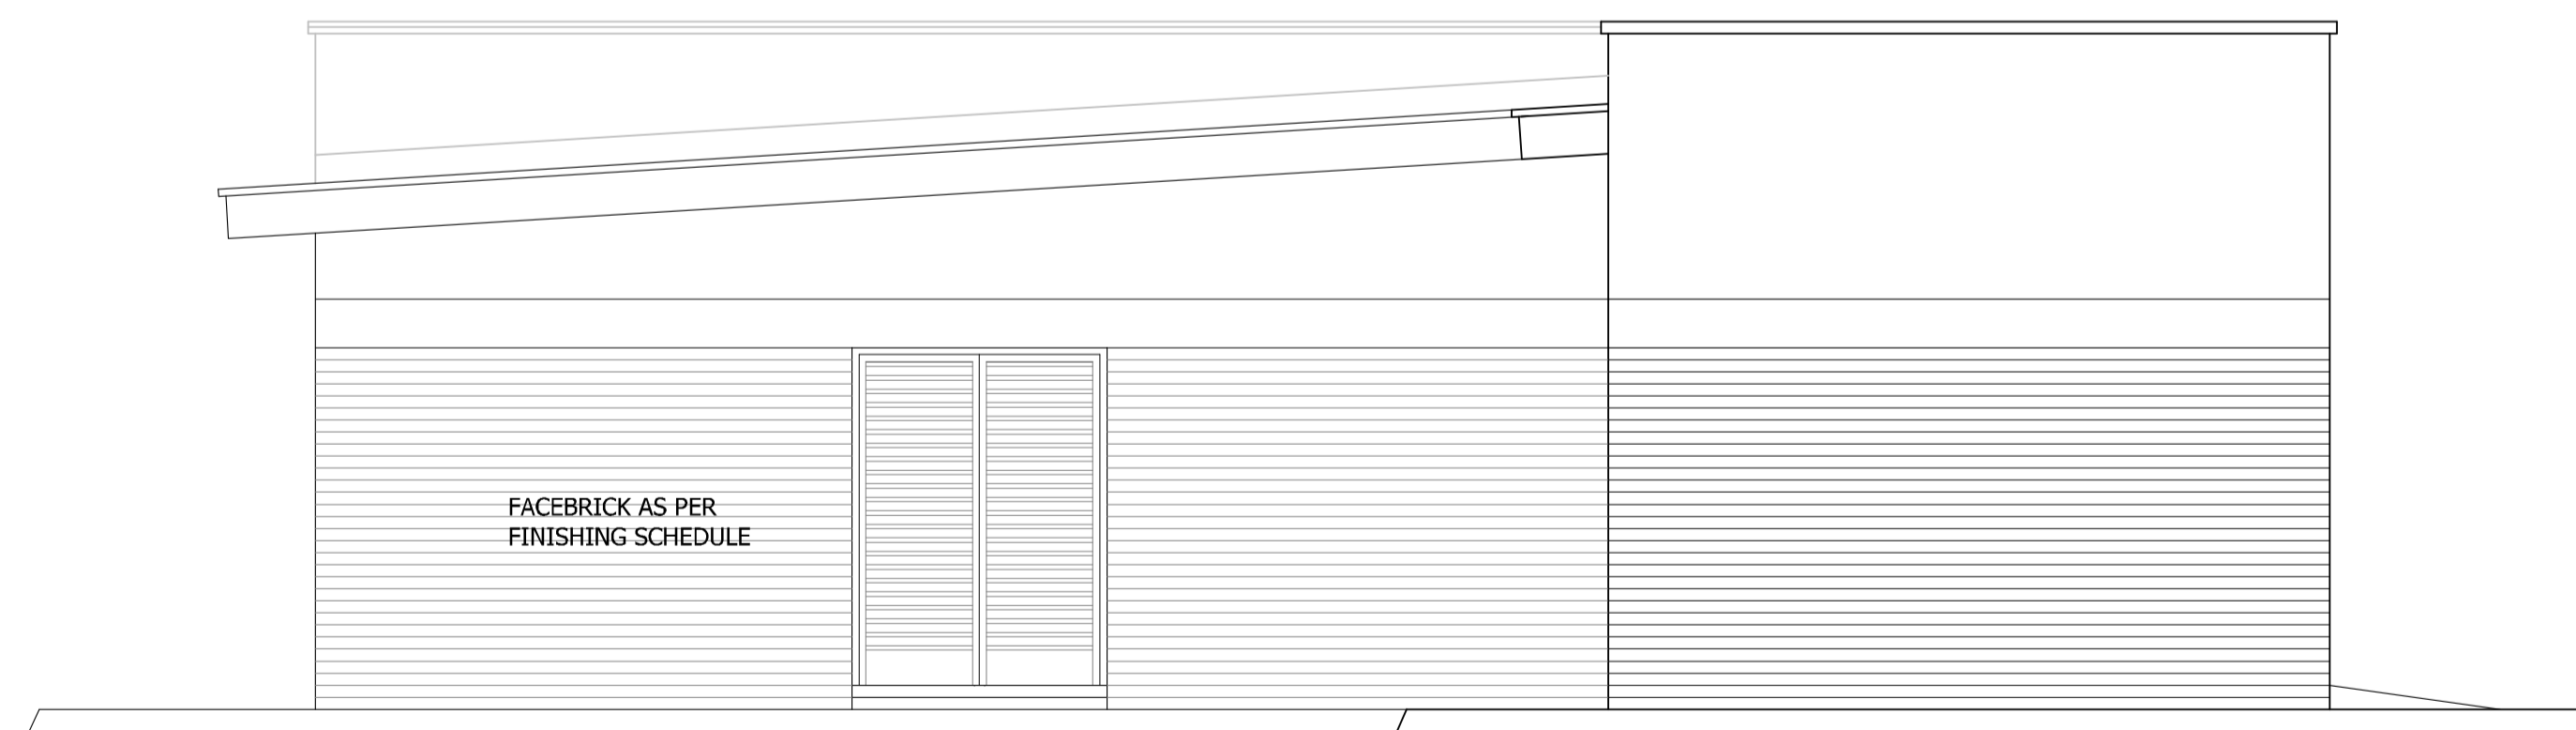


1:50 SUB-STATION NORTH ELEVATION



1:50 SUB-STATION EAST ELEVATION

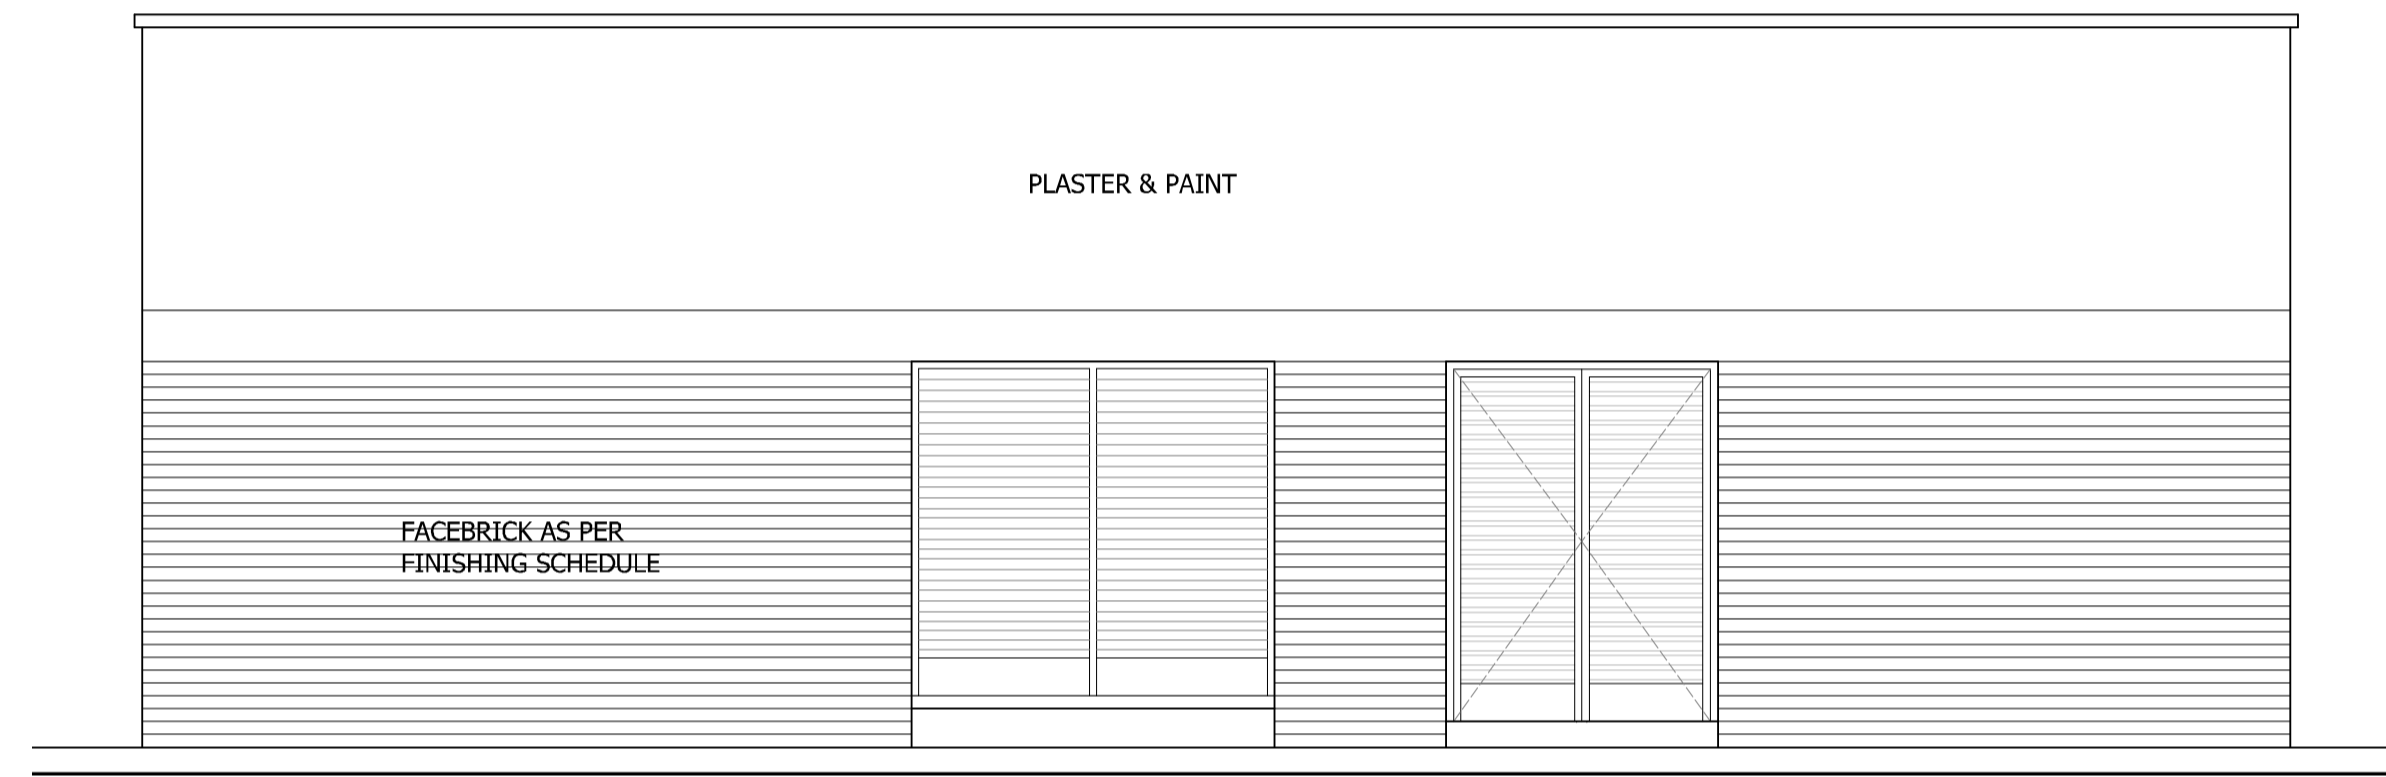

1:50 SUB-STATION SOUTH ELEVATION

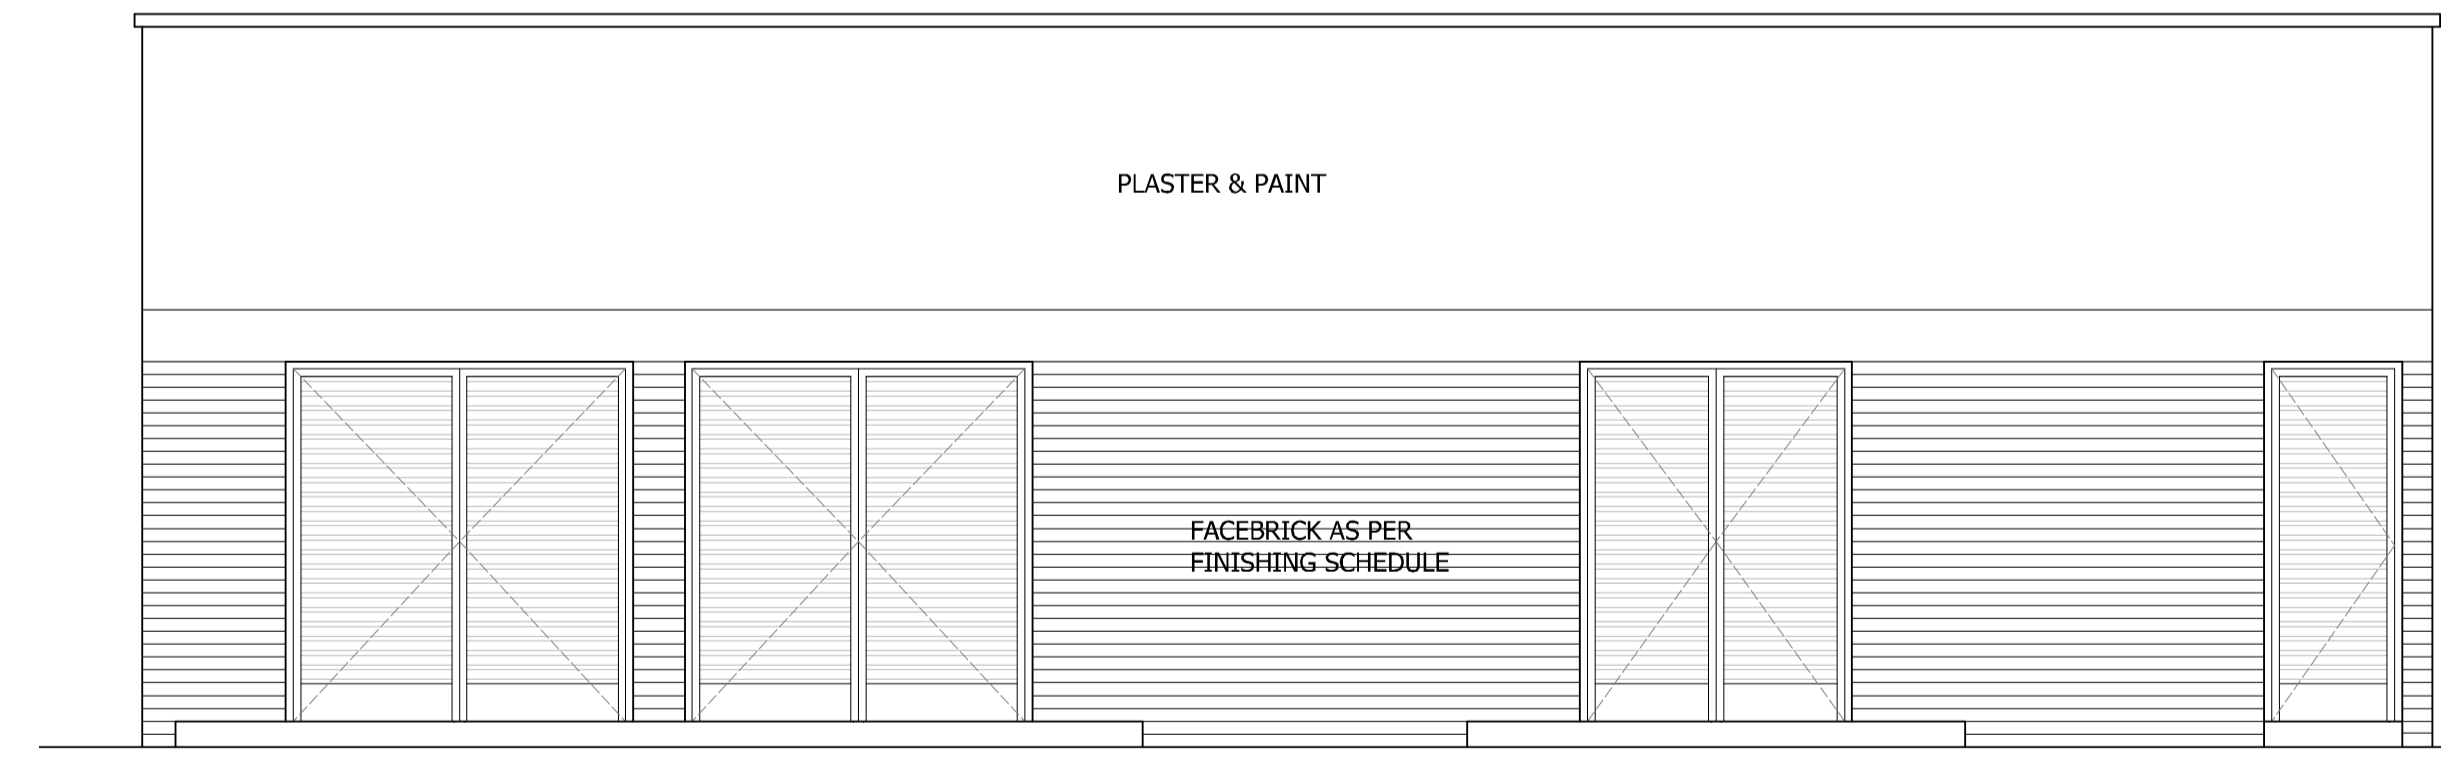

1:50 SUB-STATION WEST ELEVATION

ALL DIMENSIONS ARE TO BE CHECKED ON SITE PRIOR TO CONSTRUCTION TAKING PLACE. ANY DISCREPANCY BETWEEN ARCHITECT'S DRAWINGS, ENGINEERS DRAWINGS AND THE BILLS OF QUANTITIES ARE TO BE CLARIFIED WITH THE ARCHITECT. ALL PRODUCT SPECIFICATION CODES ARE TO BE CHECKED WITH THE SUPPLIER PRIOR TO THE ORDERING AND BUILDING IN OF MATERIAL. ALL STRUCTURE TO BE CHECKED BY THE ENGINEER.

NO.	DATE	AMENDMENT	D.P.W.

Copyright vests in the Department of Public Works
 as-built drawings
 Certified as-built drawings as per Centralised Drawing Archive AS-BUILT DRAWING REQUIREMENTS
 name: C.D.H.SPARKS
 date: _____
 professional registration no.: 4661

AMAF SUBSTATION & GATEHOUSE.dwg page 1 of 1



ARCHITECT
 NEWCASTLE MAGISTRATES COURT:
 UGRADING, RENOVATION AND EXTENSION
 OF CURRENT BUILDINGS
 NEWCASTLE, Erf 16957,
 33 & 35 MURCHISON STREET.
 WCS number: 45965
 BLOCK G:
 SECTIONS & ELEVATIONS.

drawn by	CDHS
scale	AS SHOWN
date	AUGUST 2021
departmental drawing number	
drawing number	L12/03/G/03 (WD)

SUBSTATION BLOCK G SECTION & ELEVATIONS. (IN CAD FILE) AMAF SUBSTATION & GATEHOUSE.dwg printed on 05 Jul 2023 at 14:12:27