



SITE INSPECTION IN ORDER
 DATE: 07/19/13

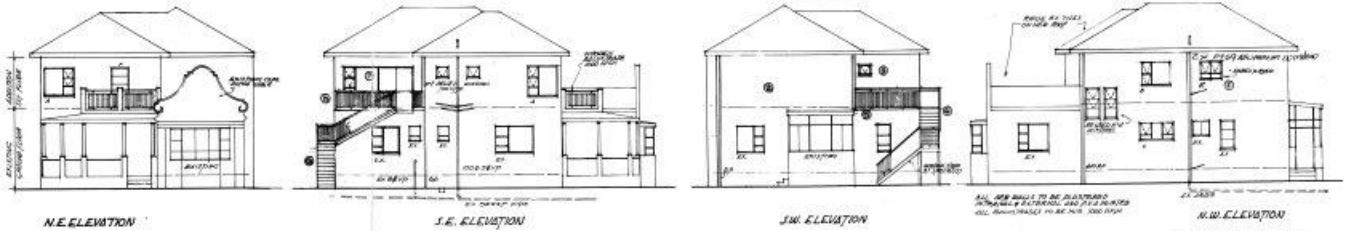


- FINISHES & JOINTS (UNLESS NOTED)**
- 1. ALL INTERIORS - (SEE PLAN)
 - 2. ALL EXTERIORS - (SEE PLAN)
 - 3. ALL ROOFING - (SEE PLAN)
 - 4. ALL JOINTS - (SEE PLAN)
 - 5. ALL JOINTS - (SEE PLAN)
 - 6. ALL JOINTS - (SEE PLAN)
 - 7. ALL JOINTS - (SEE PLAN)
 - 8. ALL JOINTS - (SEE PLAN)
 - 9. ALL JOINTS - (SEE PLAN)
 - 10. ALL JOINTS - (SEE PLAN)

- DEVIATIONS**
1. ALL INTERIORS TO BE FINISHED IN BRICK OR STUCCO AND FILL FINISH.
 2. ALL EXTERIORS TO BE FINISHED IN BRICK OR STUCCO AND FILL FINISH.
 3. ALL ROOFING TO BE NEW 300 YEAR.
 4. ALL JOINTS TO BE FINISHED IN BRICK OR STUCCO AND FILL FINISH.
 5. ALL JOINTS TO BE FINISHED IN BRICK OR STUCCO AND FILL FINISH.
 6. ALL JOINTS TO BE FINISHED IN BRICK OR STUCCO AND FILL FINISH.
 7. ALL JOINTS TO BE FINISHED IN BRICK OR STUCCO AND FILL FINISH.
 8. ALL JOINTS TO BE FINISHED IN BRICK OR STUCCO AND FILL FINISH.
 9. ALL JOINTS TO BE FINISHED IN BRICK OR STUCCO AND FILL FINISH.
 10. ALL JOINTS TO BE FINISHED IN BRICK OR STUCCO AND FILL FINISH.


- NOTE**
- ALL DIMENSIONS TO BE READ AND CHECKED.
 - ALL DIMENSIONS ARE TO BE FINISHED UNLESS NOTED OTHERWISE.
 - ALL DIMENSIONS ARE TO BE FINISHED UNLESS NOTED OTHERWISE.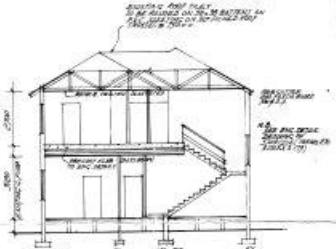
EXISTING GROUND FLOOR

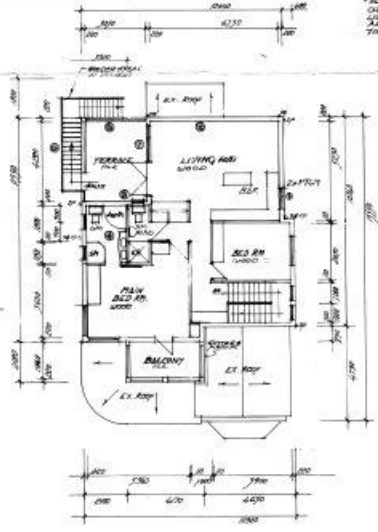

PROPOSED 1ST FLOOR PLAN

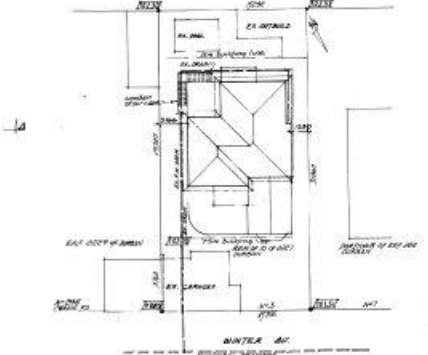

SITE PLAN 12.00

DEVIATION PLAN to
 Approved Plan # 12.04.04
 as built November 2013

PROPOSED ALTERATIONS AND ADDITIONS TO EXISTING HOUSE AT 111111 BUNTER RD ON REAR OF 10' X 30' ZONED LOT FOR 10' X 30' ZONED LOT IN L.R. HILLS

DESIGNED BY: S. MOHAN (P.E. ARCHT)
 PREPARED BY: S. MOHAN (P.E. ARCHT)
 CHECKED BY: S. MOHAN (P.E. ARCHT)
 DATE: 07/19/13

PROJECT: 111111 BUNTER RD, L.R. HILLS

SOURCE OF AREA:
 SITE AREA: 10' X 30' = 300 SQ. FT.
 LOT AREA: 10' X 30' = 300 SQ. FT.
 COVERED AREA: 10' X 30' = 300 SQ. FT.
 UNCOVERED AREA: 10' X 30' = 300 SQ. FT.
 TOTAL AREA: 10' X 30' = 300 SQ. FT.