


FIRST FLOOR PLAN  
SCALE: 1:500

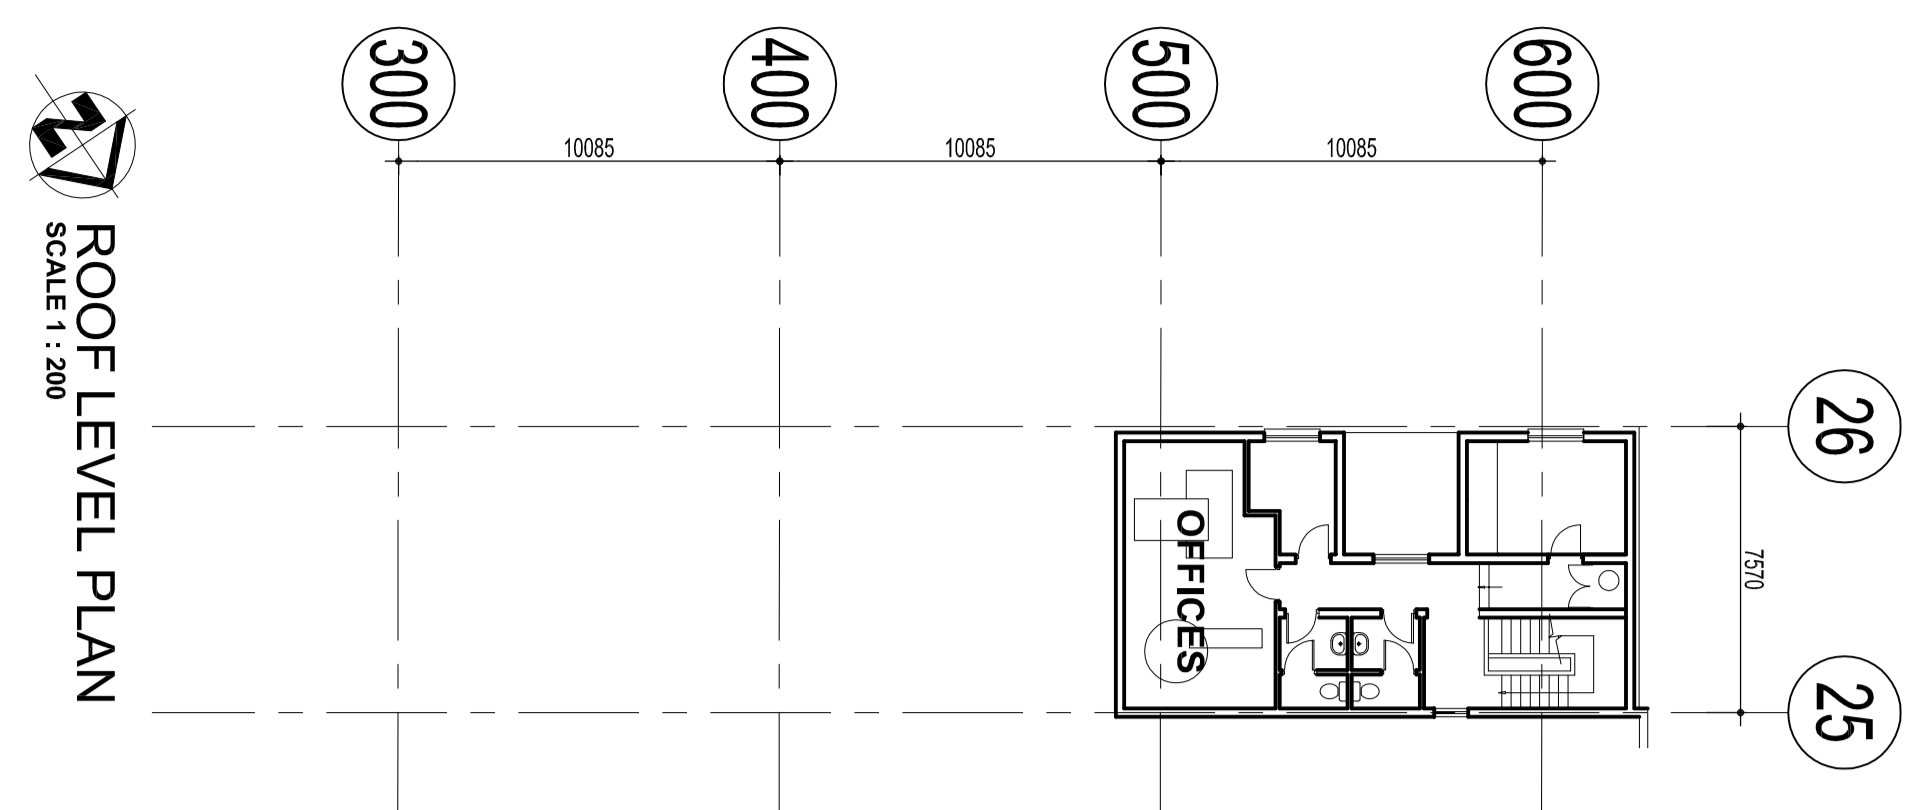

ROOF LEVEL PLAN  
SCALE: 1:200

APPLICATION FOR AMAFA APPROVAL

NOTES

1. DO NOT SCALE DRAWING - ONLY DIMENSIONS SHOWN TO BE USED.
2. THE CONTRACTOR SHALL VERIFY ALL CONDITIONS, DIMENSIONS AND LEVELS ON THE SITE AND NOTIFY THE CONSULTANT OF ANY VARIATIONS BEFORE CONSTRUCTION.

NO.	DATE	DESCRIPTION

CONTRACTOR / CONSULTANT

NAME	SON	DATE
TITLE	AM	RS

TRANSNET GROUP CAPITAL

NAME	SON	DATE
TITLE	AM	RS

PREPARED BY: PRENTO, P. R. TECH. P. R. ARCH  
 CHECKED BY: N.A. MAGAN  
 DATE: 09/12/20

OPERATING DIVISIONS

NAME	SON	DATE
TITLE	AM	RS

PREPARED BY: PRENTO, P. R. TECH. P. R. ARCH  
 CHECKED BY: N.A. MAGAN  
 DATE: 09/12/20

PROJECT NUMBER: 1001000110001102110

CONVERSION OF OCEAN TERMINAL BUILDING TO CAR TERMINAL ADDITIONAL PARKING FIRST FLOOR & ROOF LEVEL PLAN

PORT OF DURBAN  
T JETTY  
TRANSNET GROUP CAPITAL

SCALE: AS SHOWN

TRANSNET GROUP CAPITAL  
 1001000110001102110