



ALL DIMENSIONS TO BE CHECKED ON SITE PRIOR TO ANY WORK OR STOP DRAWINGS AND DISCREPANCIES TO BE DISCUSSED WITH PROJECT MANAGER PRIOR TO IMPLEMENTATION THEREOF.

REVISION	No.	DATE	DESCRIPTION	INITIAL

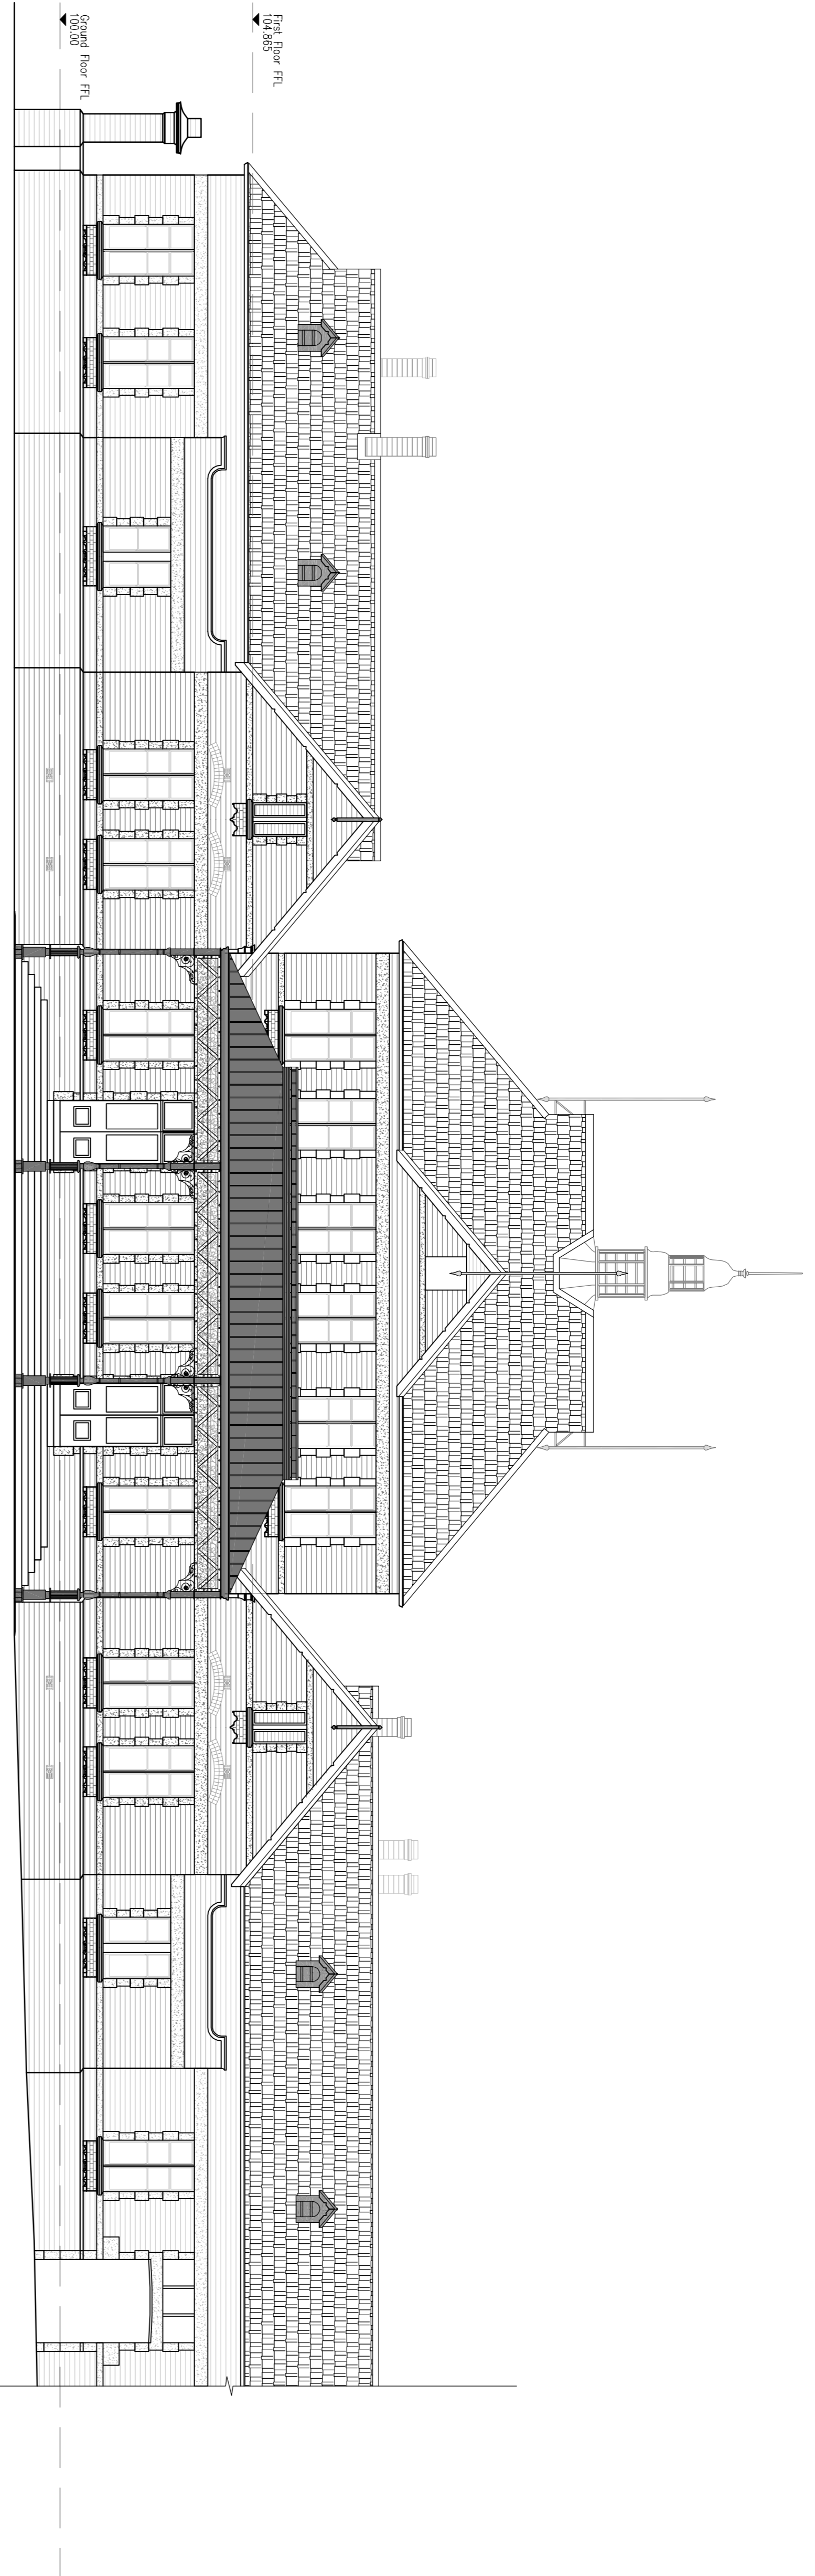

1 Front Elevation  
SCALE - 1 : 100

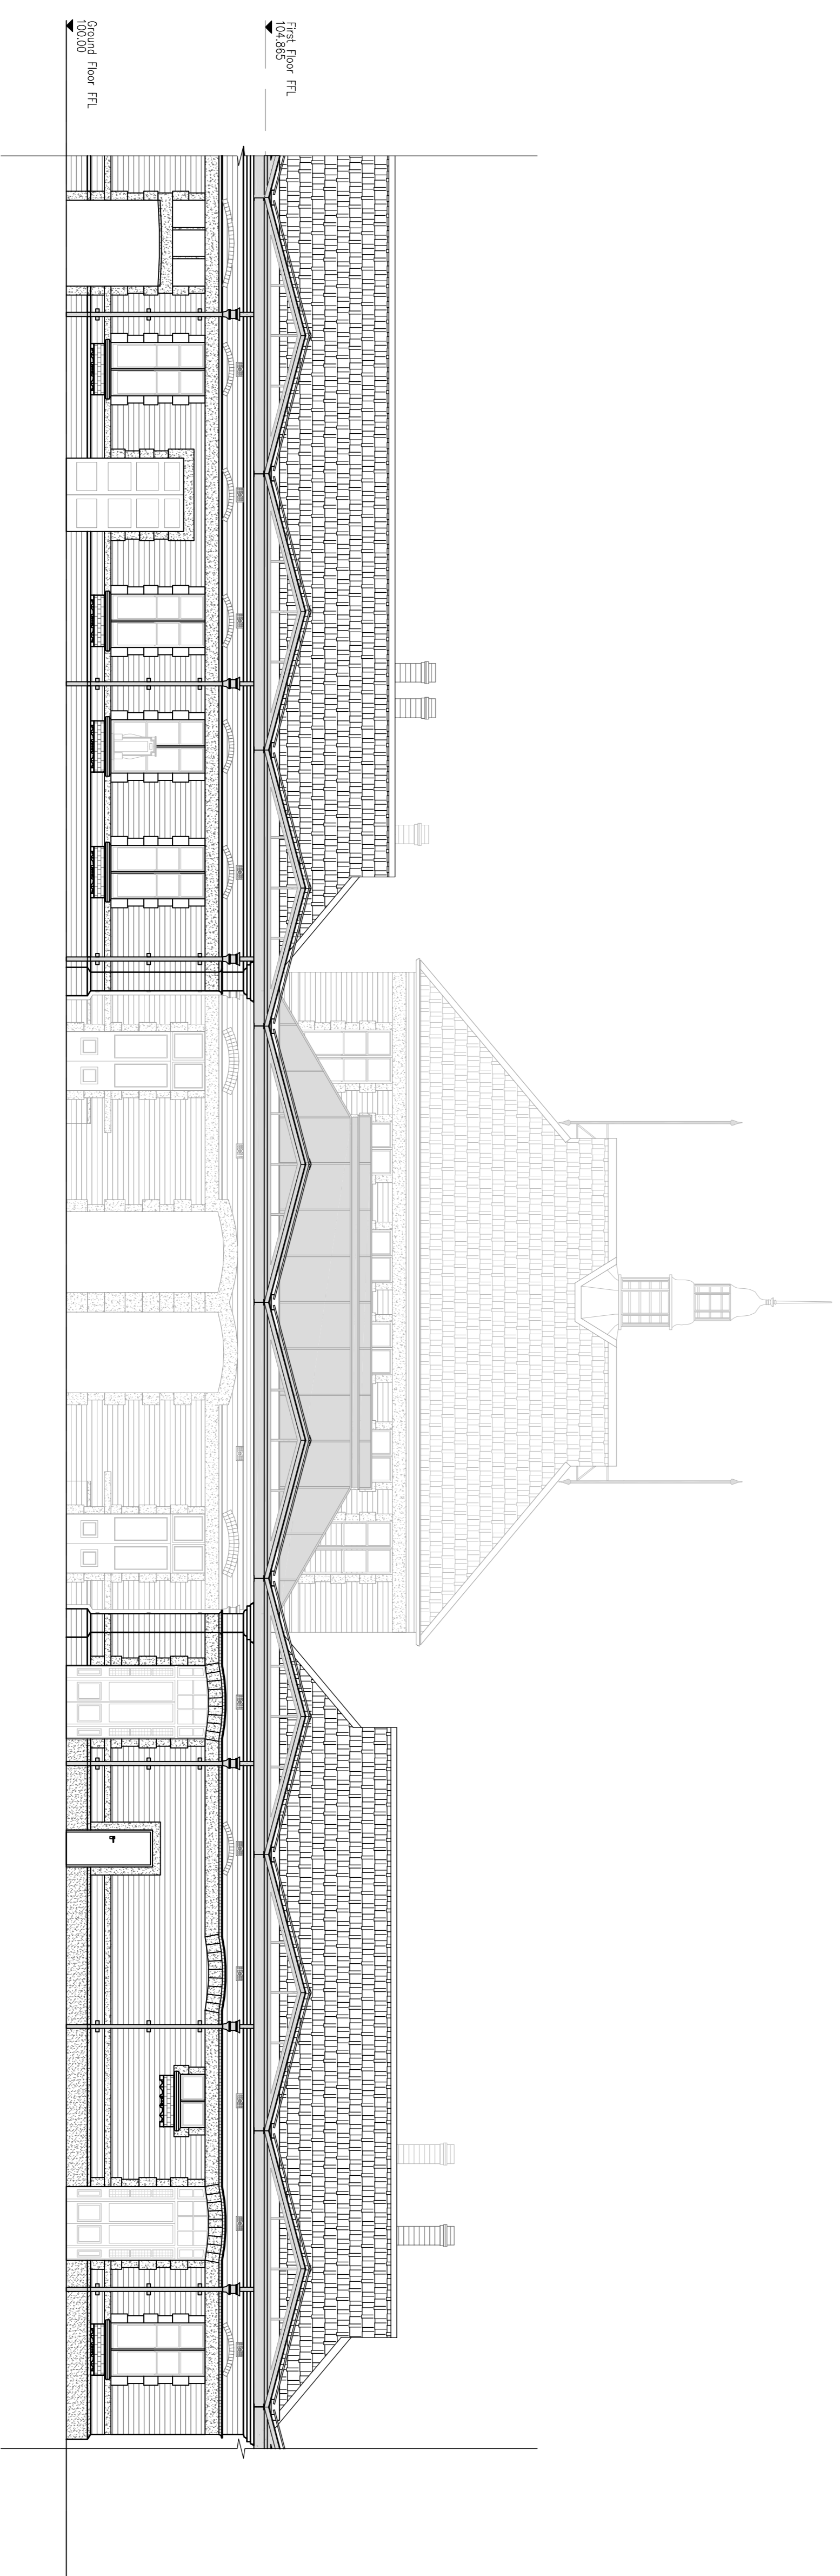

1 Sectional Back Elevation  
SCALE - 1 : 100



41 SWAPO (BROADWAY), DURBAN NORTH  
 PRIVATE BAG X12 GATEWAY 4251  
 TEL: 031 963 3434 FAX: 031 963 3518  
 Suite 28 GOLDEN PENNY CENTRE  
 28 HELY HUTCHINSON STREET, MTJUZINI  
 EMAIL: mh@sakhiszwearchitects.co.za

Project Title  
**PROPOSED ALTERATIONS TO  
 PIETERMARITZBURG STATION FOR  
 PRASA**

date : APRIL 2012  
 scale : 1:100

Drawing Description:  
**COUNCIL SUBMISSION DRAWING**  
**STATION MAIN BUILDING**  
**ELEVATIONS**  
**AS BUILT DRAWING**

Job No.	Drawing No.	Rev. No.
s282.3	102	-

ISSUED FOR APPROVAL	
ISSUED FOR INFORMATION	
ISSUED FOR SUBMISSION	11.02.2013
ISSUED FOR TENDER	
ISSUED FOR CONSTRUCTION	