
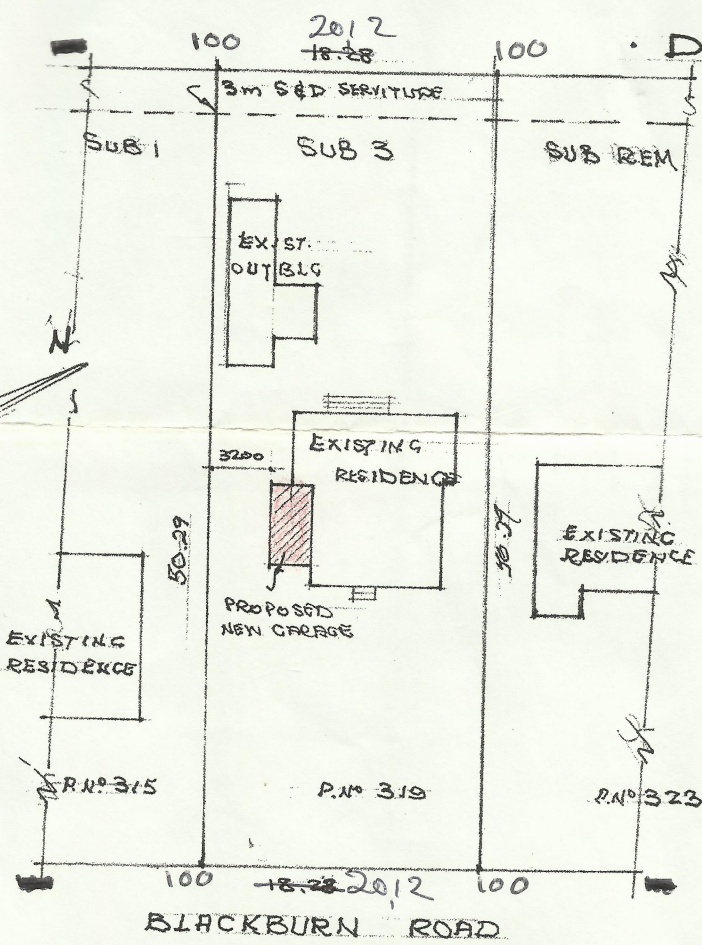


# W. ELEVATION

MADECK  
 50x70 PURLINS AT  
 CENTRES  
 38 RAFTERS AT  
 CENTRES  
 FLASHING  
 TO BEARER FIXED  
 WALL  
 FINISHES TO  
 MATCH EXIST.

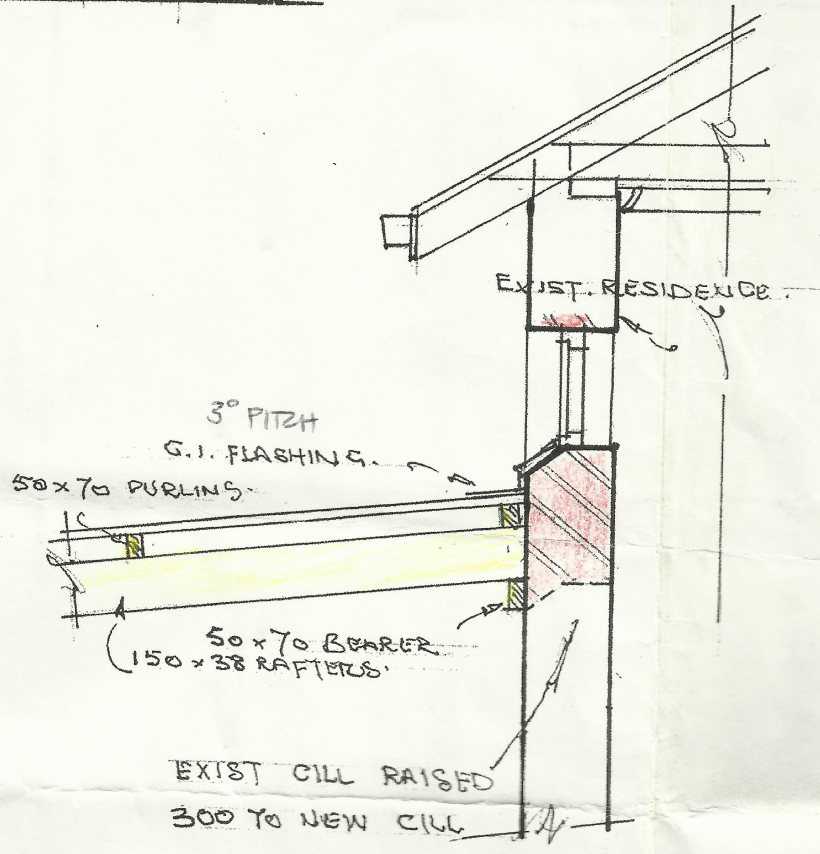

## DETAIL B

SUBMISSIONS  
 SITEPLAN CHECKED  
 2001-12-19  
 Signature: [Handwritten Signature]

### AREA

OUTBLDS :	42.75
EXIST. RES :	111.53
PRDP. ADD :	18.75
TOTAL :	173.03
SITE AREA :	1012.5m <sup>2</sup>

### SITE PLAN

SCALE 1:1500

RAFE NO 81763055

ANTIGUAN  
 SOIL  
 ALL G  
 WITH  
 OF SA