




100 S-07 Building Section (2)
Scale 1:200

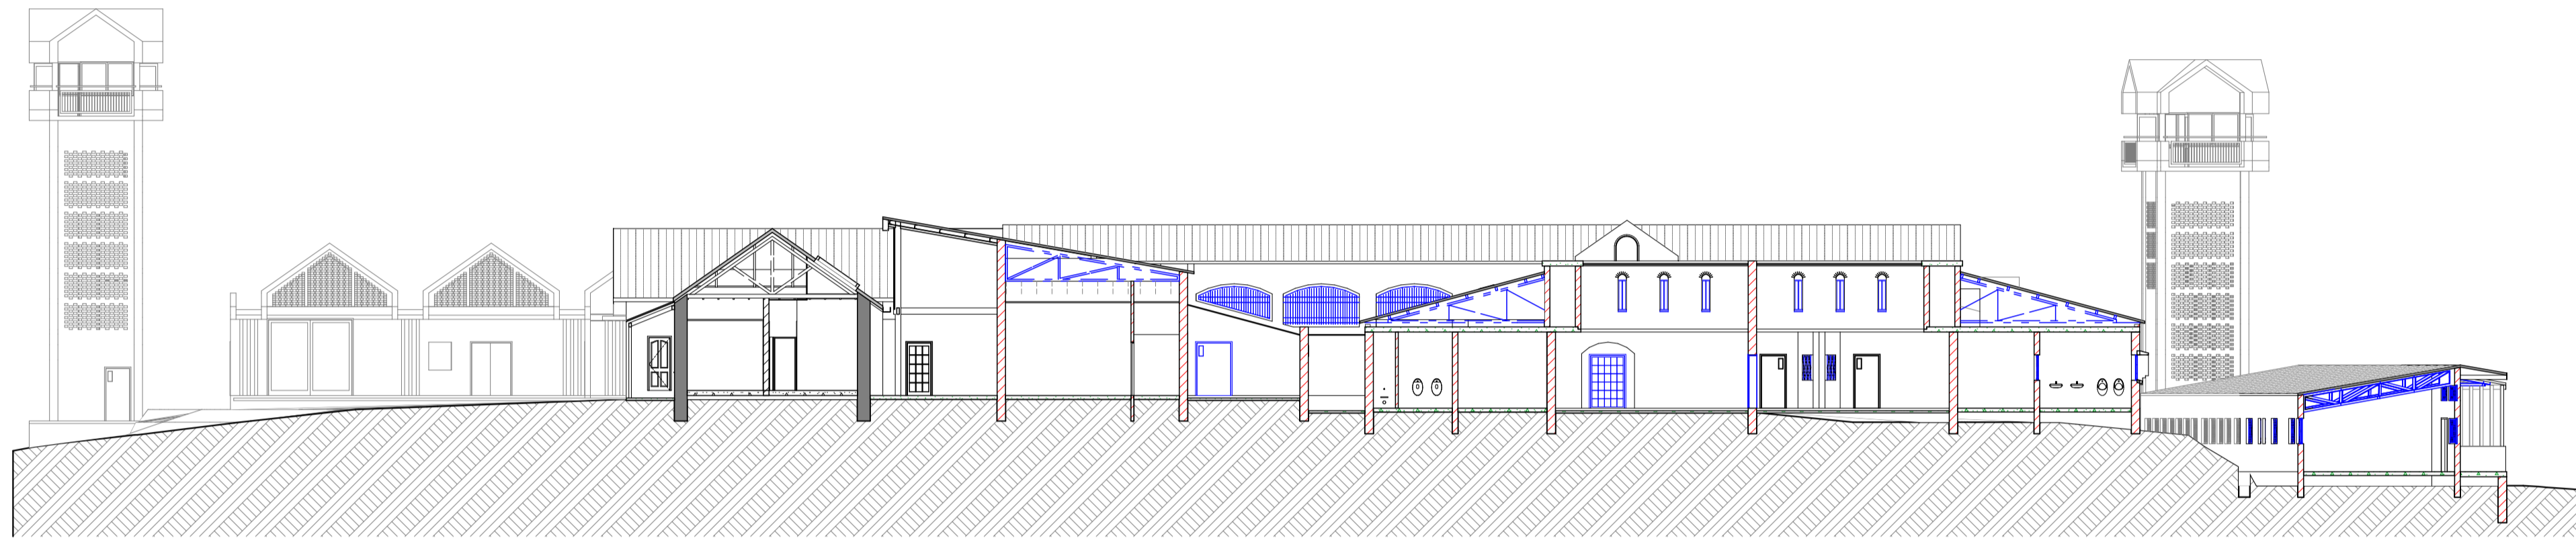

100 S-02 Building Section
1:200

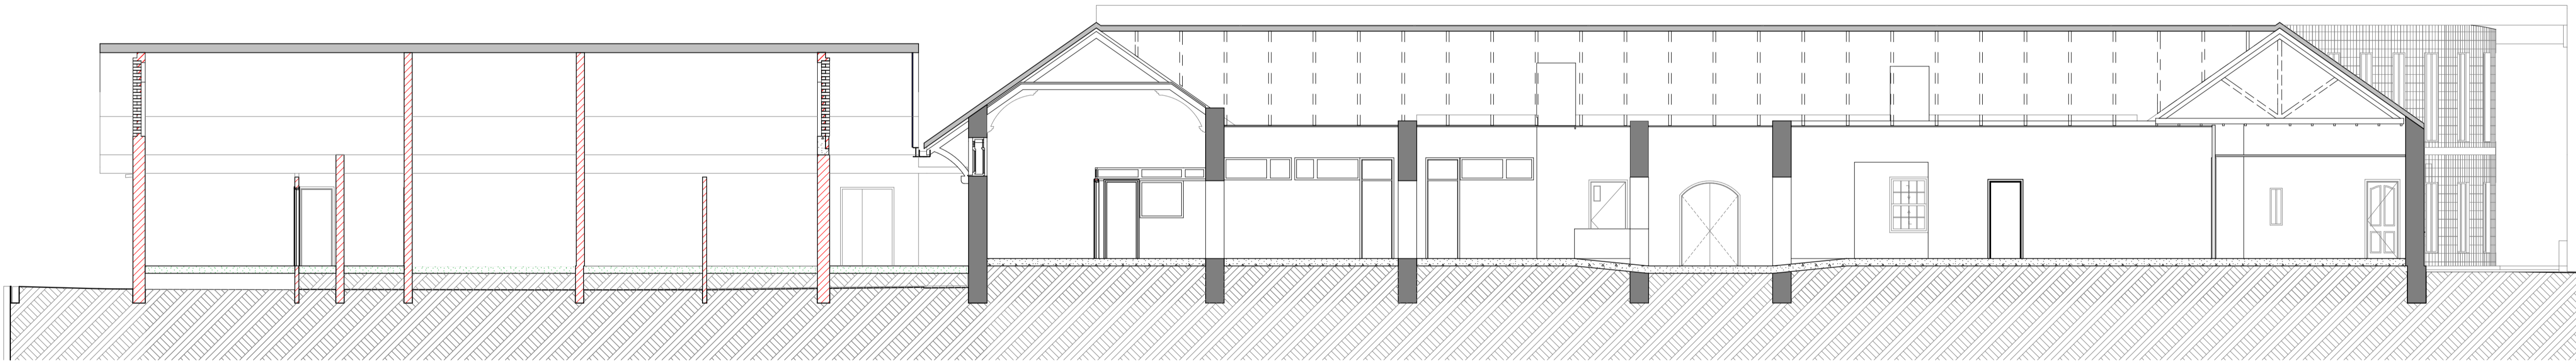

100 S-03 Building Section
1:100

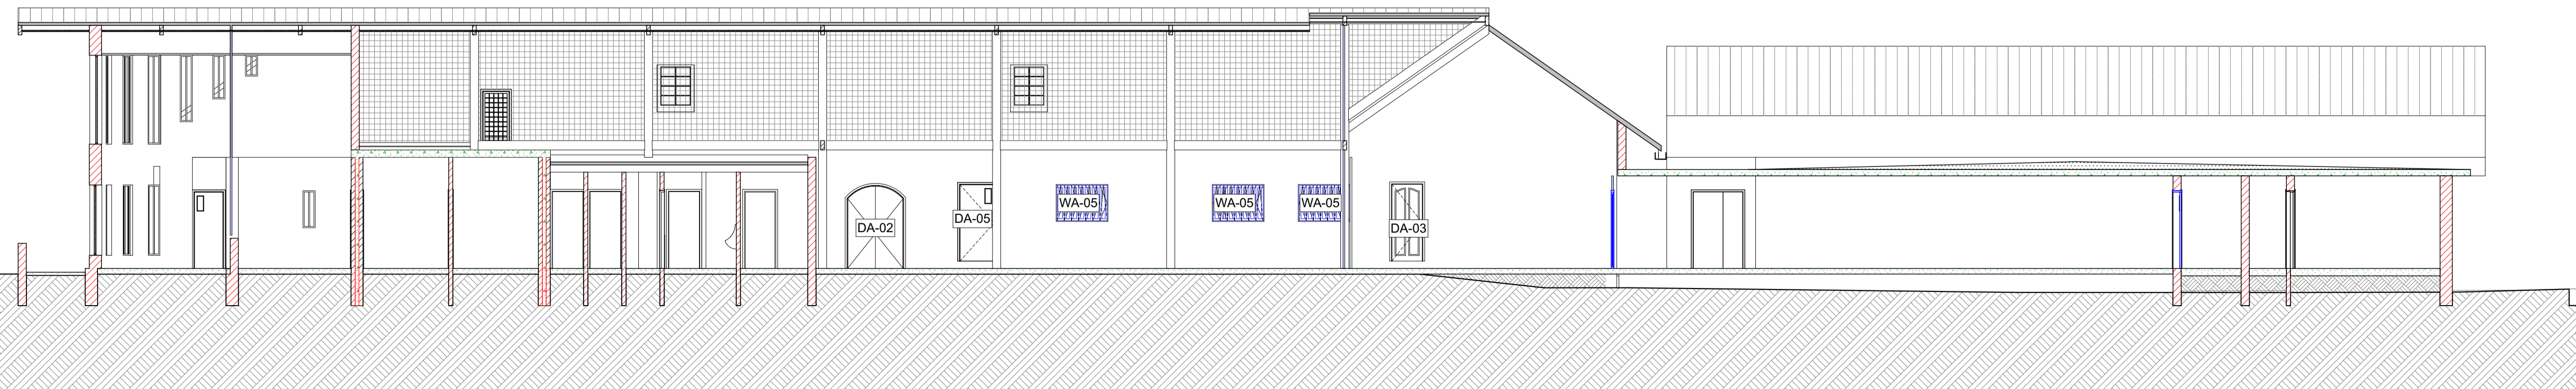

100 S-04 Building Section
1:100

| No. | DATE | AMENDMENT | D.P.W. |
|-----|------|-----------|--------|
| | | | |

Copyright vests in the
Department of Public Works
certified as-built drawings as per Centralised Drawing
Archive AS-BUILT DRAWING REQUIREMENTS

name: Sean Wesfels
date: 24 February 2017
professional registration no.: PrArch24750197

cad file name: PSP 20170221.pln
page type: A 1



consultant: MAZIBUKO WESSELS ARCHITECTS

discipline: ARCHITECTS

service: PORT SHEPSTONE PRISON:
REPAIR AND RENOVATIONS FOR
BUILDING RELATED SERVICES

WCS number: 040801

drawing title: Sections

ref.no. PSP 24/02/2017
scale: 1:100, 1:200
date: 24 February 2017
designed: SEAN WESSELS
drawn: SEAN WESSELS
checked: SEAN WESSELS

DPW drawing number: 040801/X201