





100 S-07 Building Section
Scale 1:100

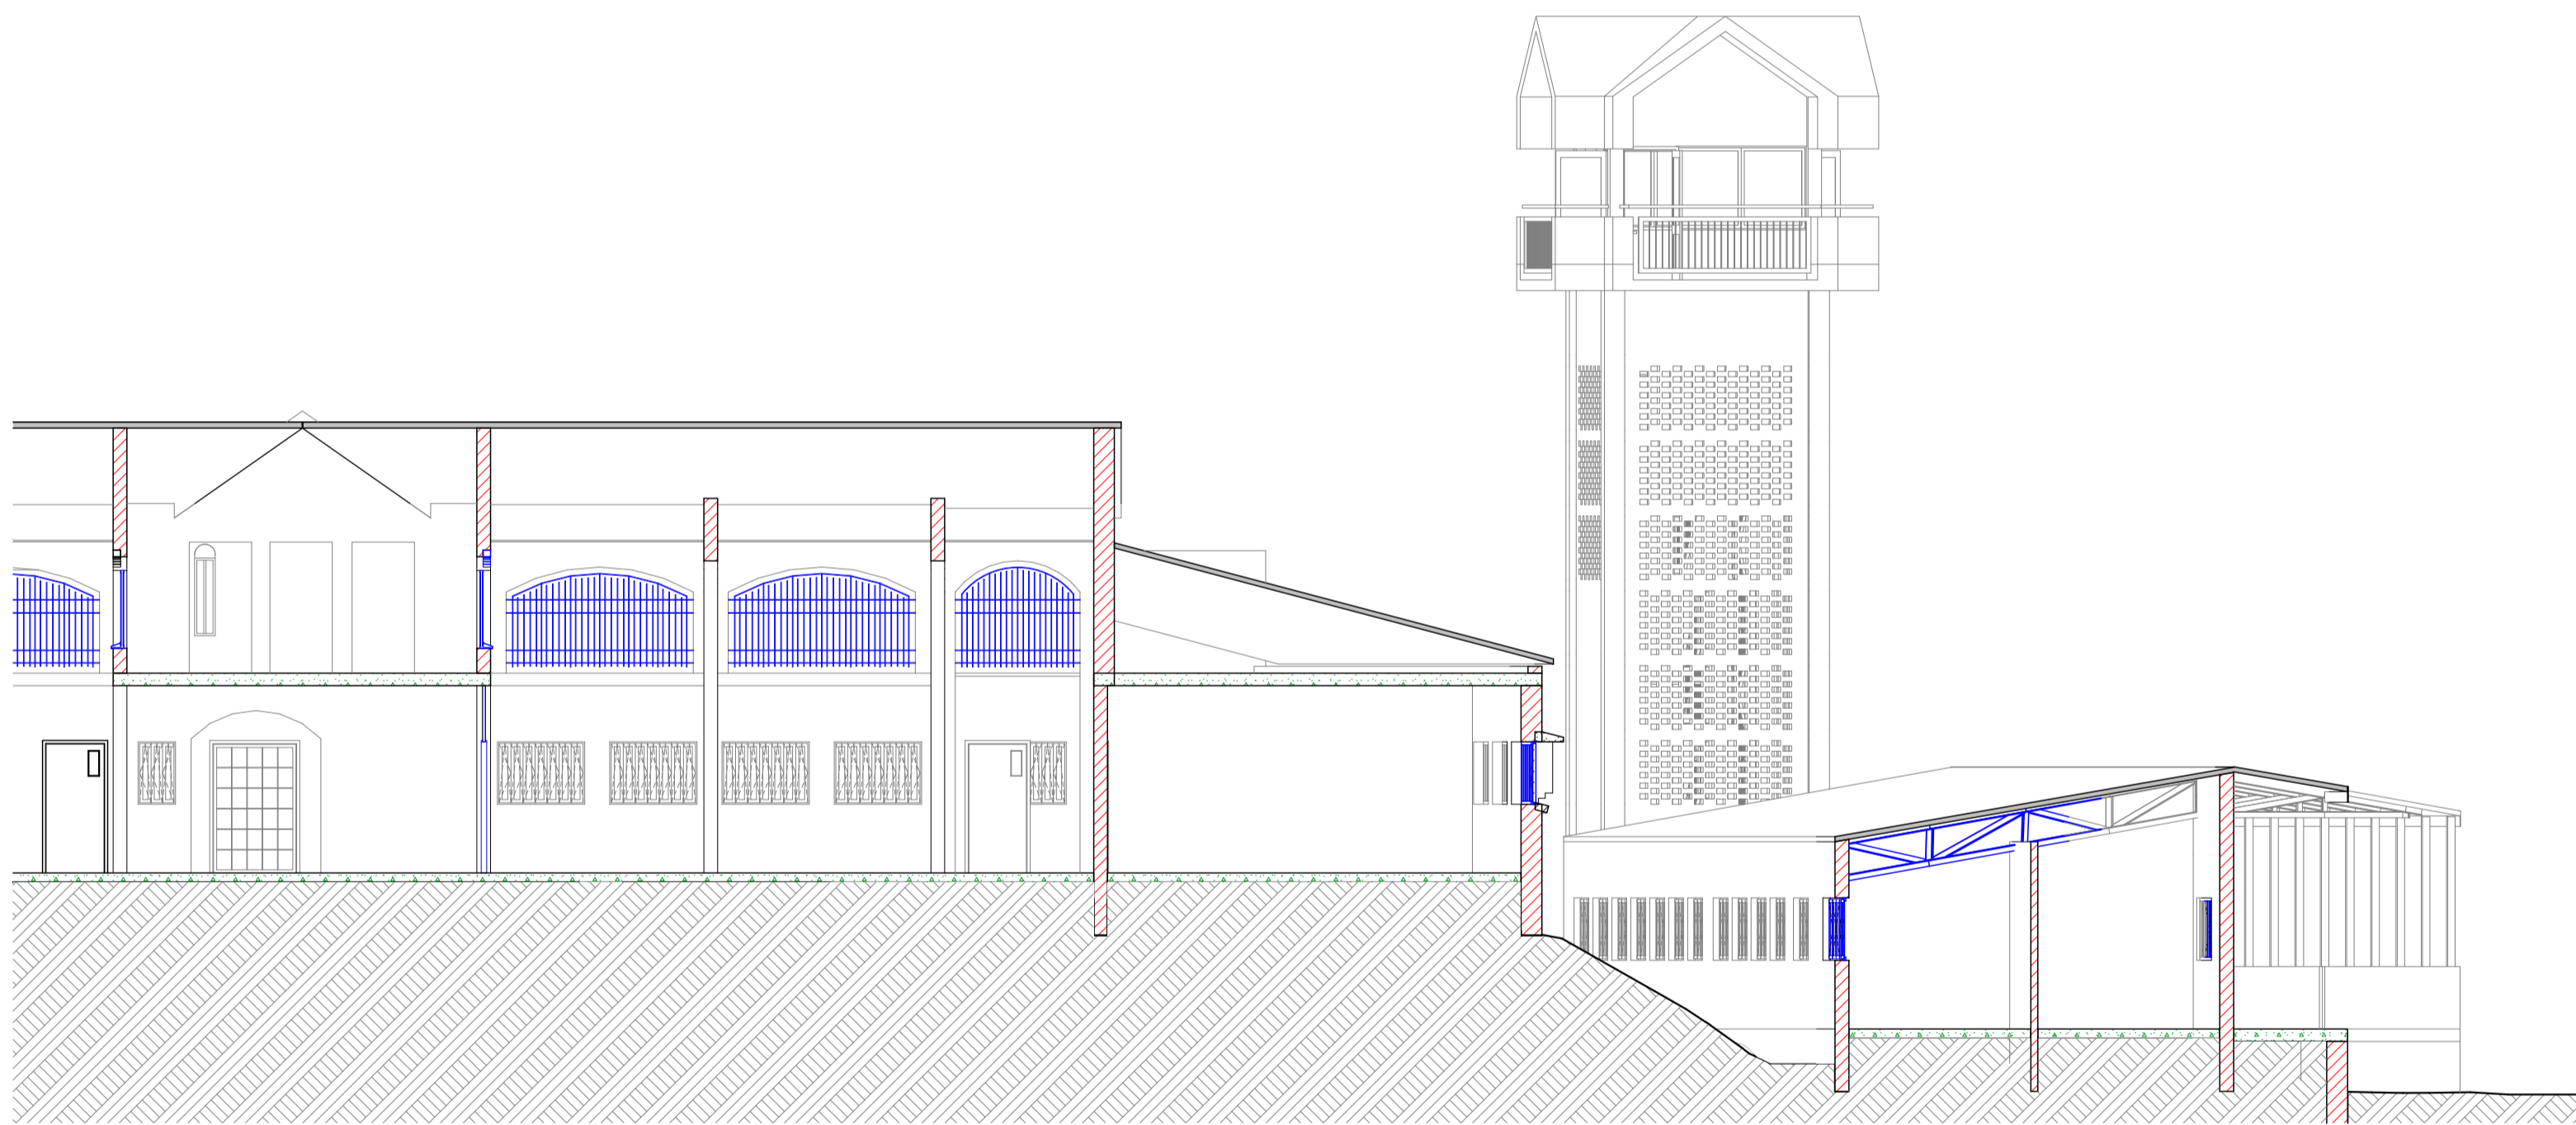

100 S-07 Building Section
Scale 1:100

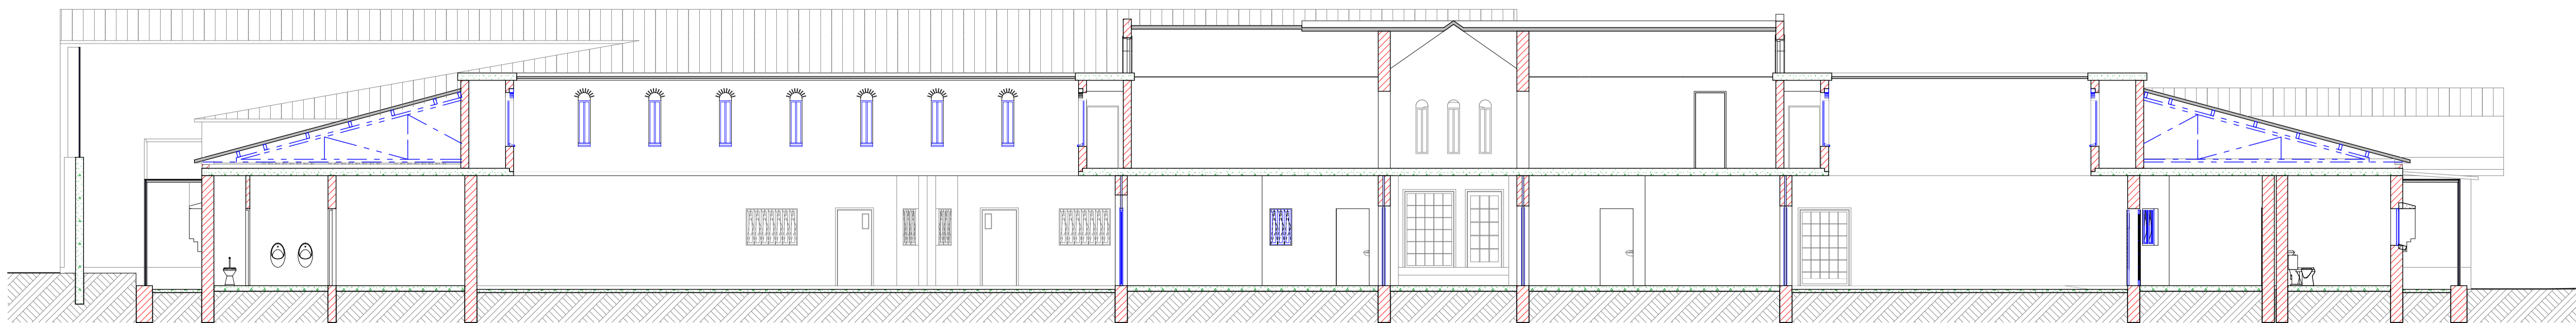

100 S-16 Building Section
Scale 1:100

No.	DATE	AMENDMENT	D.P.W.

Copyright vests in the
Department of Public Works

certified as-built drawings as per Centralised Drawing
Archive AS-BUILT DRAWING REQUIREMENTS

name: Sean Wessels
date: 24 February 2017
professional registration no.: PrArch24750197

cad file name: PSP 20170221.pln page type: A 1



consultant: MAZIBUKO WESSELS ARCHITECTS

discipline: ARCHITECTS

service: PORT SHEPSTONE PRISON:
REPAIR AND RENOVATIONS FOR
BUILDING RELATED SERVICES

WCS number: 040801

drawing title: Sections

ref no: PSP 24/02/2017 designed: SEAN WESSELS
scale: 1:100 drawn: SEAN WESSELS
date: 24 February 2017 checked: SEAN WESSELS
DPW drawing number:

040801/X202