




100 302 North Eastern Elevation (2)
Scale 1:200

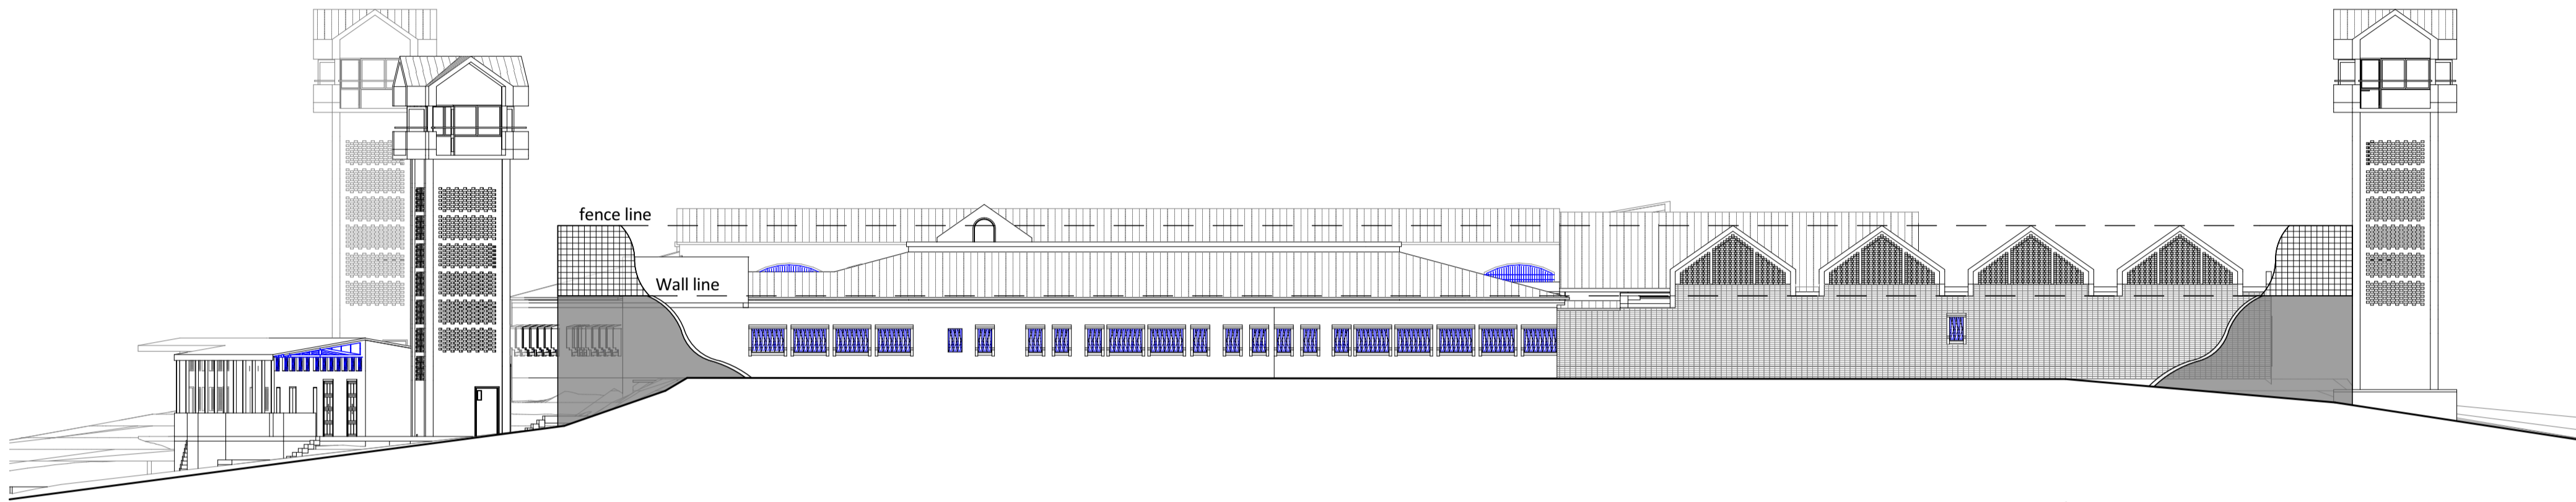


100 304 South Western Elevation (3)
Scale 1:200

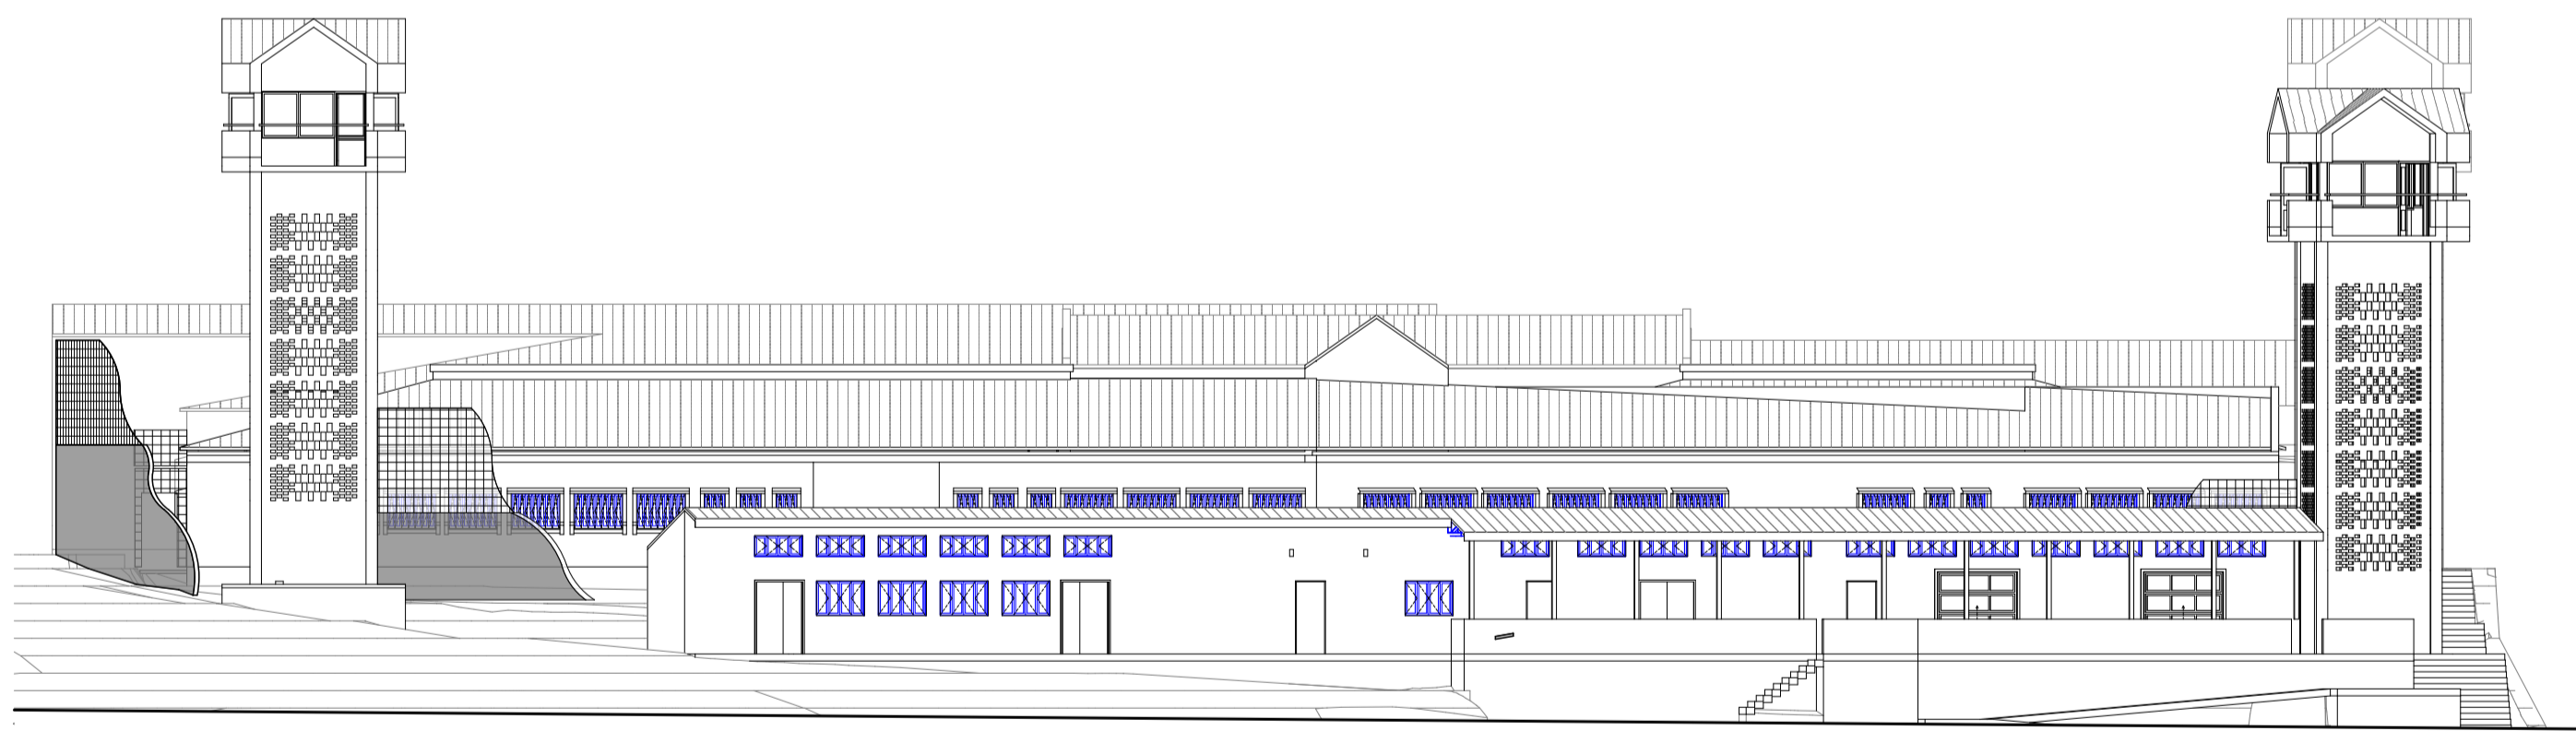

100 301 North Western Elevation (1)
Scale 1:200

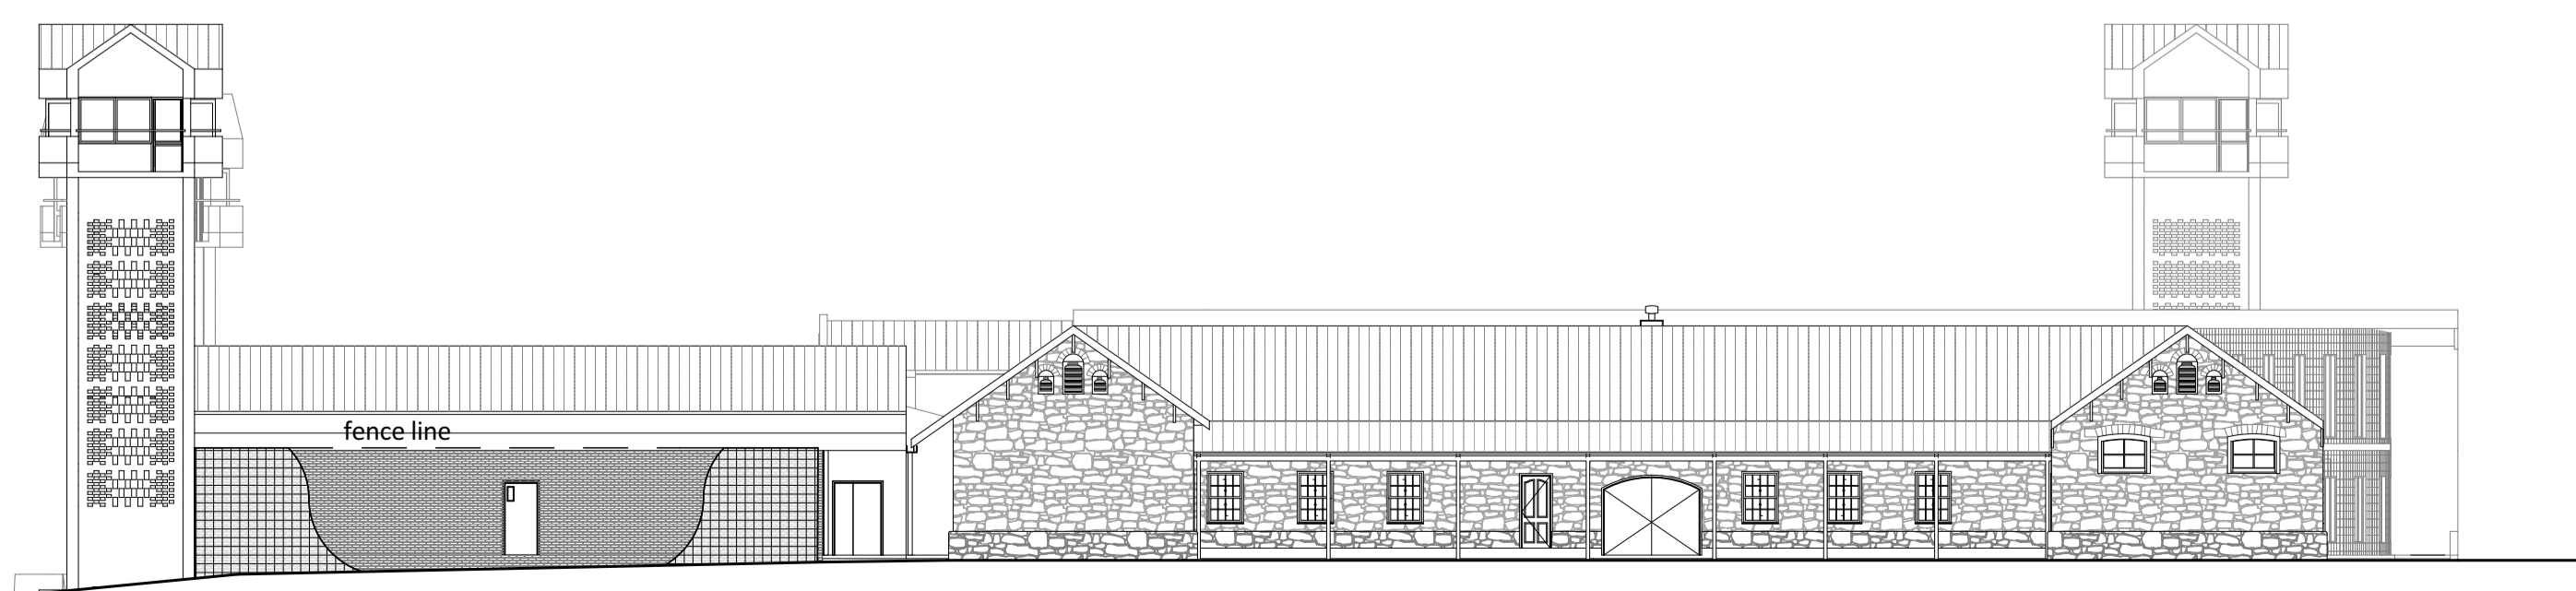

100 303 South Eastern Elevation (2)
Scale 1:200

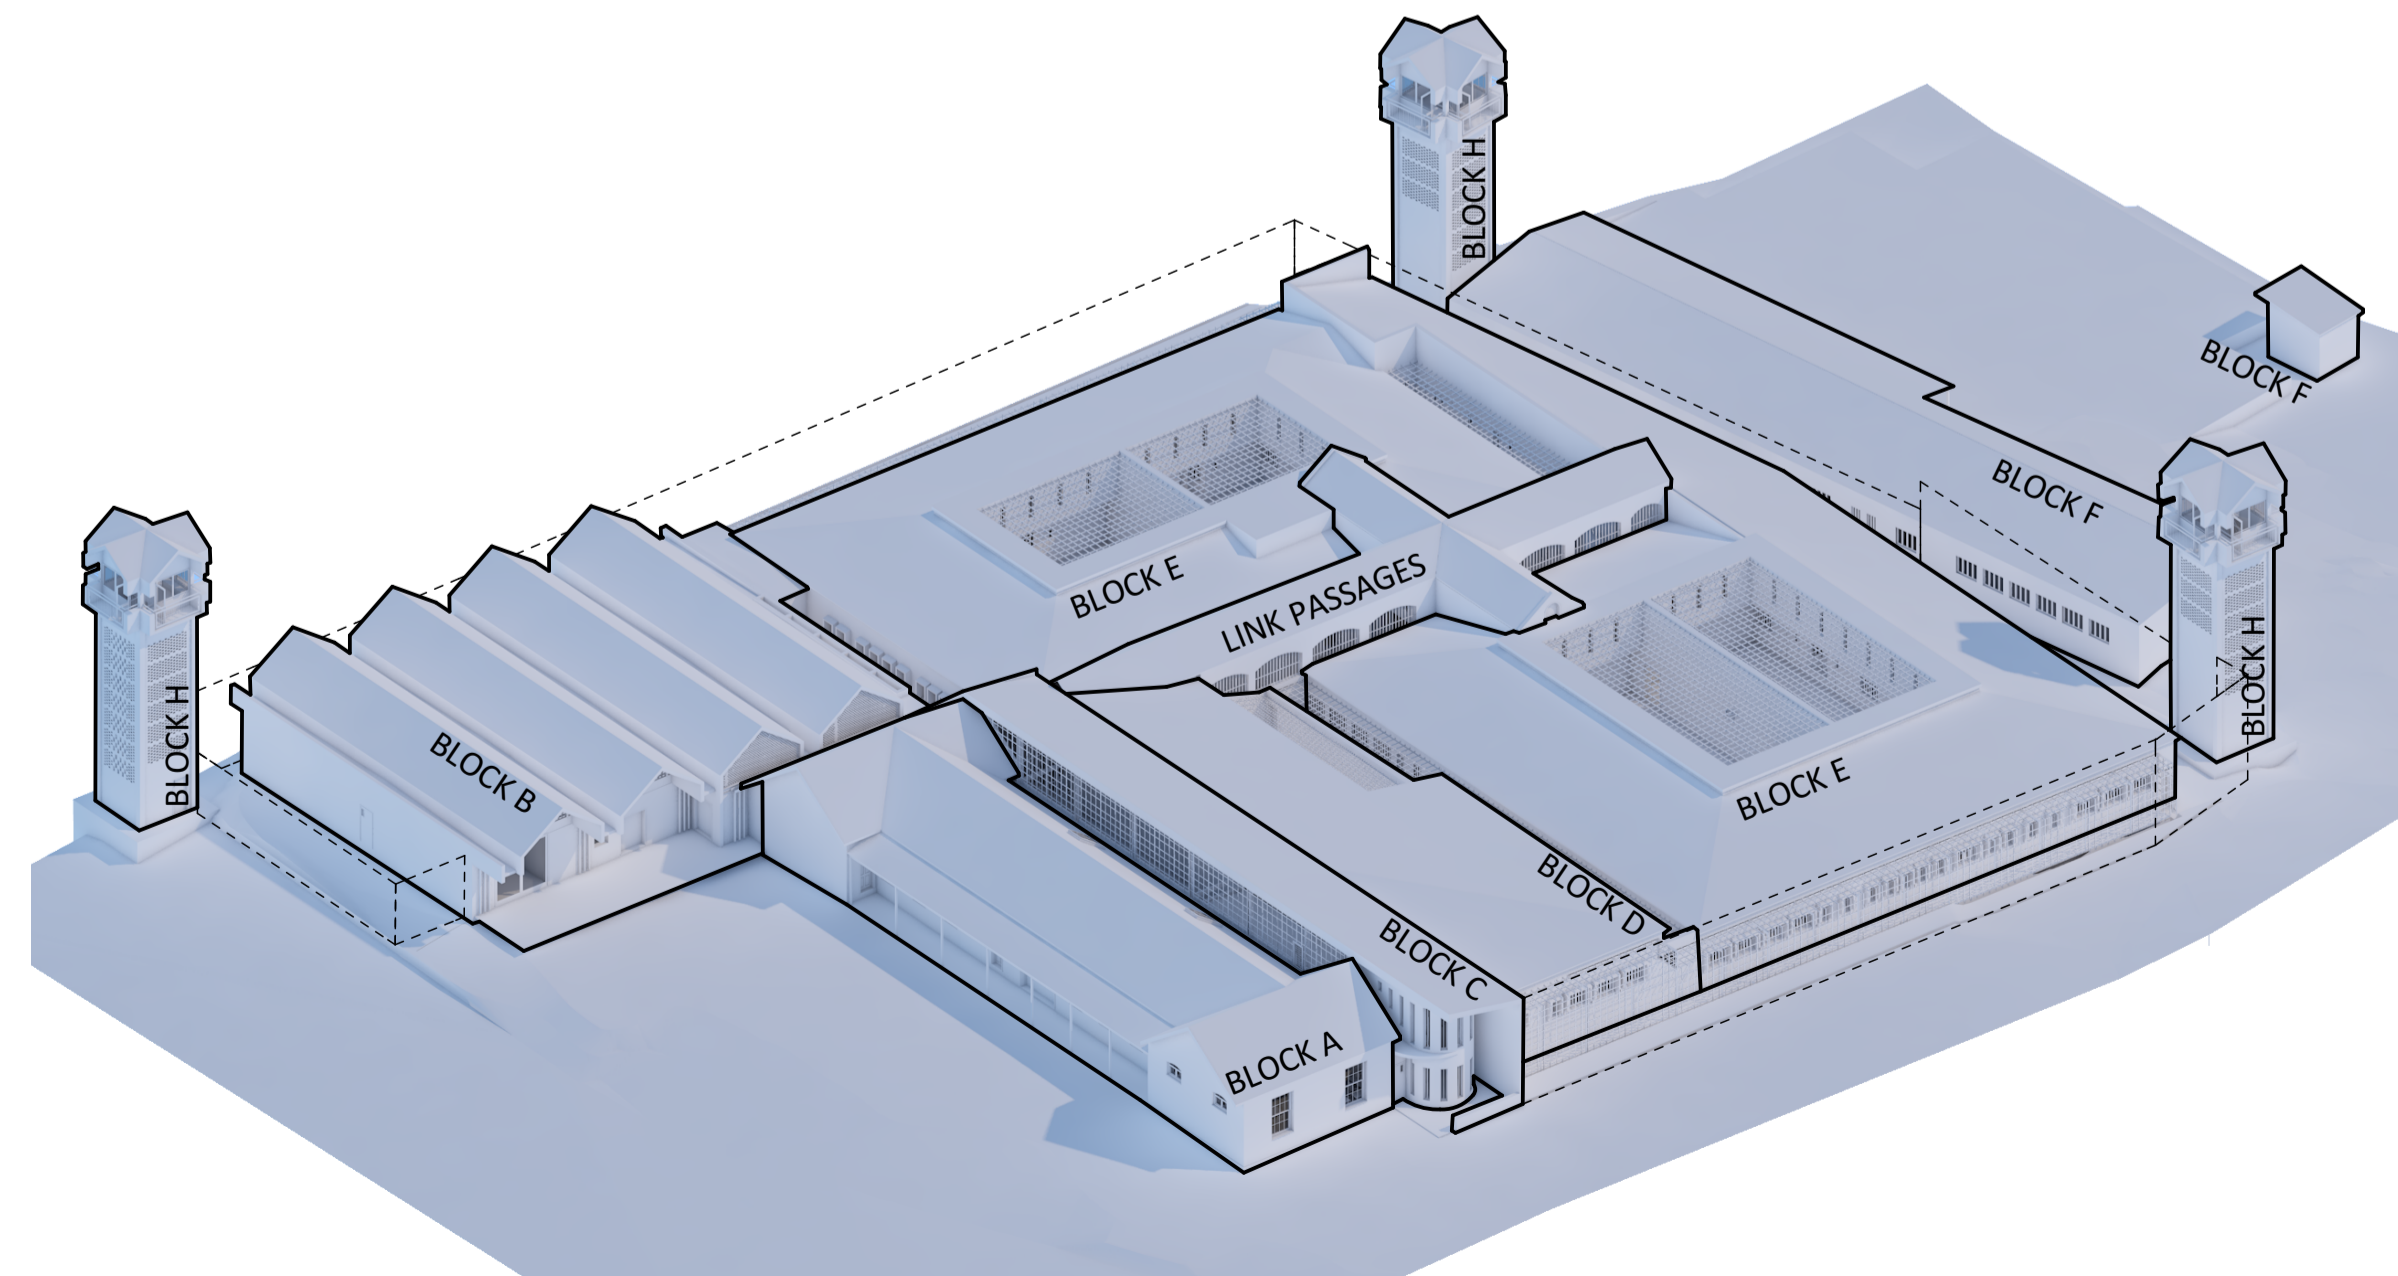

100 401 Axonometric

No.	DATE	AMENDMENT	D.P.W.

Copyright vests in the Department of Public Works
certified as-built drawings as per Centralised Drawing Archive AS-BUILT DRAWING REQUIREMENTS

name: Sean Wessels
date: 24 February 2017
professional registration no.: PrArch24750197

cad file name: PSP 20170221.pln page type: A 1



consultant: MAZIBUKO WESSELS ARCHITECTS

discipline: ARCHITECTS
service: PORT SHEPSTONE PRISON: REPAIR AND RENOVATIONS FOR BUILDING RELATED SERVICES

WCS number: 040801

drawing title: Elevations Block A, Block C

ref no: PSP 24/02/2017 designed: SEAN WESSELS
scale: 1:200, 1:169.66 drawn: SEAN WESSELS
date: 24 February 2017 checked: SEAN WESSELS
DPW drawing number

040801/X301