

DURHAM CORPORATION  
SCALE: 1" = 8'-0"

# PROPOSED HOUSE for L. J. BREEDS.


CITY ENGINEERS DEPARTMENT  
SECTION 155 OF THE BUILDING LAWS TO INDIVIDUALS  
B - LAWS WILL BE COMPLIED WITH.  
HOUSING SECTION

DRAWING NO. TYPE 42  
SIZE OF SHEET 15 1/2" x 27"


ALL ALTERATIONS SHOWN IN RED



REAR ELEVATION

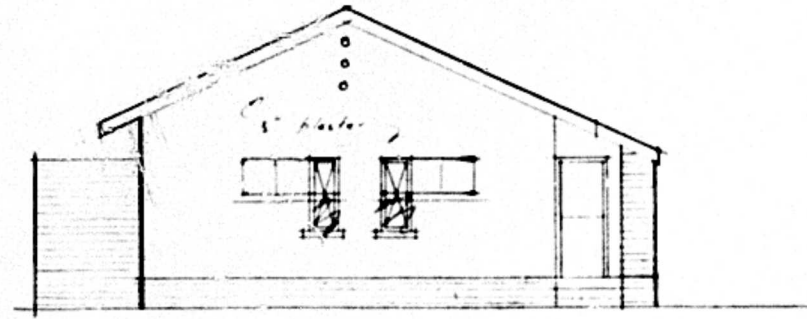


SIDE ELEVATION

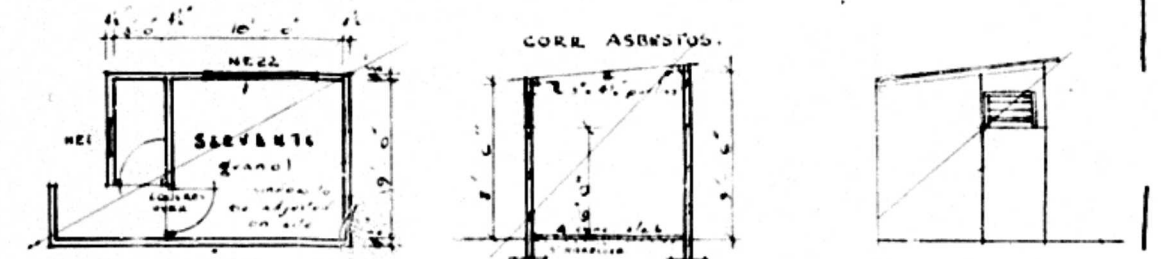


PLAN

SECTION


ELEVATION

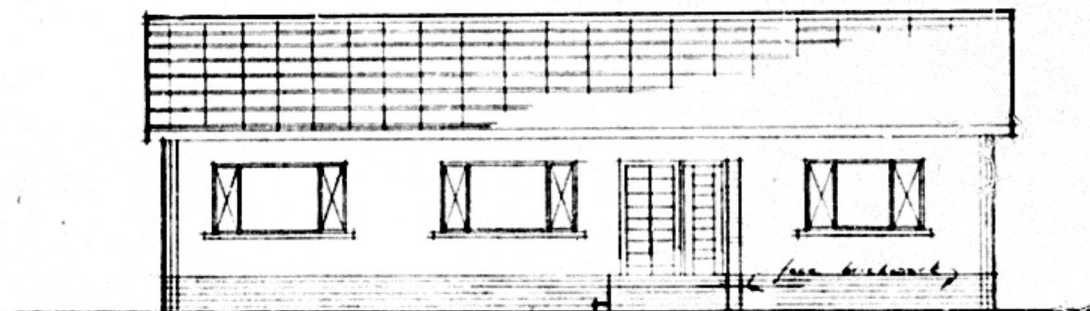


FRONT ELEVATION

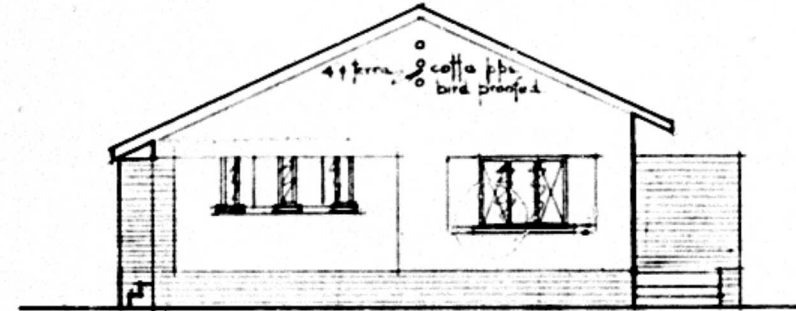

SIDE ELEVATION

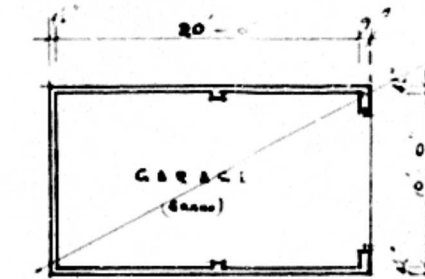


PLAN

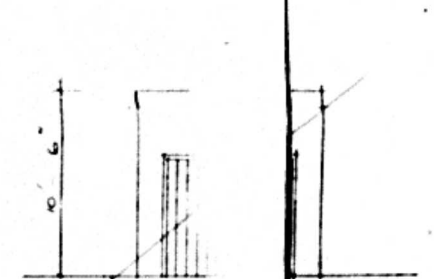


ELEVATION

OUTBUILDINGS

Roof & floor construction to housing specification.

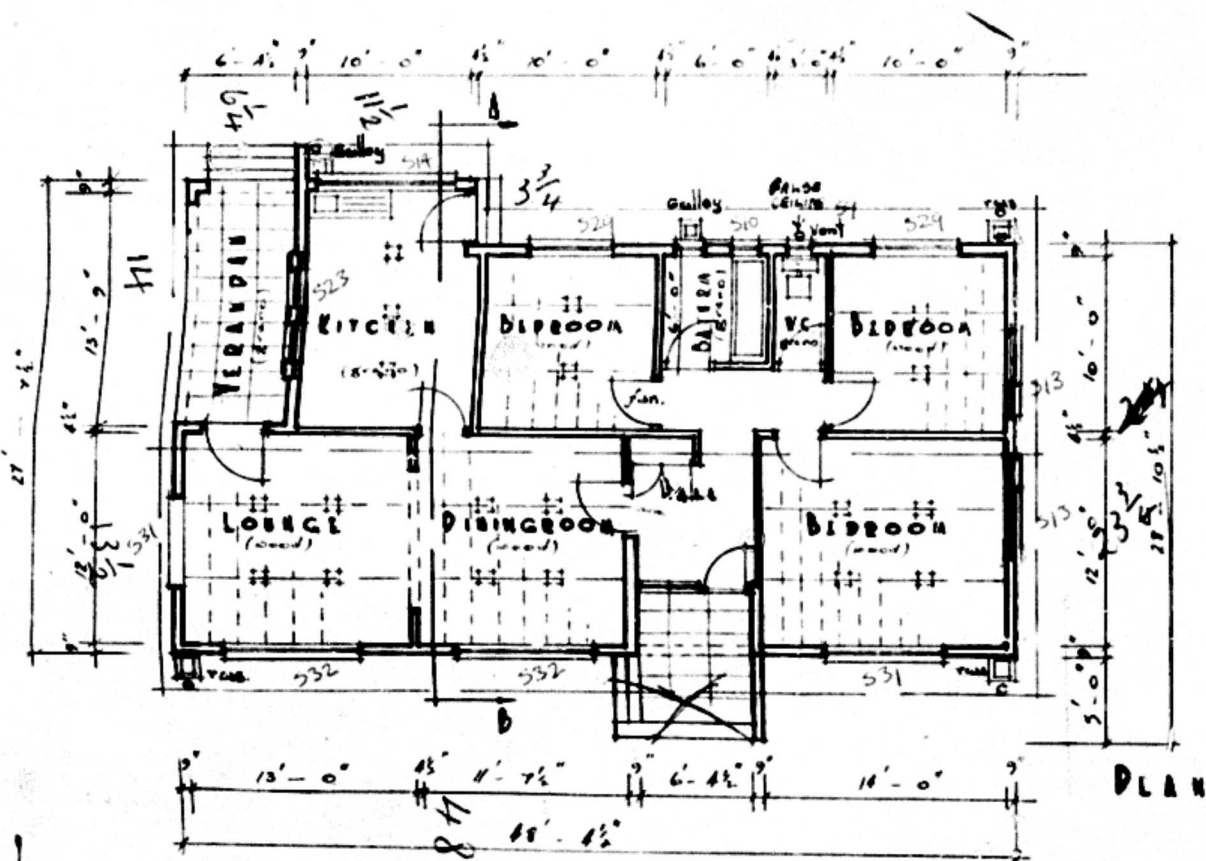

PLAN

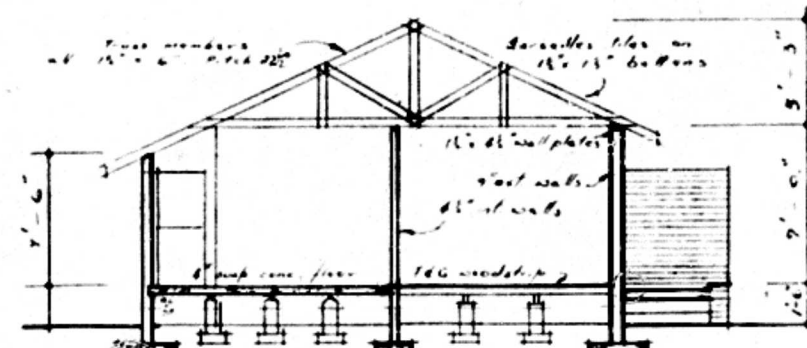

SECTION A-B

PLAN APPROVED 21-8-63  
SUBJECT TO

*A. Linnart*

*H. Blankenhorn*